



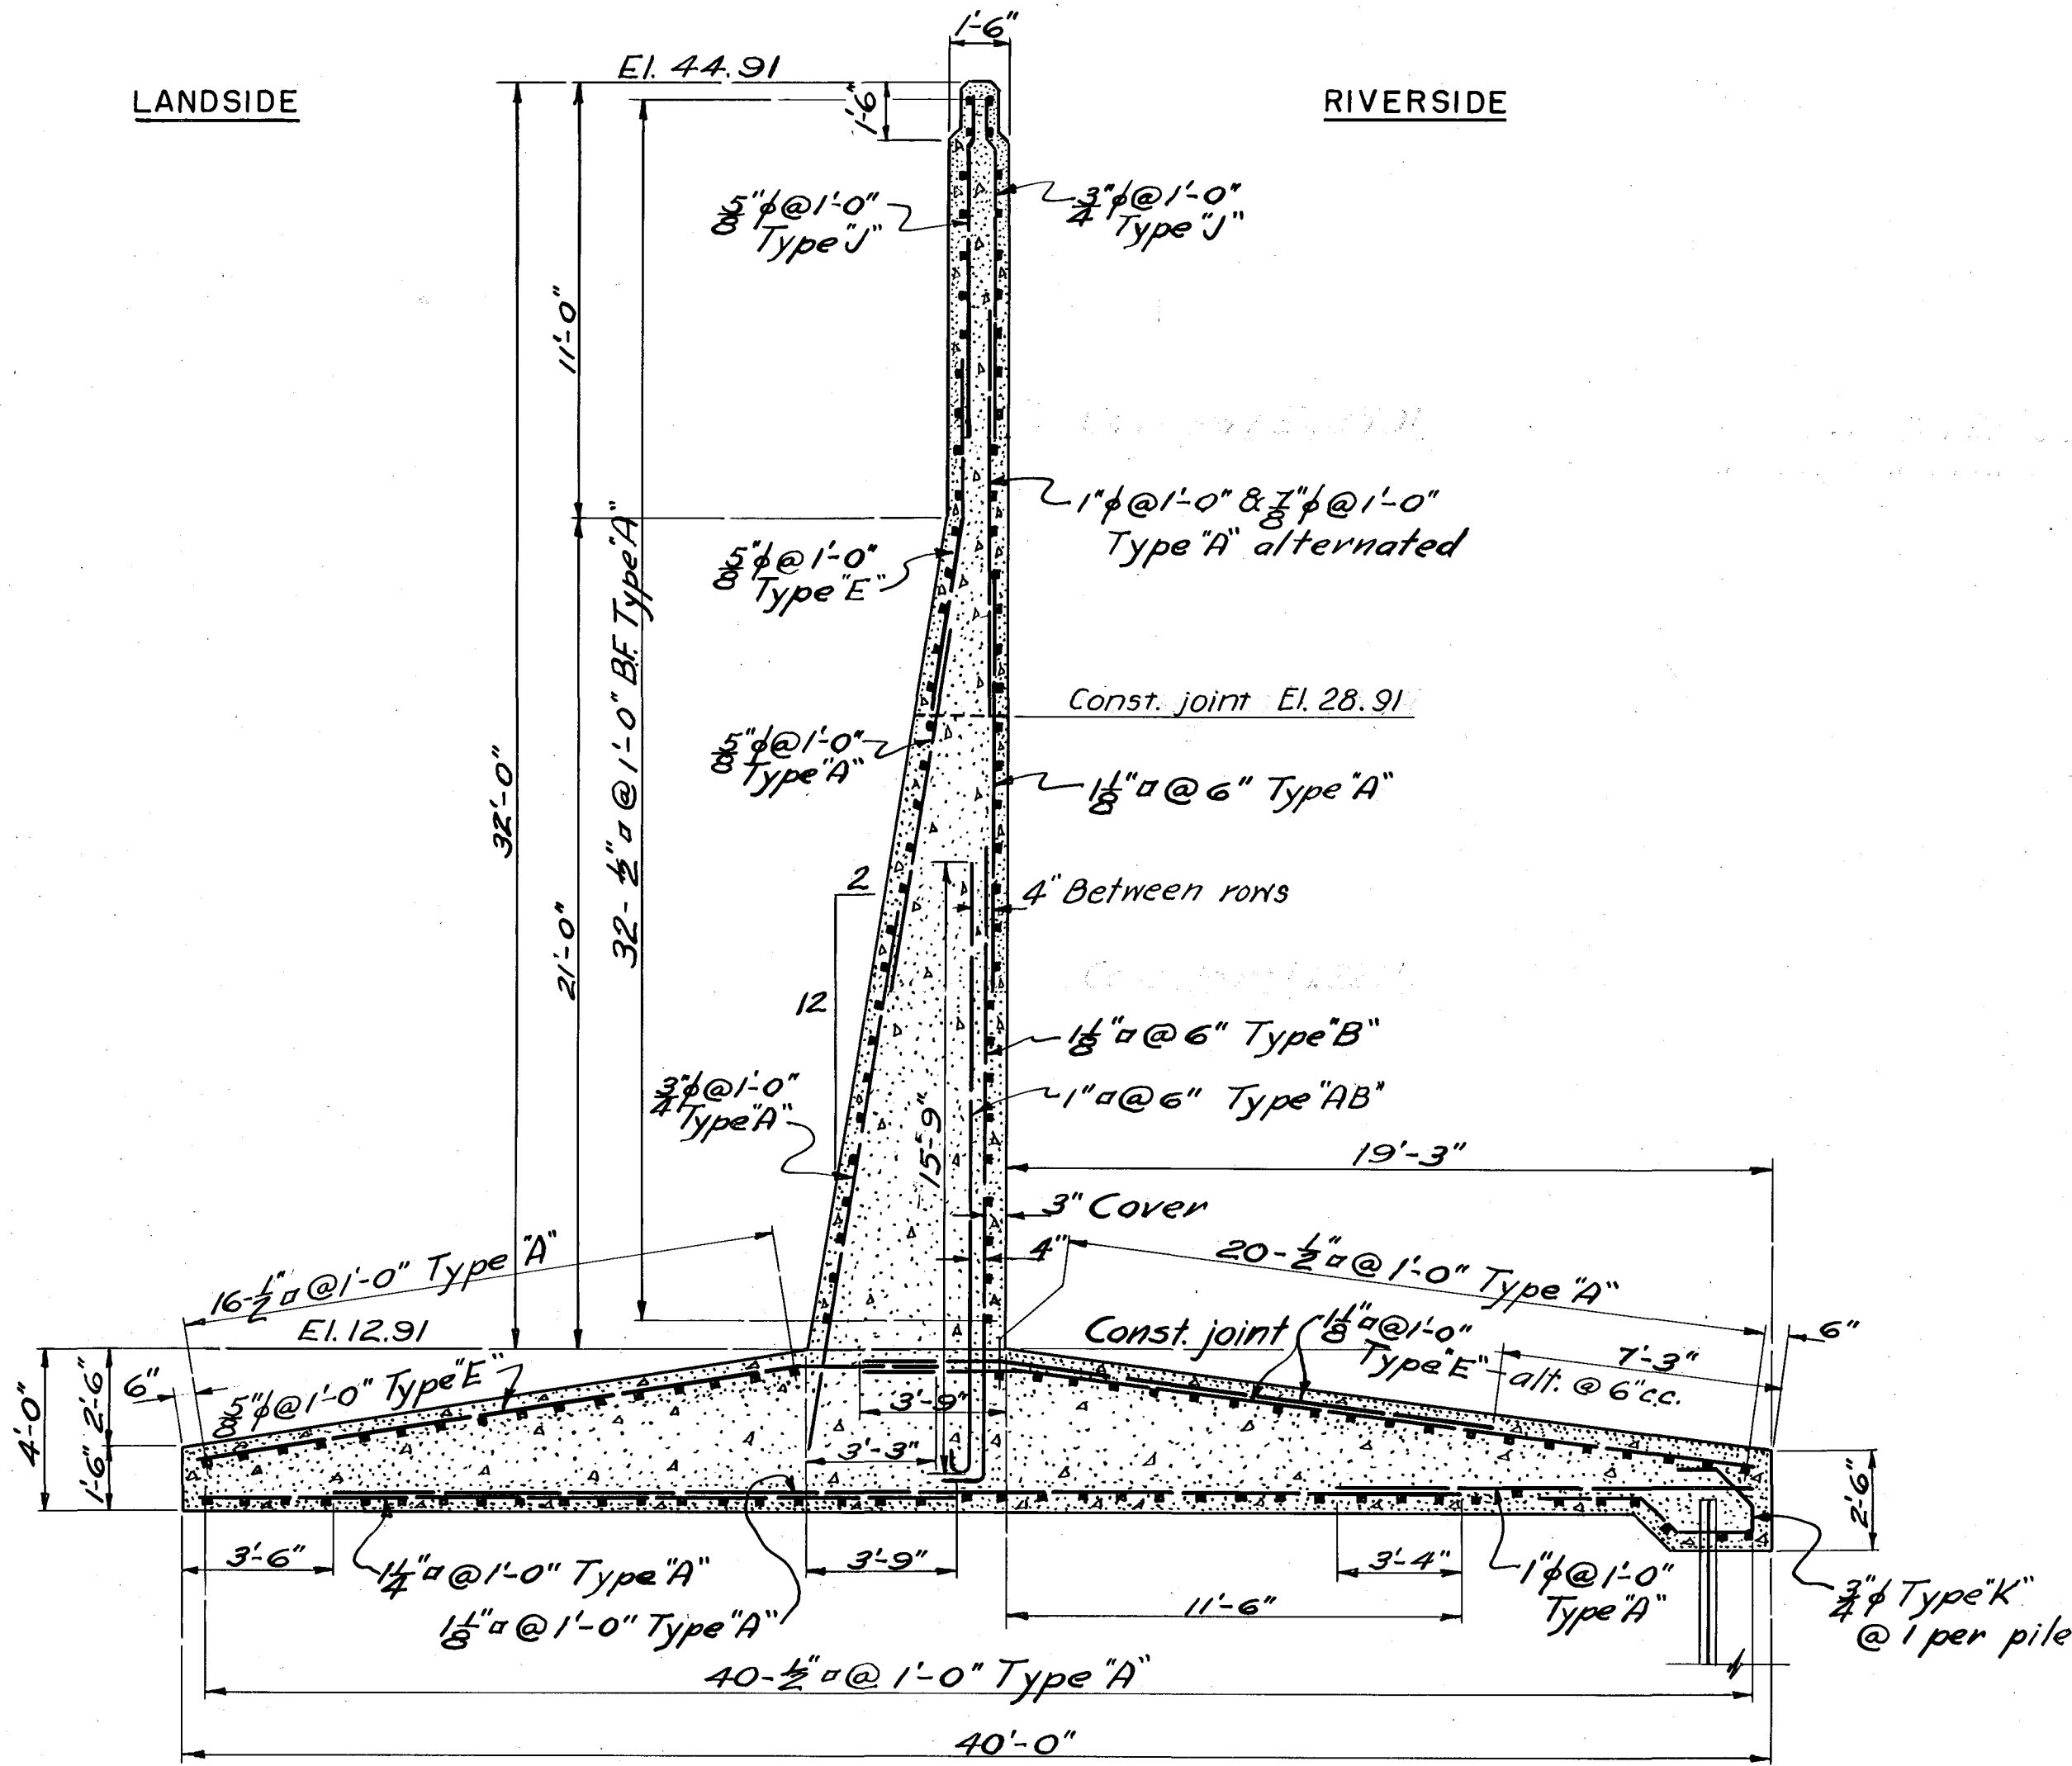

32'-0" WALL

STA. 15 + 11.19 TO STA. 15 + 91.19

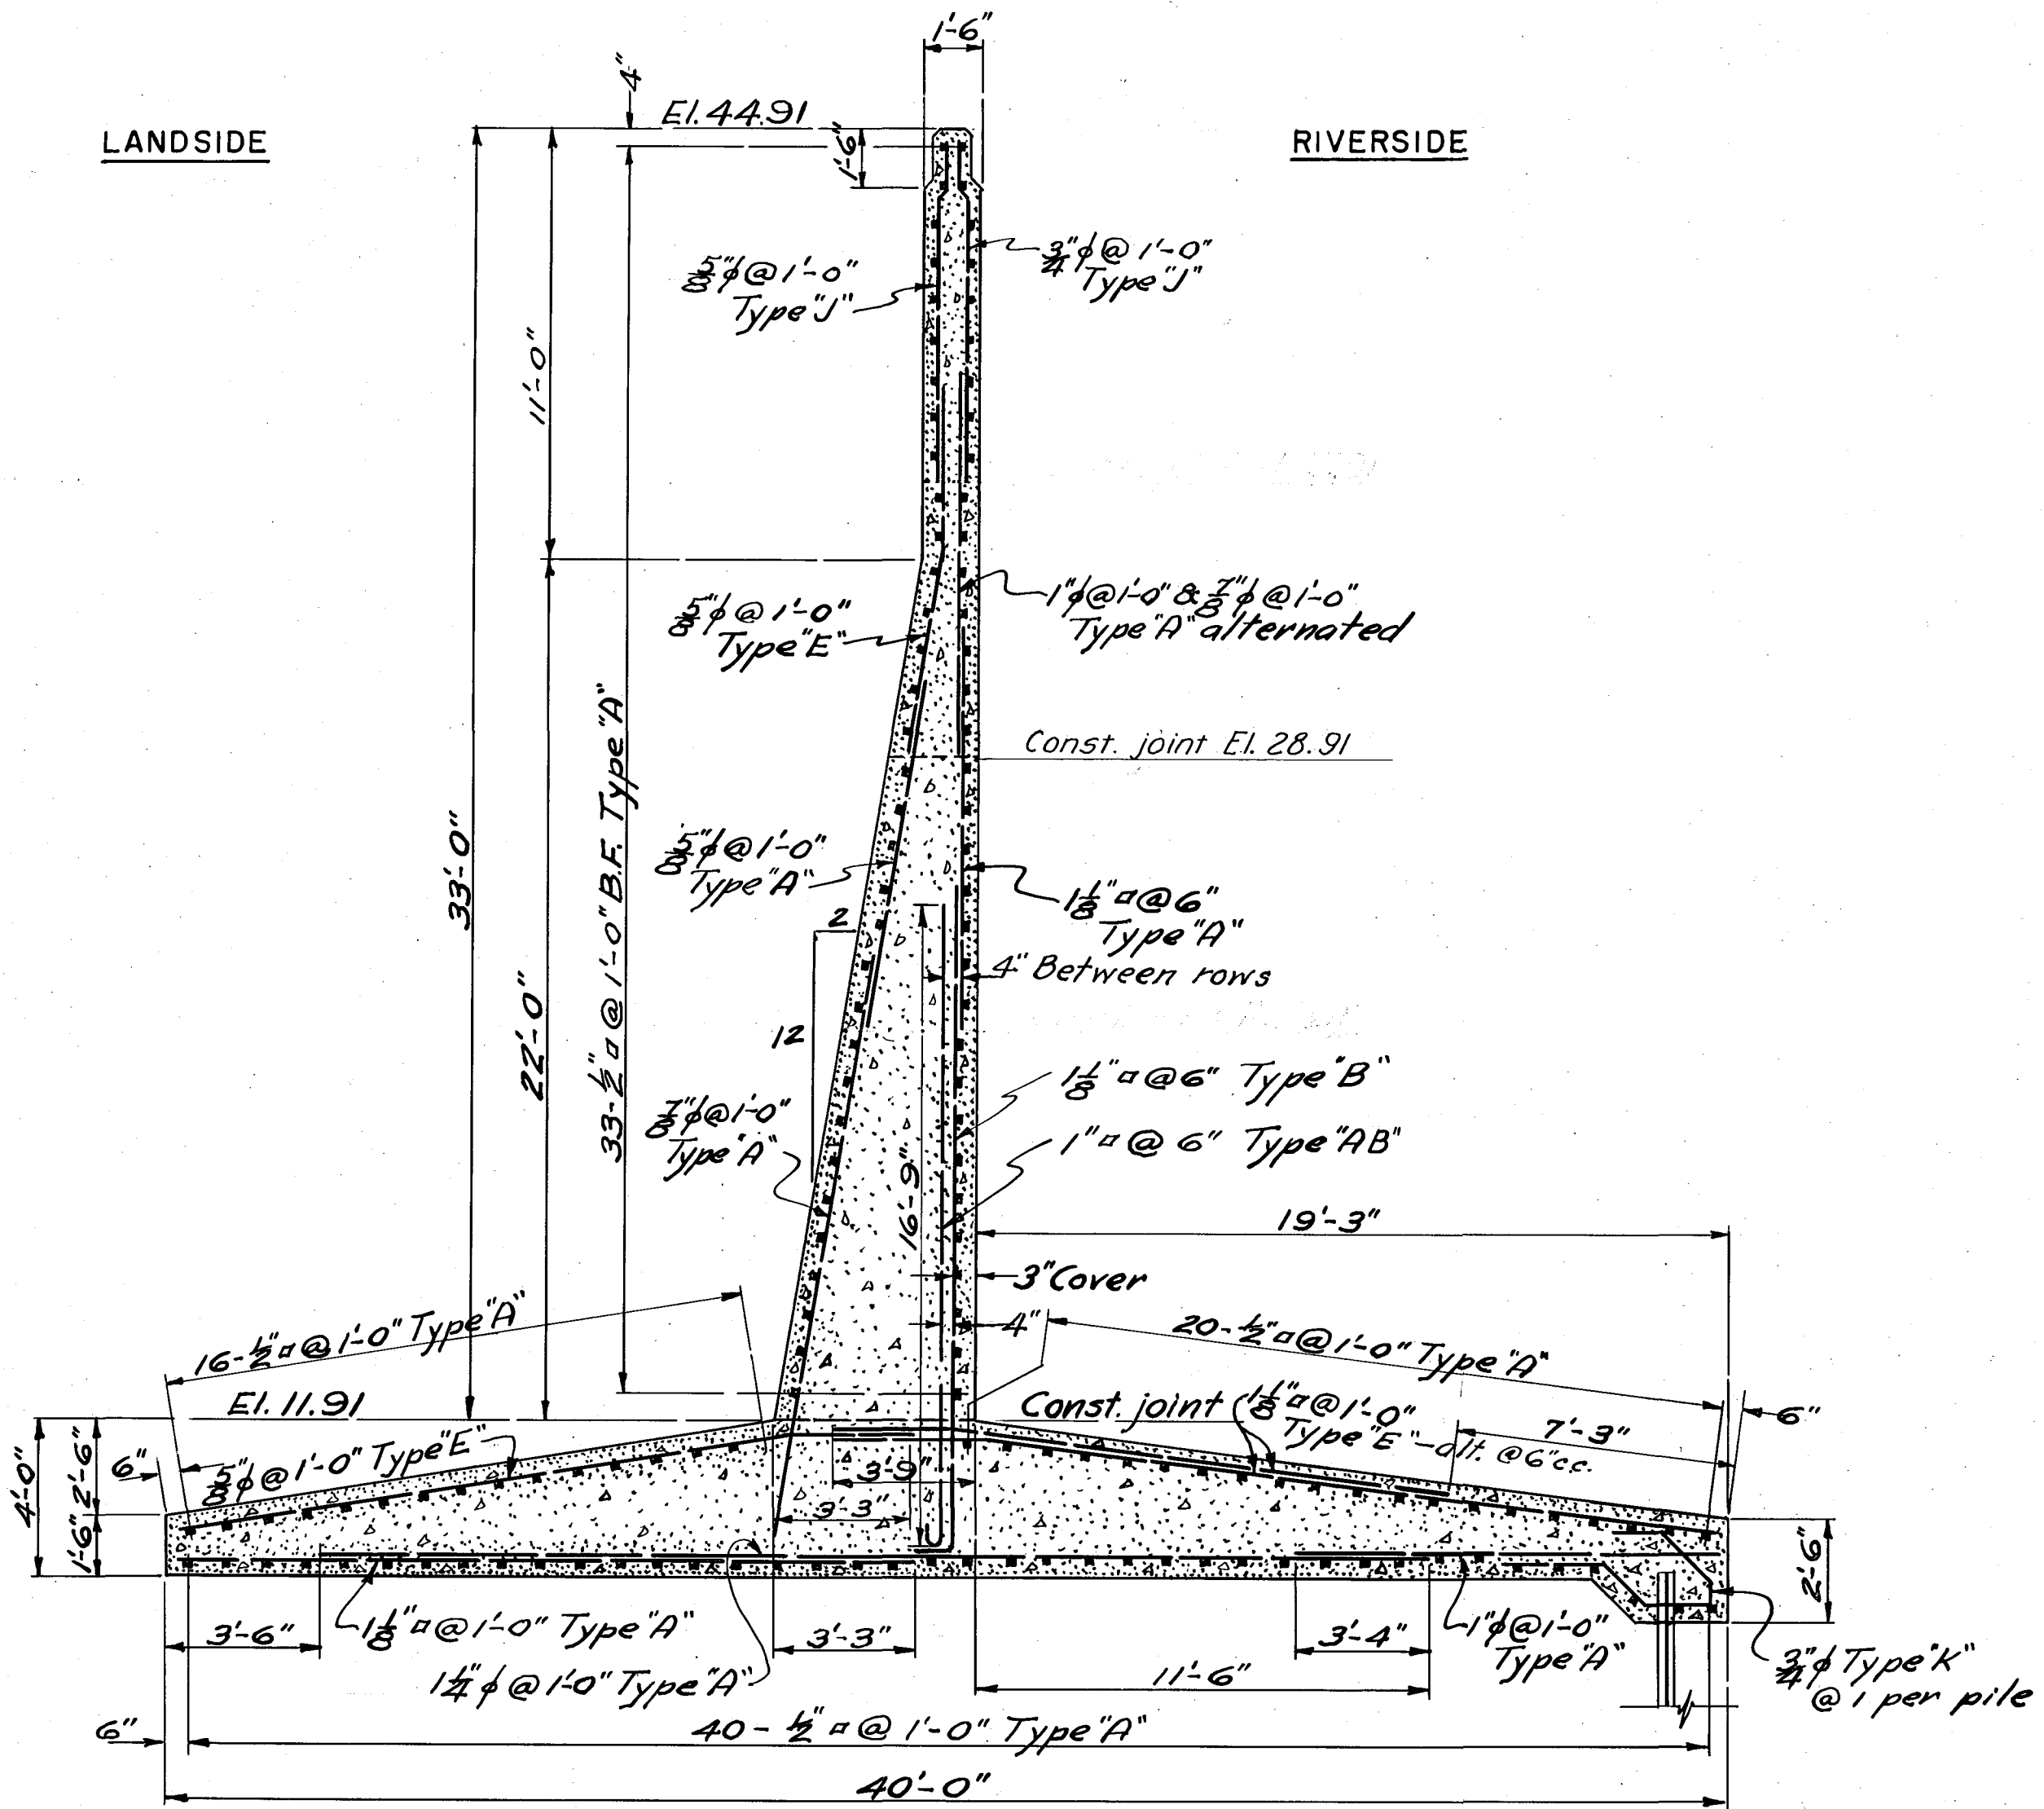

33'-0" WALL

STA. 15 + 91.19 TO STA. 16 + 31.19

NOTES

For concrete details see Sheet No. 72
For general notes see Sheet No. 89

KEY	DATE	REVISION (Indicated by Δ)	REV. BY	CK. BY	AP. BY
	12-31-45	As built revisions			

CONNECTICUT RIVER FLOOD CONTROL		
HARTFORD DIKE		
RIVERFRONT, MORGAN ST. TO STA. 96+73		
WALL - STA. 15+11.19 TO STA. 16+31.19		
STEEL REINFORCEMENT		
CONNECTICUT RIVER		CONNECTICUT
IN 135 SHEETS	SCALE: 1/4 IN. = 1 FT.	SHEET NO. 91
U.S. ENGINEER OFFICE, PROVIDENCE, R.I., MAY 1940		
SUBMITTED:	APPROVAL RECOMMENDED:	APPROVED:
Senior Engineer	Principal Engineer	District Engineer
HEAD, DESIGN SECTION	CHIEF, F.C. ENGINEERING DIV.	DISTRICT ENGINEER
DESIGNED:	DRAWN: J. H. L.	FISCAL YEAR 1940
ASSOC. ENGINEER	TRACED: R. M. W.	FILE NO. CT-4-2551
	CHECKED: K. W. M.	