
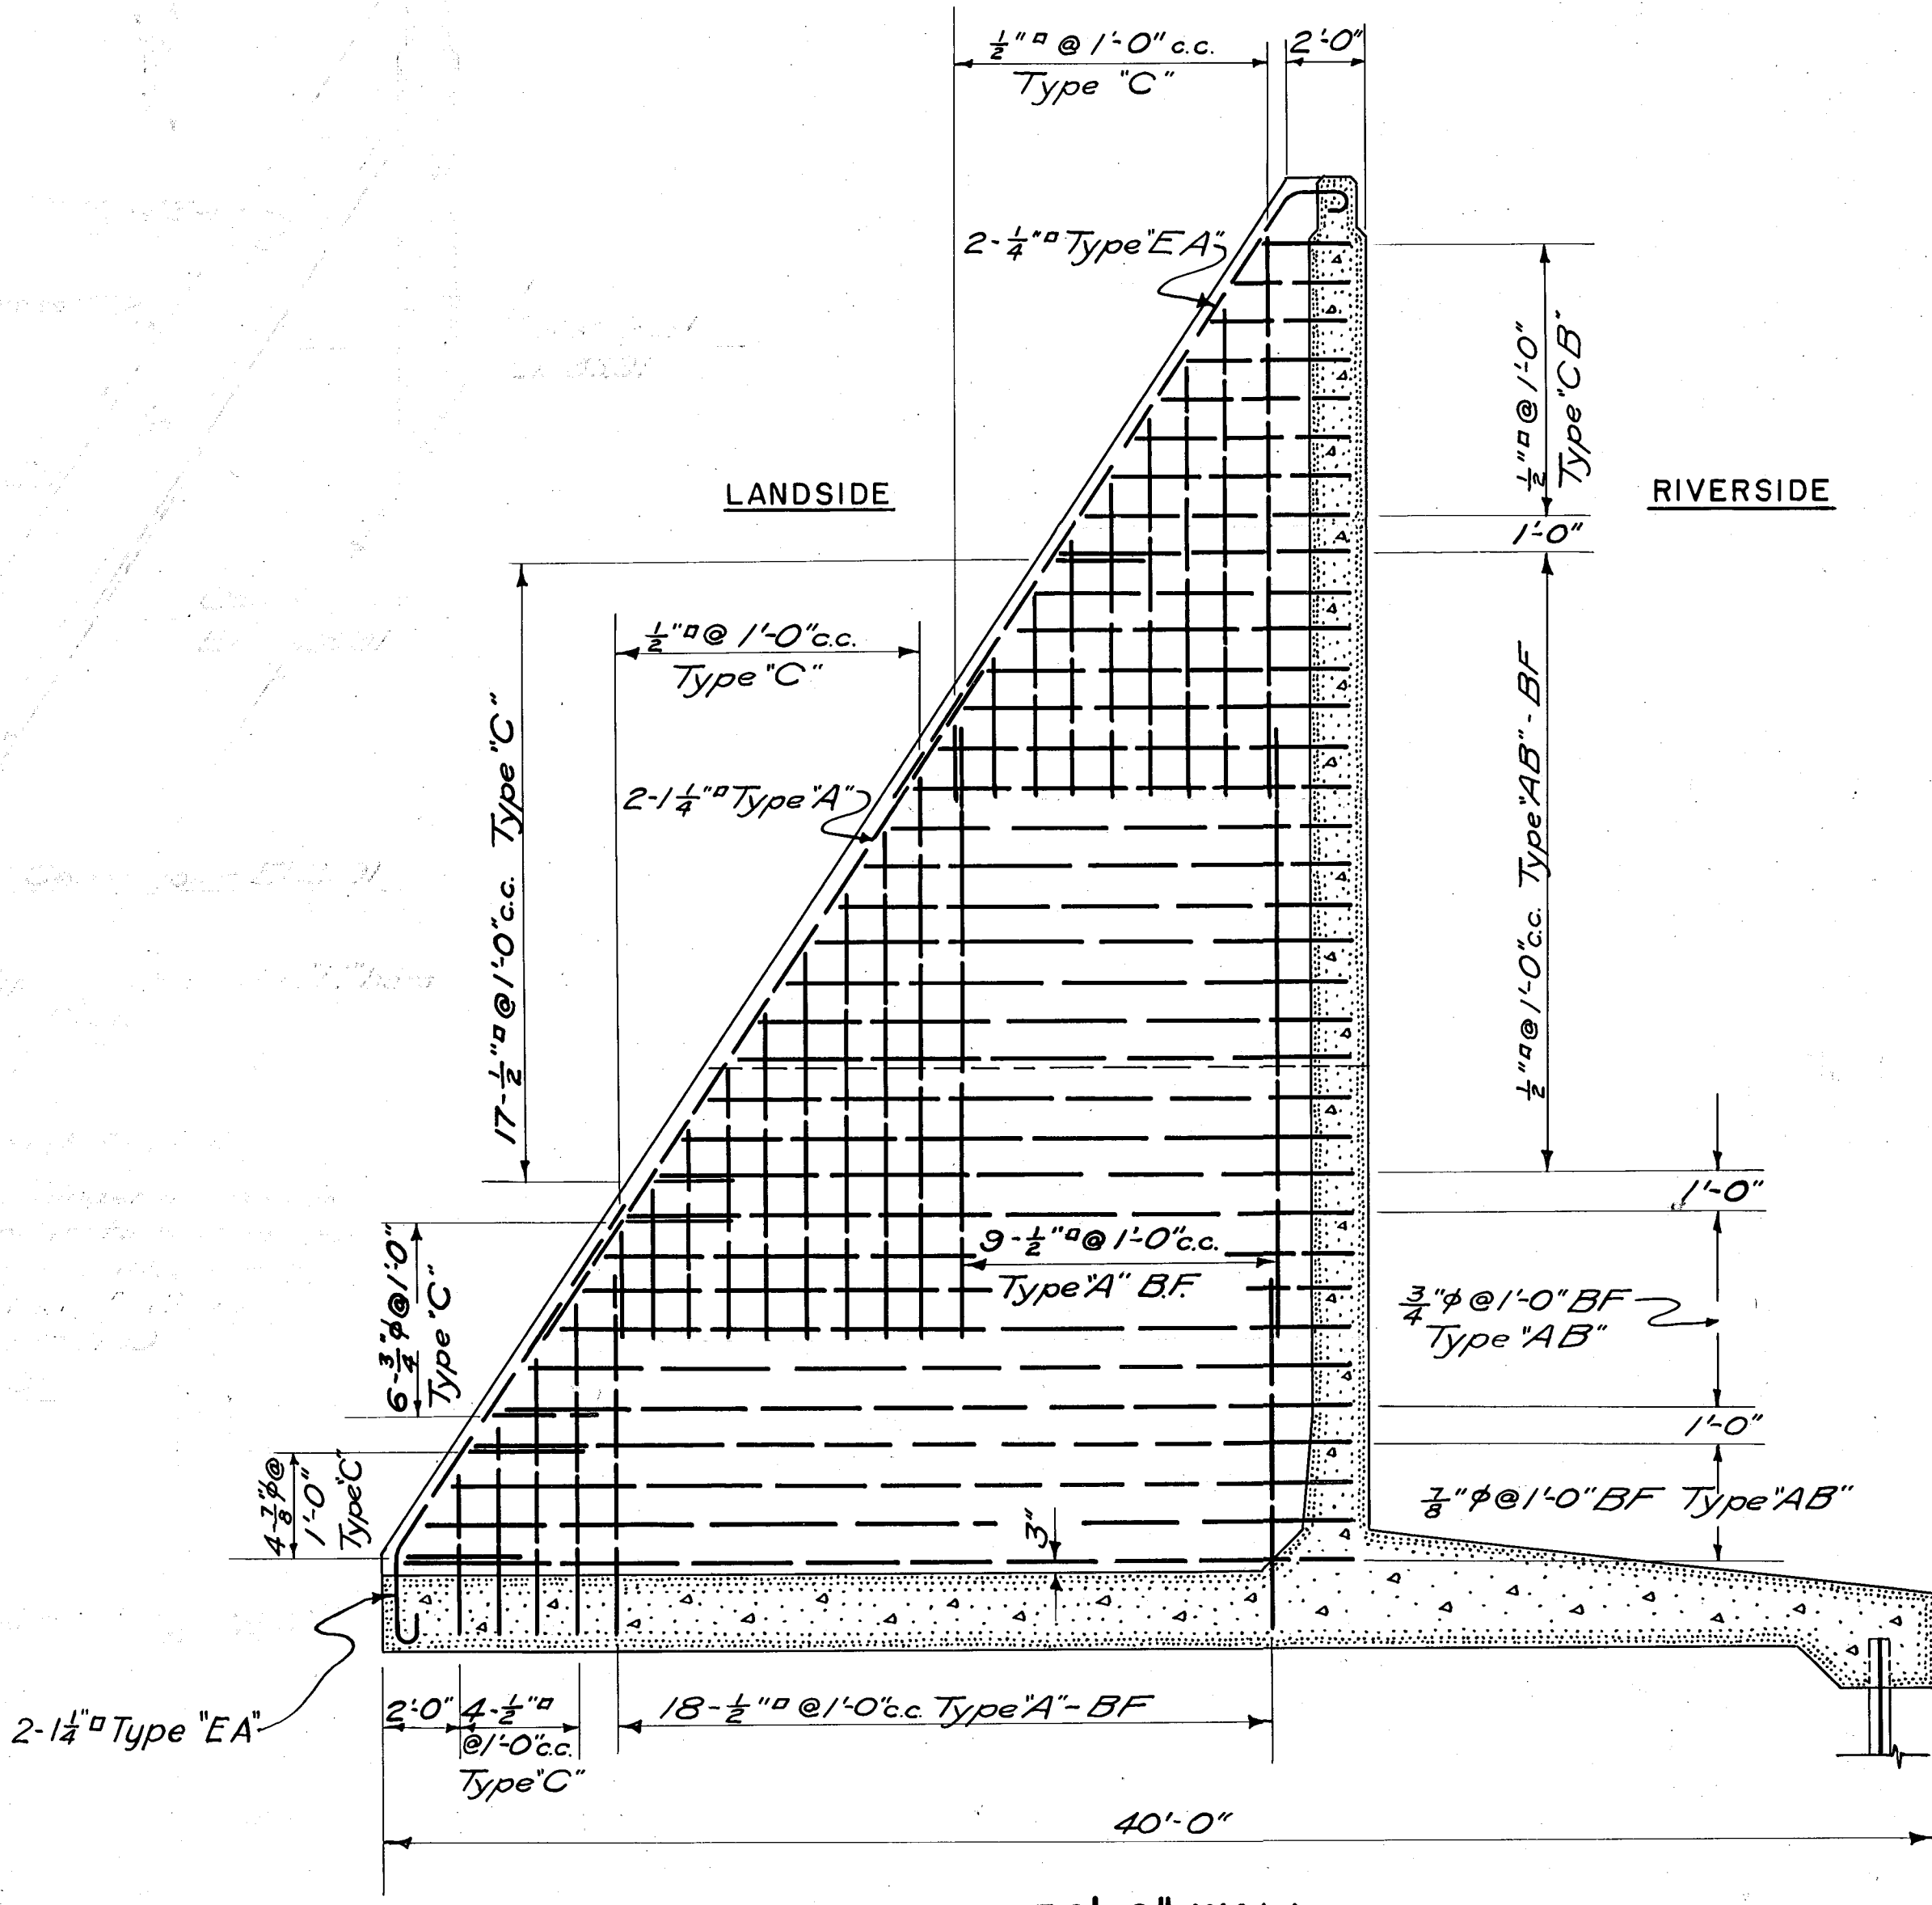


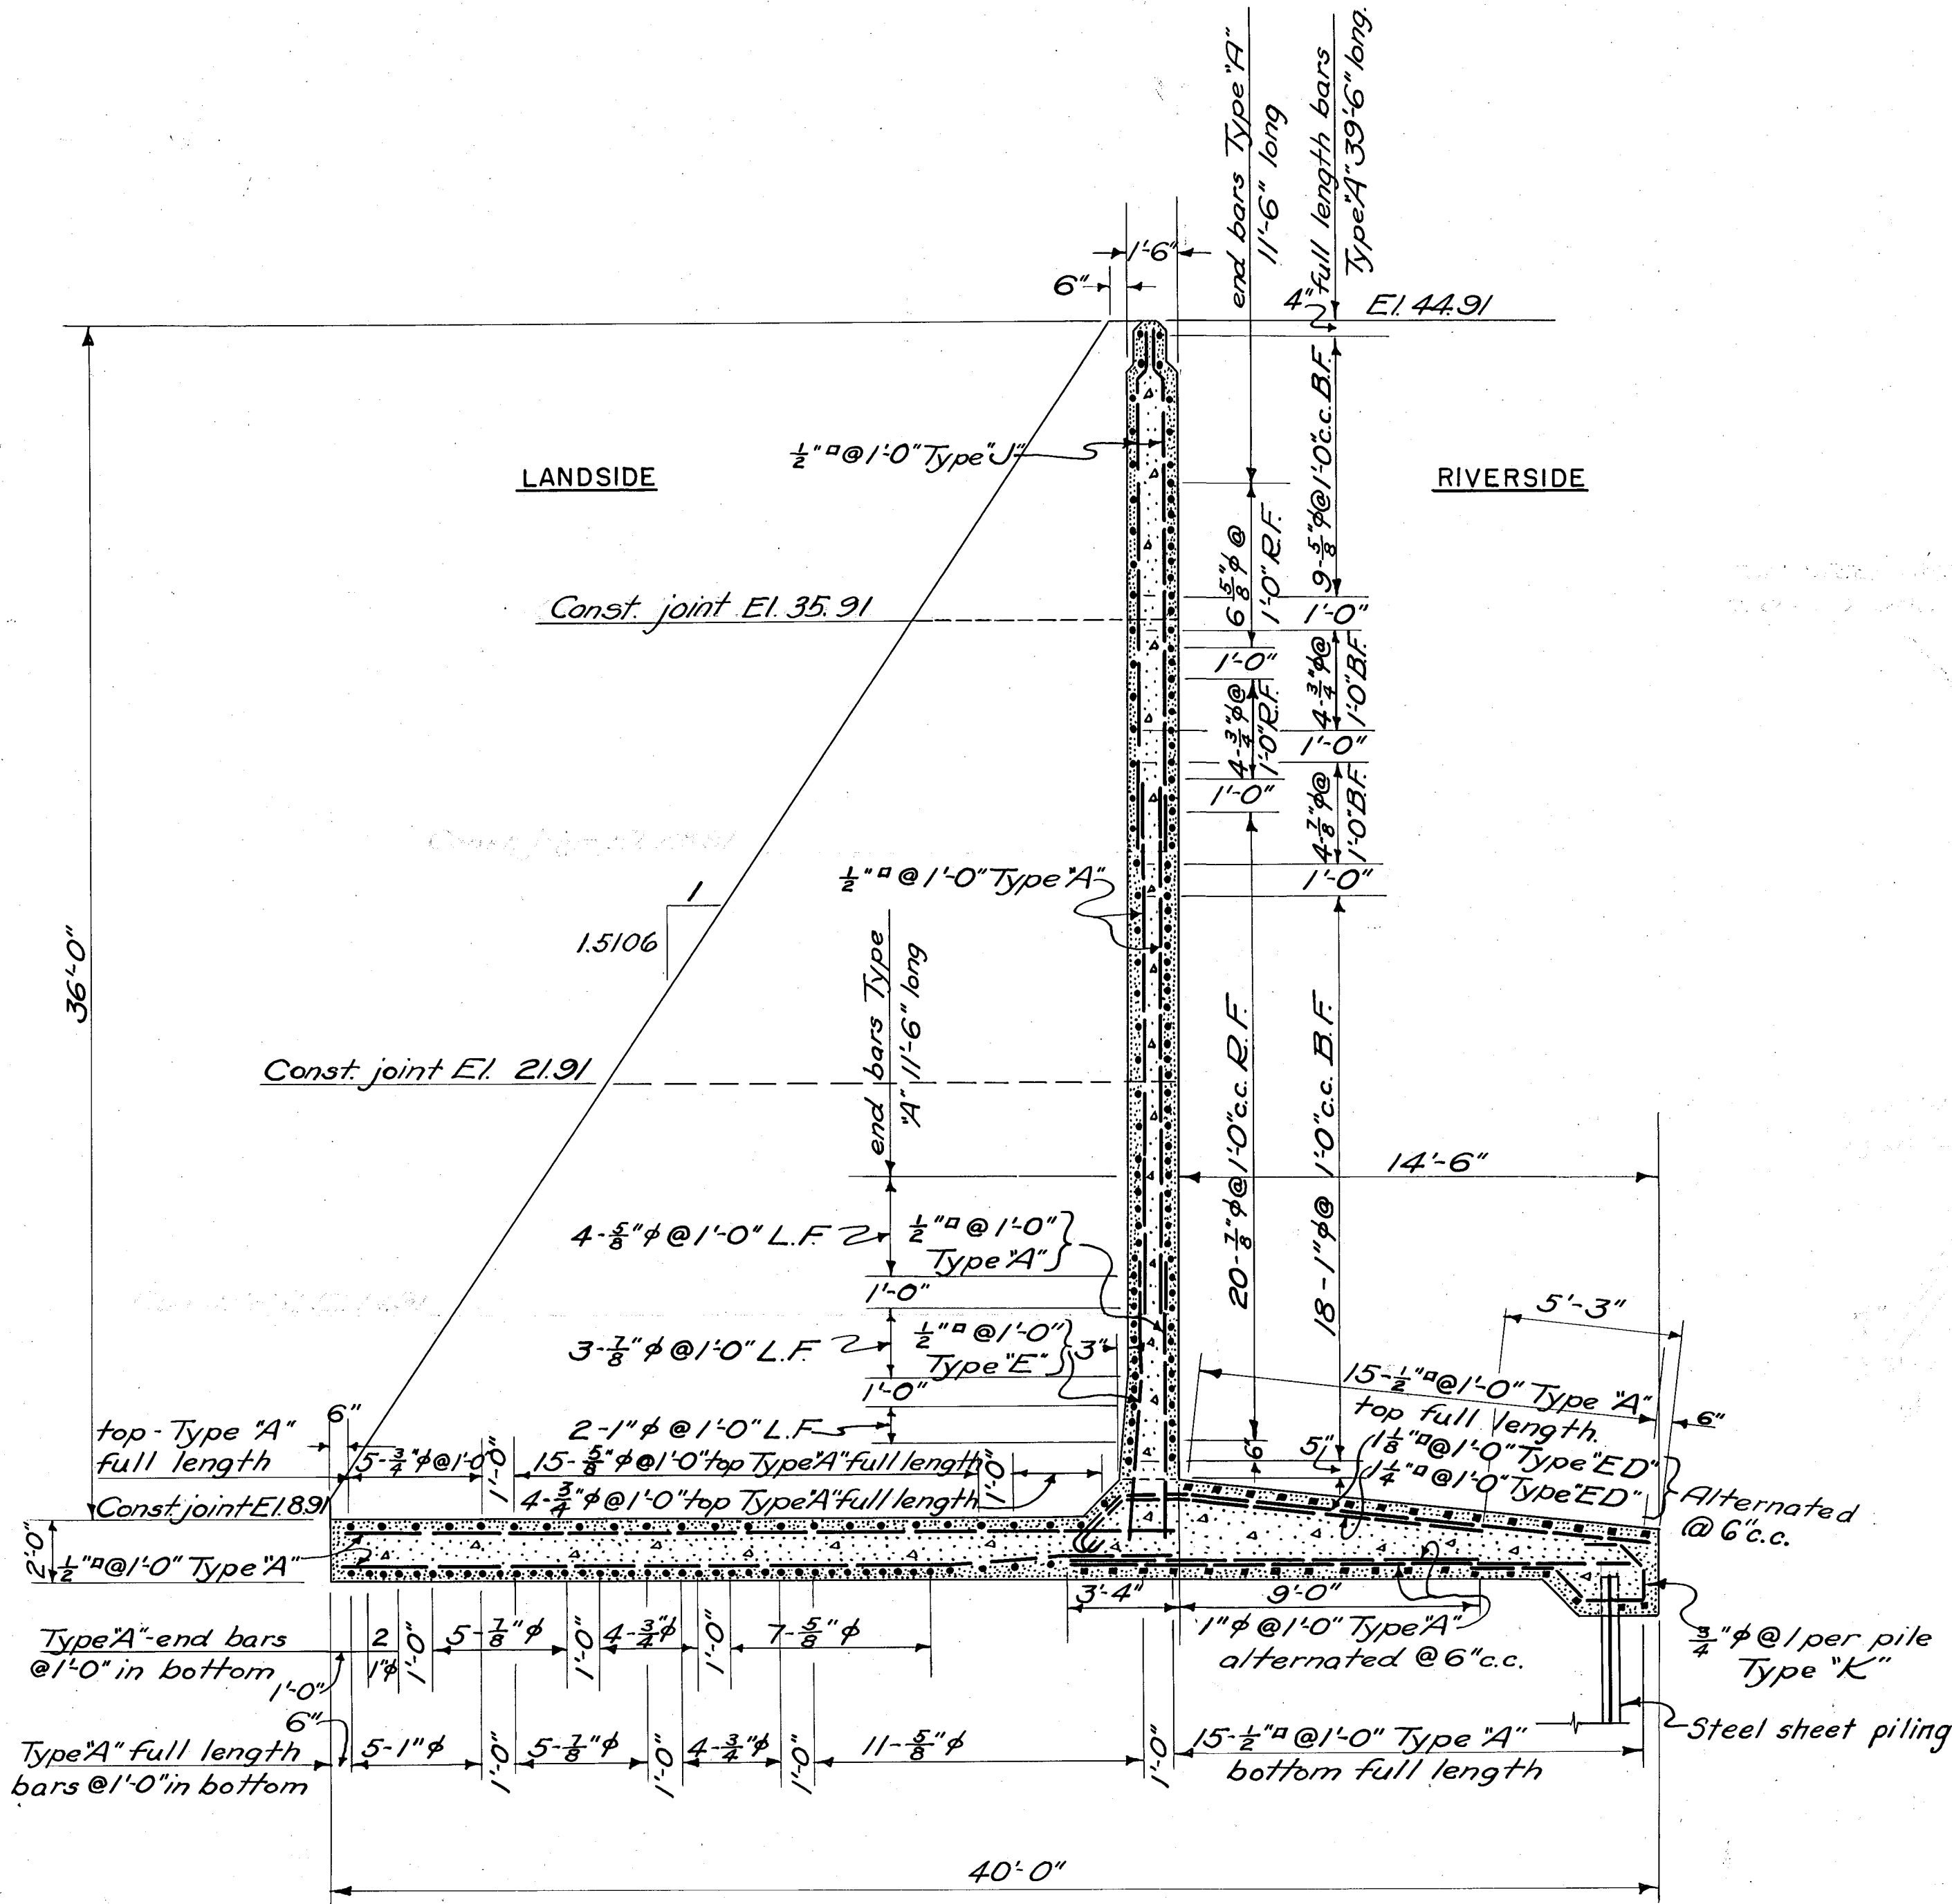

NOTES
For concrete details see Sheet No. 72
For general notes see Sheet No. 89

CONNECTICUT RIVER FLOOD CONTROL			
HARTFORD DIKE			
RIVERFRONT, MORGAN ST. TO STA. 96+73			
WALL - STA. 17+91.19 TO STA. 18+71.19			
STEEL REINFORCEMENT			
CONNECTICUT RIVER	SCALE: 1/4 IN. = 1 FT.	CONNECTICUT	SHEET NO. 93
U.S. ENGINEER OFFICE, PROVIDENCE, R.I., MAY 1940			
SUBMITTED:	APPROVAL RECOMMENDED:	APPROVED:	
Senior Engineer	Principal Engineer	District Engineer	
HEAD DESIGN SECTION	CHIEF, F.C. ENGINEERING DIV.	DISTRICT ENGINEER	
DESIGNED BY:	DRAWN BY:	FISCAL YEAR 1940	
ASSOC. ENGINEER	CHECKED BY:	FILE NO. CT-4-2553	

12-31-45	As built revisions			
8/26/40	Wall stations changed	EM.V.	172	JMB
KEY	DATE	REVISION (Indicated by Δ)	REV. BY	CK. BY