



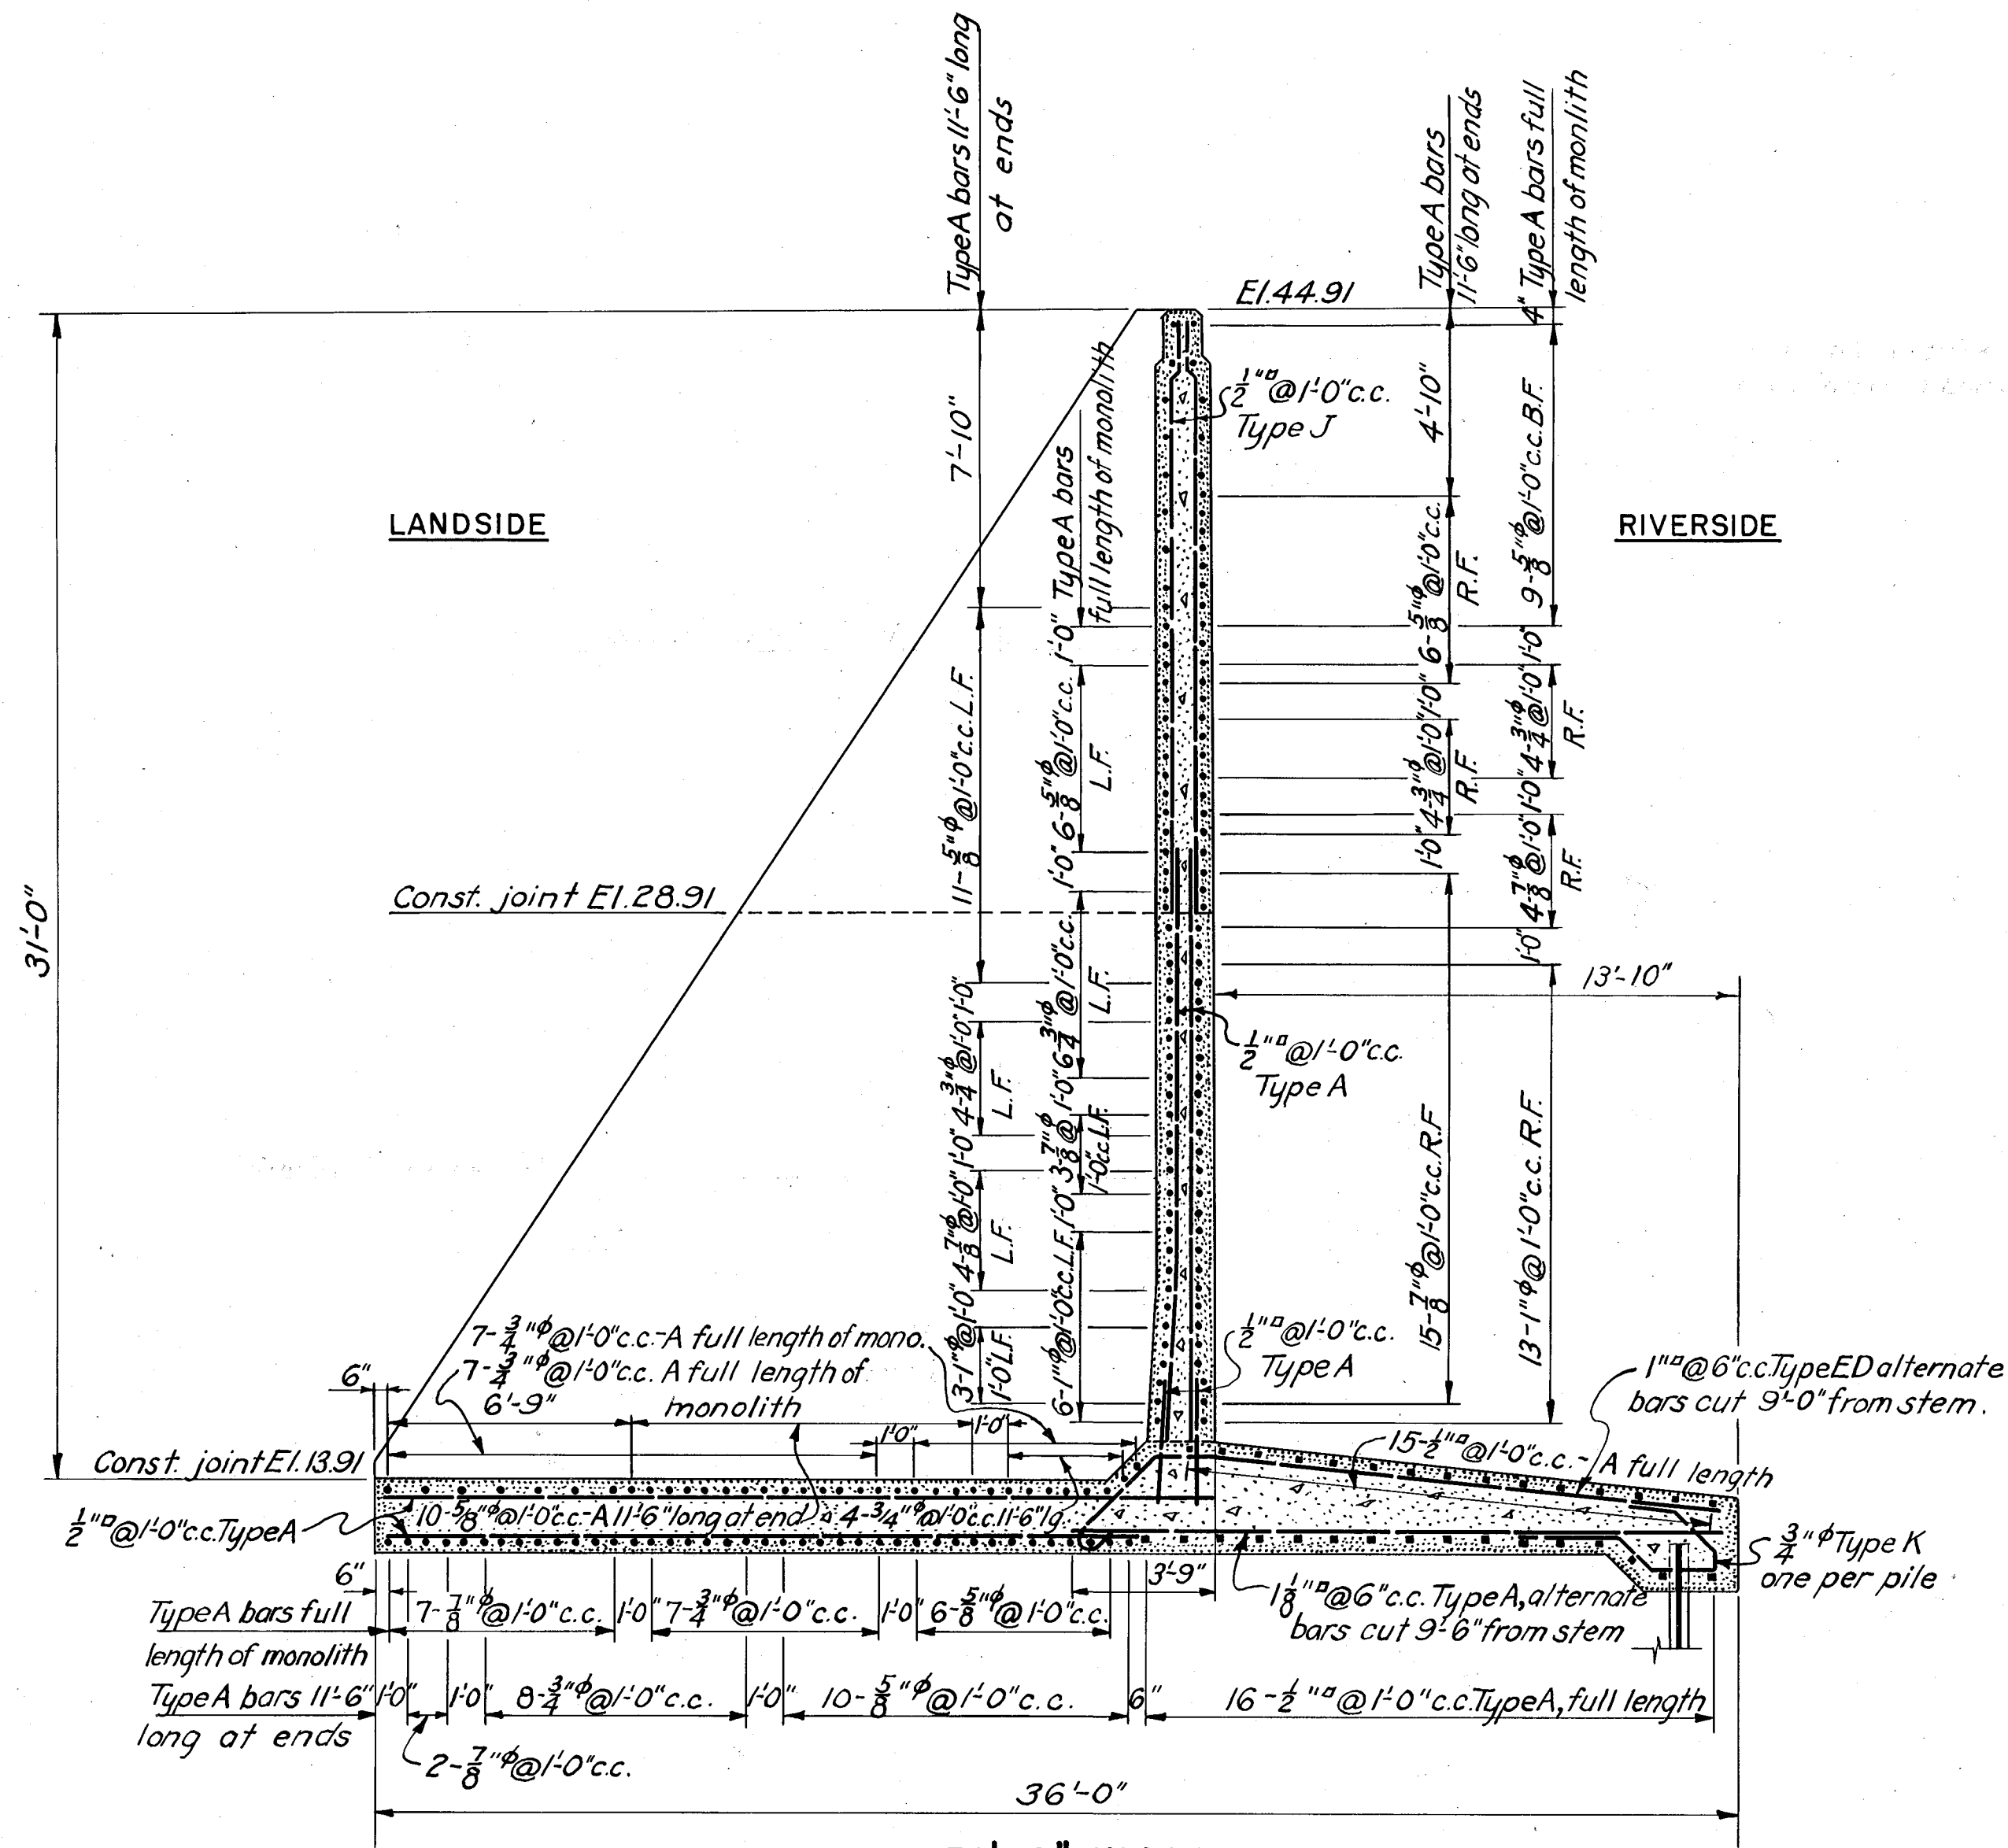

31'-0" WALL
STEM AND BASE STEEL
STA. 19+11.19 TO STA. 20+31.19

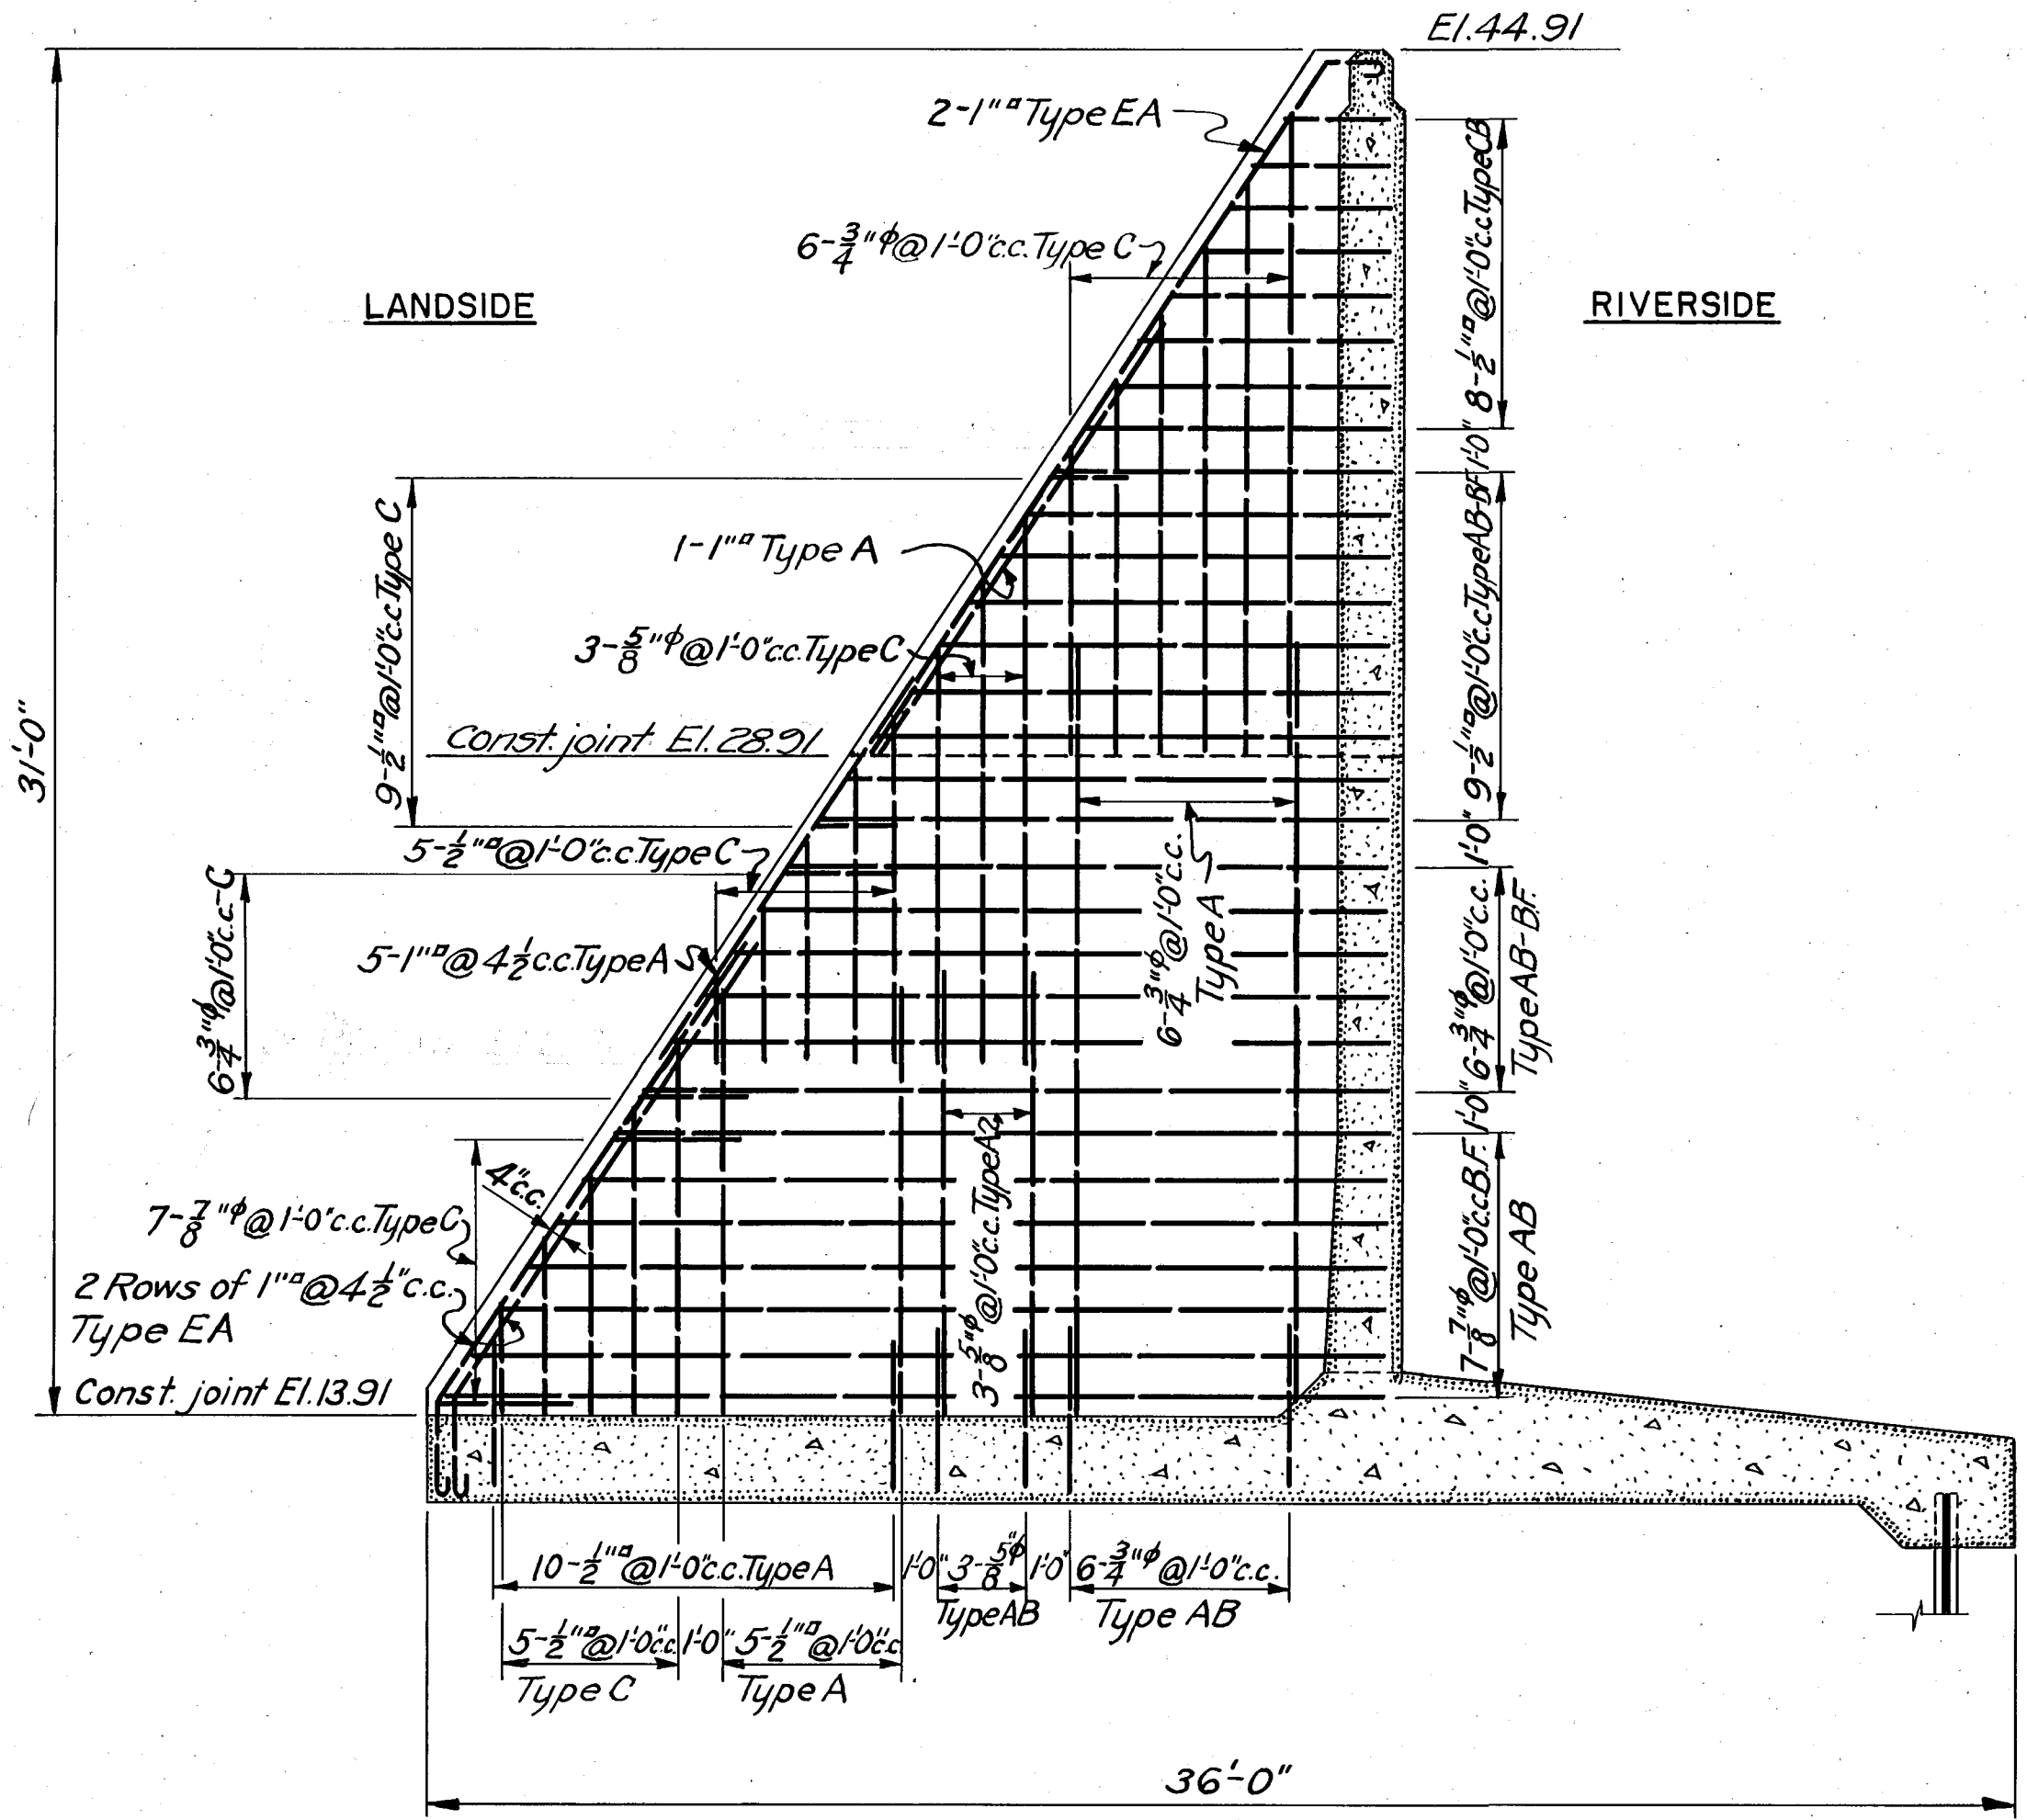

31'-0" WALL
BUTTRESS STEEL
STA. 19+11.19 TO STA. 20+31.19

NOTES
For concrete details see Sheet No. 73
For general notes see Sheet No. 94

CONNECTICUT RIVER FLOOD CONTROL			
HARTFORD DIKE			
RIVERFRONT, MORGAN ST. TO STA. 96+73.			
WALL—STA. 19+11.19 TO STA. 20+31.19			
STEEL REINFORCEMENT			
CONNECTICUT RIVER		CONNECTICUT	
IN 135 SHEETS		SCALE: 1/4 IN. = 1 FT.	
SHEET NO. 95		MAY 1940	
U. S. ENGINEER OFFICE, PROVIDENCE, R.I.			
SUBMITTED:		APPROVAL RECOMMENDED:	
DESIGNED BY: <i>J. C. Singwall</i>		DRAWN BY: <i>N.I.</i>	
CHECKED BY: <i>W. M.</i>		FISCAL YEAR 1940	
FILE NO. CT-4-2555		Ht. 587b	

KEY	DATE	REVISION (Indicated by Δ)	REV. BY	CK. BY	AP. BY
	12-31-45	As built revisions			