



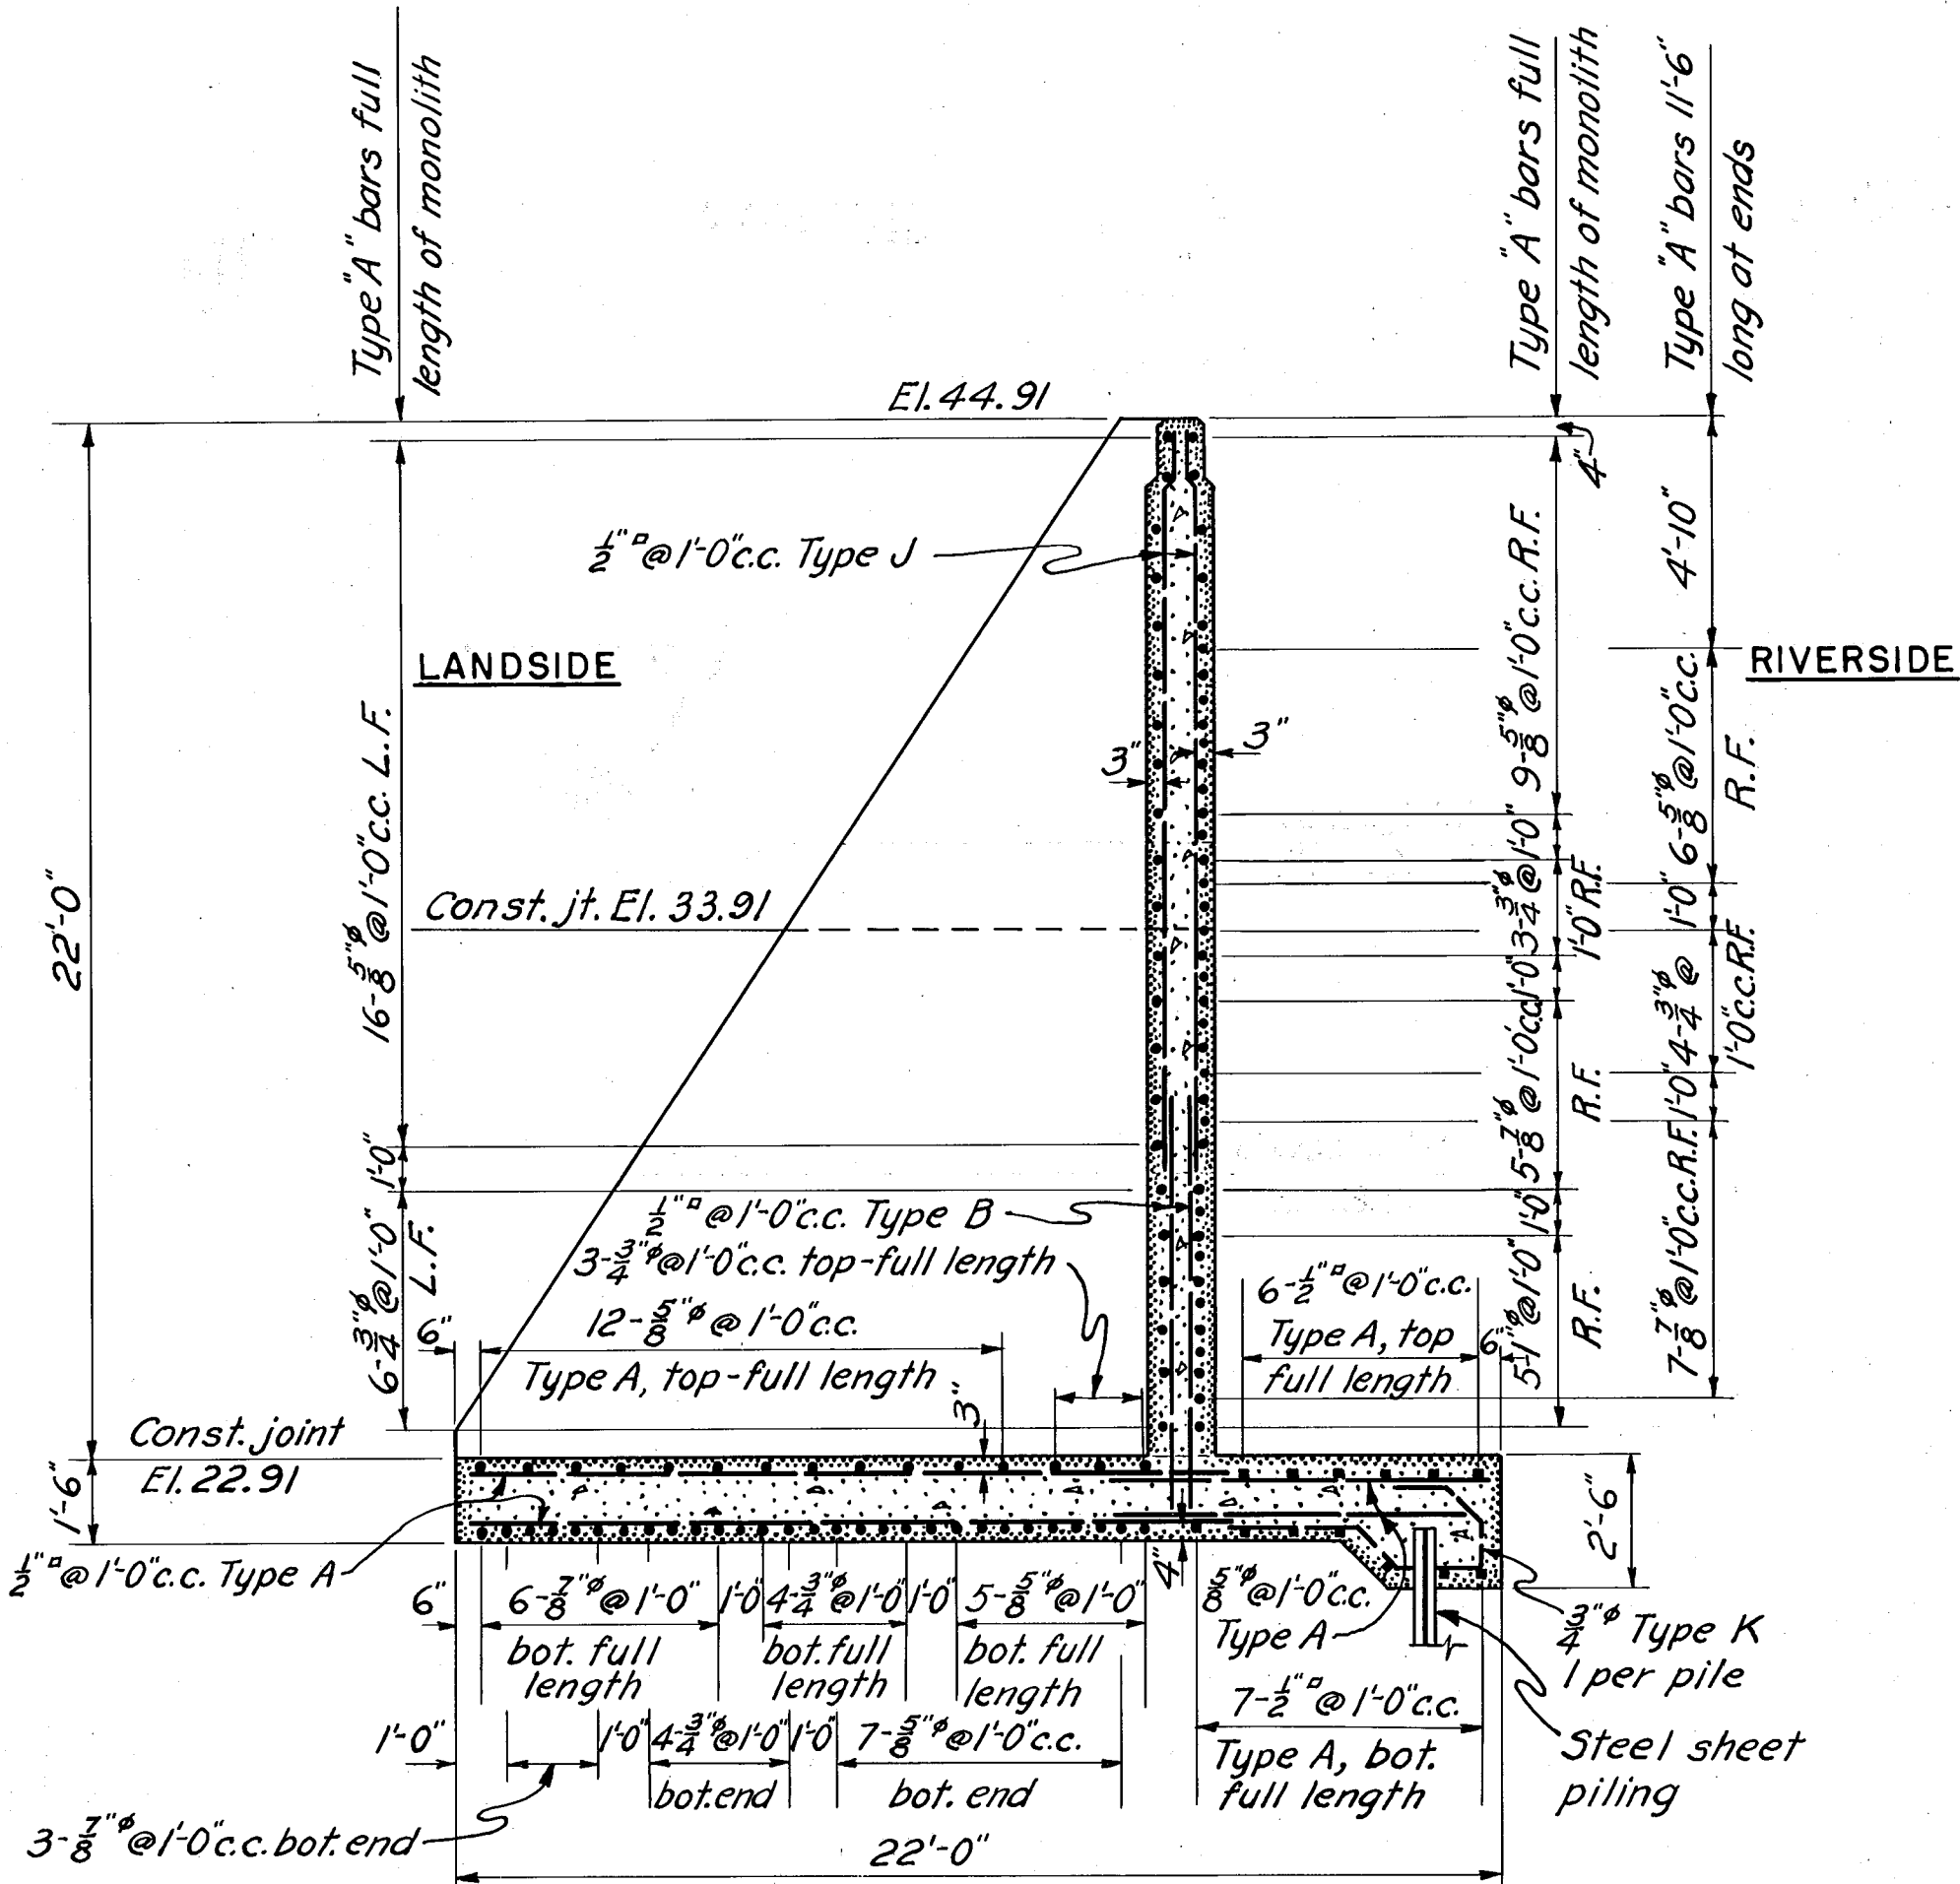


22'-0" WALL

STA. 21+11.19 TO STA. 21+51.19
STEM AND BASE STEEL

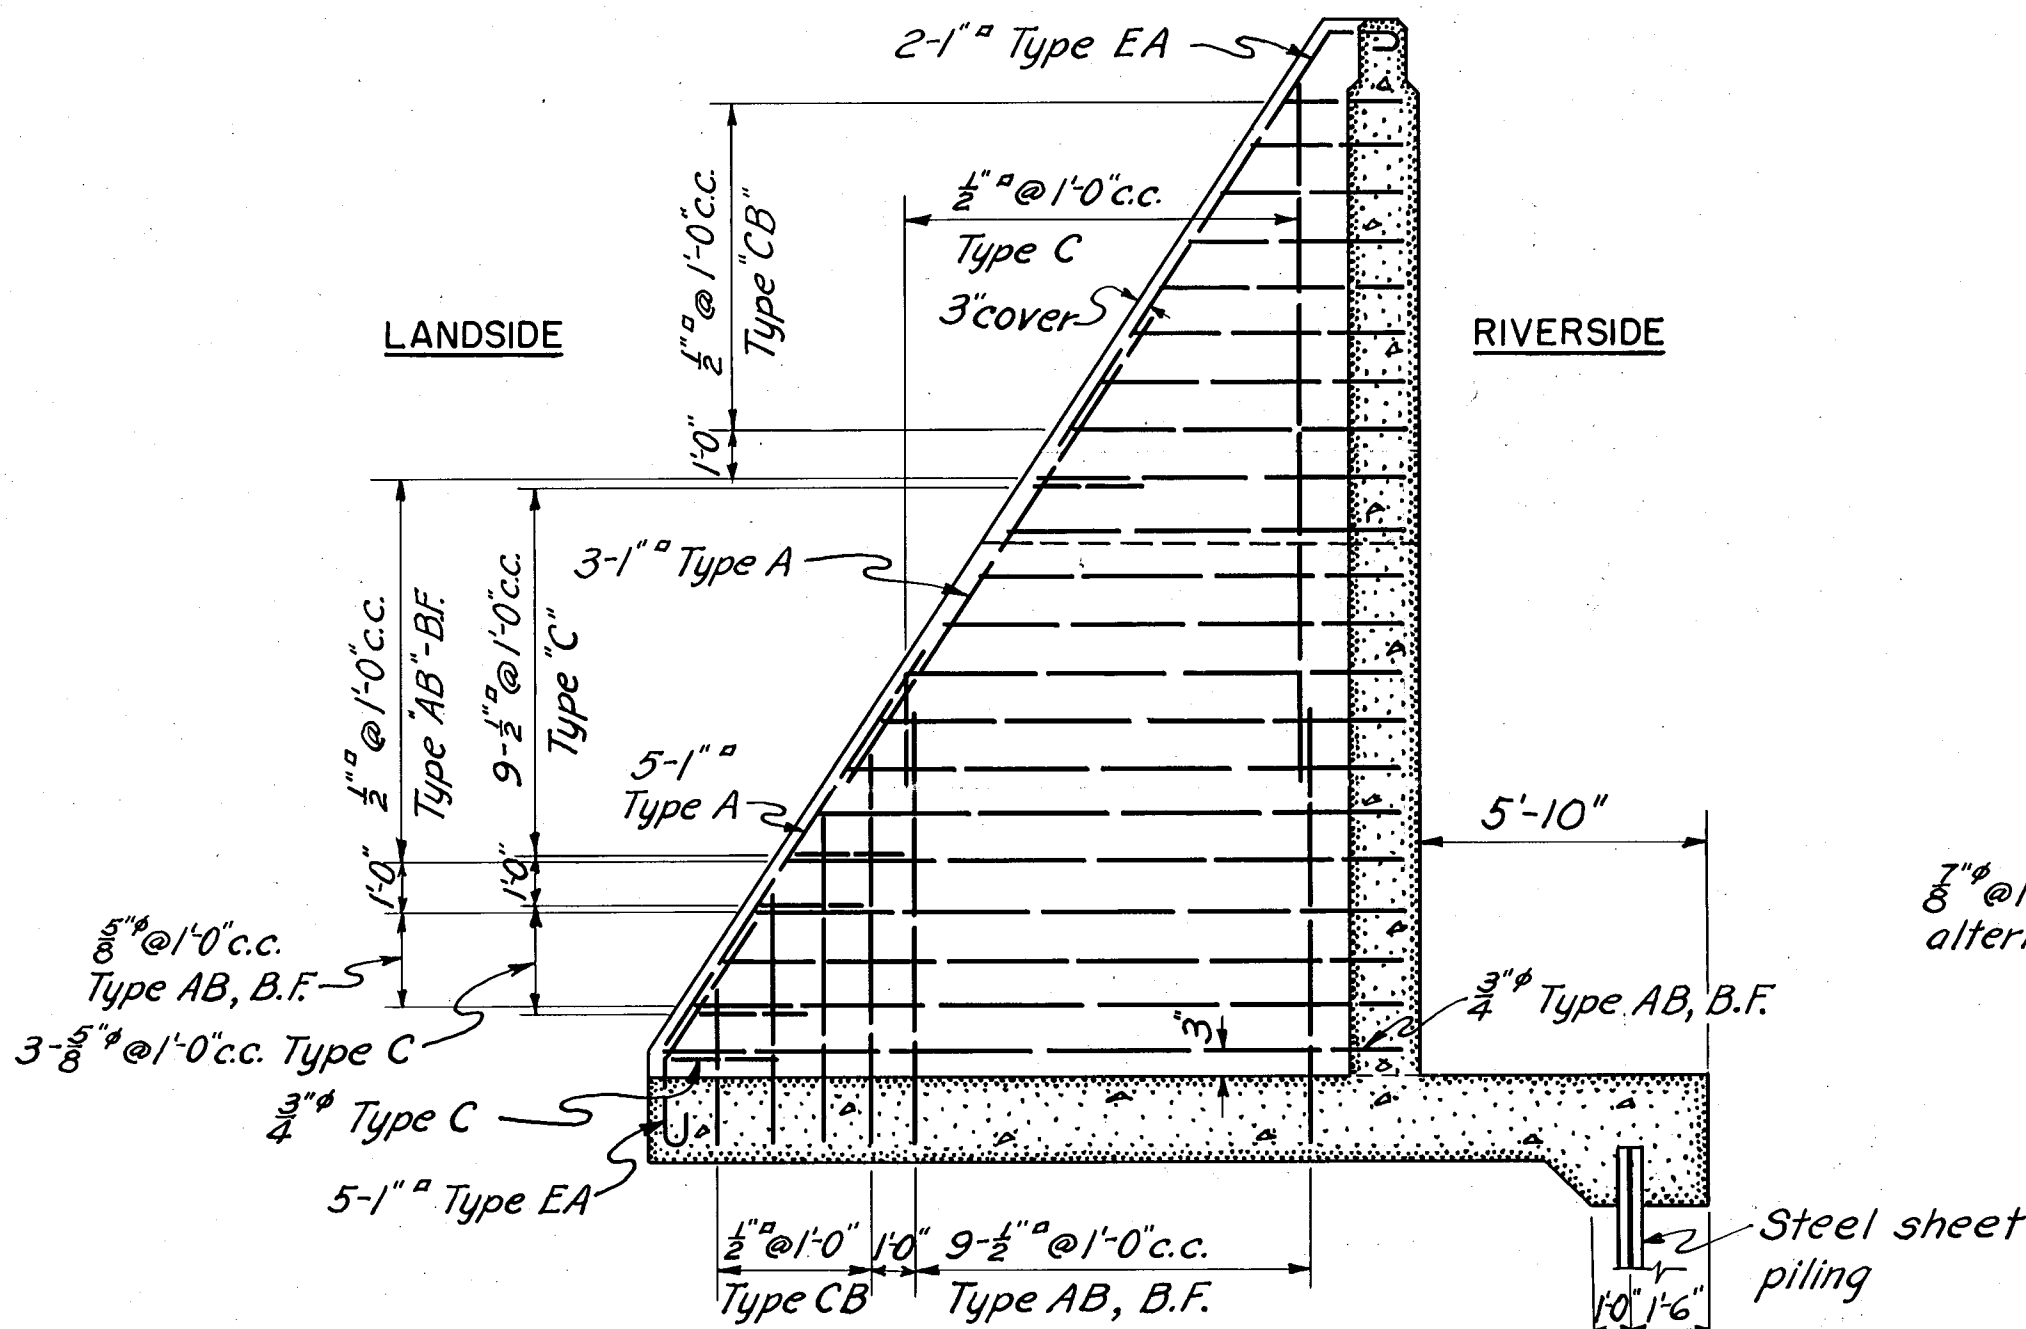

22'-0" WALL

STA. 21+11.19 TO STA. 21+51.19
BUTTRESS STEEL

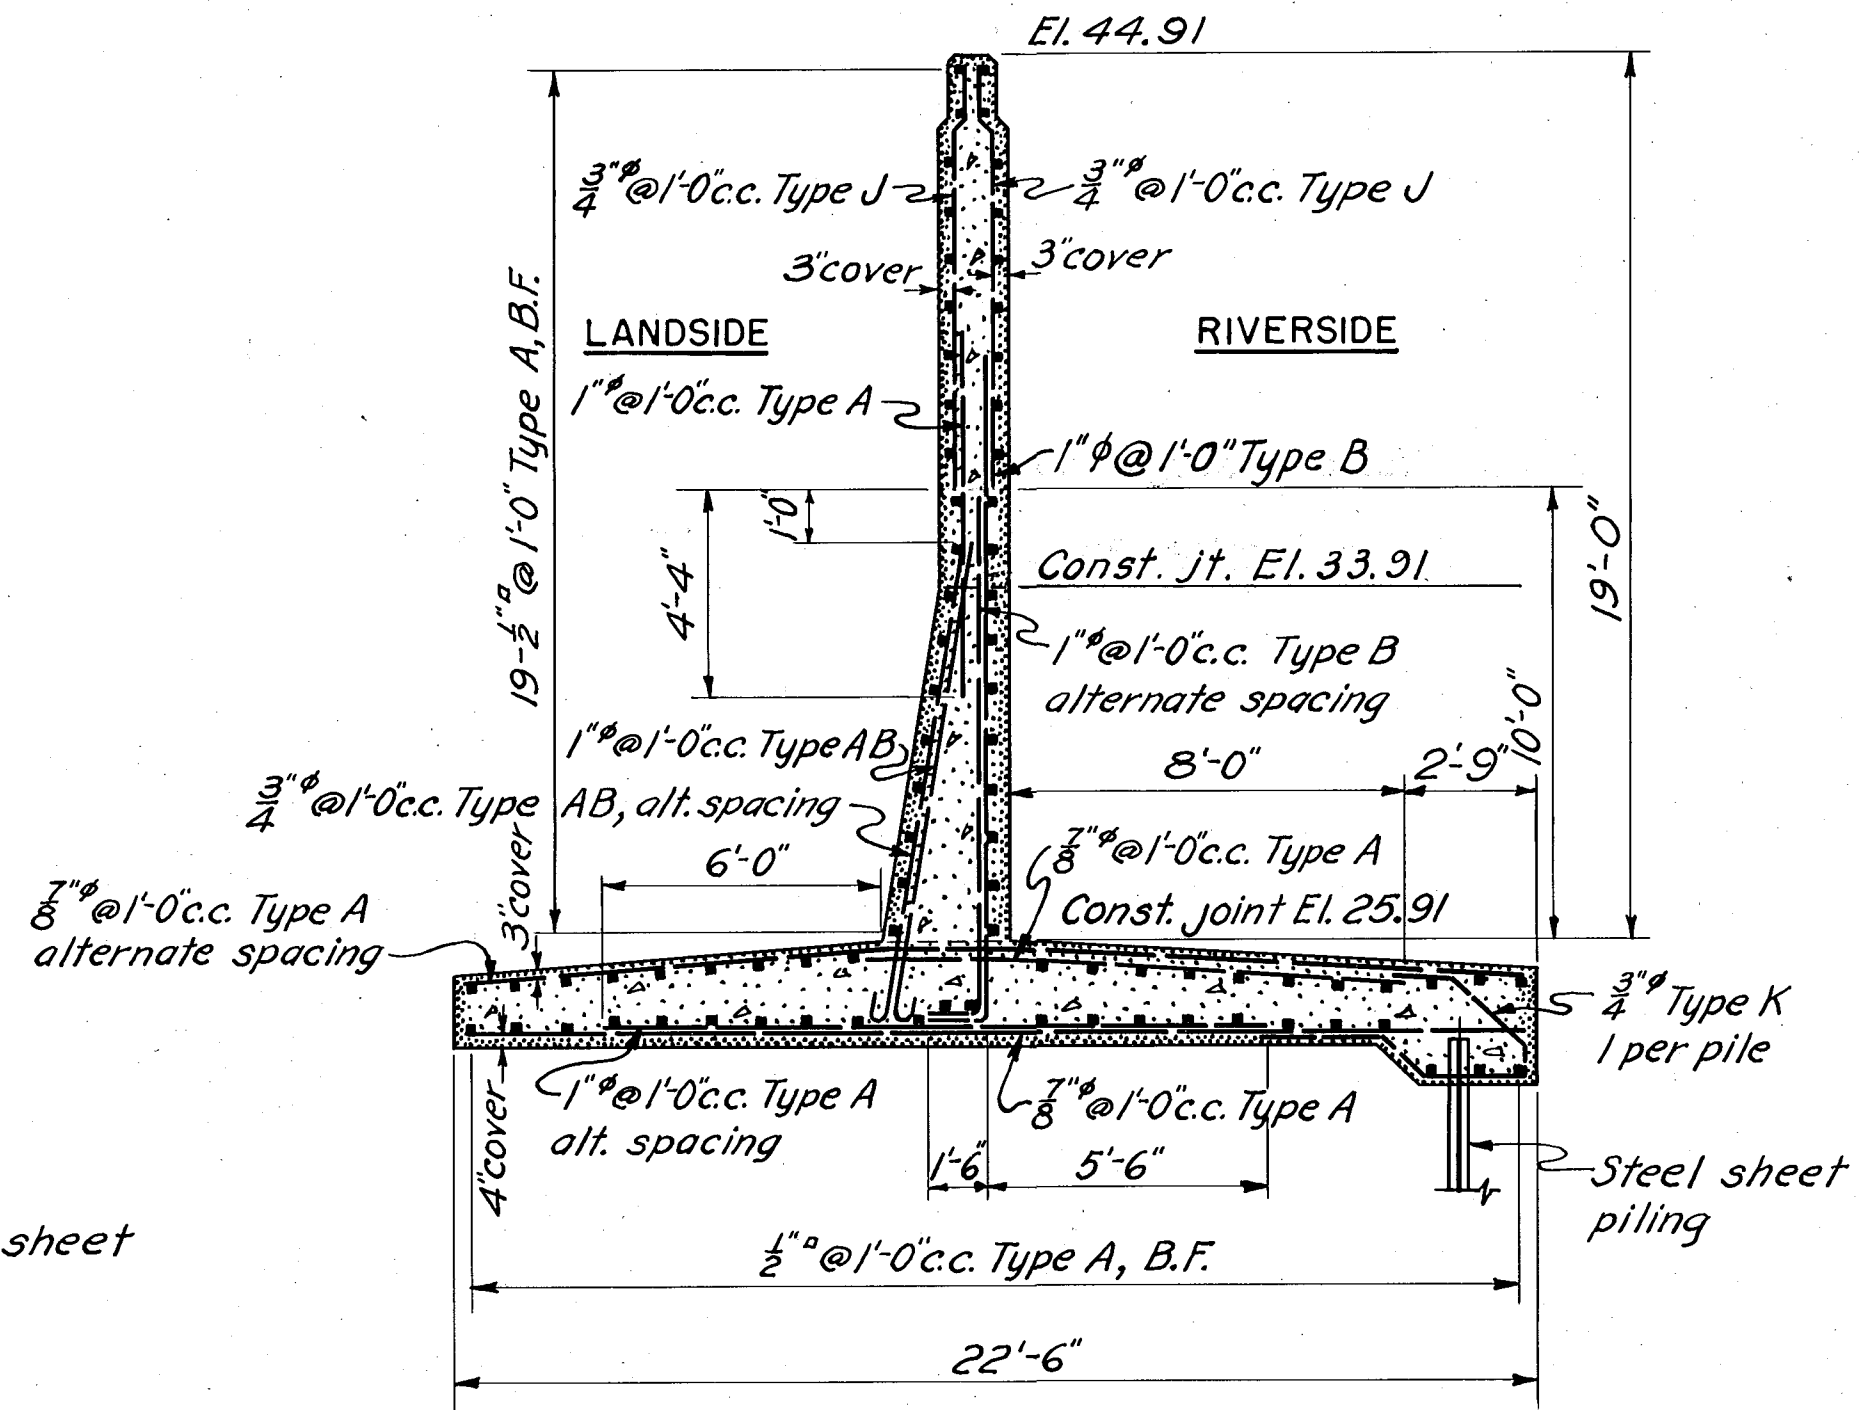

18'-6" WALL

STA. 21+51.19 TO STA. 21+76.19

NOTE

For concrete details see Sheet No. 73
For general notes see Sheet No. 94

KEY	DATE	REVISION (Indicated by Δ)	REV. BY	CK. BY	AP. BY
	12-31-45	As built revisions.			

CONNECTICUT RIVER FLOOD CONTROL		
HARTFORD DIKE		
RIVERFRONT, MORGAN ST. TO STA. 96+73.		
WALL - STA. 21+11.19 TO STA. 21+76.19		
STEEL REINFORCEMENT		
CONNECTICUT RIVER		CONNECTICUT
IN 135 SHEETS	SCALE: 1/4 IN. = 1 FT.	SHEET NO. 97
U.S. ENGINEER OFFICE, PROVIDENCE, R.I., MAY 1940		
SUBMITTED:	APPROVAL RECOMMENDED:	APPROVED:
Senior Engineer	Principal Engineer	Chief of Engineering Div.
Head Design Section	Chief of Engineering Div.	District Engineer
DESIGNED BY	DRAWN BY	FISCAL YEAR 1940
J.C. Duggan	J.H.L. & R.S.M.	FILE NO. CT-4-2557
ASSOC. ENGINEER	CHECKED BY	