
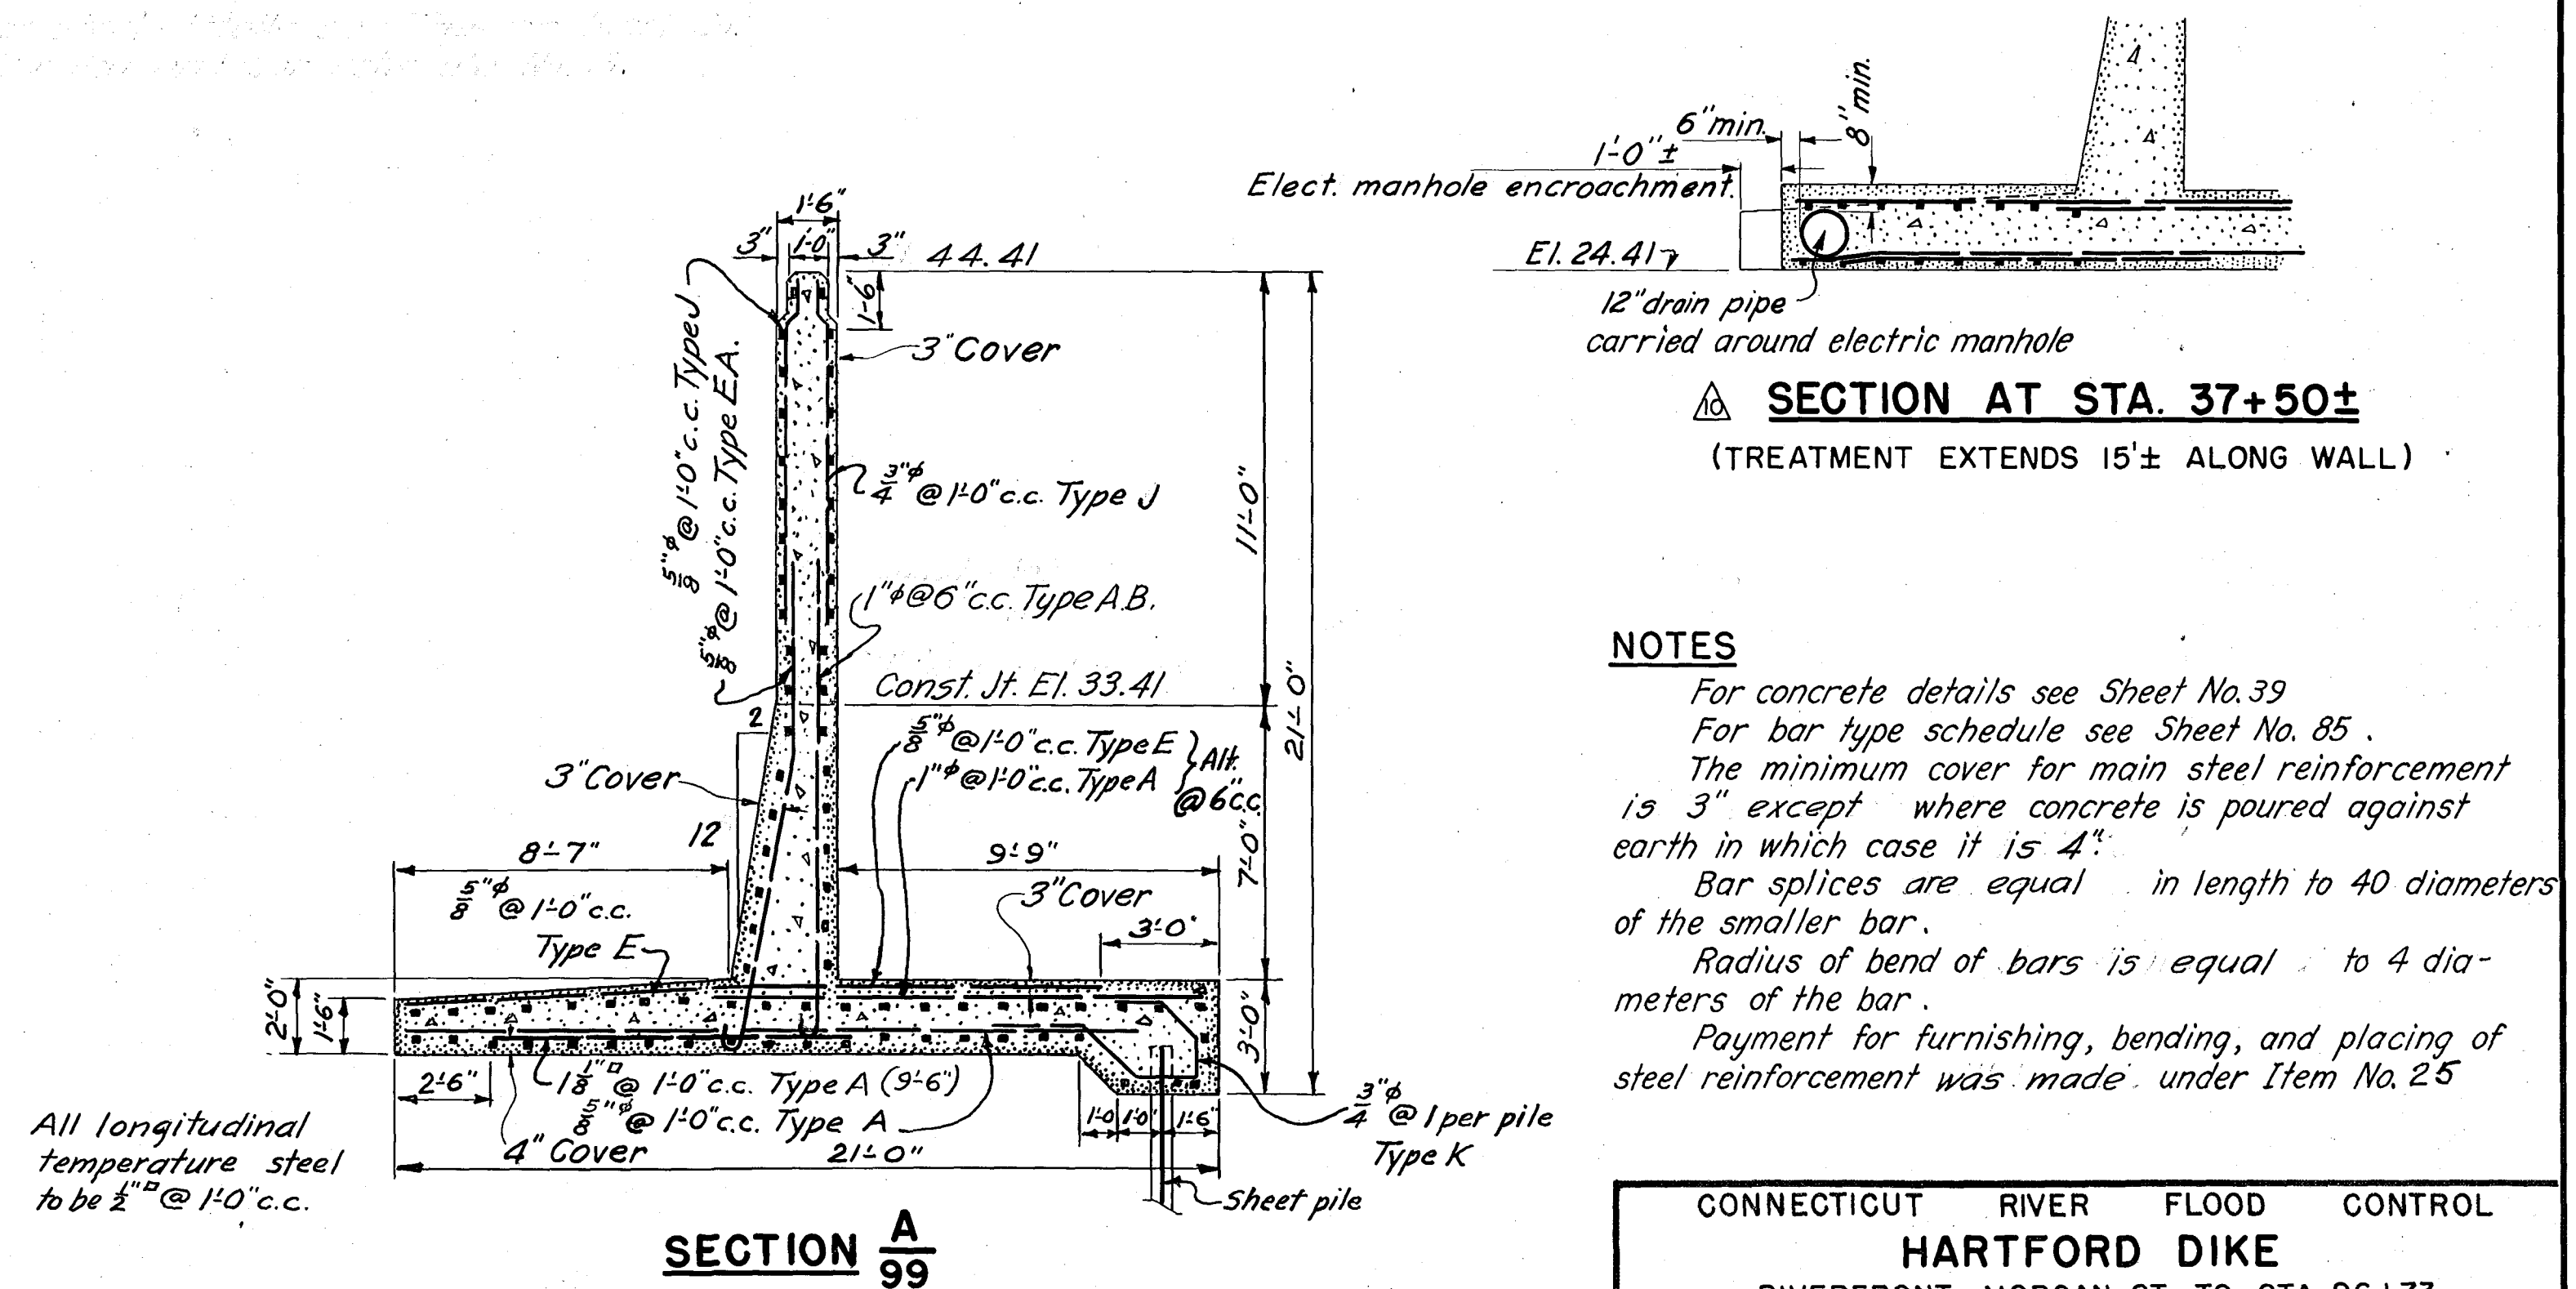


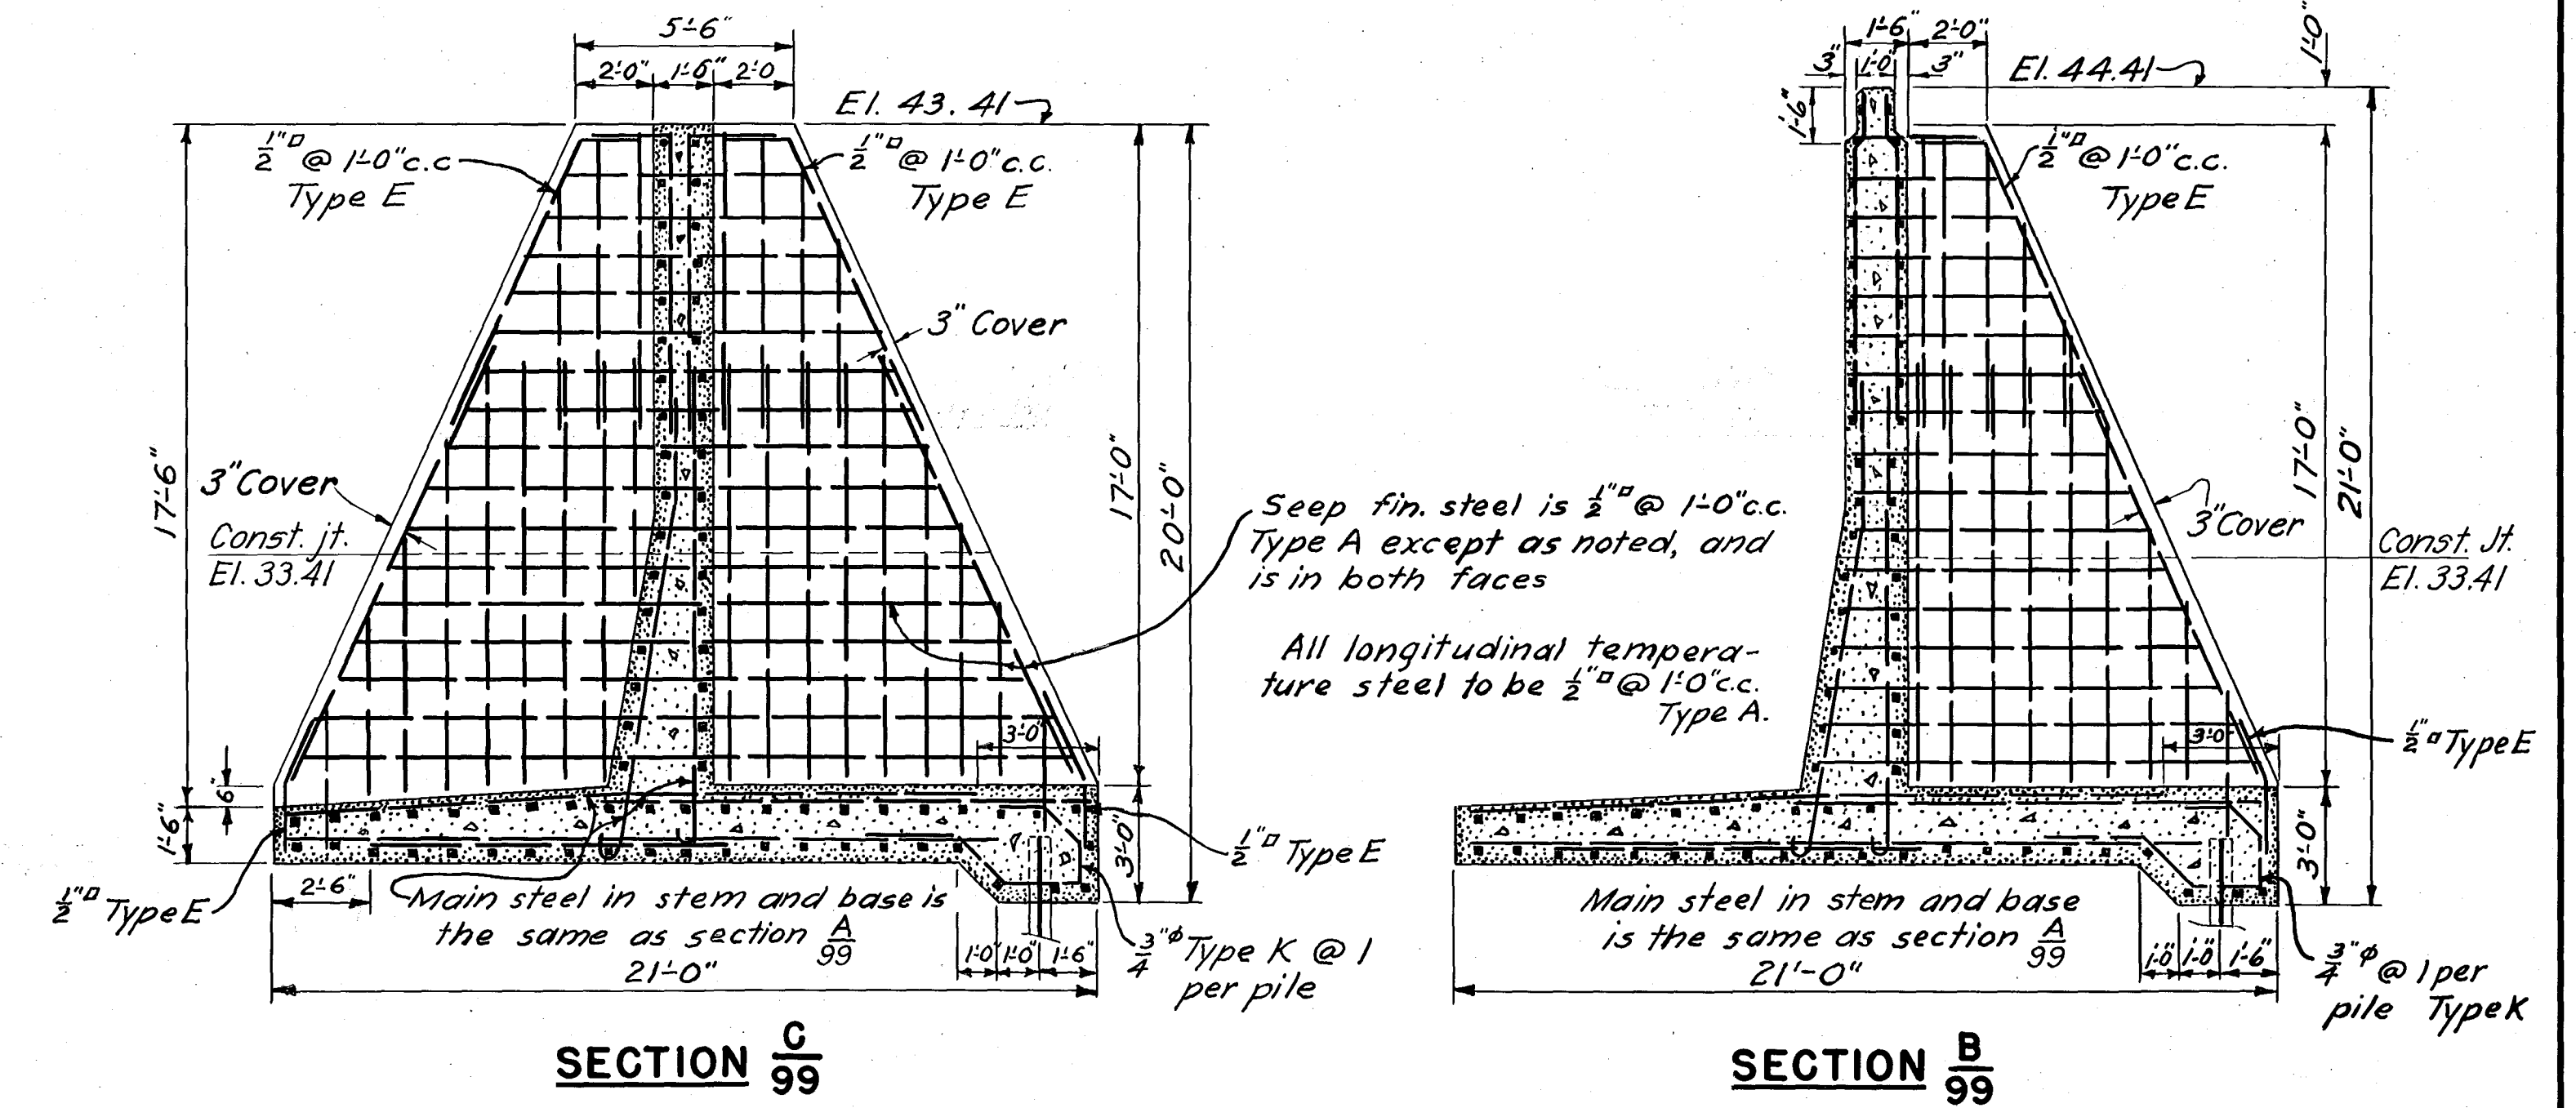

NOTES

For concrete details see Sheet No.39
For bar type schedule see Sheet No. 85 .
The minimum cover for main steel reinforcement is 3" except where concrete is poured against earth in which case it is 4".
Bar splices are equal in length to 40 diameters of the smaller bar .
Radius of bend of bars is equal to 4 diameters of the bar .
Payment for furnishing, bending, and placing of steel reinforcement was made under Item No.25

	12/31/45	As built revisions			
Δ	10/6/41	Section added.	R.C.H.	10/6	2M
KEY	DATE	REVISION (Indicated by Δ)	REV. BY	OK. BY	AP. BY

CONNECTICUT RIVER FLOOD CONTROL		
HARTFORD DIKE RIVERFRONT, MORGAN ST. TO STA. 96+73 CUT-OFF WALL AND REGULAR WALL STA. 35+54 TO STA. 38+21		
CONNECTICUT RIVER		CONNECTICUT
IN 135 SHEETS	SCALE, 1/4 IN. = 1 FT.	SHEET NO. 99
U.S. ENGINEERING OFFICE, PROVIDENCE, R.I., MAY 1940		
SUBMITTED: <i>Charles B. Rice</i> SENIOR ENGINEER HEAD, DESIGN SECTION	APPROVAL RECOMMENDED: <i>J. S. Burns</i> PRINCIPAL ENGINEER CHIEF, F.C. ENGINEERING DIV.	APPROVED: <i>W. C. Clegg</i> LT. COL., CORPS OF ENGINEERS DISTRICT ENGINEER
DESIGNED: <i>J. S. Burns</i> ASSIST. ENGINEER	DRAWN: O.A.K. TRACED: A.H.R. CHECKED: <i>J. S. Burns</i>	FISCAL YEAR 1940 FILE NO. CT-4-2559