




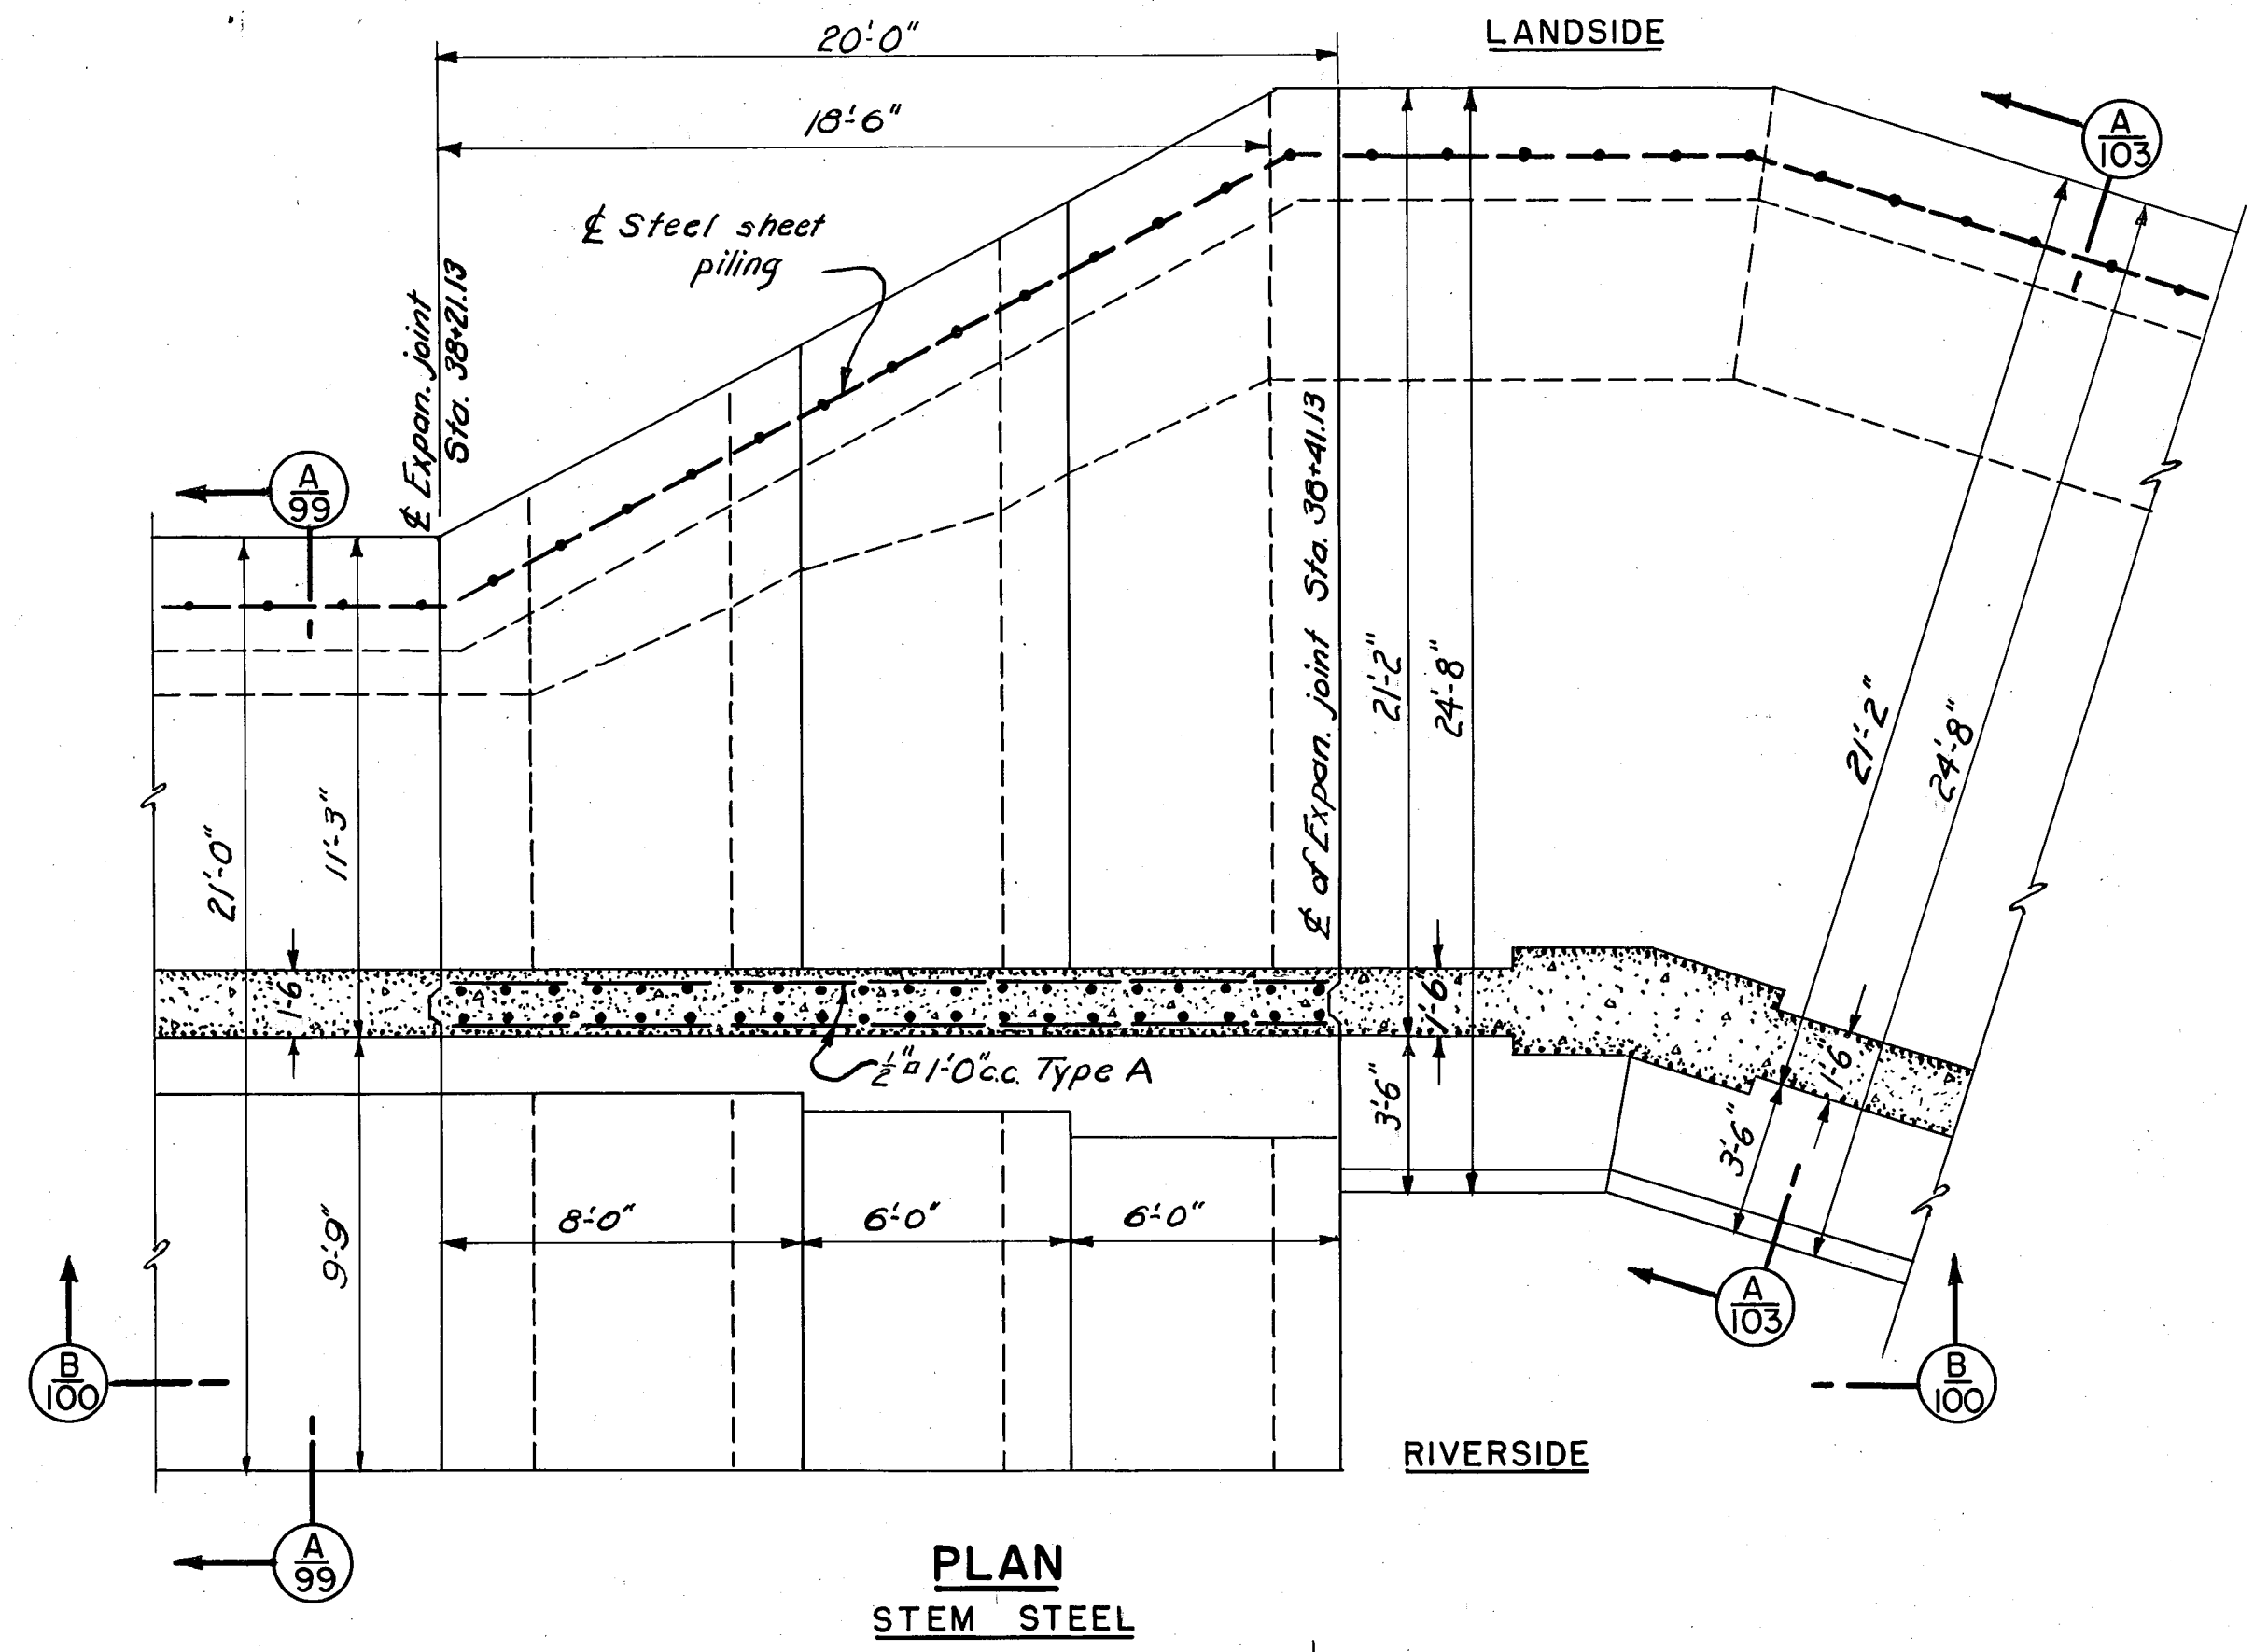

PLAN
STEM STEEL

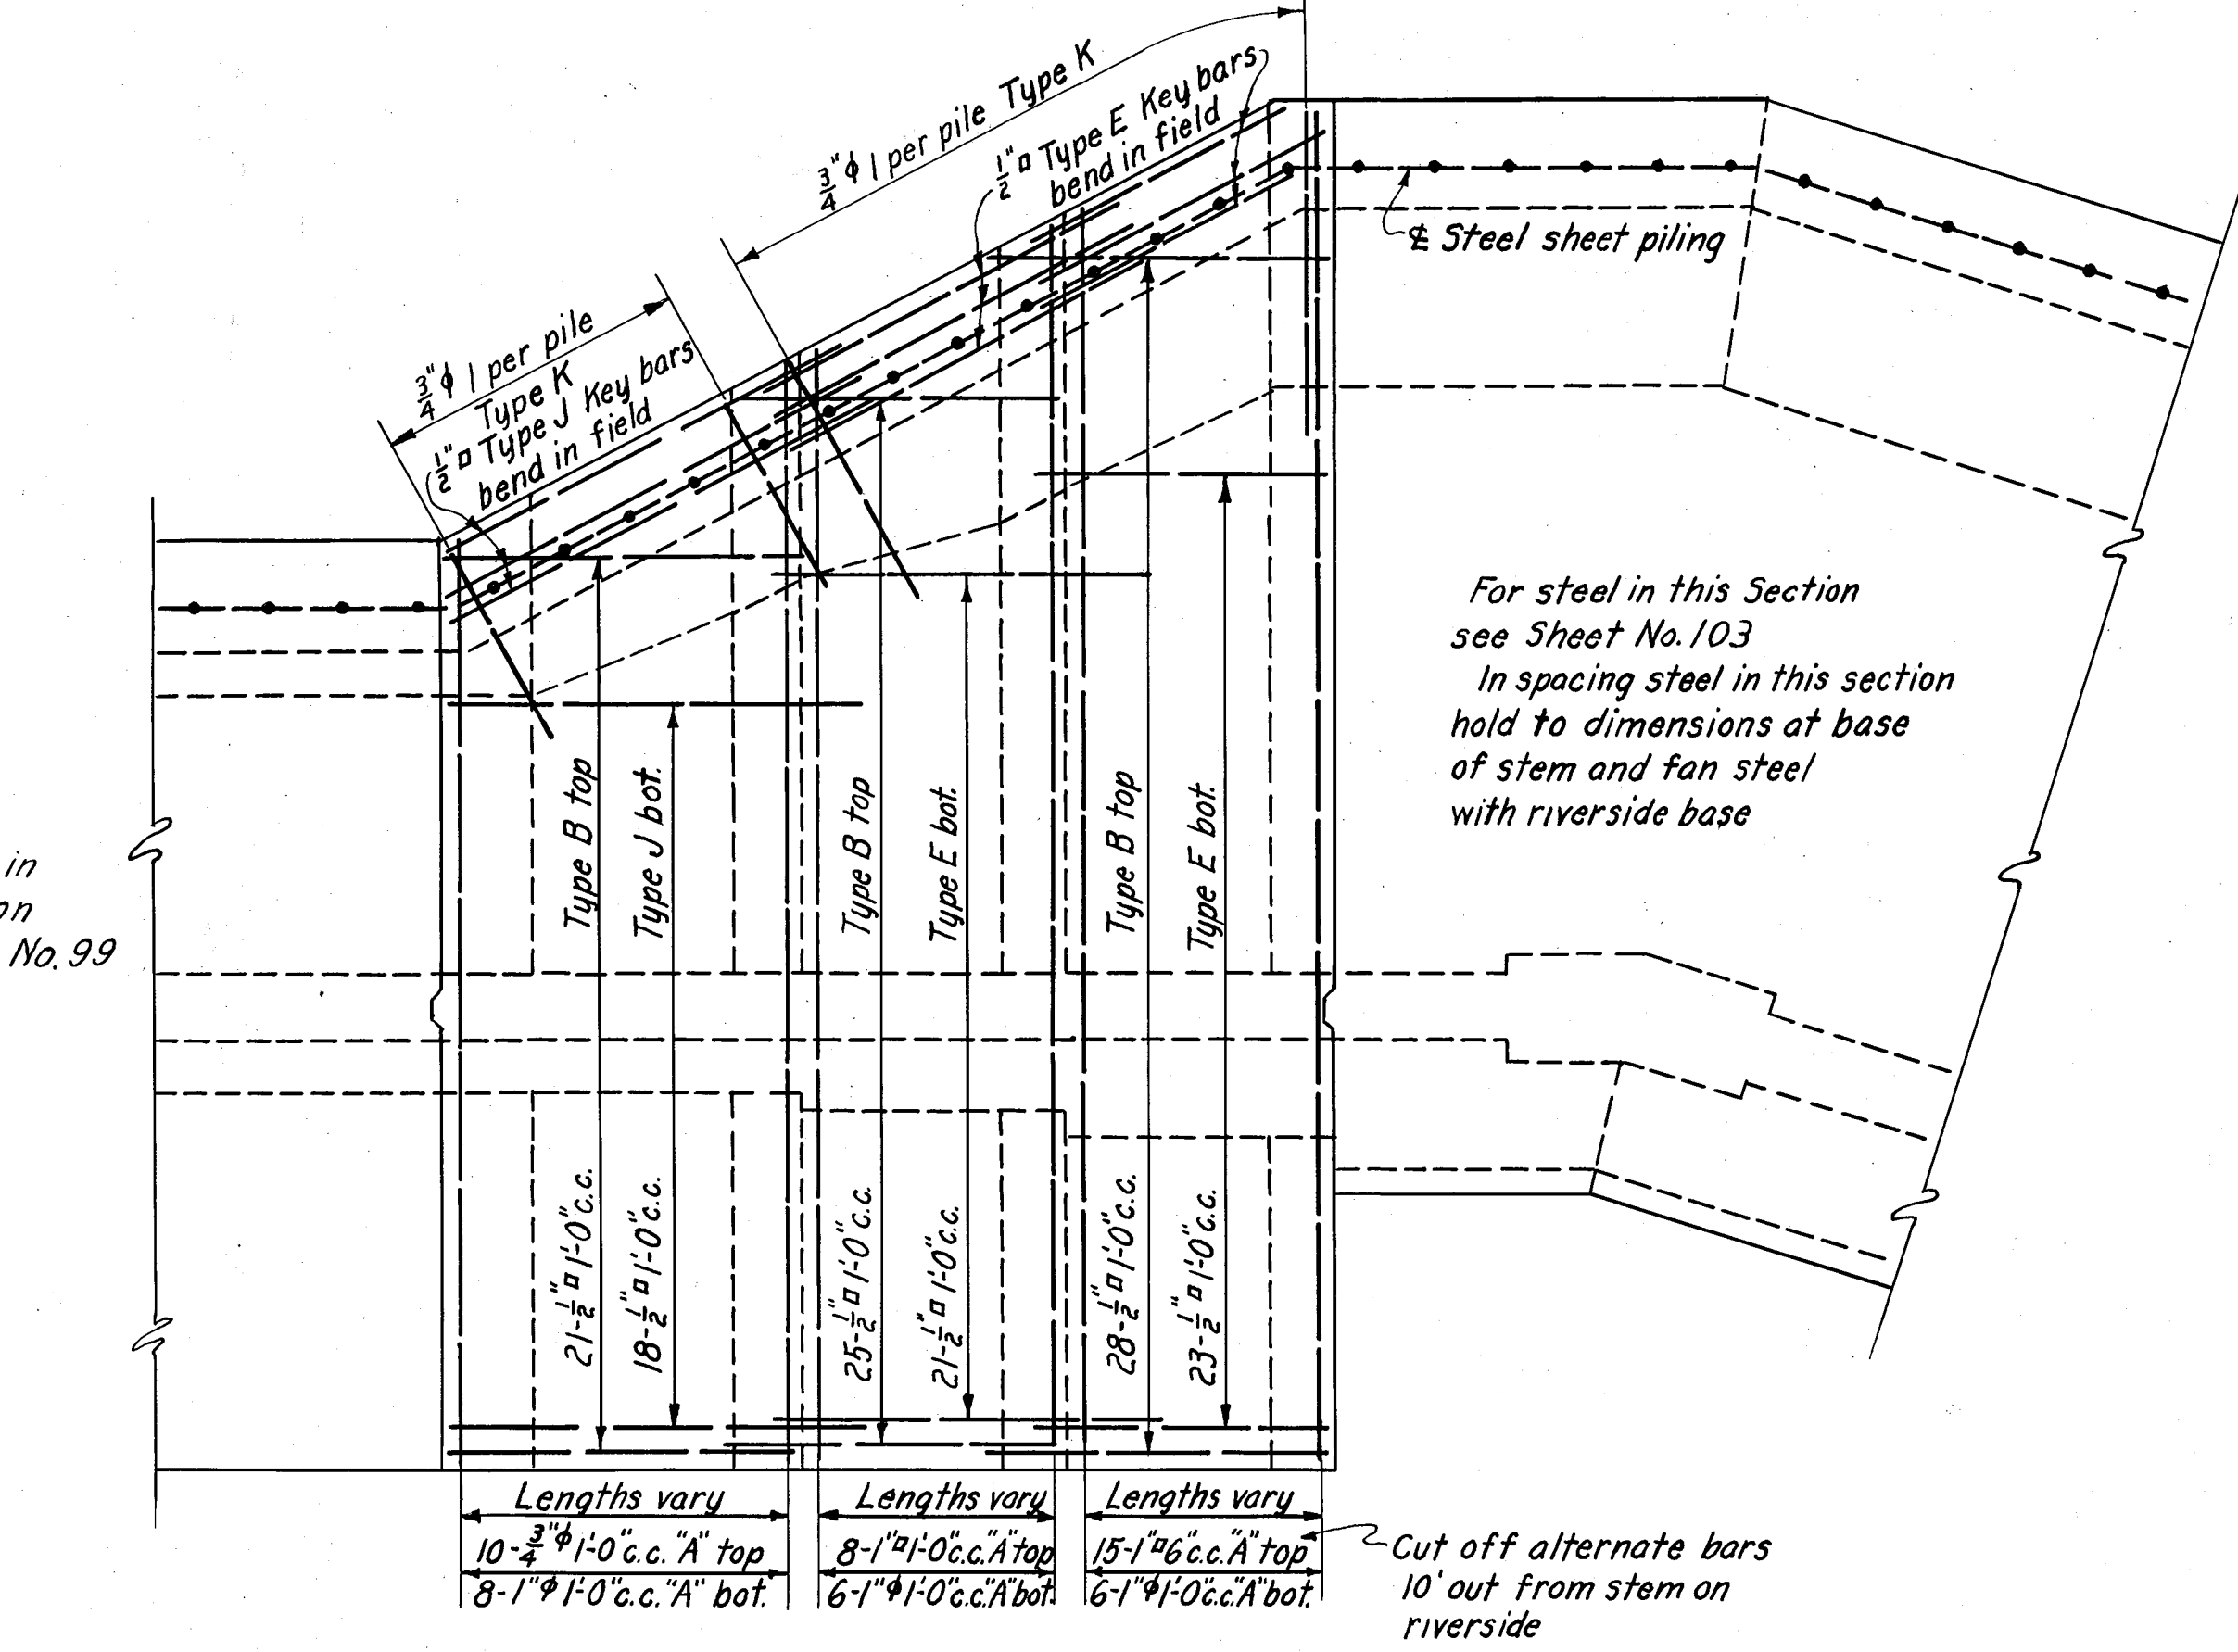

PLAN
STEM STEEL

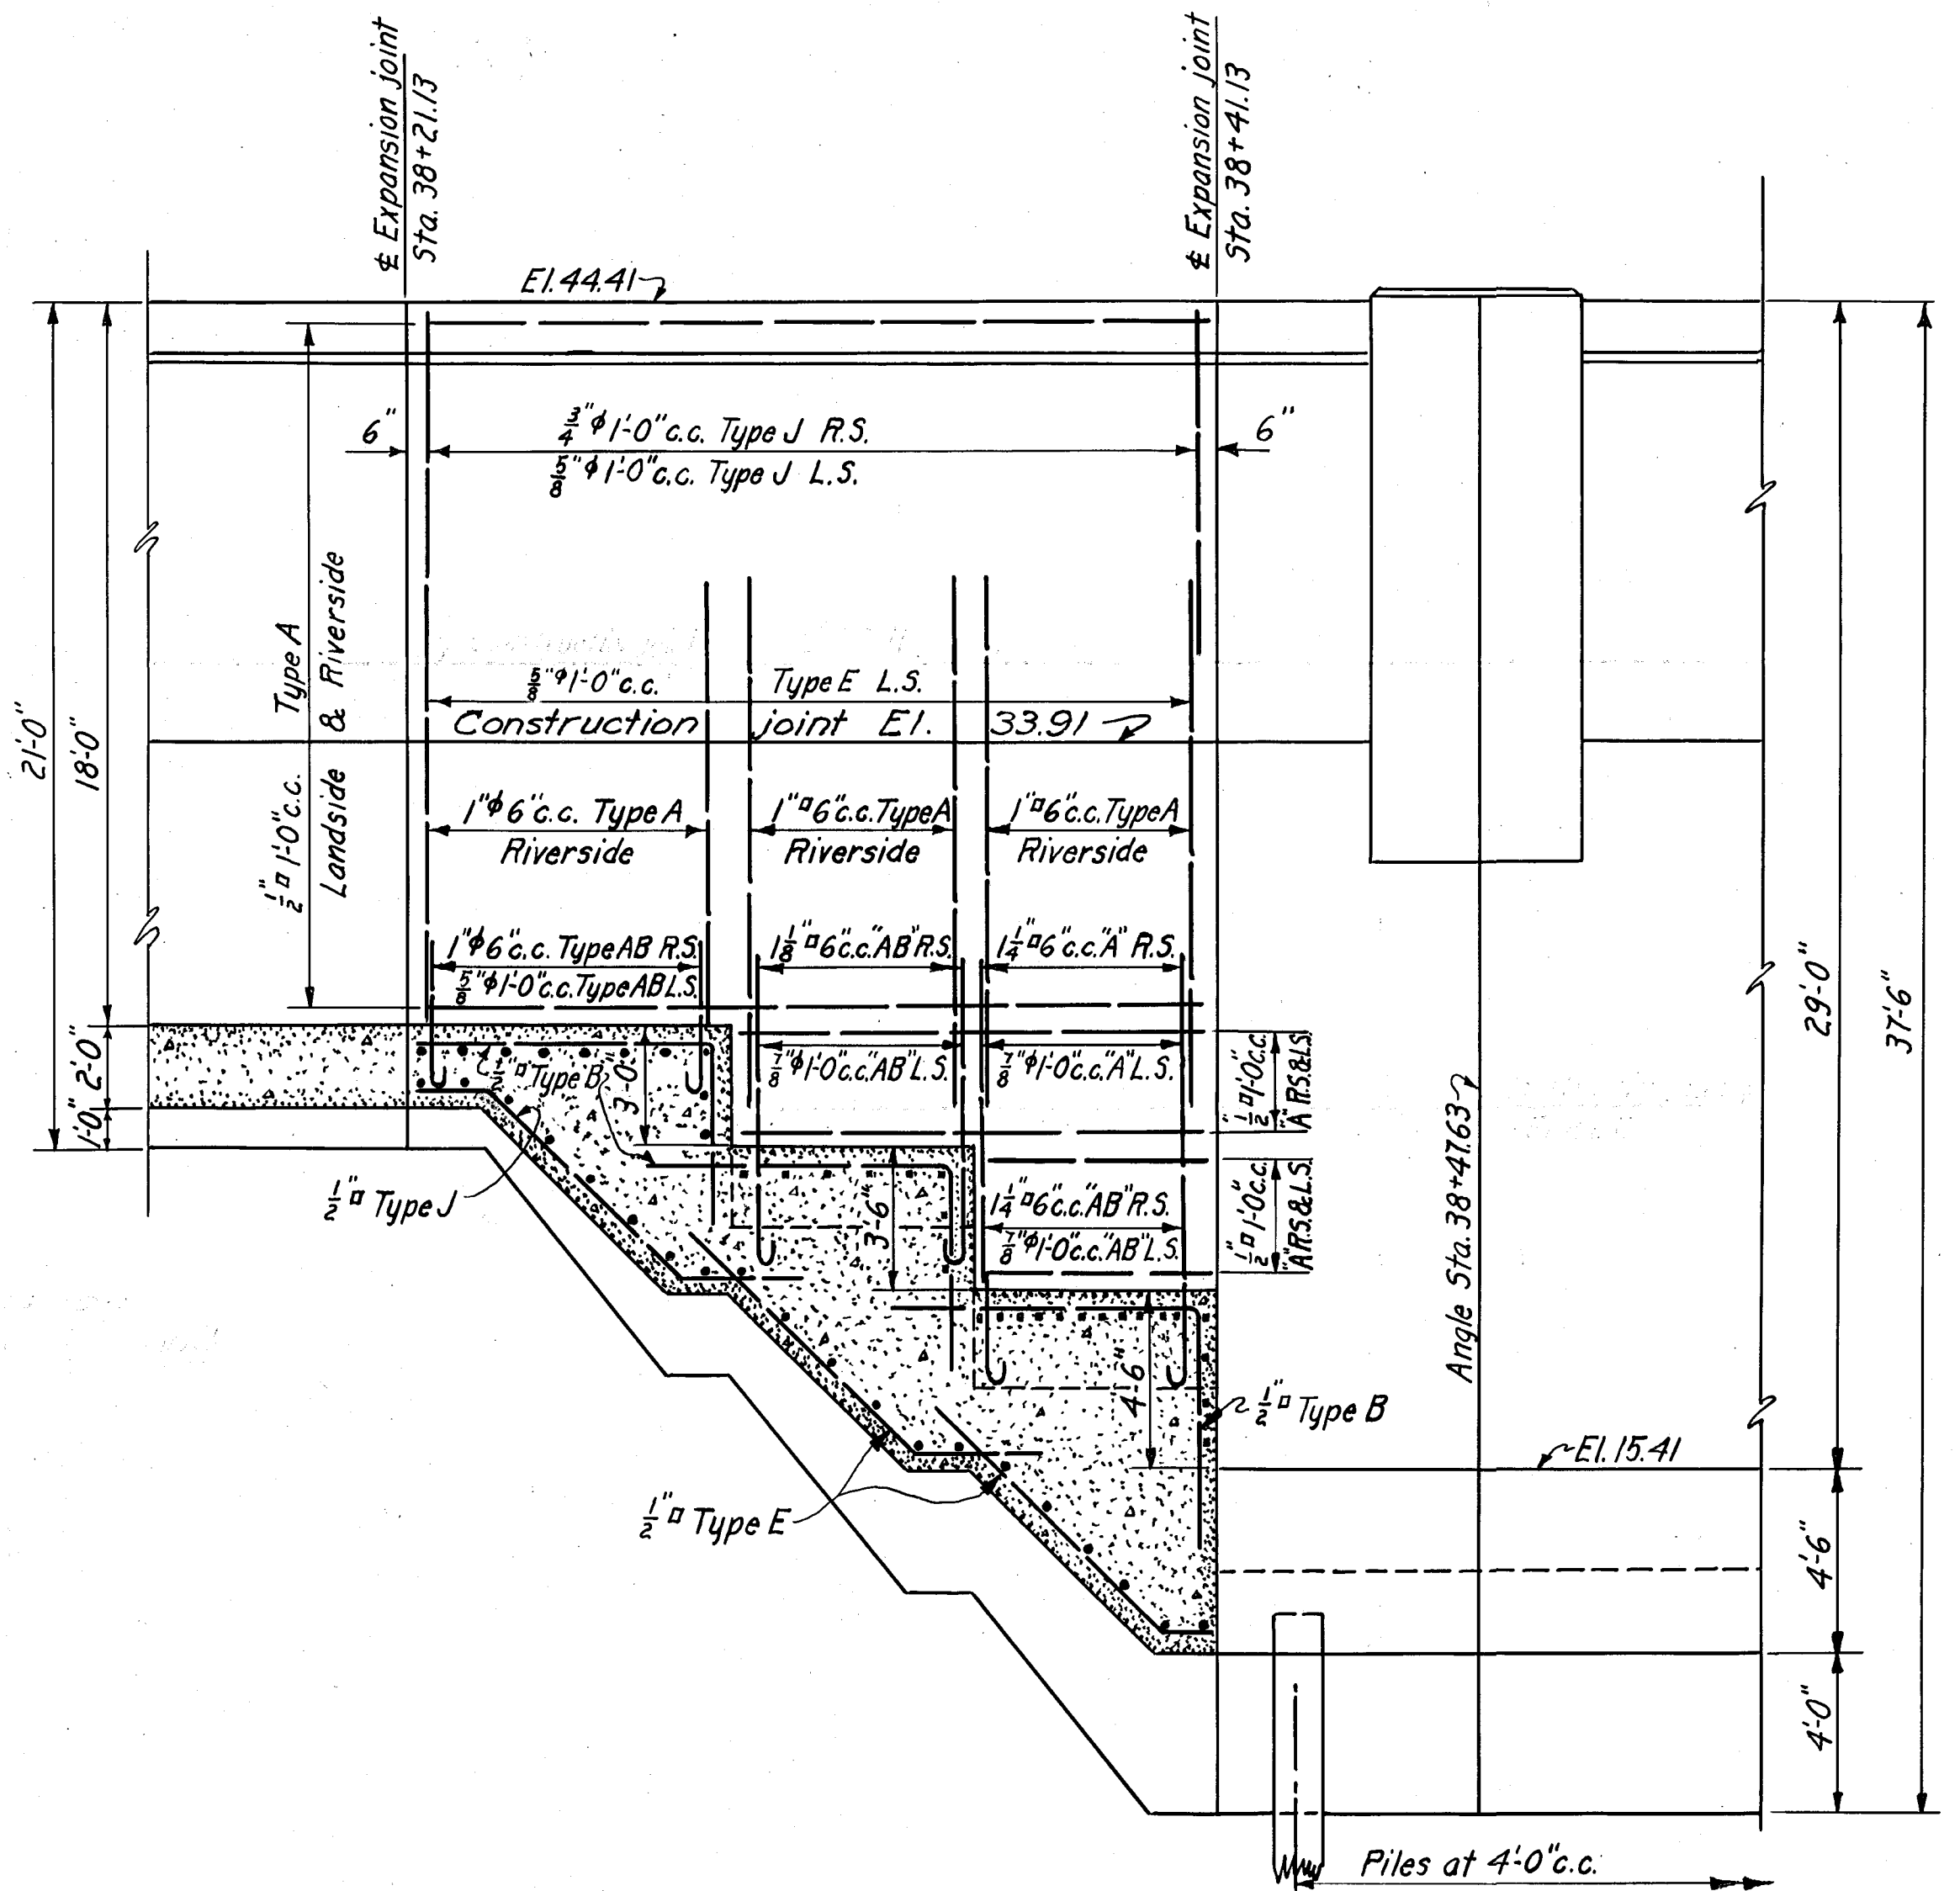

SECTION B
100

NOTES
For concrete details see Sheets No. 40 & 41
For general notes see Sheet No. 99

CONNECTICUT RIVER FLOOD CONTROL			
HARTFORD DIKE			
RIVERFRONT, MORGAN ST. TO STA. 96+73			
WALL DETAILS			
STA. 38+21.13 TO STA. 38+41.13			
CONNECTICUT RIVER		CONNECTICUT	
IN 135 SHEETS		SCALE 1/4 IN. = 1 FT.	
SHEET NO. 100		SHEET NO. 100	
U. S. ENGINEER OFFICE, PROVIDENCE, R. I., MAY 1940			
SUBMITTED:		APPROVAL RECOMMENDED:	
DESIGNED:		CHECKED:	
DRAWN:		FISCAL YEAR 1940	
FILE NO. CT-4-2560		FILE NO. CT-4-2560	

KEY	DATE	REVISION (Indicated by Δ)	REV. BY	CK. BY	AP. BY
	12-31-45	As built revisions			