



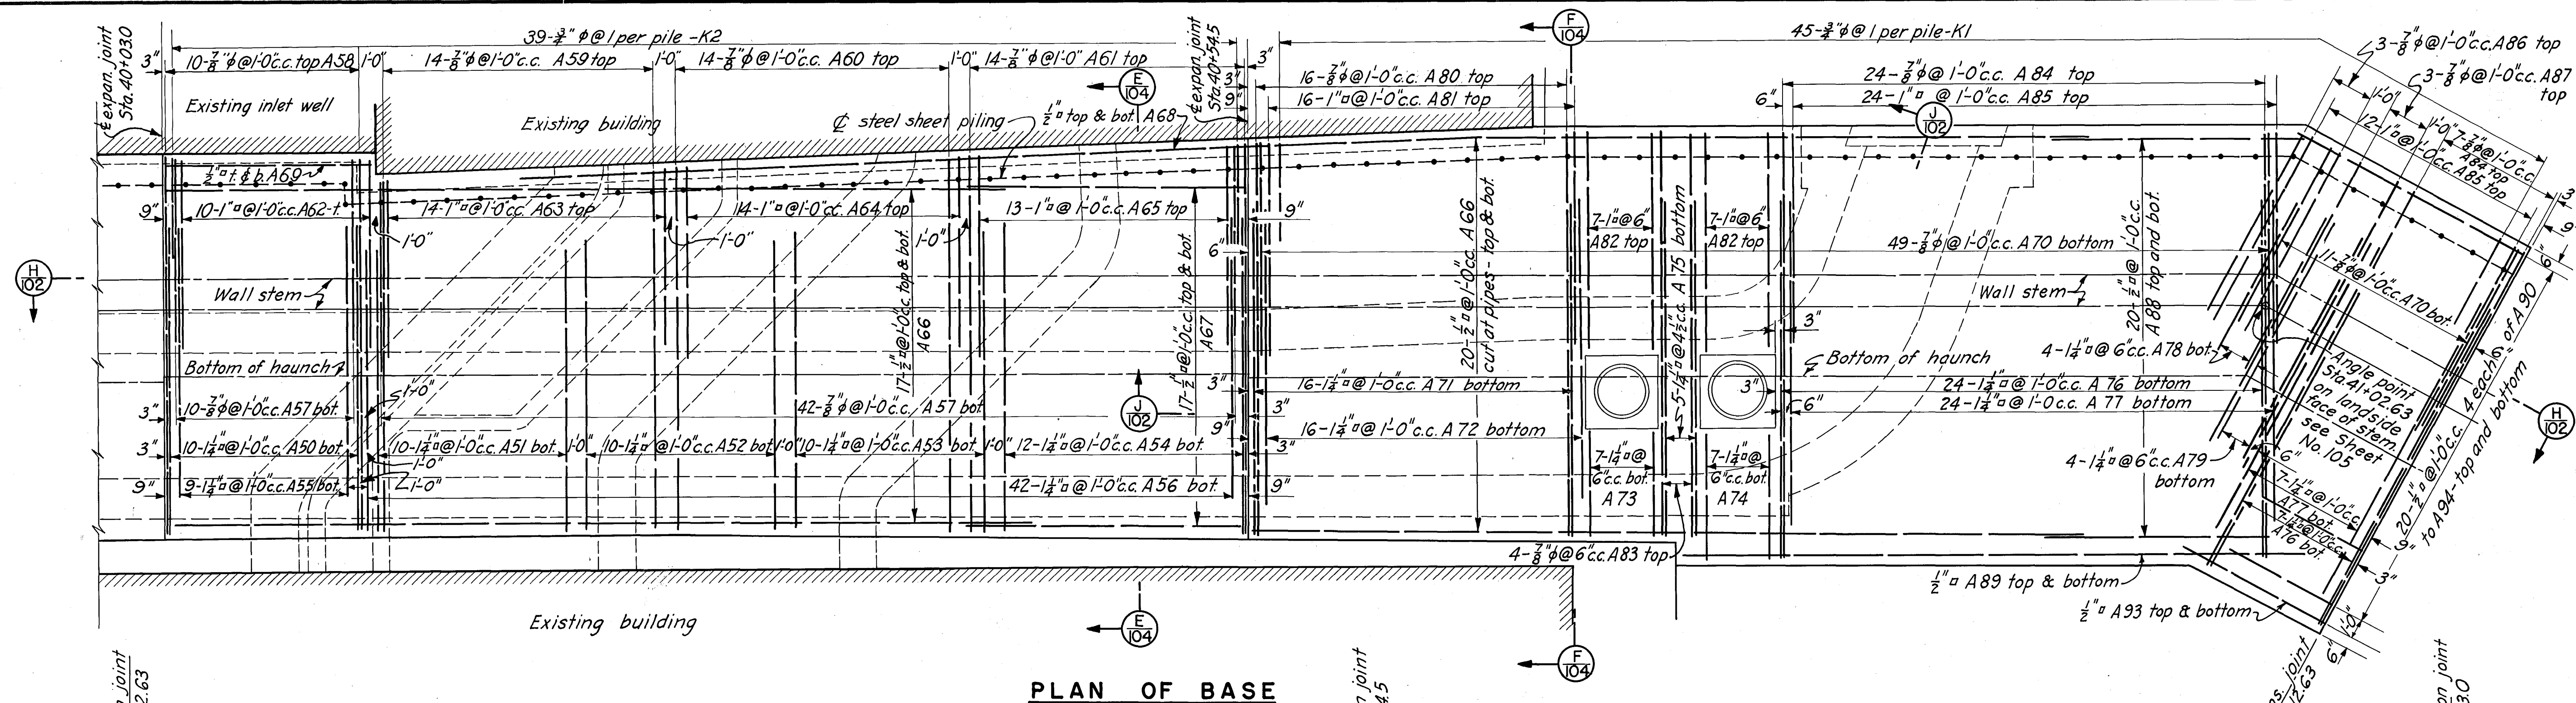

PLAN OF BASE

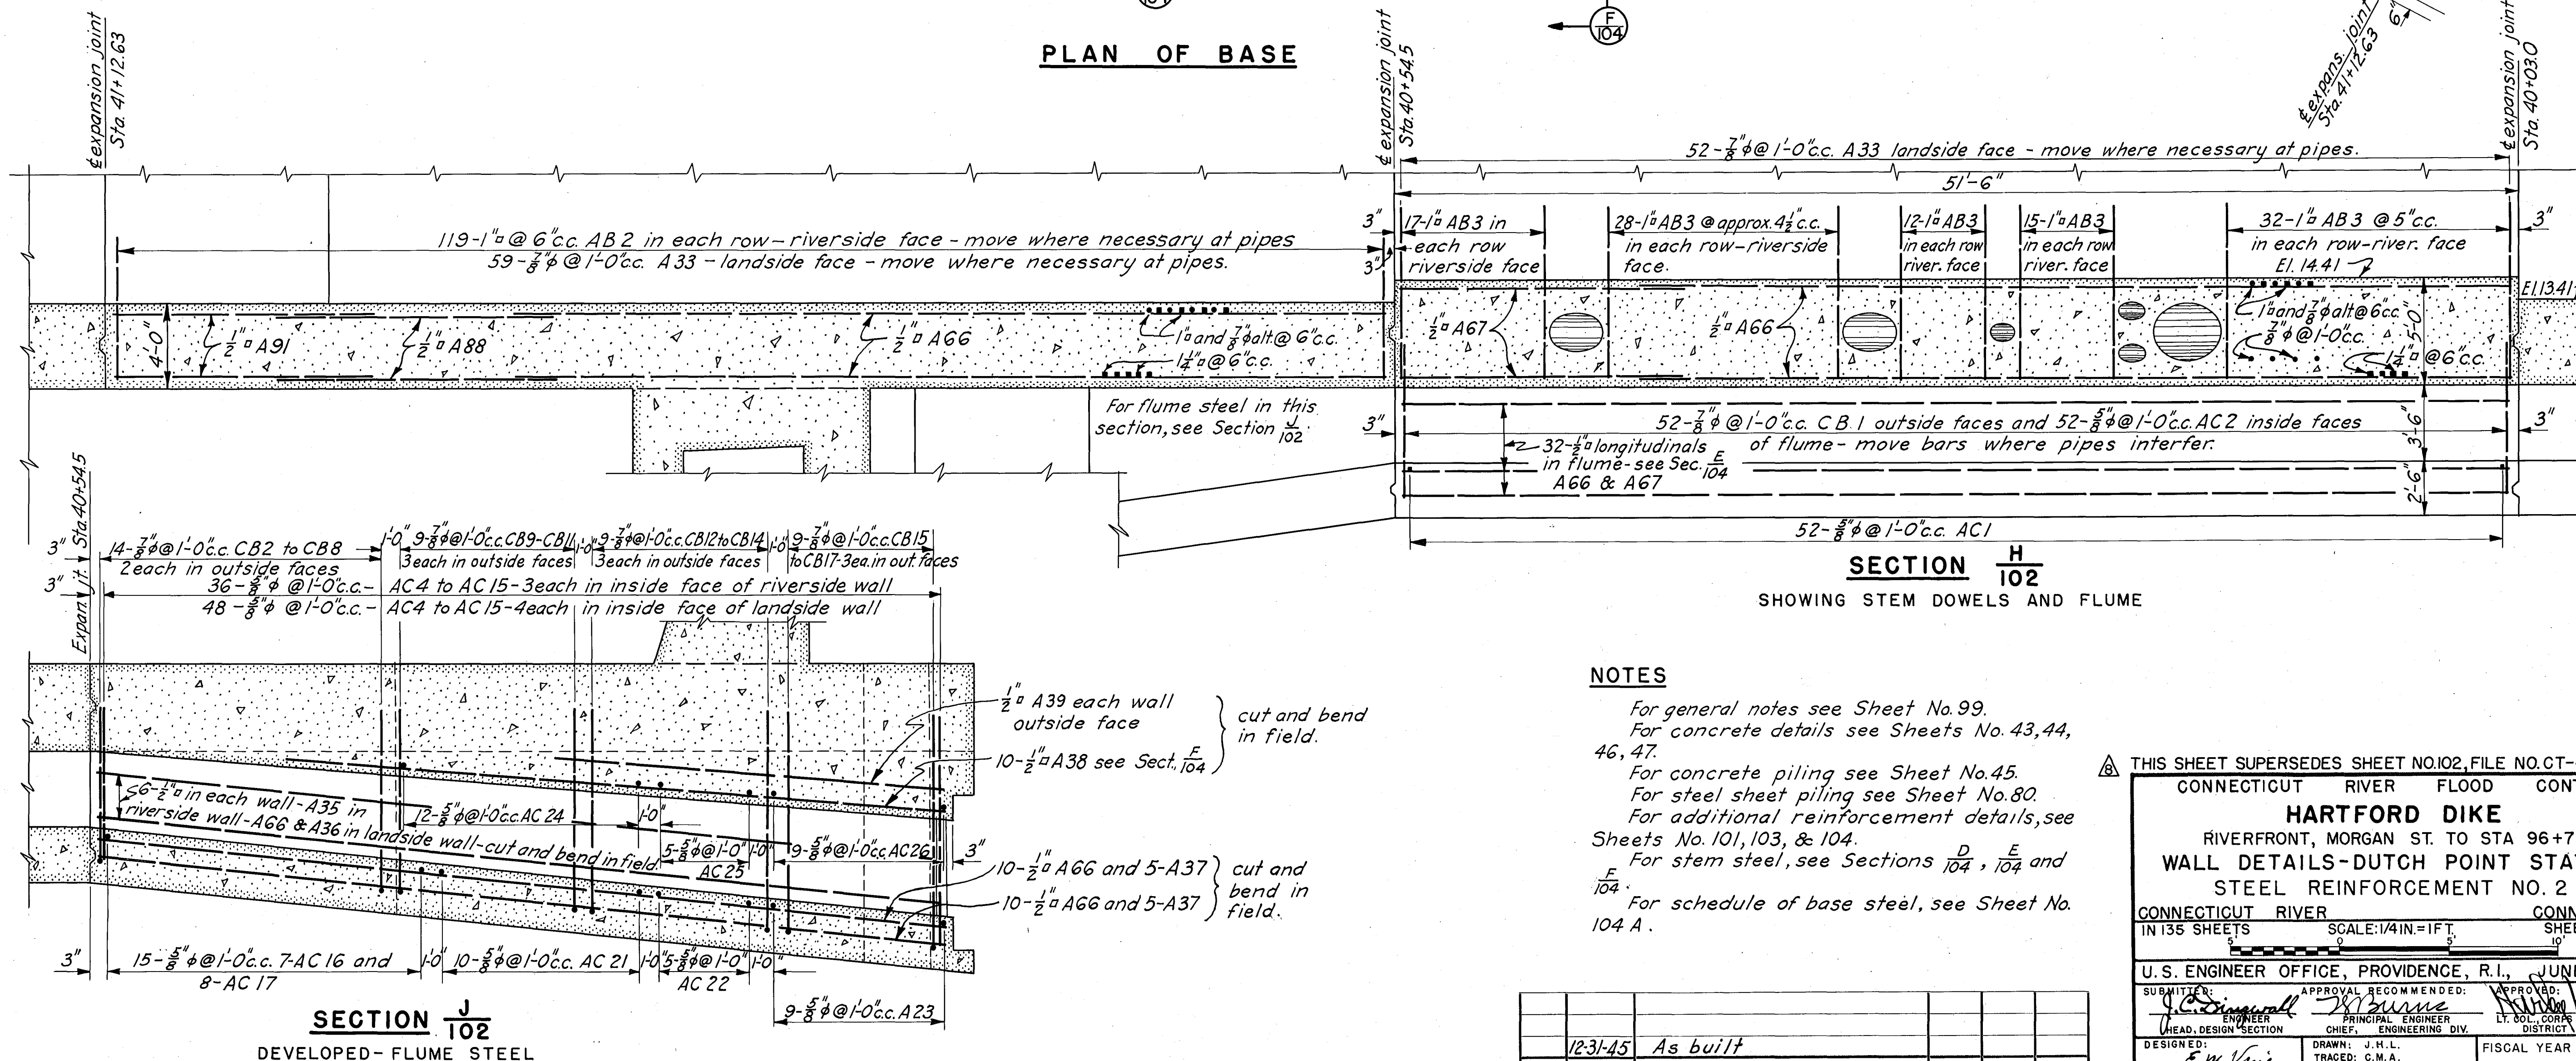

SECTION J 102

SHOWING STEM DOWELS AND FLUME

NOTES

- For general notes see Sheet No. 99.
 For concrete details see Sheets No. 43, 44, 46, 47.
 For concrete piling see Sheet No. 45.
 For steel sheet piling see Sheet No. 80.
 For additional reinforcement details, see Sheets No. 101, 103, & 104.
 For stem steel, see Sections D, E, and F.
 For schedule of base steel, see Sheet No. 104 A.

THIS SHEET SUPERSEDES SHEET NO. 102, FILE NO. CT-4-2562

CONNECTICUT RIVER FLOOD CONTROL

HARTFORD DIKE

RIVERFRONT, MORGAN ST. TO STA 96+73

WALL DETAILS-DUTCH POINT STATION

STEEL REINFORCEMENT NO. 2

CONNECTICUT RIVER CONNECTICUT

IN 135 SHEETS SCALE: 1/4" = 1' FT. SHEET NO. 102

U. S. ENGINEER OFFICE, PROVIDENCE, R. I., JUNE 1941

SUBMITTED: APPROVAL: RECOMMENDED: APPROVED:

HEAD, DESIGN SECTION CHIEF, ENGINEERING DIV. LT. COL. CORPS OF ENGINEERS

DESIGNED: DRAWN: J. H. L. TRACED: C. M. A. CHECKED: J. J. D. FISCAL YEAR 1940

ASSOC. ENGINEER FILE NO. CT-4-2970

KEY	DATE	REVISION (Indicated by Δ)	REV. BY	CK. BY	AP. BY
	12-31-45	As built			