
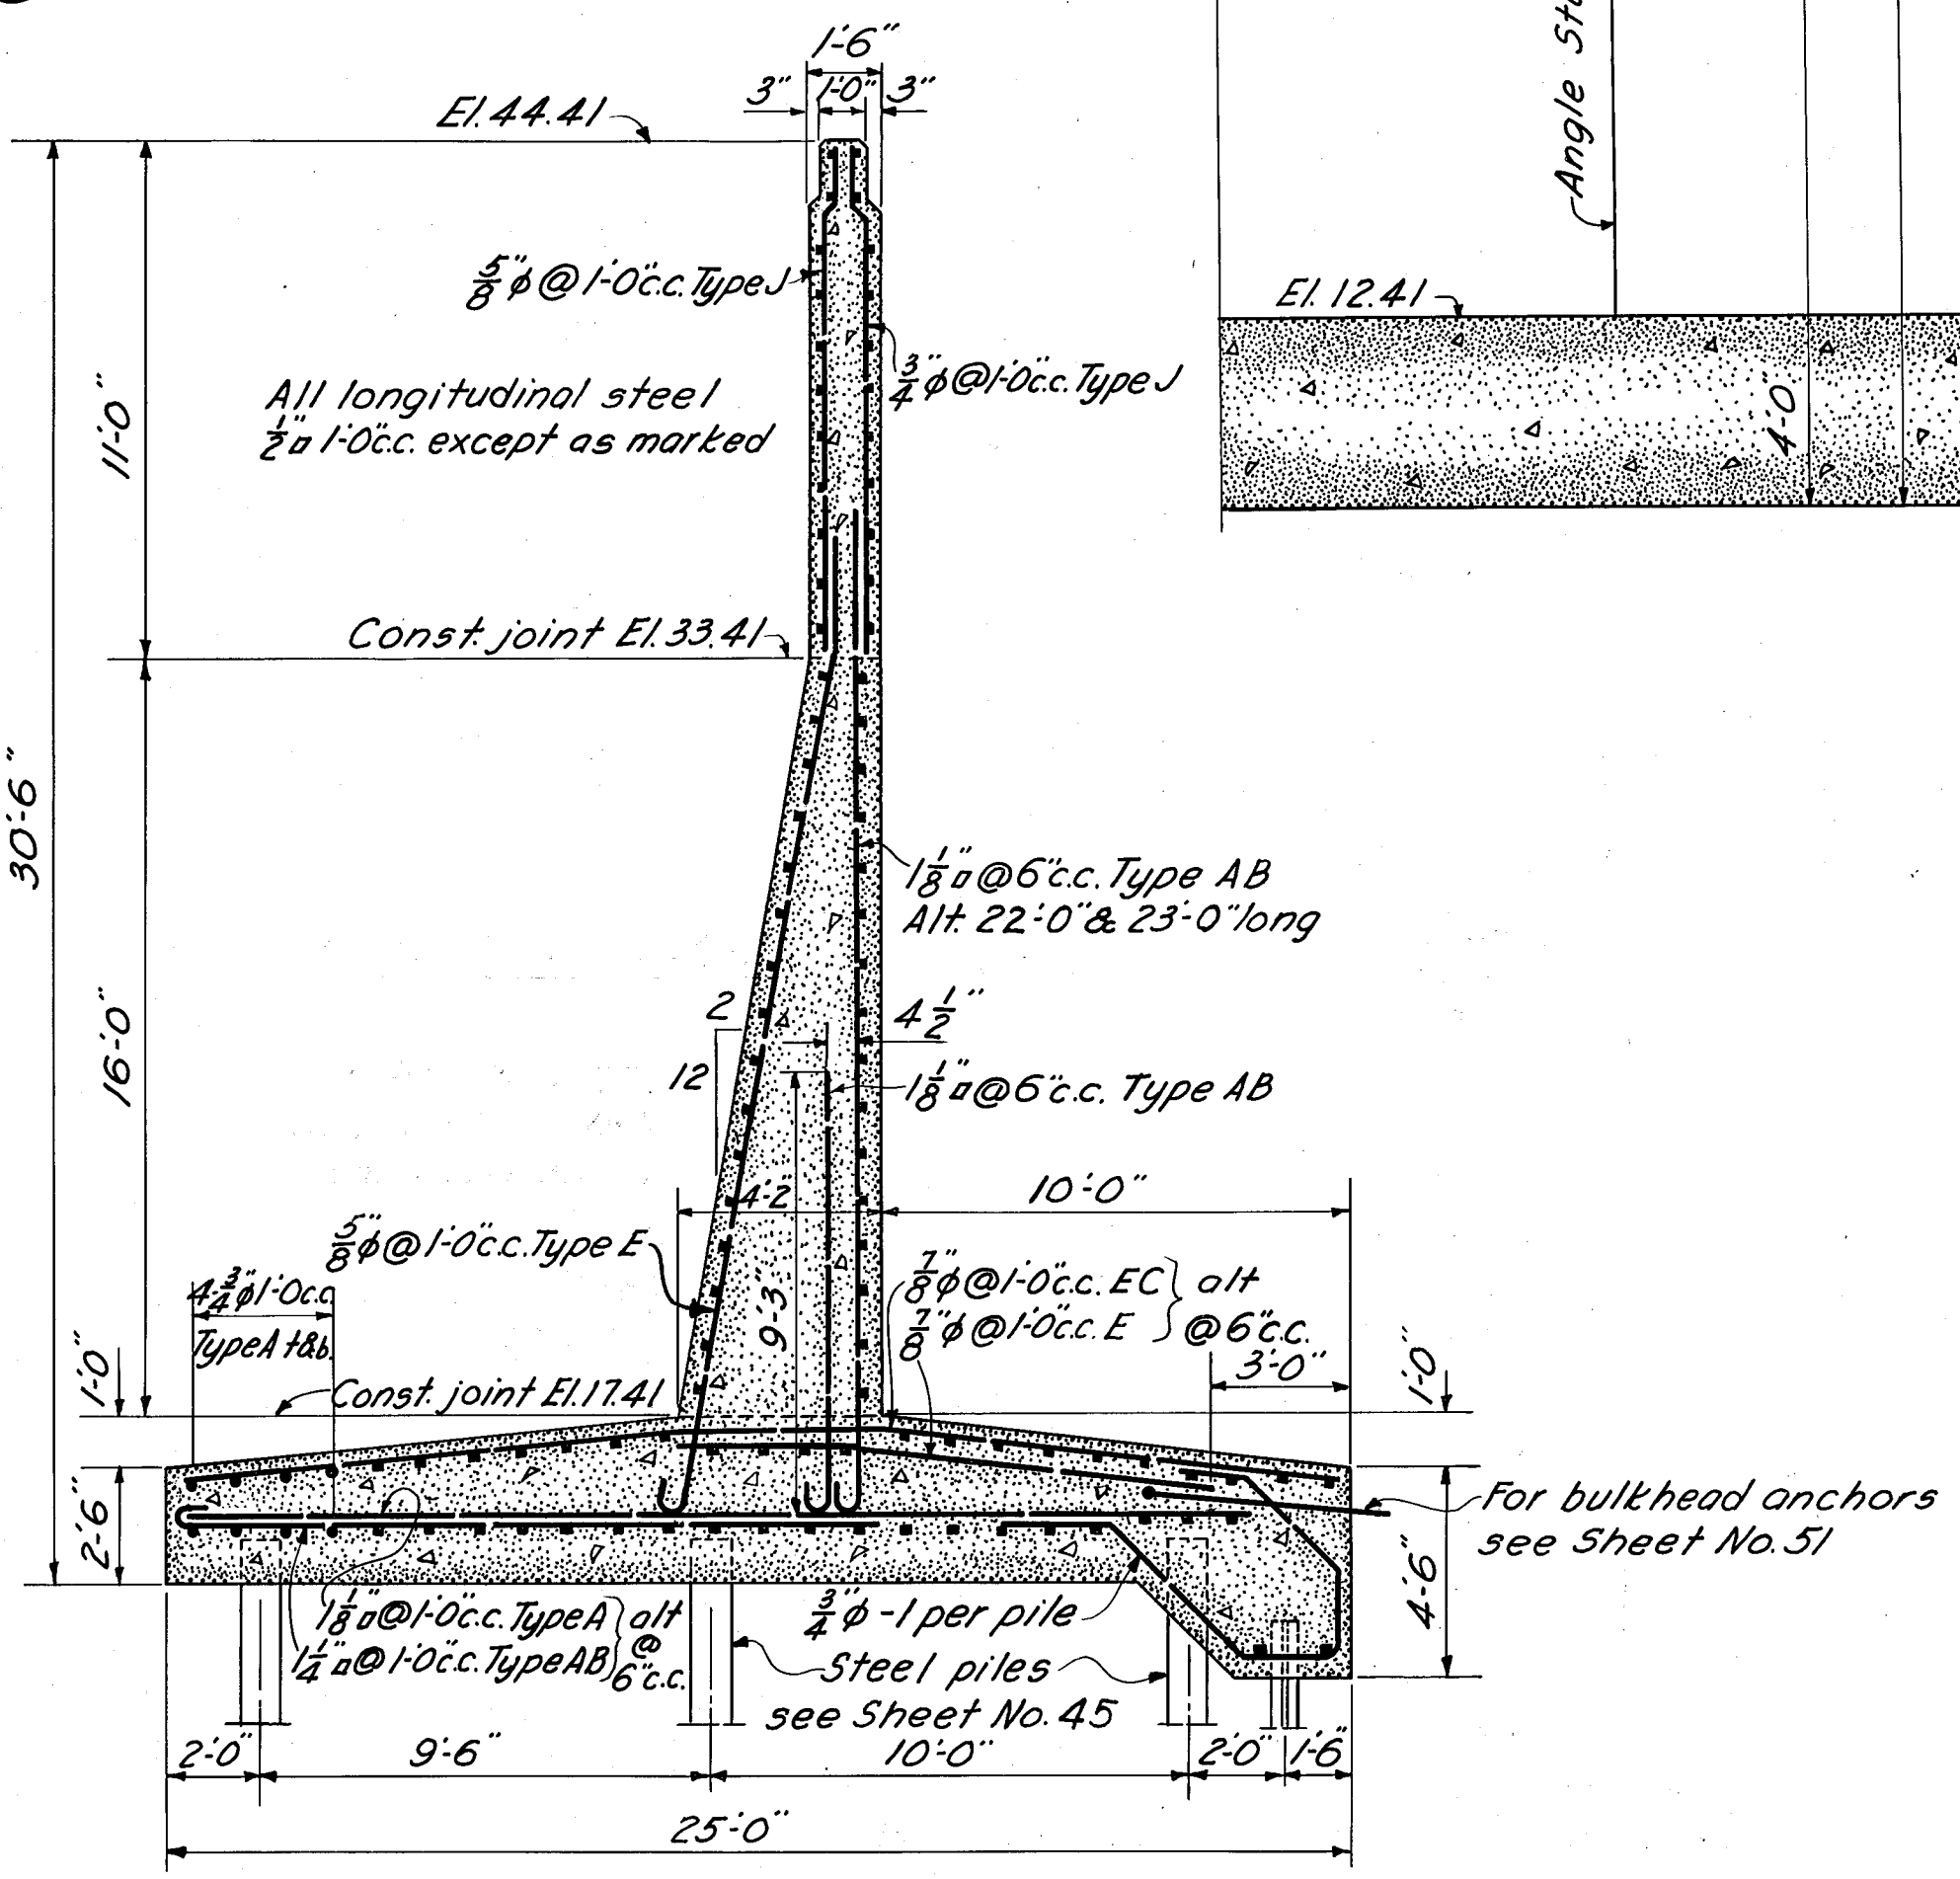
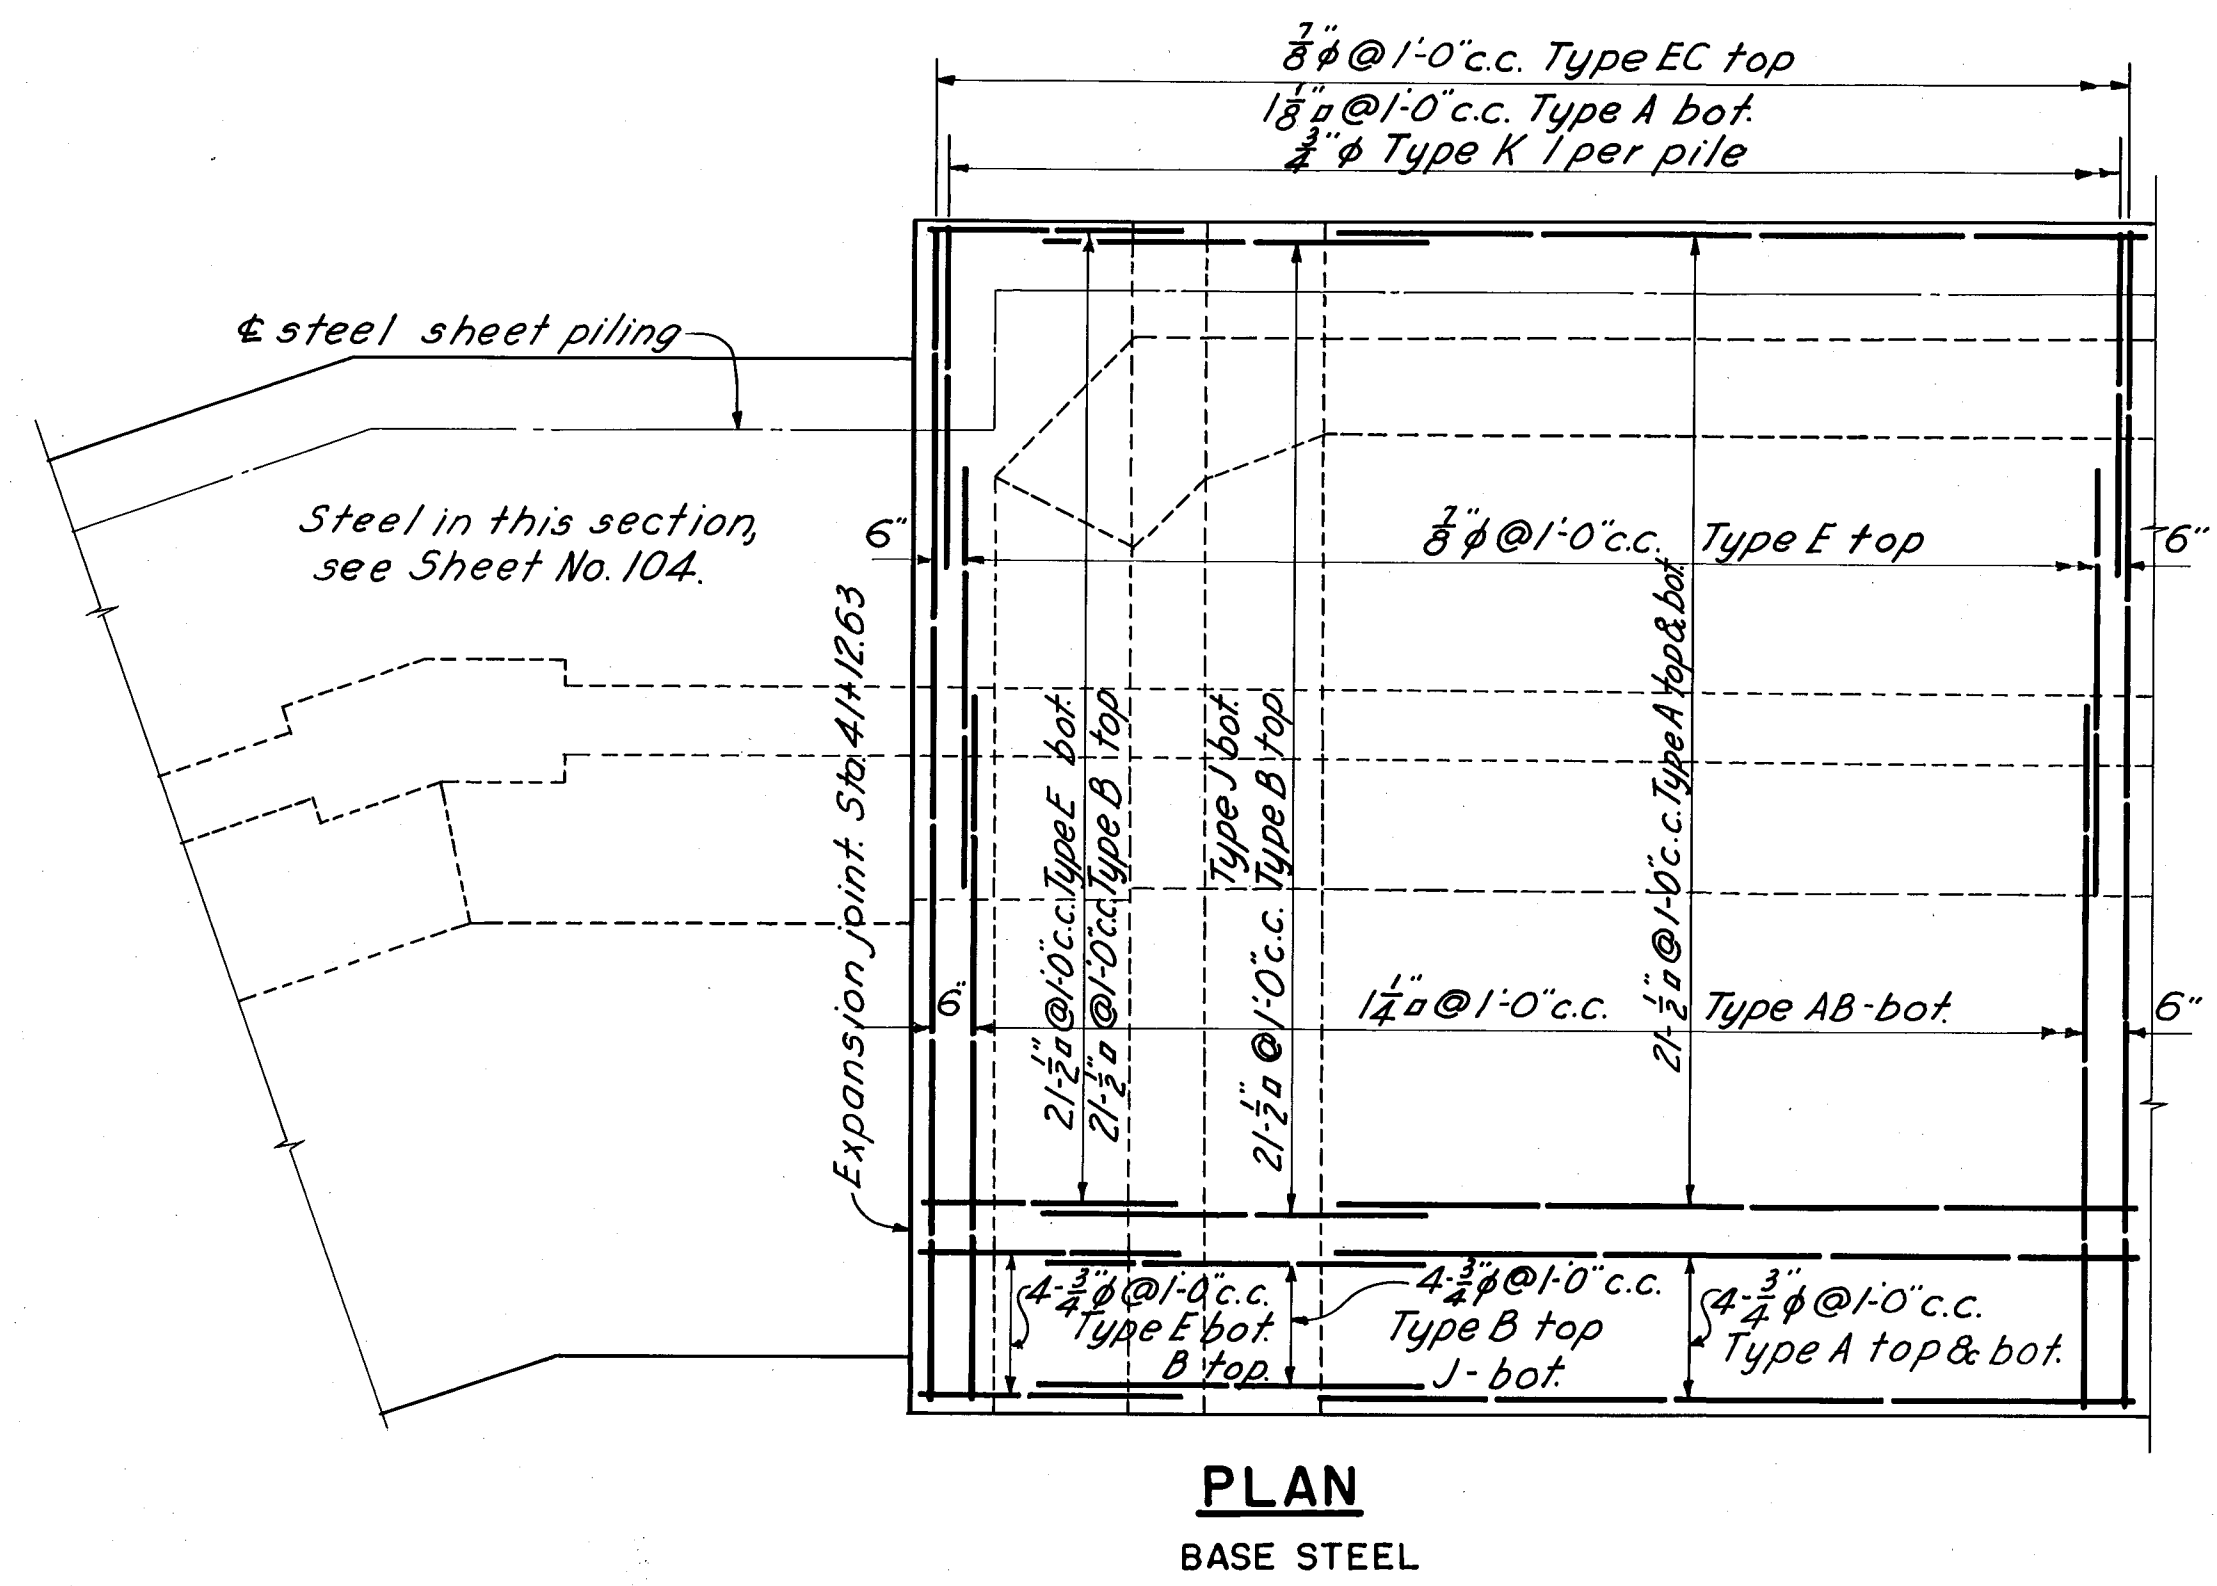
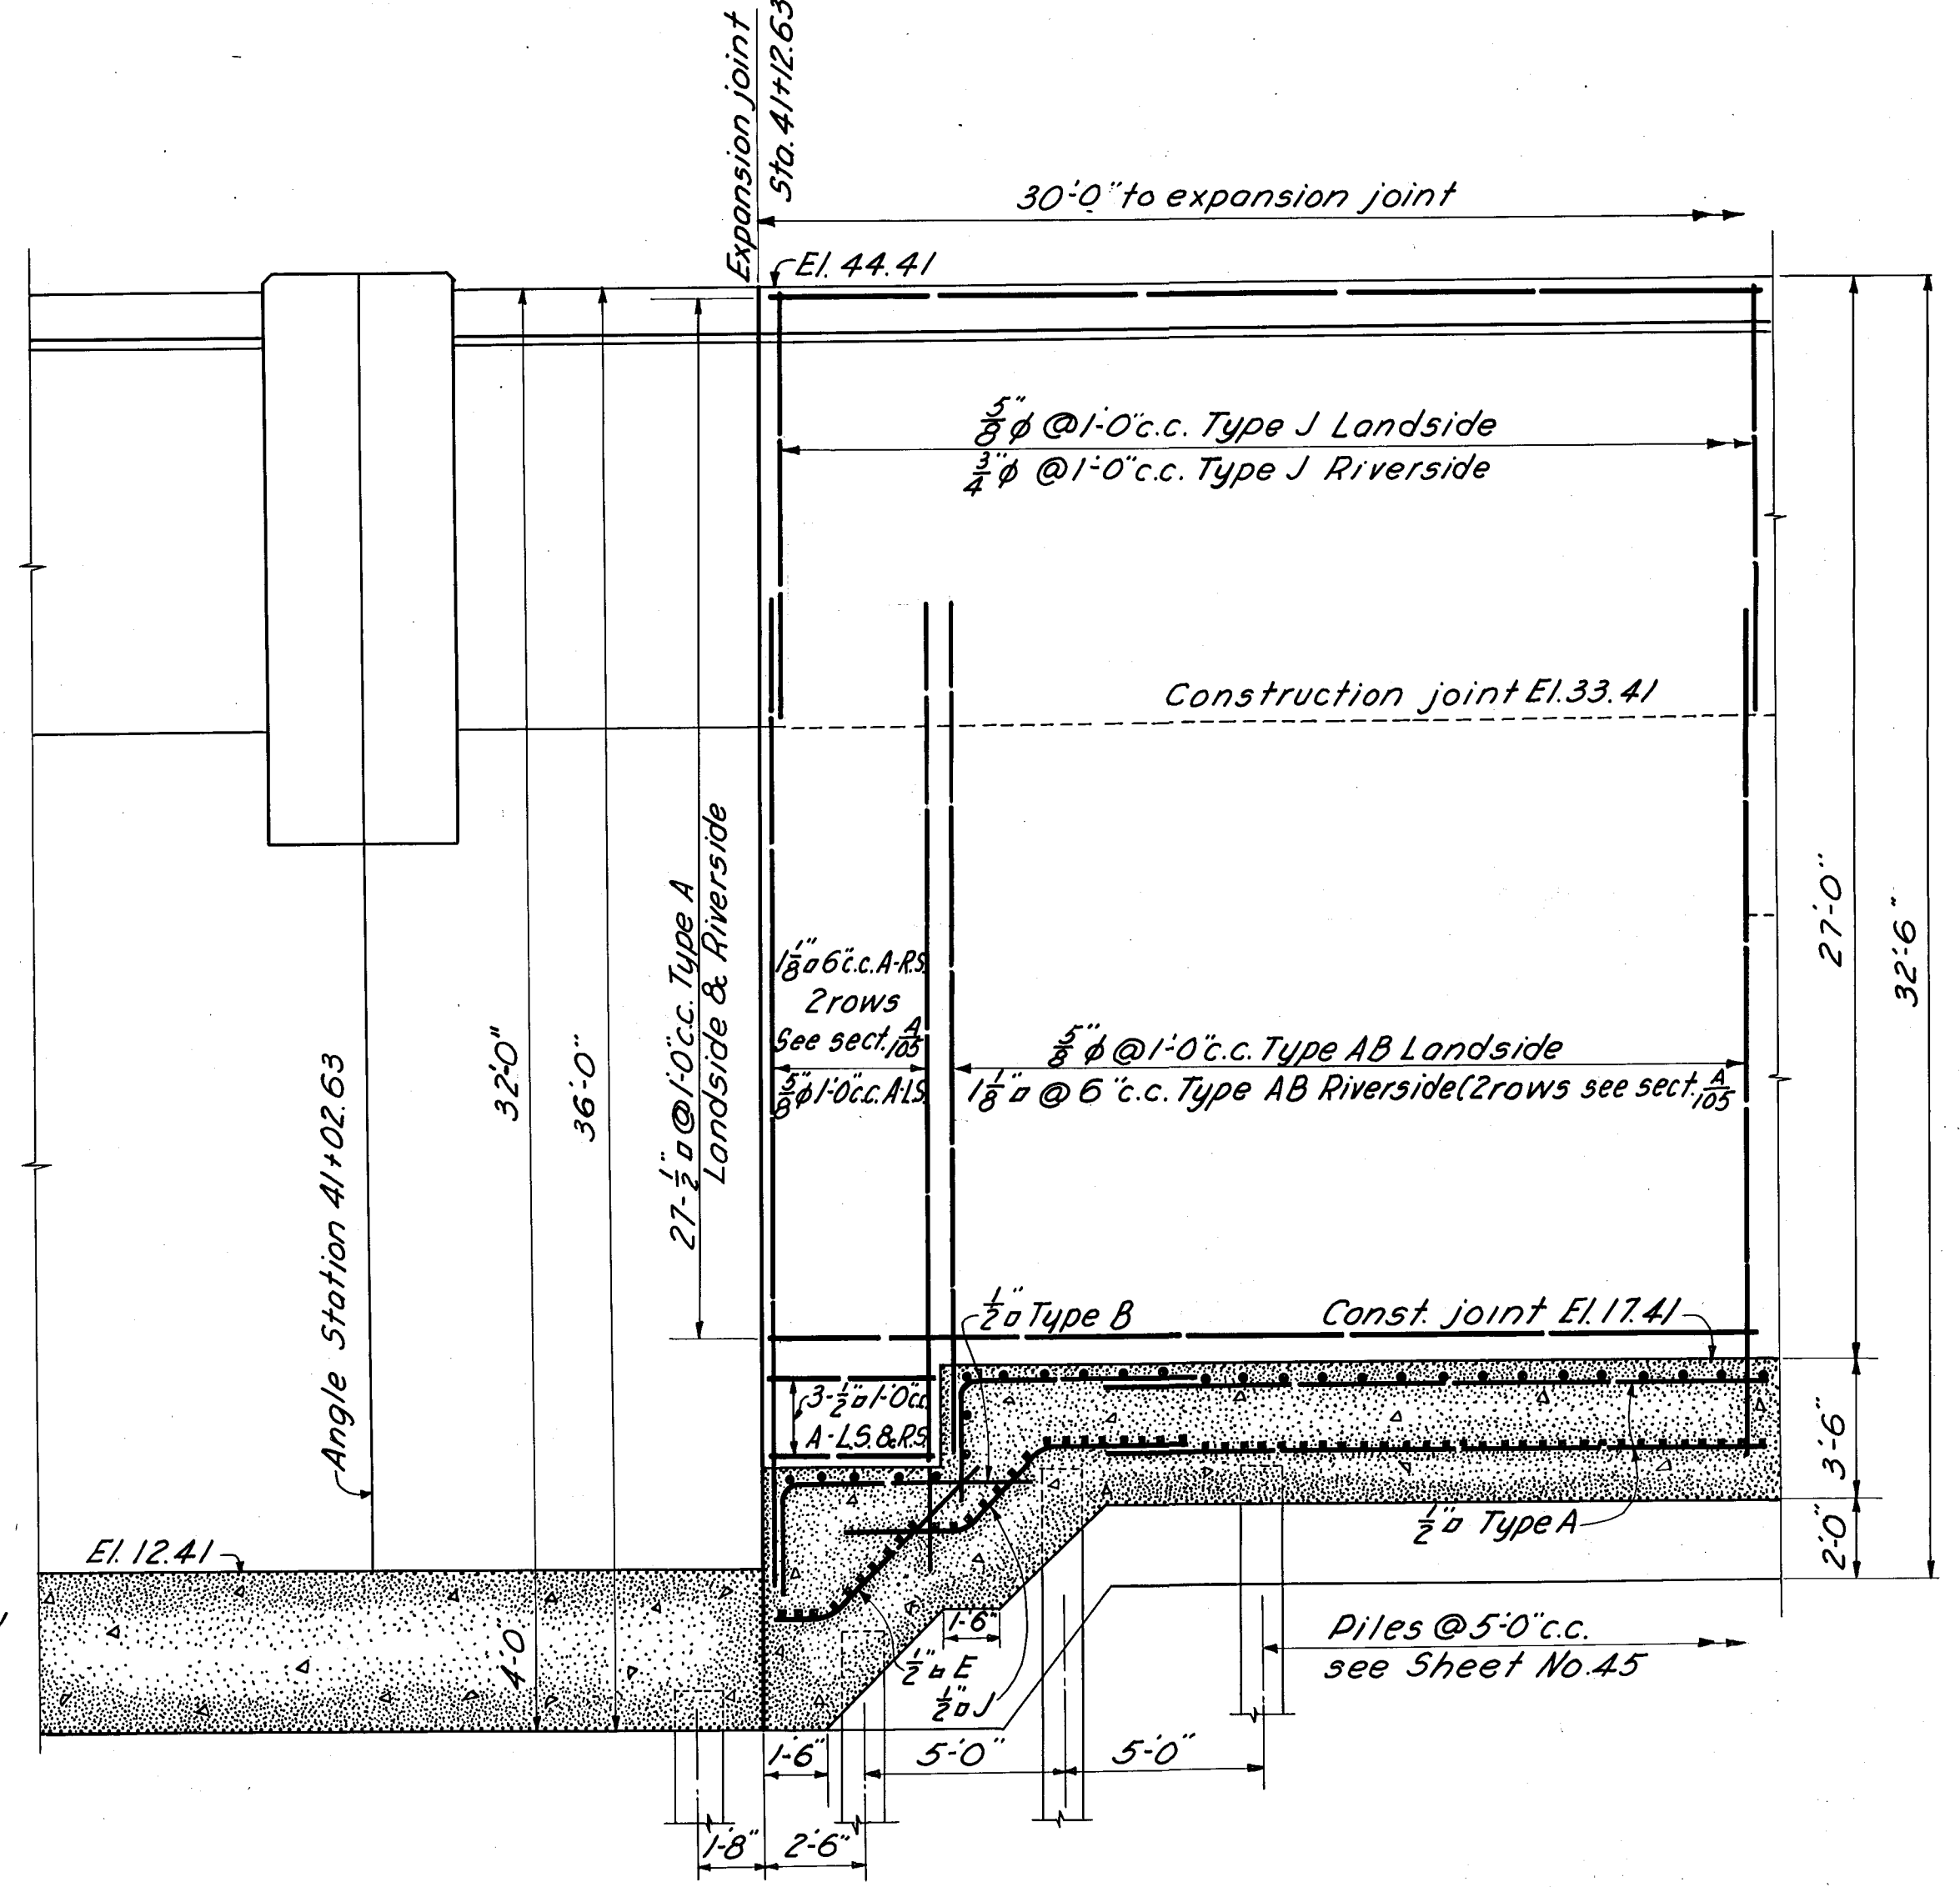


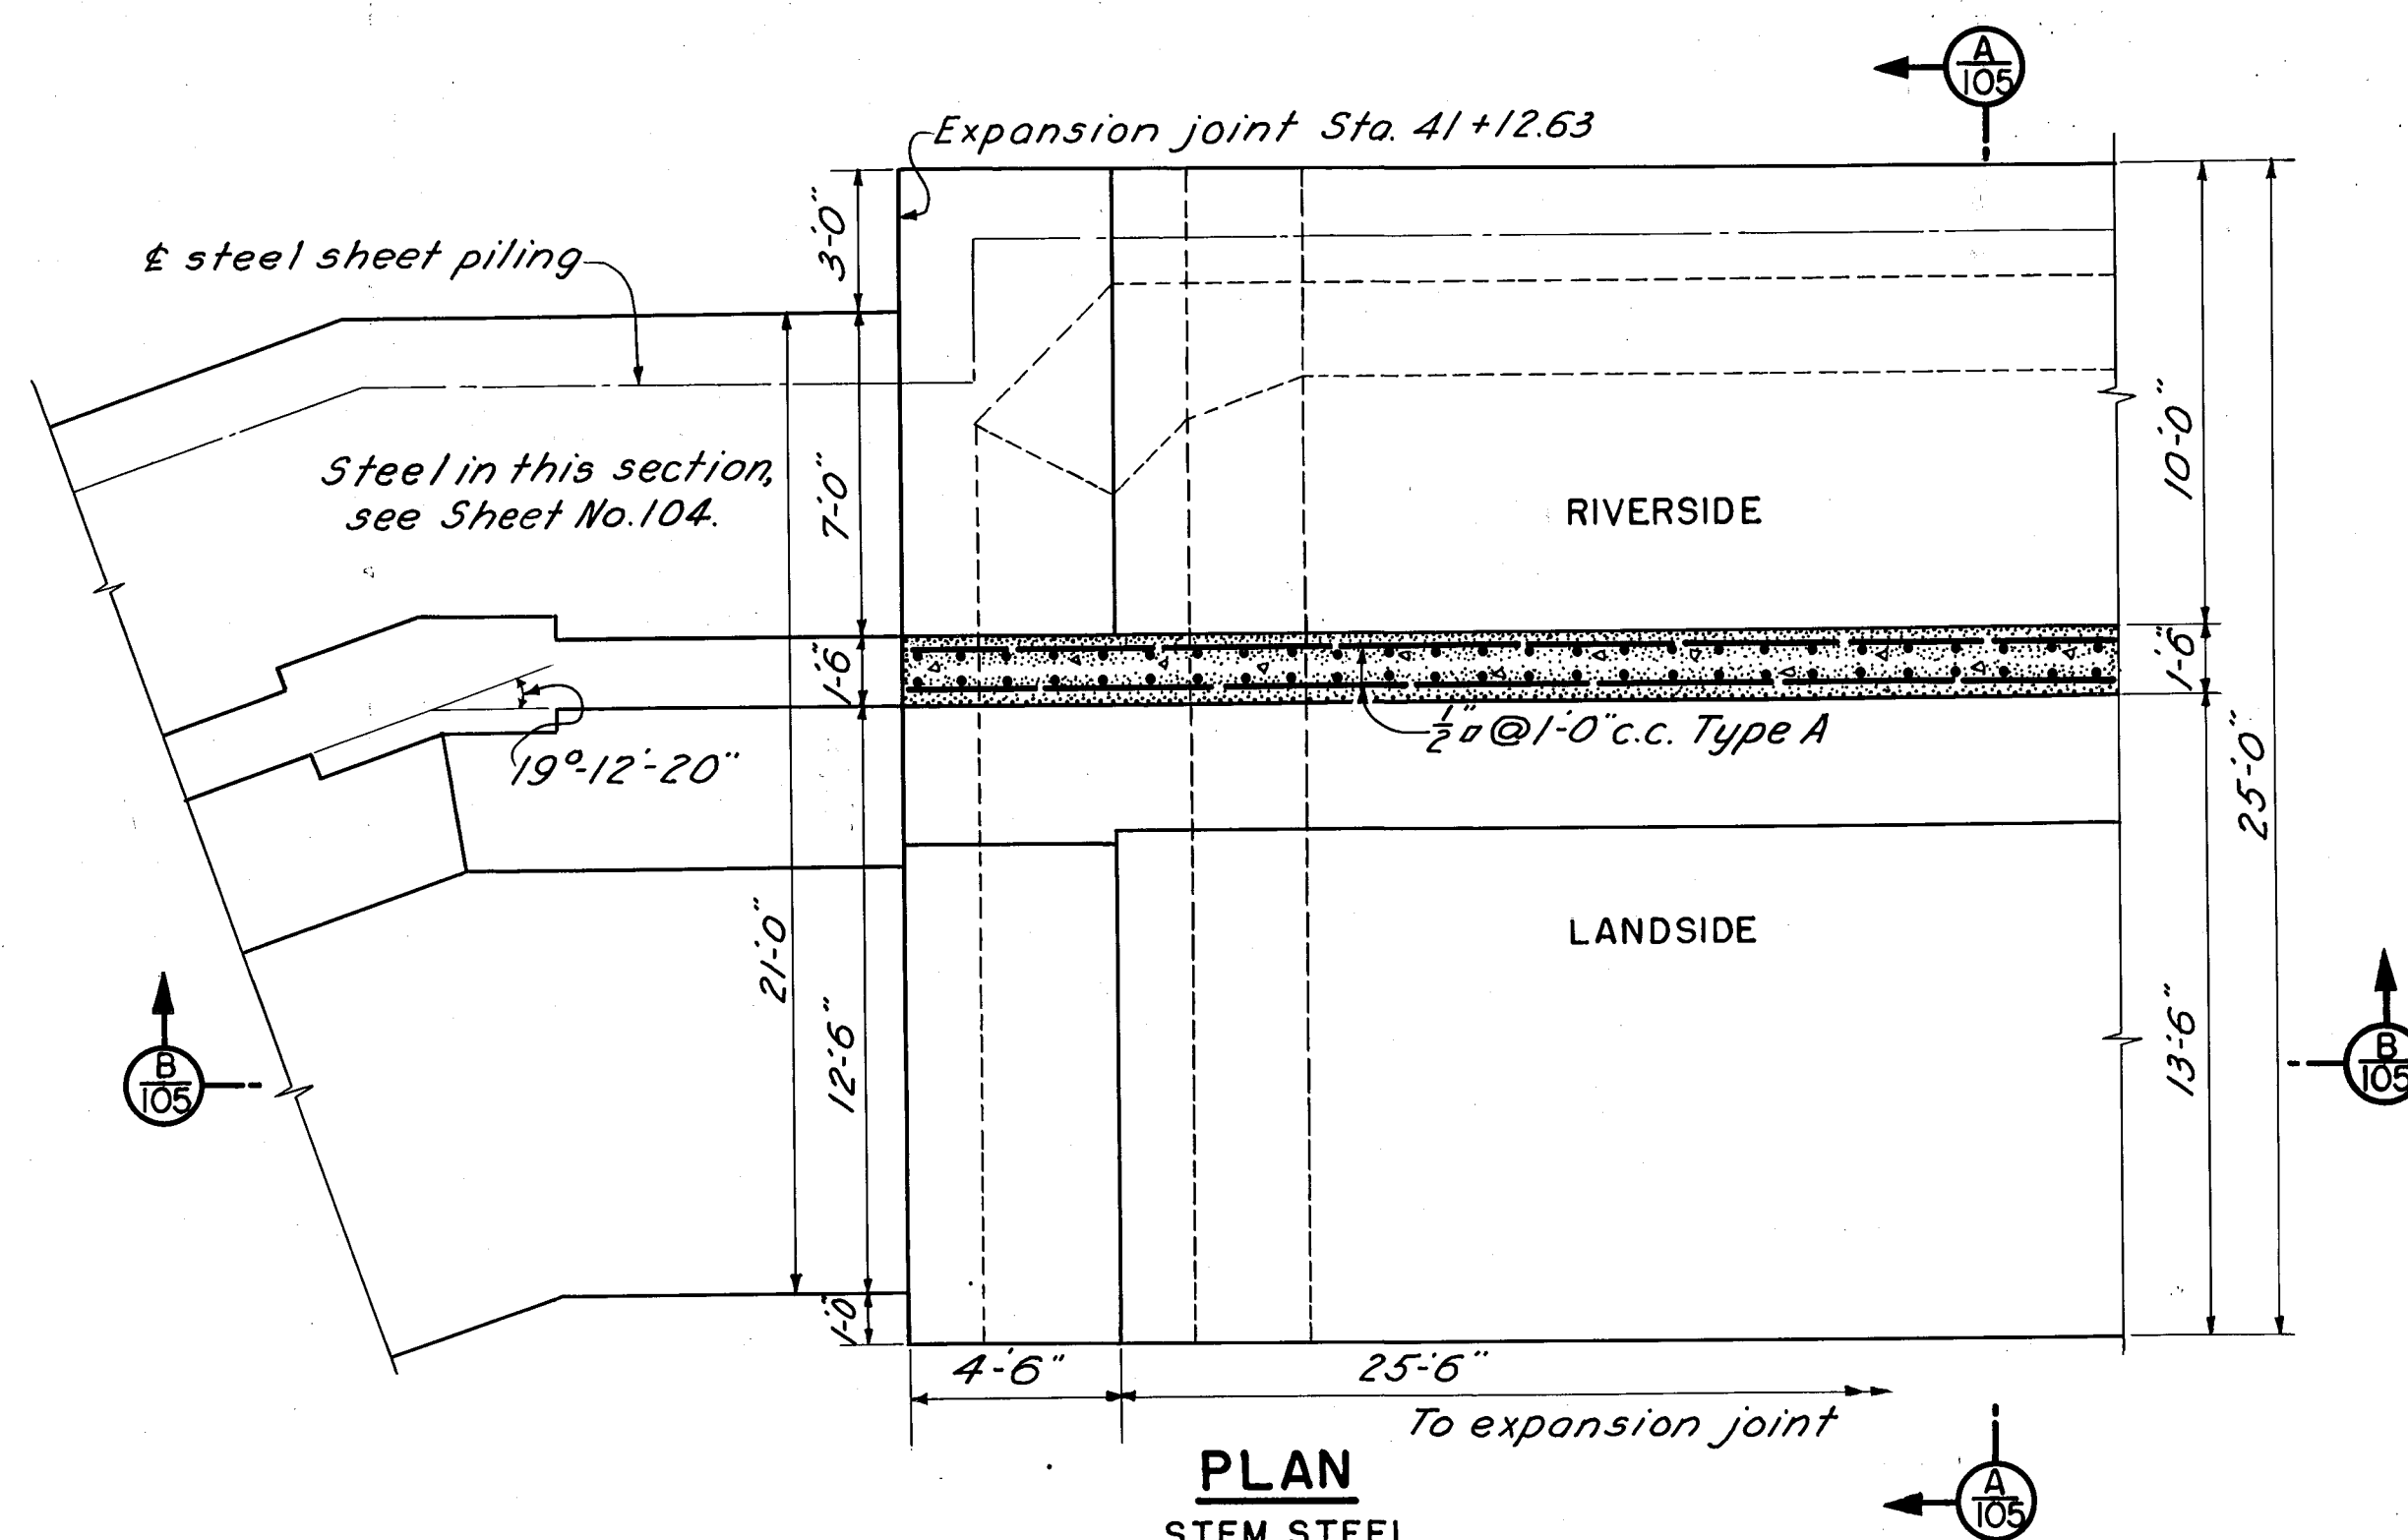

NOTES
For concrete details see Sheet Nos. 40 & 41
For general notes see Sheet No. 107.

THIS SHEET SUPERSEDES SHEET NO. 105 FILE NO. CT-4-2565

CONNECTICUT RIVER FLOOD CONTROL

HARTFORD DIKE

RIVERFRONT, MORGAN ST. TO STA. 96+73
TRANSITION-STA. 41+12.63 TO STA. 41+82.63
STEEL REINFORCEMENT

CONNECTICUT RIVER CONNECTICUT

IN 135 SHEETS SCALE: 1/4 IN. = 1 FT. SHEET NO. 105

U.S. ENGINEER OFFICE, PROVIDENCE, R.I., FEB. 1941

SUBMITTED: *Boris B. Nilsen* APPROVAL: *W. J. Sullivan* RECOMMENDED: *W. J. Sullivan*

DESIGNED: *W. J. Sullivan* DRAWN: *W. J. Sullivan* TRACED: *W. J. Sullivan* CHECKED: *W. J. Sullivan*

ASSOC. ENGINEER

FISCAL YEAR 1941

FILE NO. CT-4-2842

KEY	DATE	REVISION (Indicated by Δ)	REV. BY	CK. BY	AP. BY
	12-31-45	As Built			