
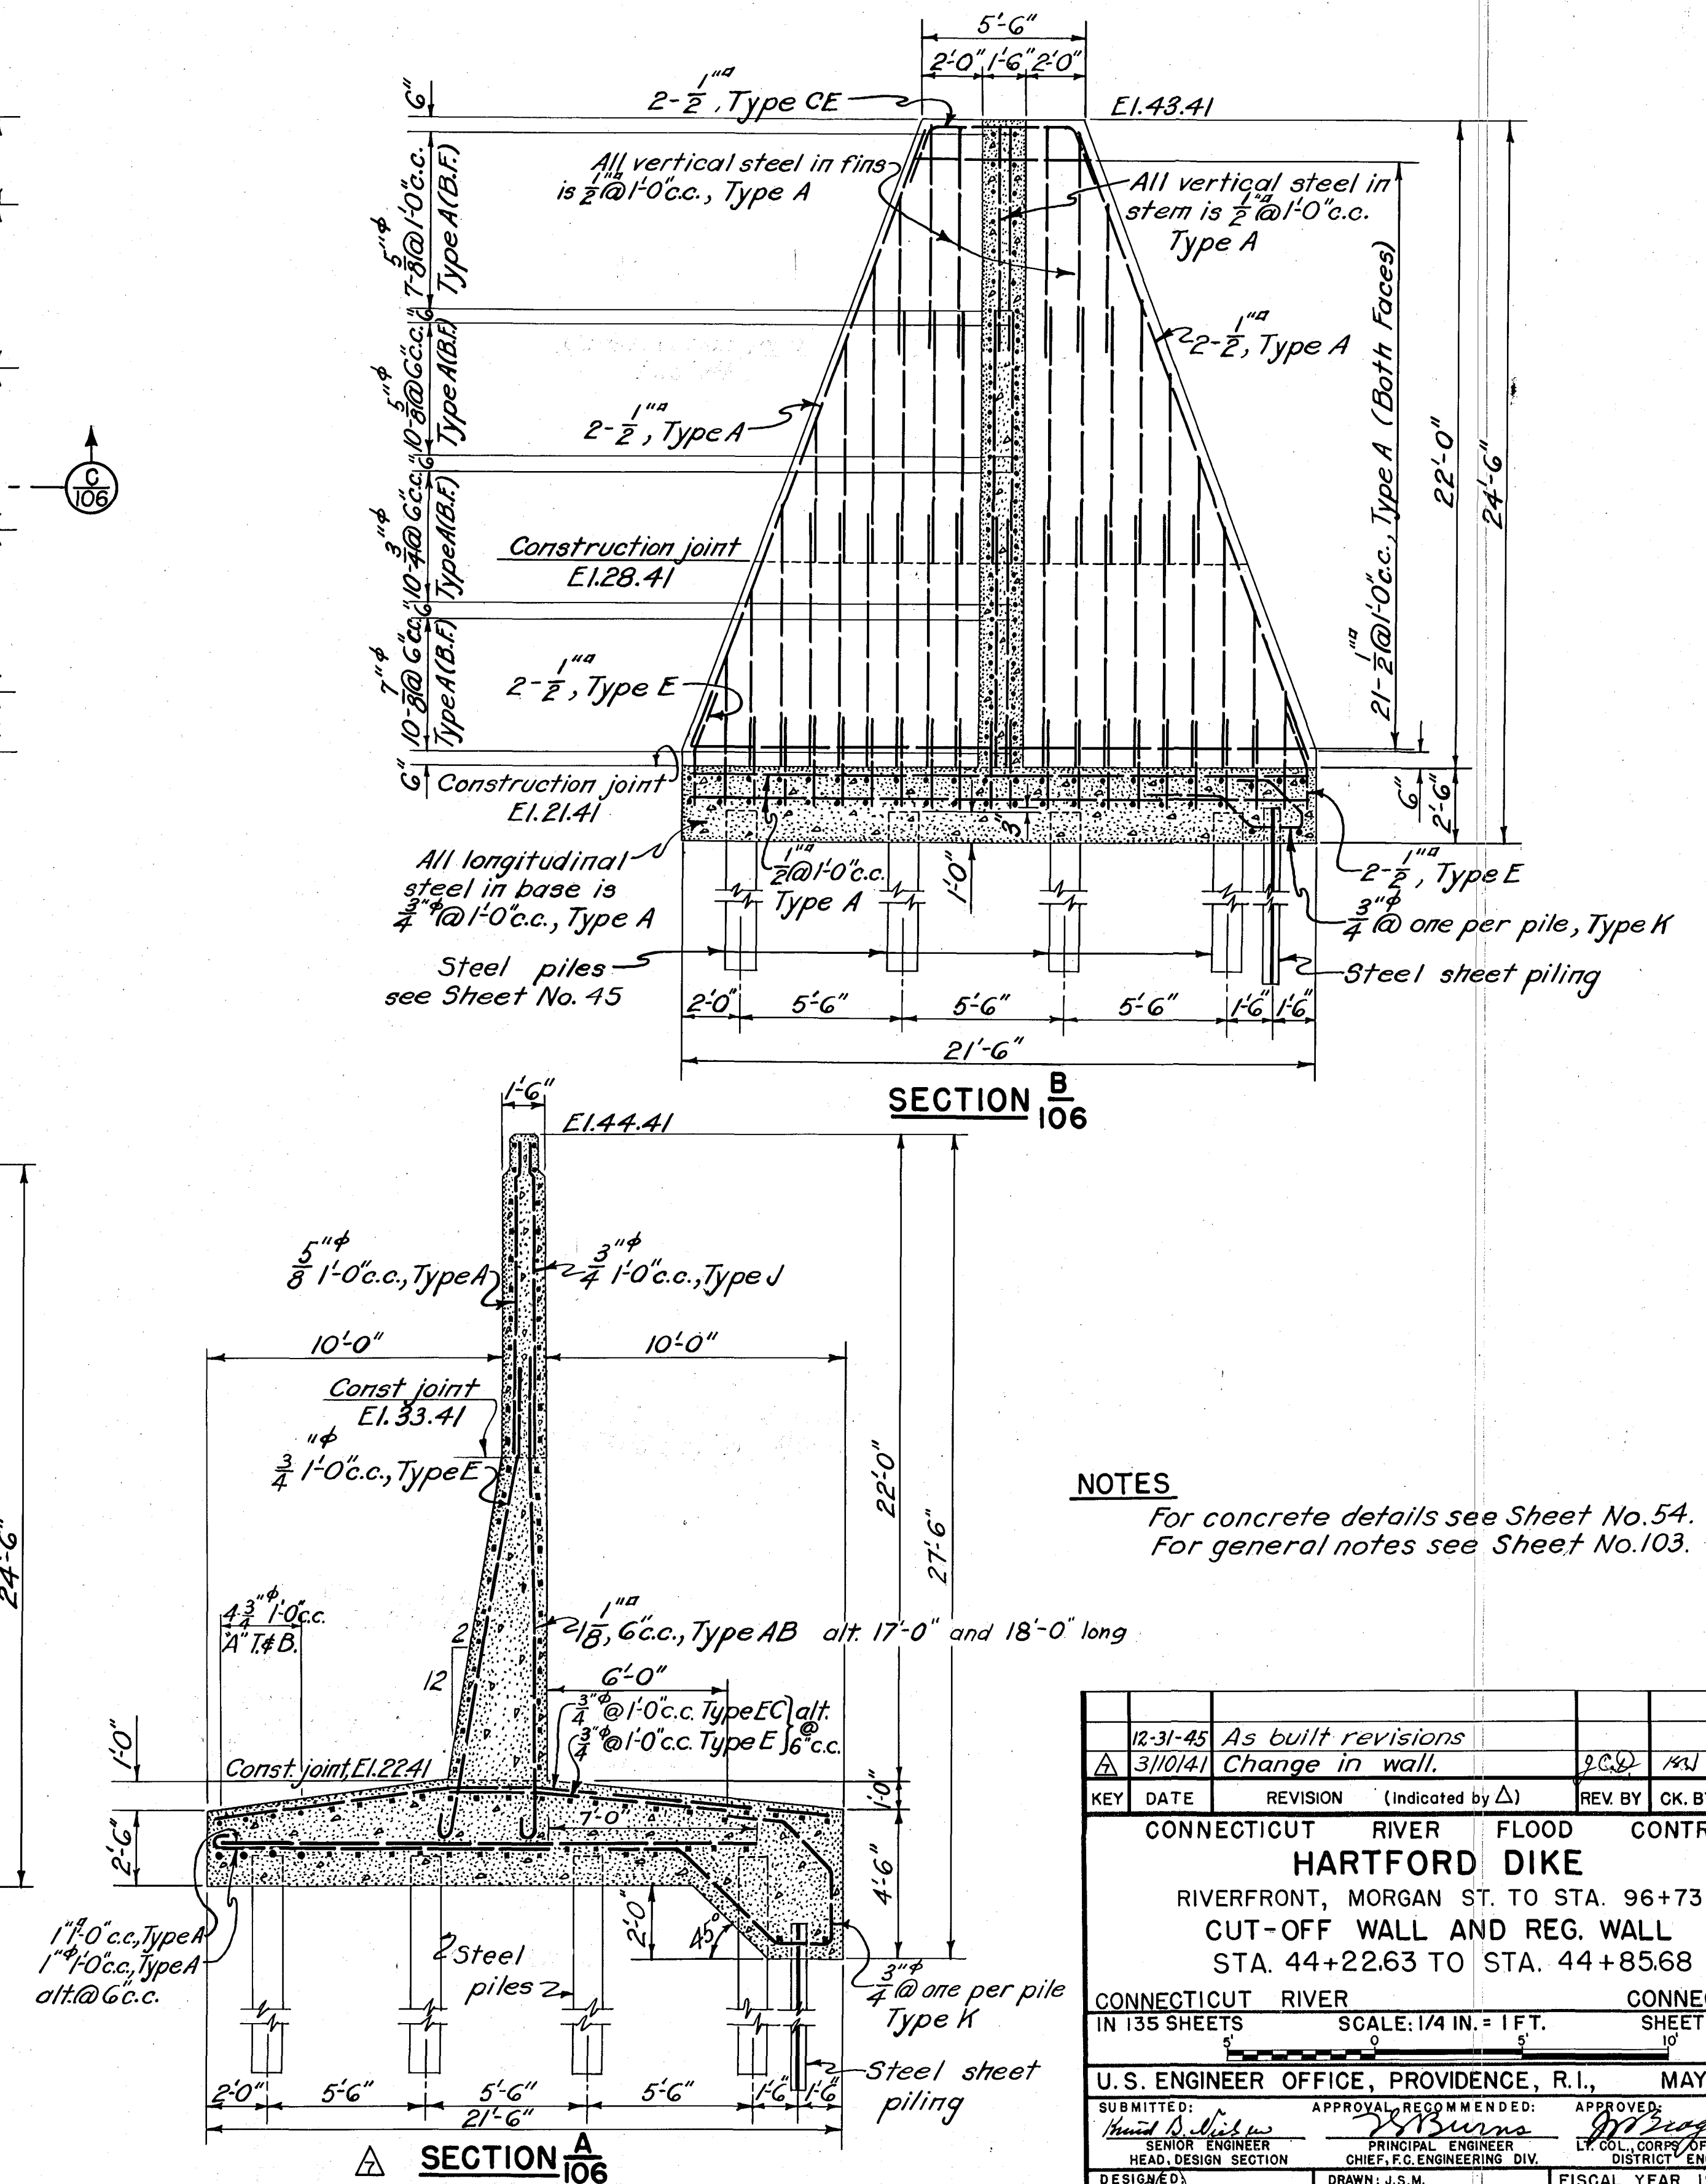


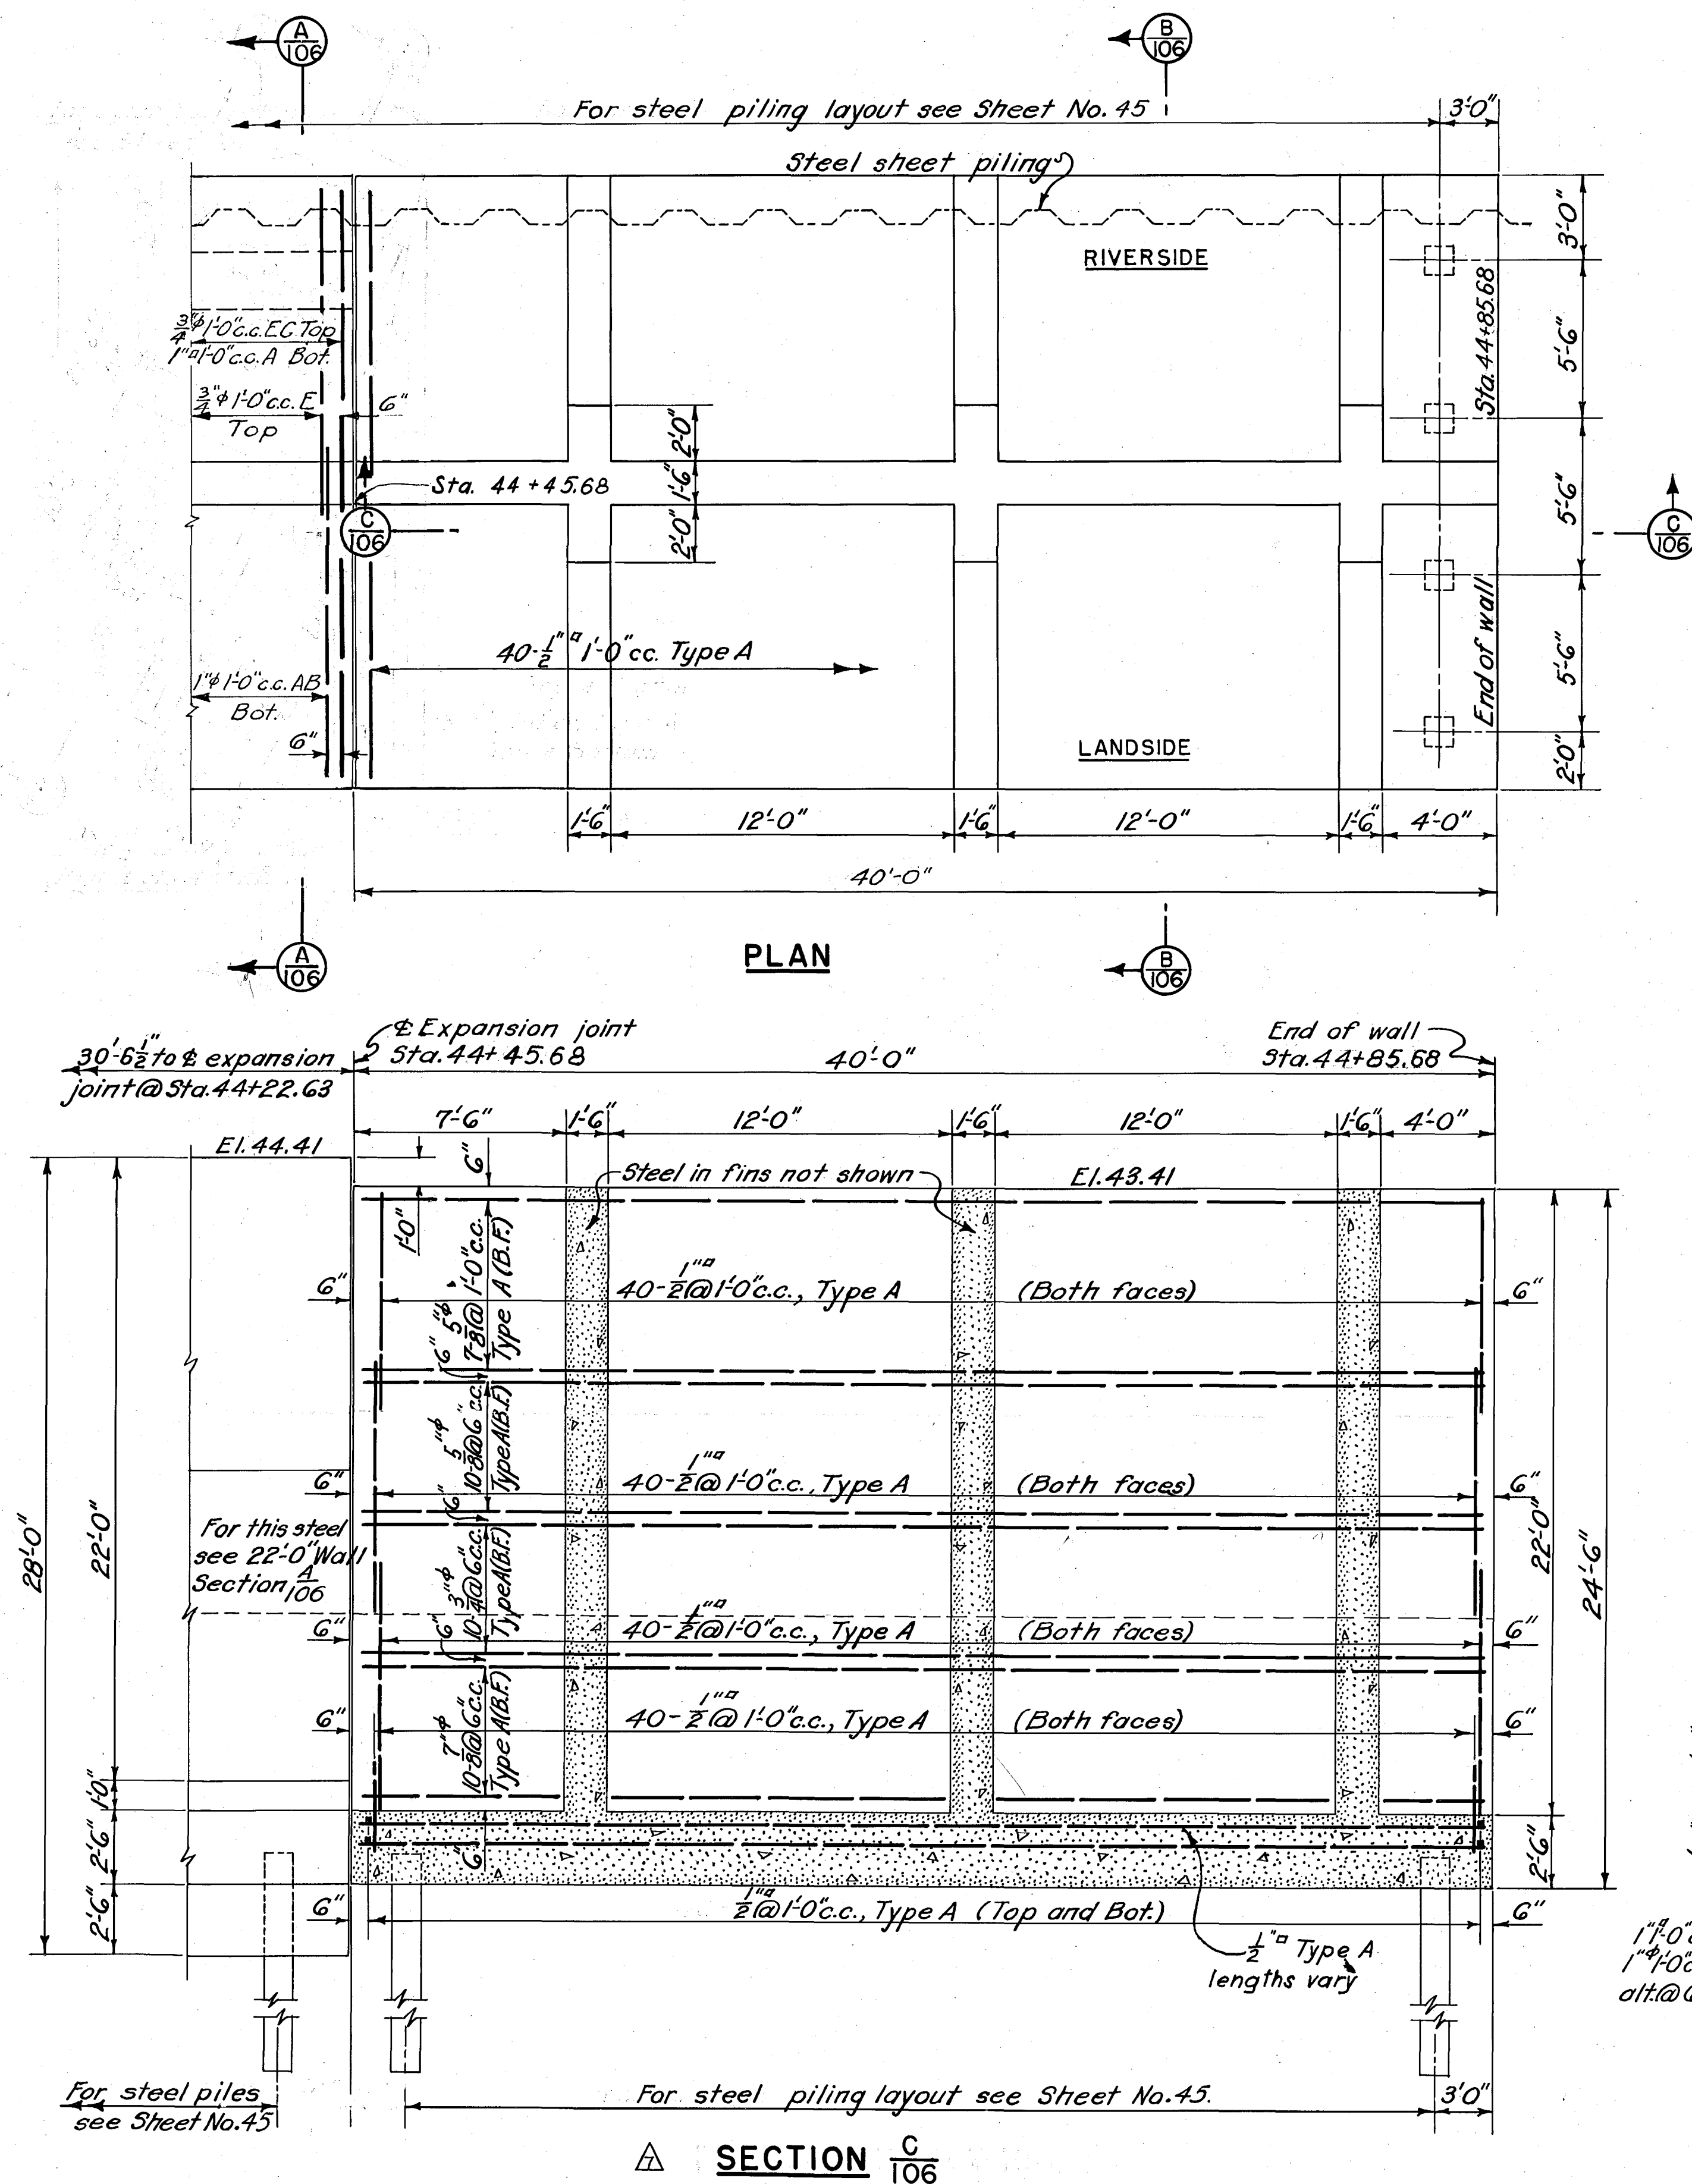

NOTES

For concrete details see Sheet No. 54.
For general notes see Sheet No. 103.

	12-31-45	As built revisions				
	3/10/47	Change in wall.		J.C.D.	141	240
KEY	DATE	REVISION (Indicated by Δ)		REV. BY	CK. BY	AP. BY
CONNECTICUT RIVER FLOOD CONTROL						
HARTFORD DIKE						
RIVERFRONT, MORGAN ST. TO STA. 96+73						
CUT-OFF WALL AND REG. WALL						
STA. 44+22.63 TO STA. 44+85.68						
CONNECTICUT RIVER			CONNECTICUT		SHEET NO. 106	
IN 135 SHEETS			SCALE: 1/4 IN. = 1 FT.			
						
U.S. ENGINEER OFFICE, PROVIDENCE, R.I., MAY 1940						
SUBMITTED:		APPROVAL, RECOMMENDED:		APPROVED:		
						
SENIOR ENGINEER		PRINCIPAL ENGINEER		LT. COL. CORPS OF ENGINEERS		
HEAD, DESIGN SECTION		CHIEF, F.C. ENGINEERING DIV.		DISTRICT ENGINEER		
DESIGNED (S)		DRAWN: J.S.M.		FISCAL YEAR 1940		
		TRACED: J.S.M. CHECKED: J.S.M.		FILE NO. CT-4-2566		