

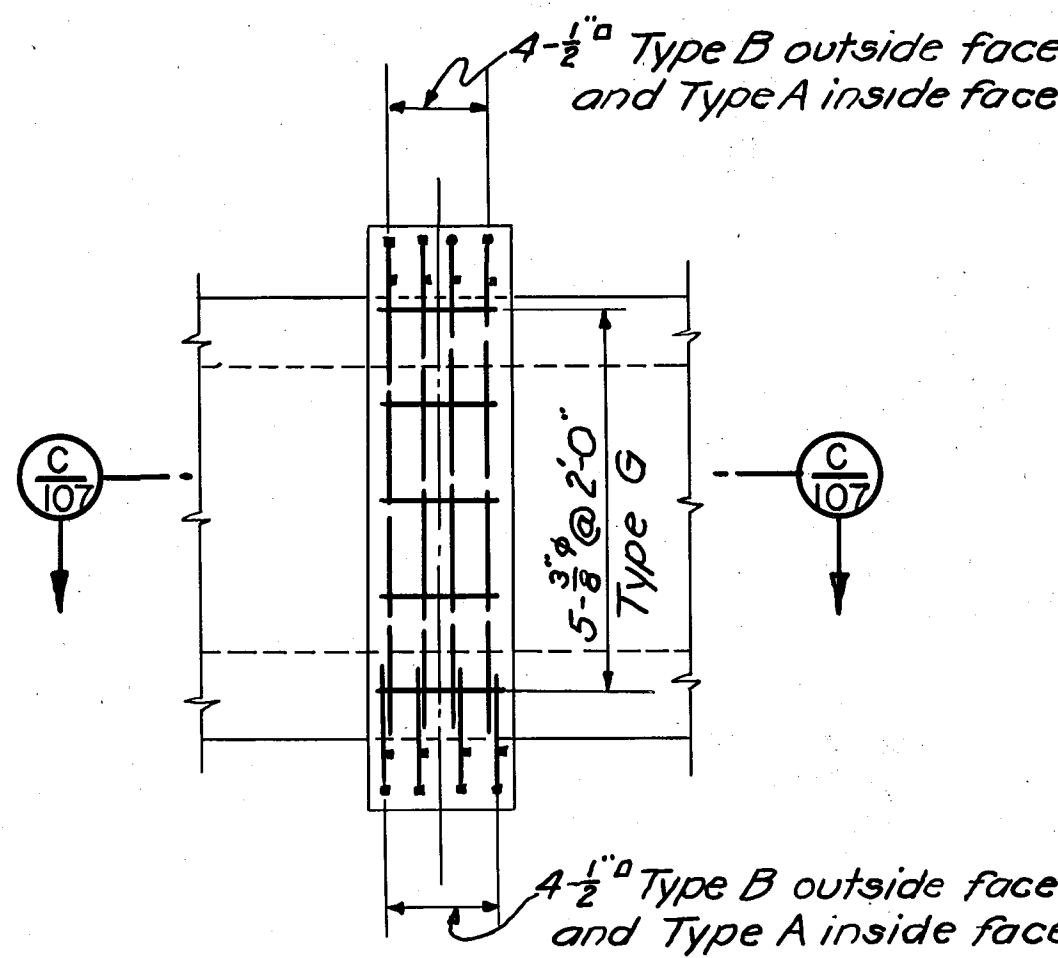
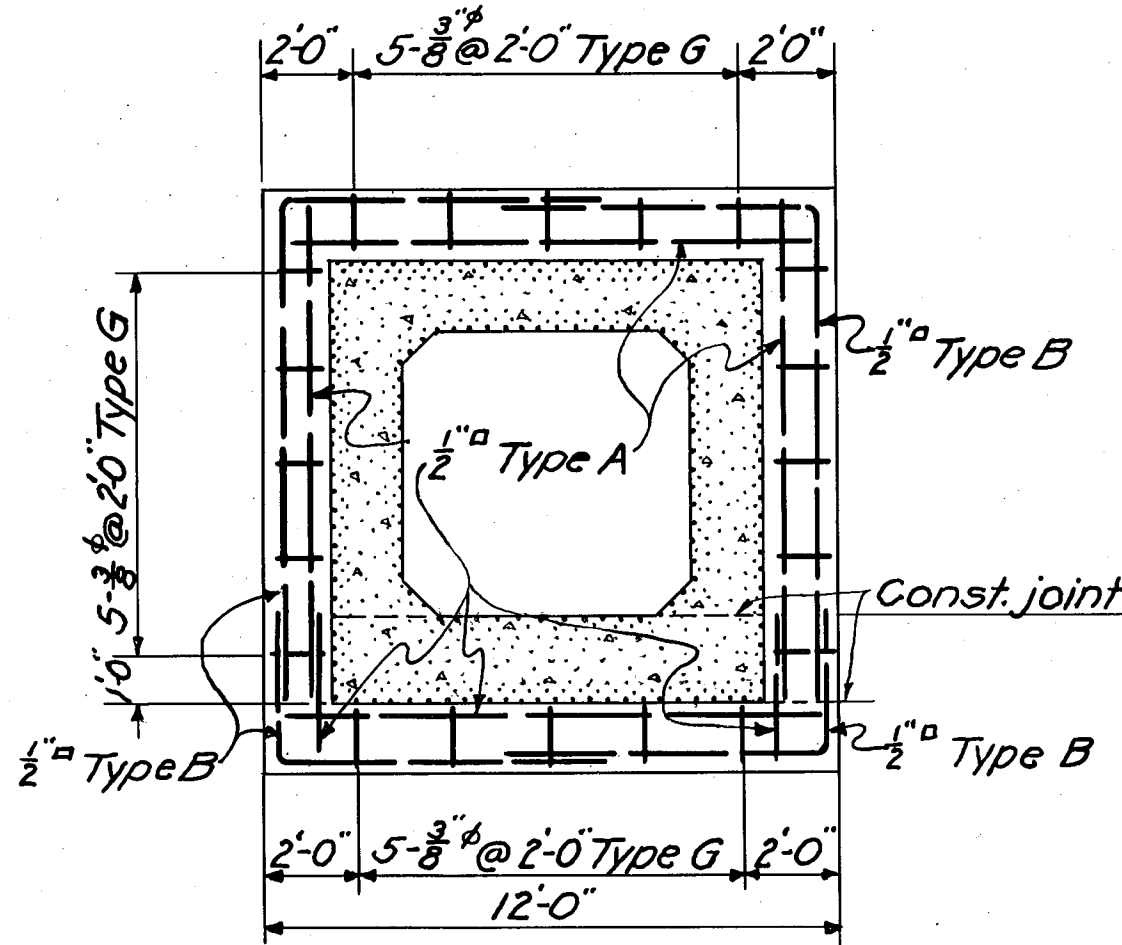
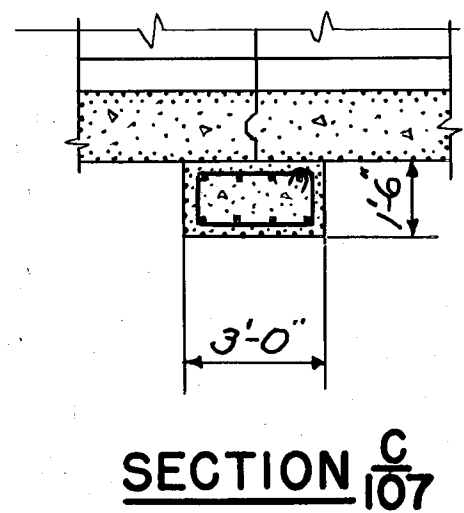
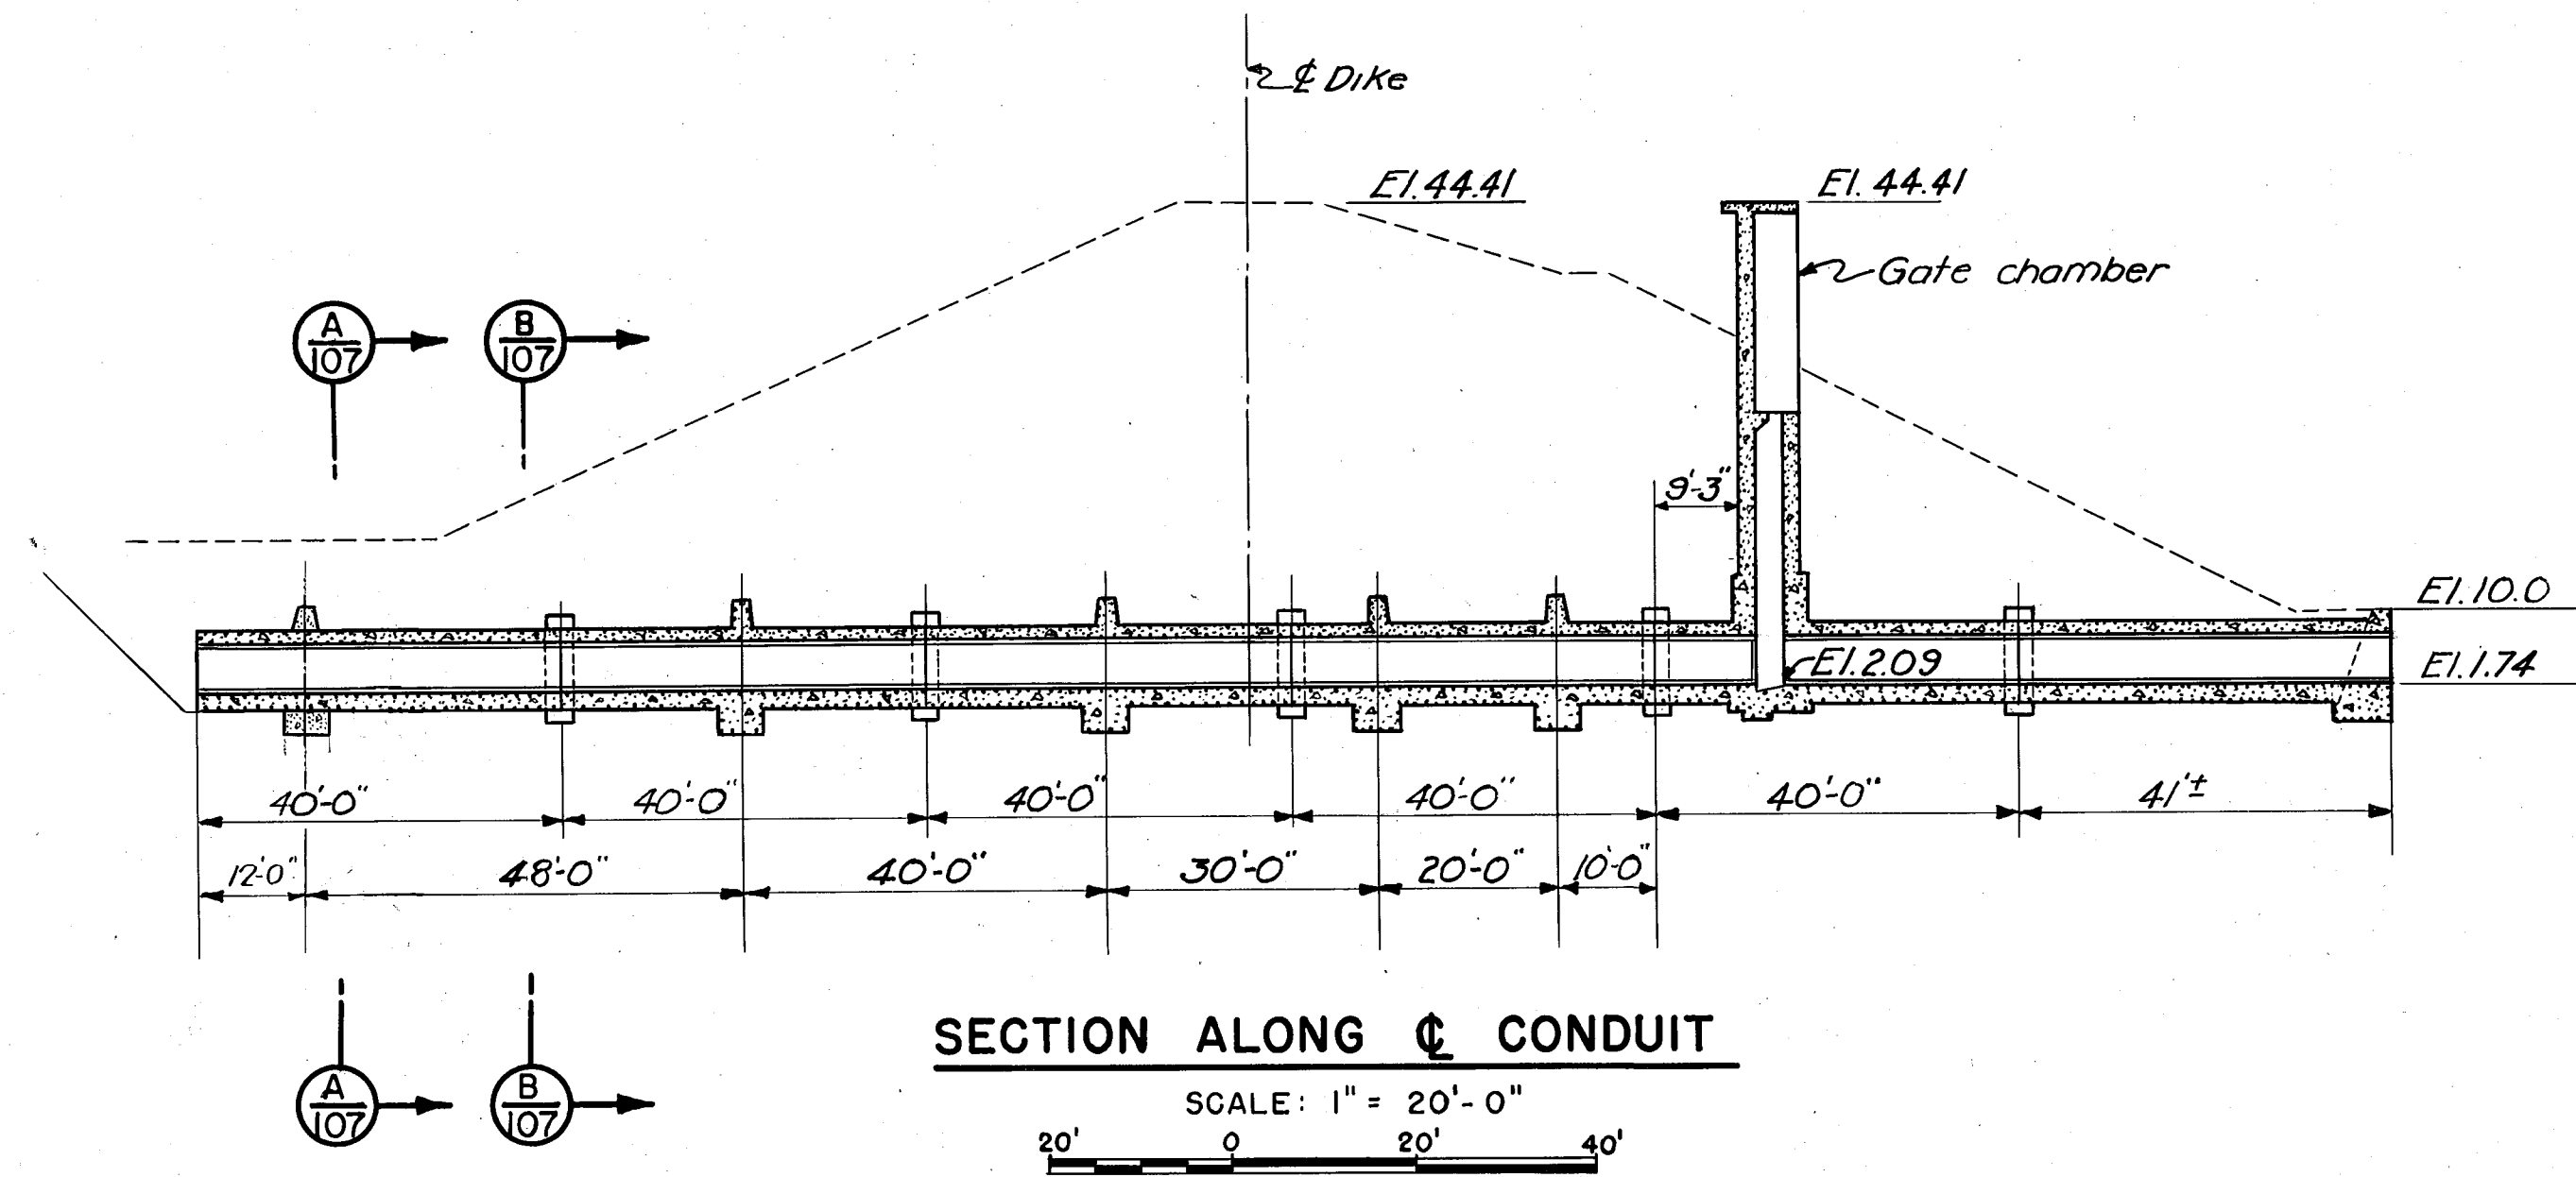


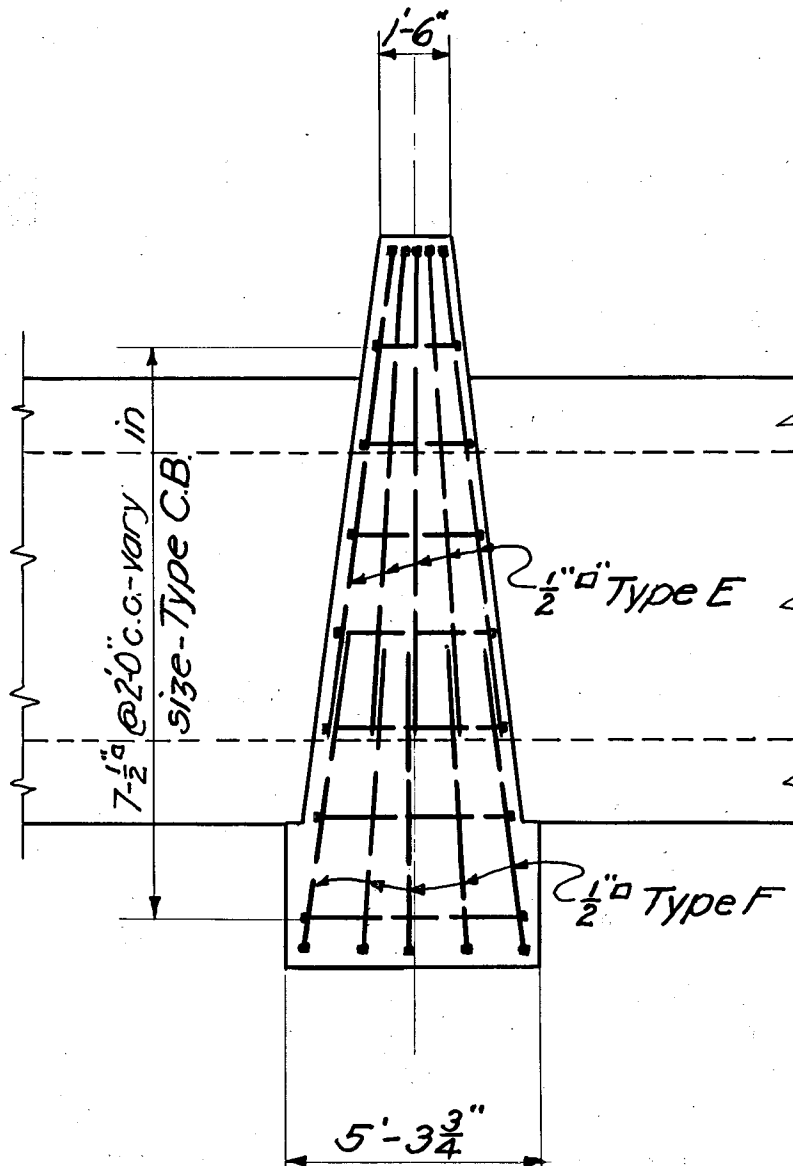

CONDUIT COLLARS


SCALE: 1/4" = 1'-0"

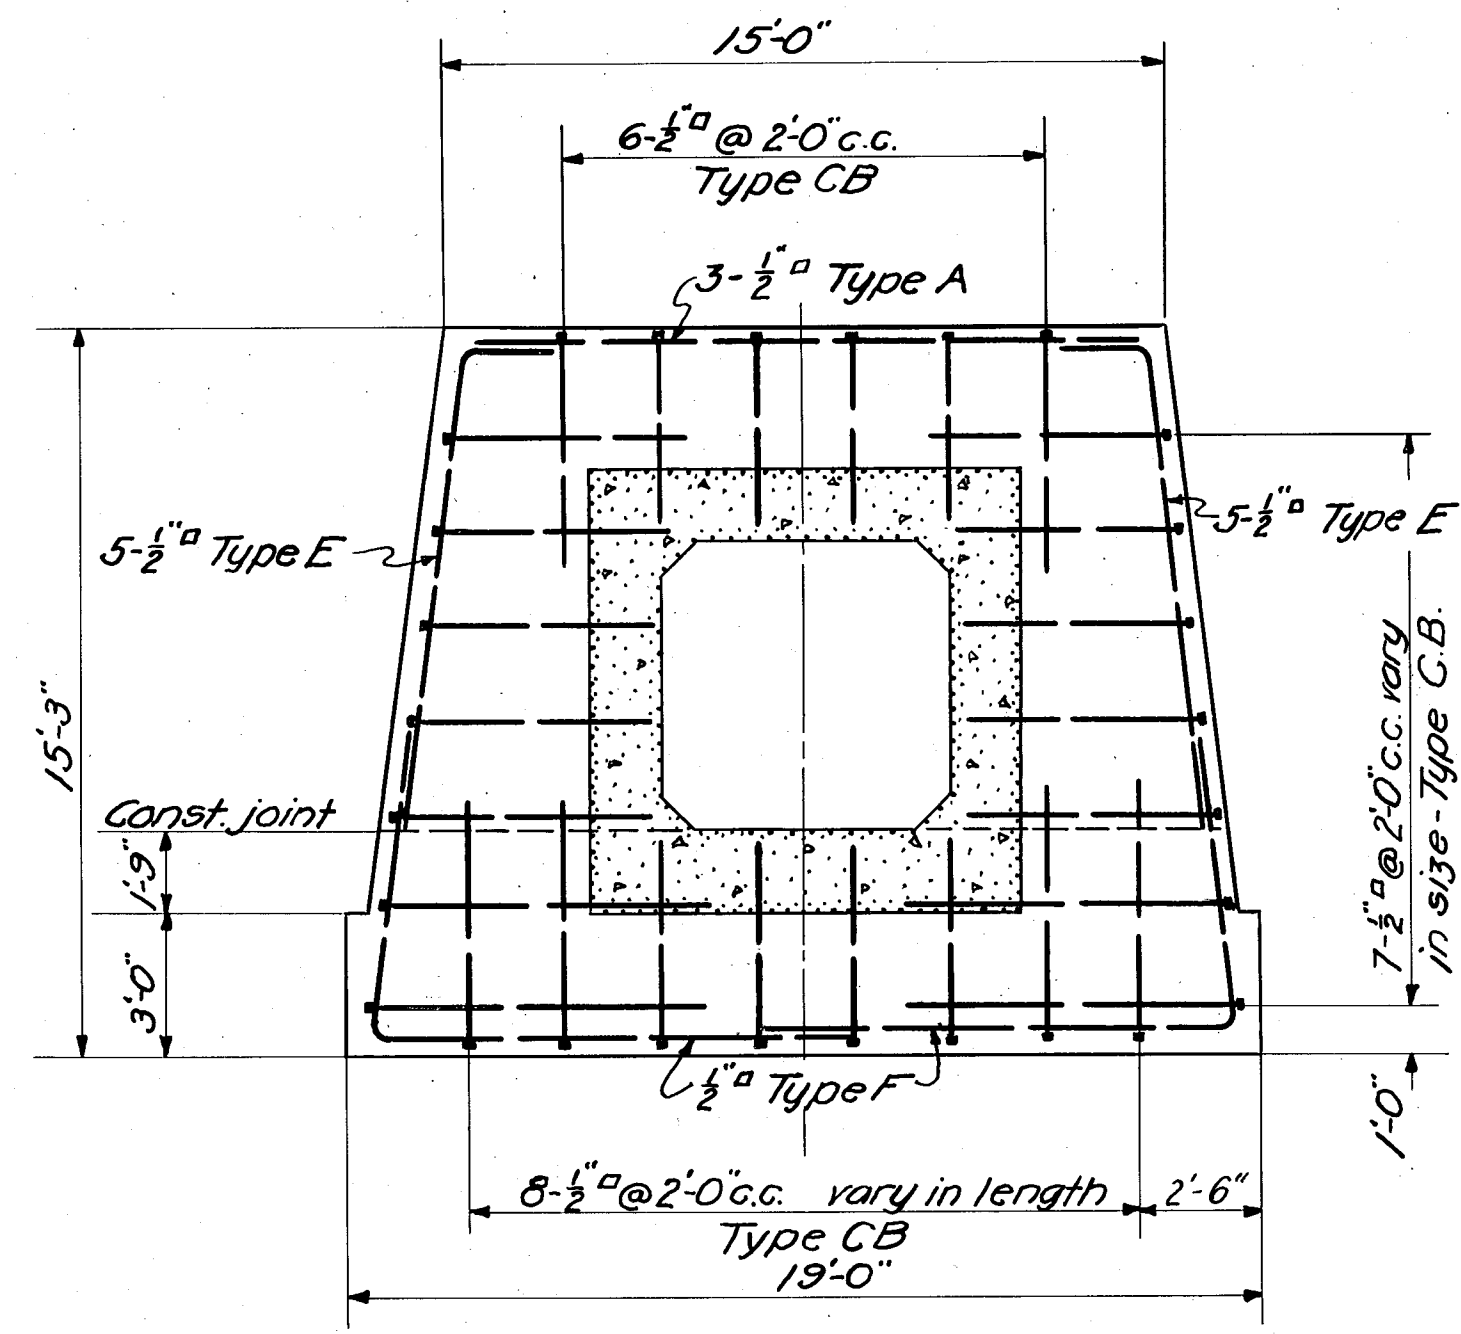

SEEP RING

5 REQUIRED
SCALE: 1/4" = 1'-0"

Note: All longitudinal bars are 1/2" @ 1'-0" c.c. continuous between expansion joints except at gate structure.

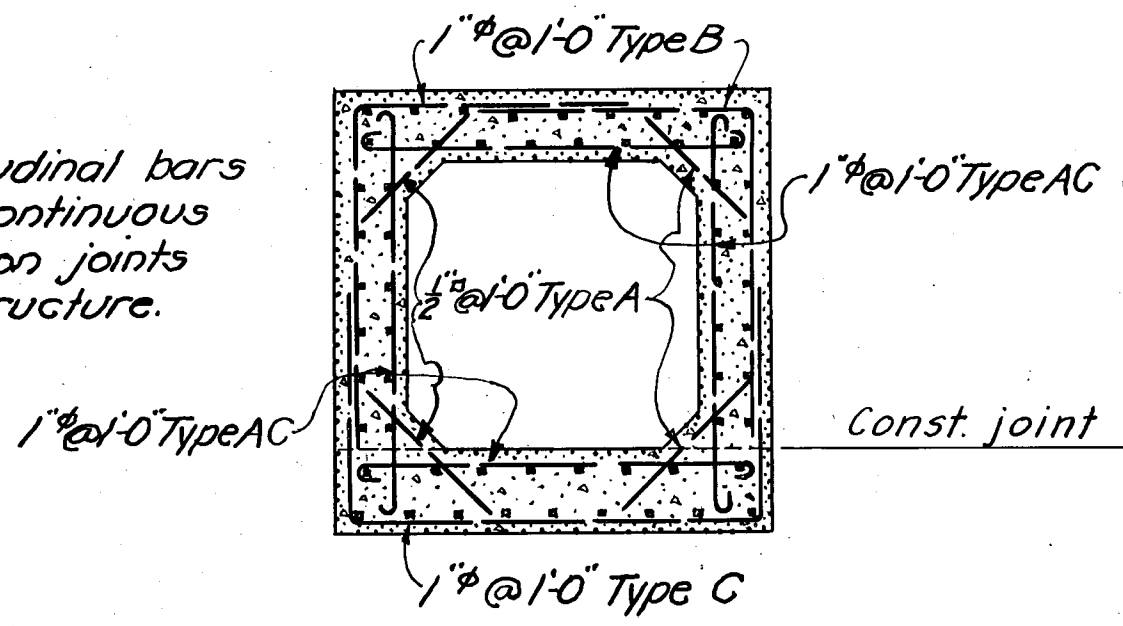

TYPICAL CONDUIT SECTION

SCALE: 1/4" = 1'-0"

NOTES:

For concrete details see Sheet No. 34.
For additional reinforcement details see Sheet No. 108.
For bar type schedule see Sheet No. 85.
The minimum cover for main steel reinforcement is 3" except where concrete is poured against earth in which case it is 4".
Bar splices are equal in length to 40 diameters of the smaller bar.
Radius of bend of bars is equal to 4 diameters of the bar.
Payment for furnishing, bending, and placing of steel reinforcement was made under Item No. 25.

CONNECTICUT RIVER FLOOD CONTROL
HARTFORD DIKE
RIVERFRONT, MORGAN ST. TO STA. 96+73
KEENEY LANE CONDUIT AND GATE STRUCTURE
STEEL REINFORCEMENT NO. 1

CONNECTICUT RIVER IN 135 SHEETS SCALE: 1/4" = 1 FT. CONNECTICUT SHEET NO. 107

U.S. ENGINEER OFFICE, PROVIDENCE, R.I., MAY 1940

SUBMITTED: [Signature] SENIOR ENGINEER
APPROVAL: [Signature] PRINCIPAL ENGINEER
RECOMMENDED: [Signature] CHIEF, F.C. ENGINEERING DIV.
APPROVED: [Signature] DISTRICT ENGINEER

DESIGNED: [Signature] ASSOC. ENGINEER
DRAWN: J.M.L.
TRACED: H.E.B.
CHECKED: [Signature]

FISCAL YEAR 1940
FILE NO. CT-4-2567

KEY	DATE	REVISION (Indicated by Δ)	REV. BY	CK. BY	AP. BY
	12-31-45	As built revisions.			