
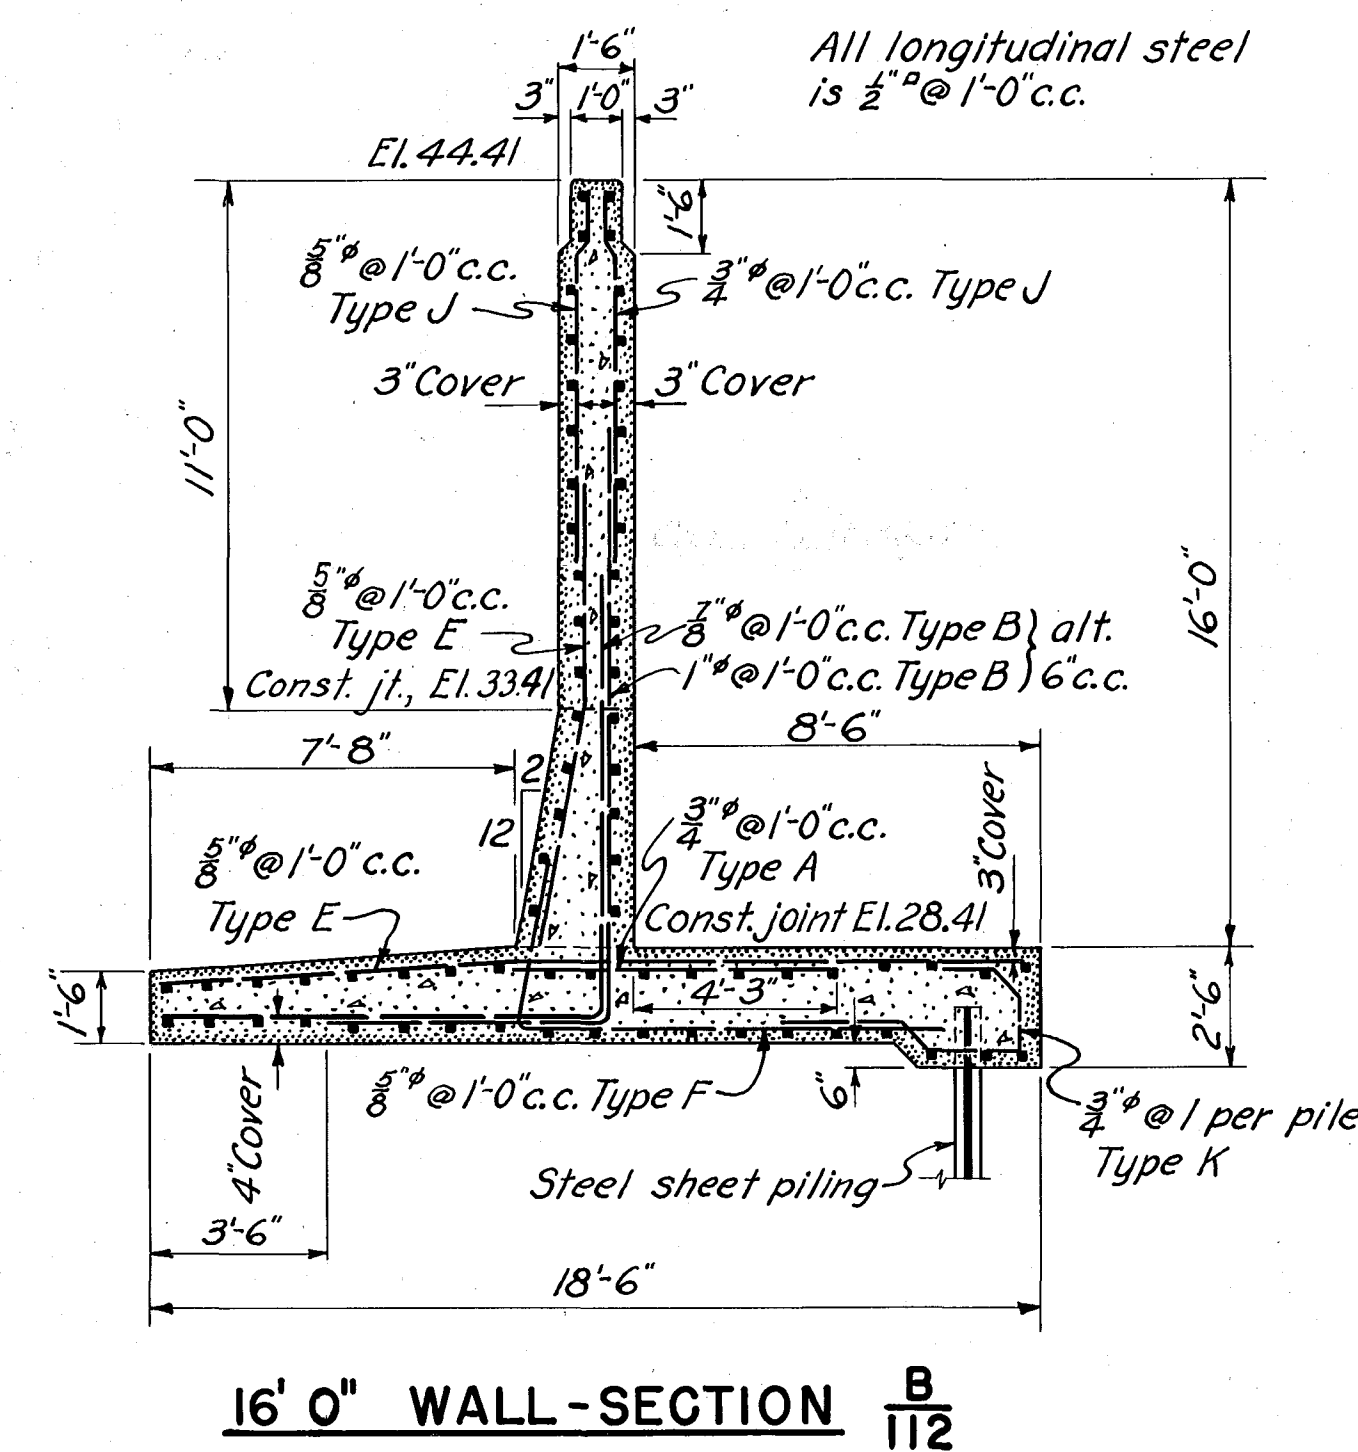


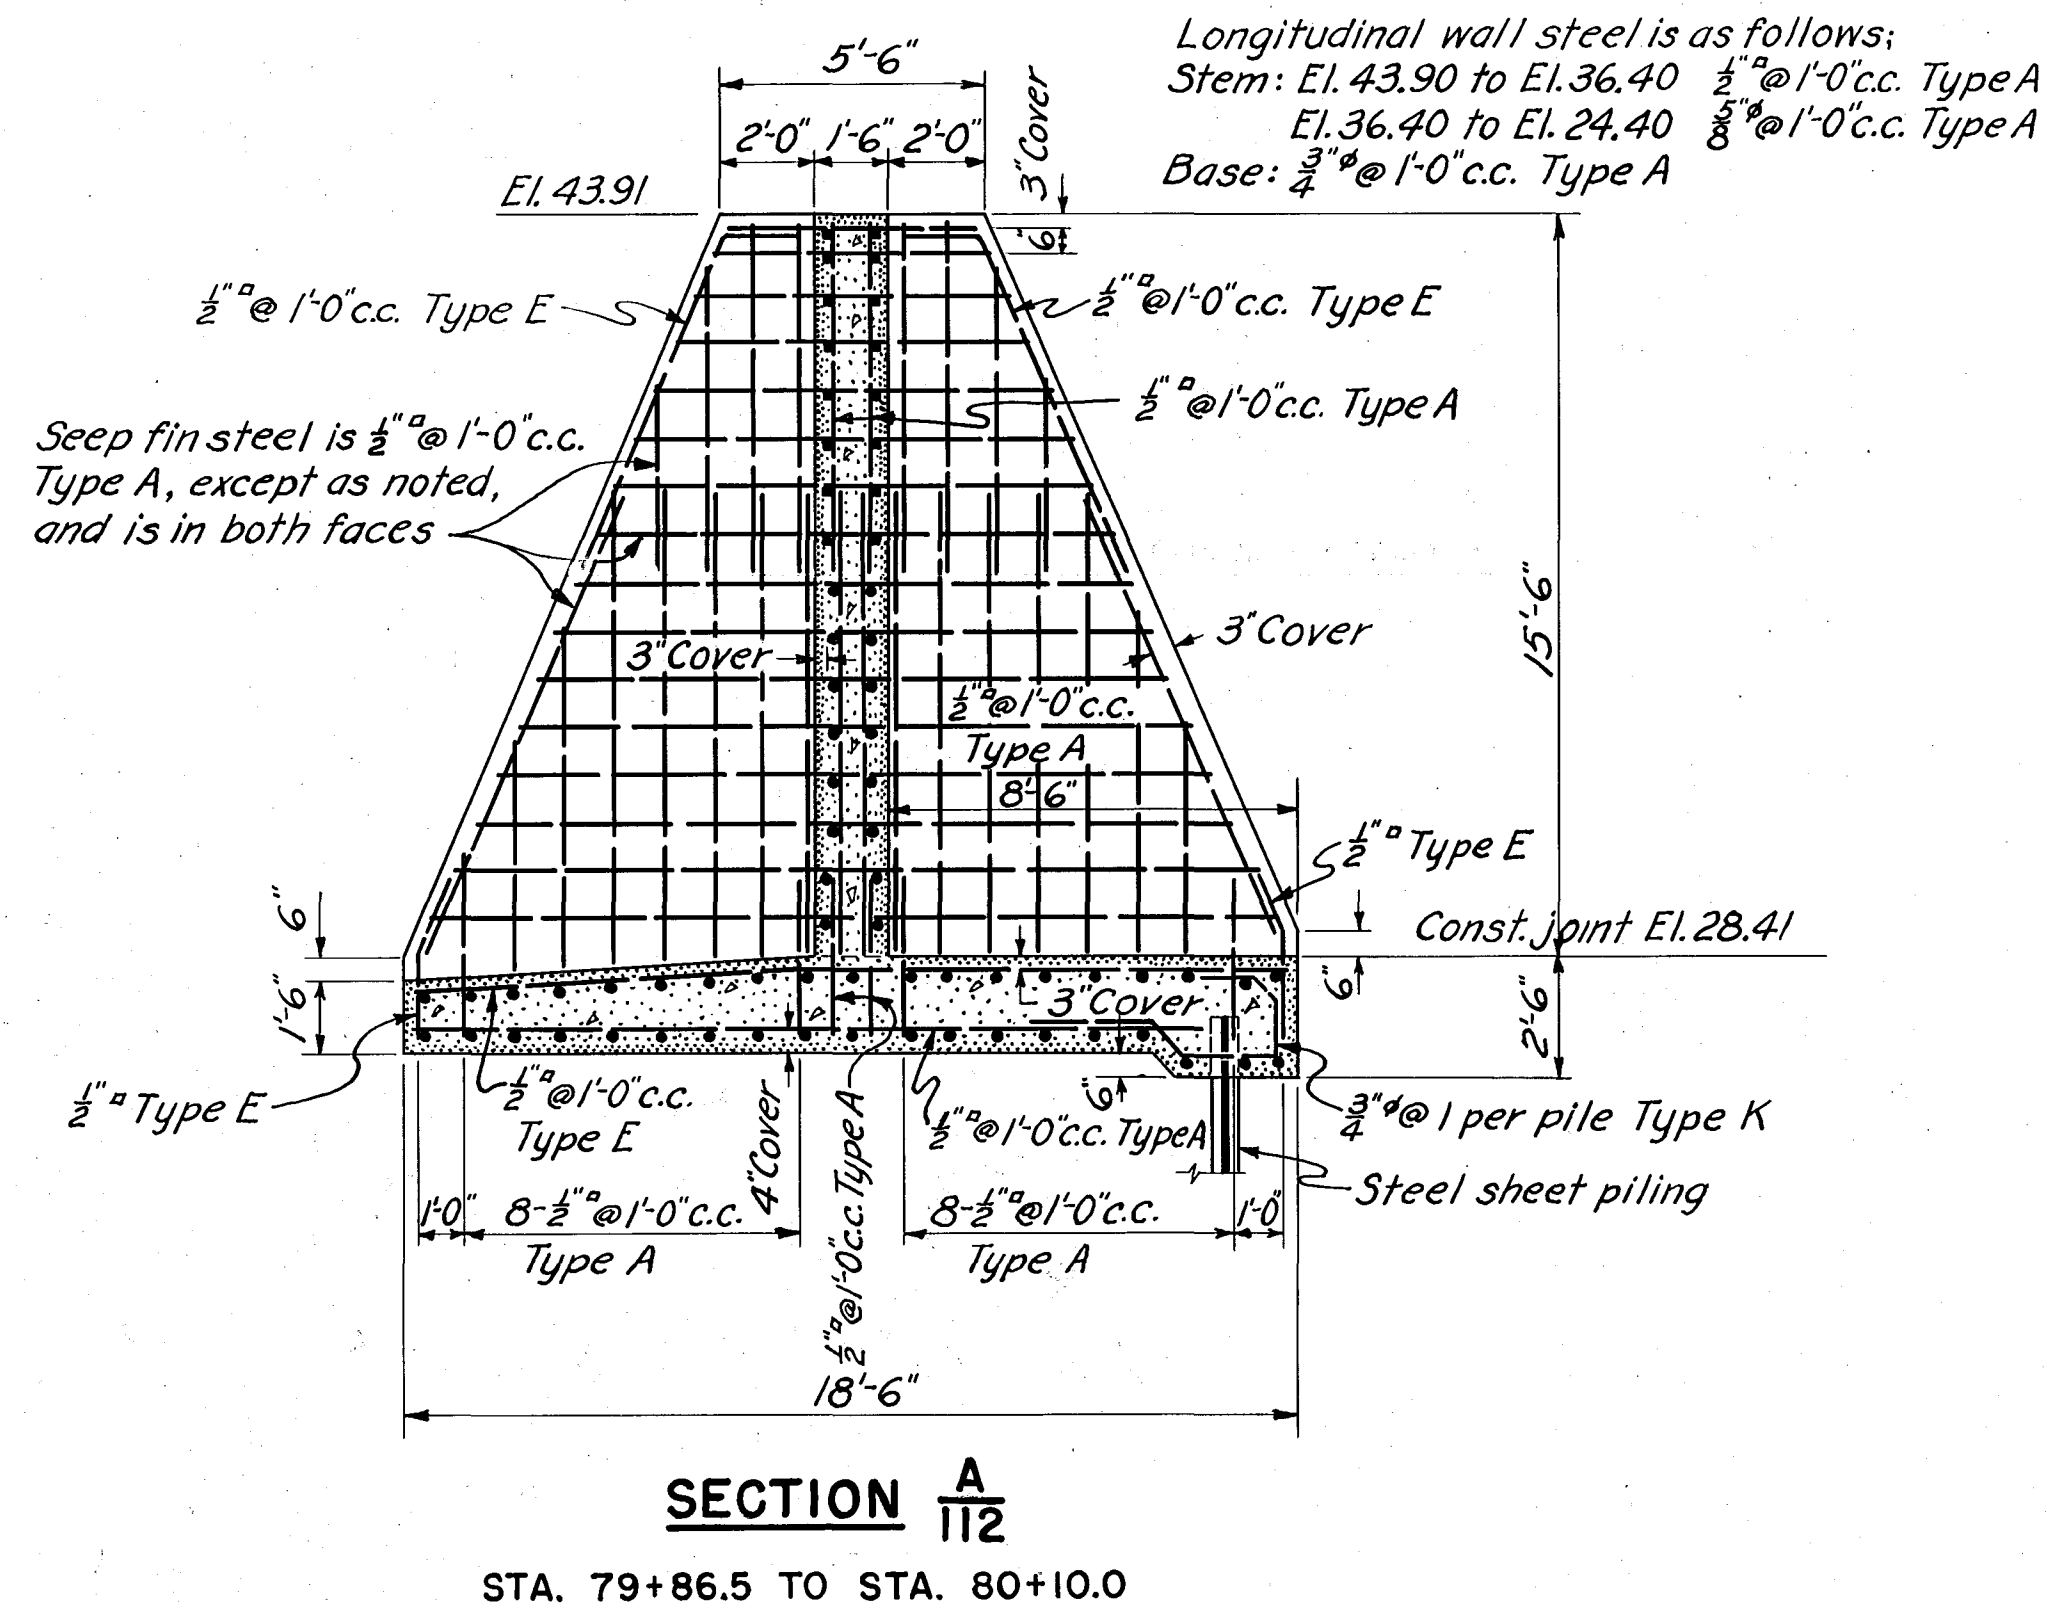

For concrete details see Sheets No.59 and 74.
For bar type schedule see Sheet No.85.
The minimum cover for main steel reinforcement is 3" except where concrete is poured against earth in which case it is 4".
Bar splices are equal in length to forty diameters of the smaller bar.
Radius of bend of bars is equal to 4 diameters of the bar.
Payment for furnishing, bending and placing of steel reinforcement was made under Item No.25.

	12-31-45	As built revisions			
△	3/10/41	Note added	gcp	kw	gms
KEY	DATE	REVISION (Indicated by △)	REV. BY	CK. BY	AP. BY

CONNECTICUT RIVER FLOOD CONTROL HARTFORD DIKE RIVERFRONT, MORGAN ST. TO STA. 96+73 WALL DETAILS-STA. 79+86.5 TO STA. 85+17.5 STEEL REINFORCEMENT		
CONNECTICUT RIVER		CONNECTICUT
IN 135 SHEETS	SCALE: 1/4 IN. = 1 FT.	SHEET NO. 112
		
U. S. ENGINEER OFFICE, PROVIDENCE, R. I., SUBMITTED: APPROVED/RECOMMENDED: APPROVED: <i>Bruce B. Higgins</i> SENIOR ENGINEER HEAD, DESIGN SECTION <i>W. J. Burns</i> PRINCIPAL ENGINEER CHIEF, F.G. ENGINEERING DIV. <i>W. J. Higgins</i> LT. COL. CORPS OF ENGINEERS DISTRICT ENGINEER DESIGNED: <i>J. J. Higgins</i> ISSUING ENGINEER DRAWN: E. H. V. TRACED: A. S. CHECKED: A. J. M. FISCAL YEAR 1940 FISCAL NO. CT-4-2572		