



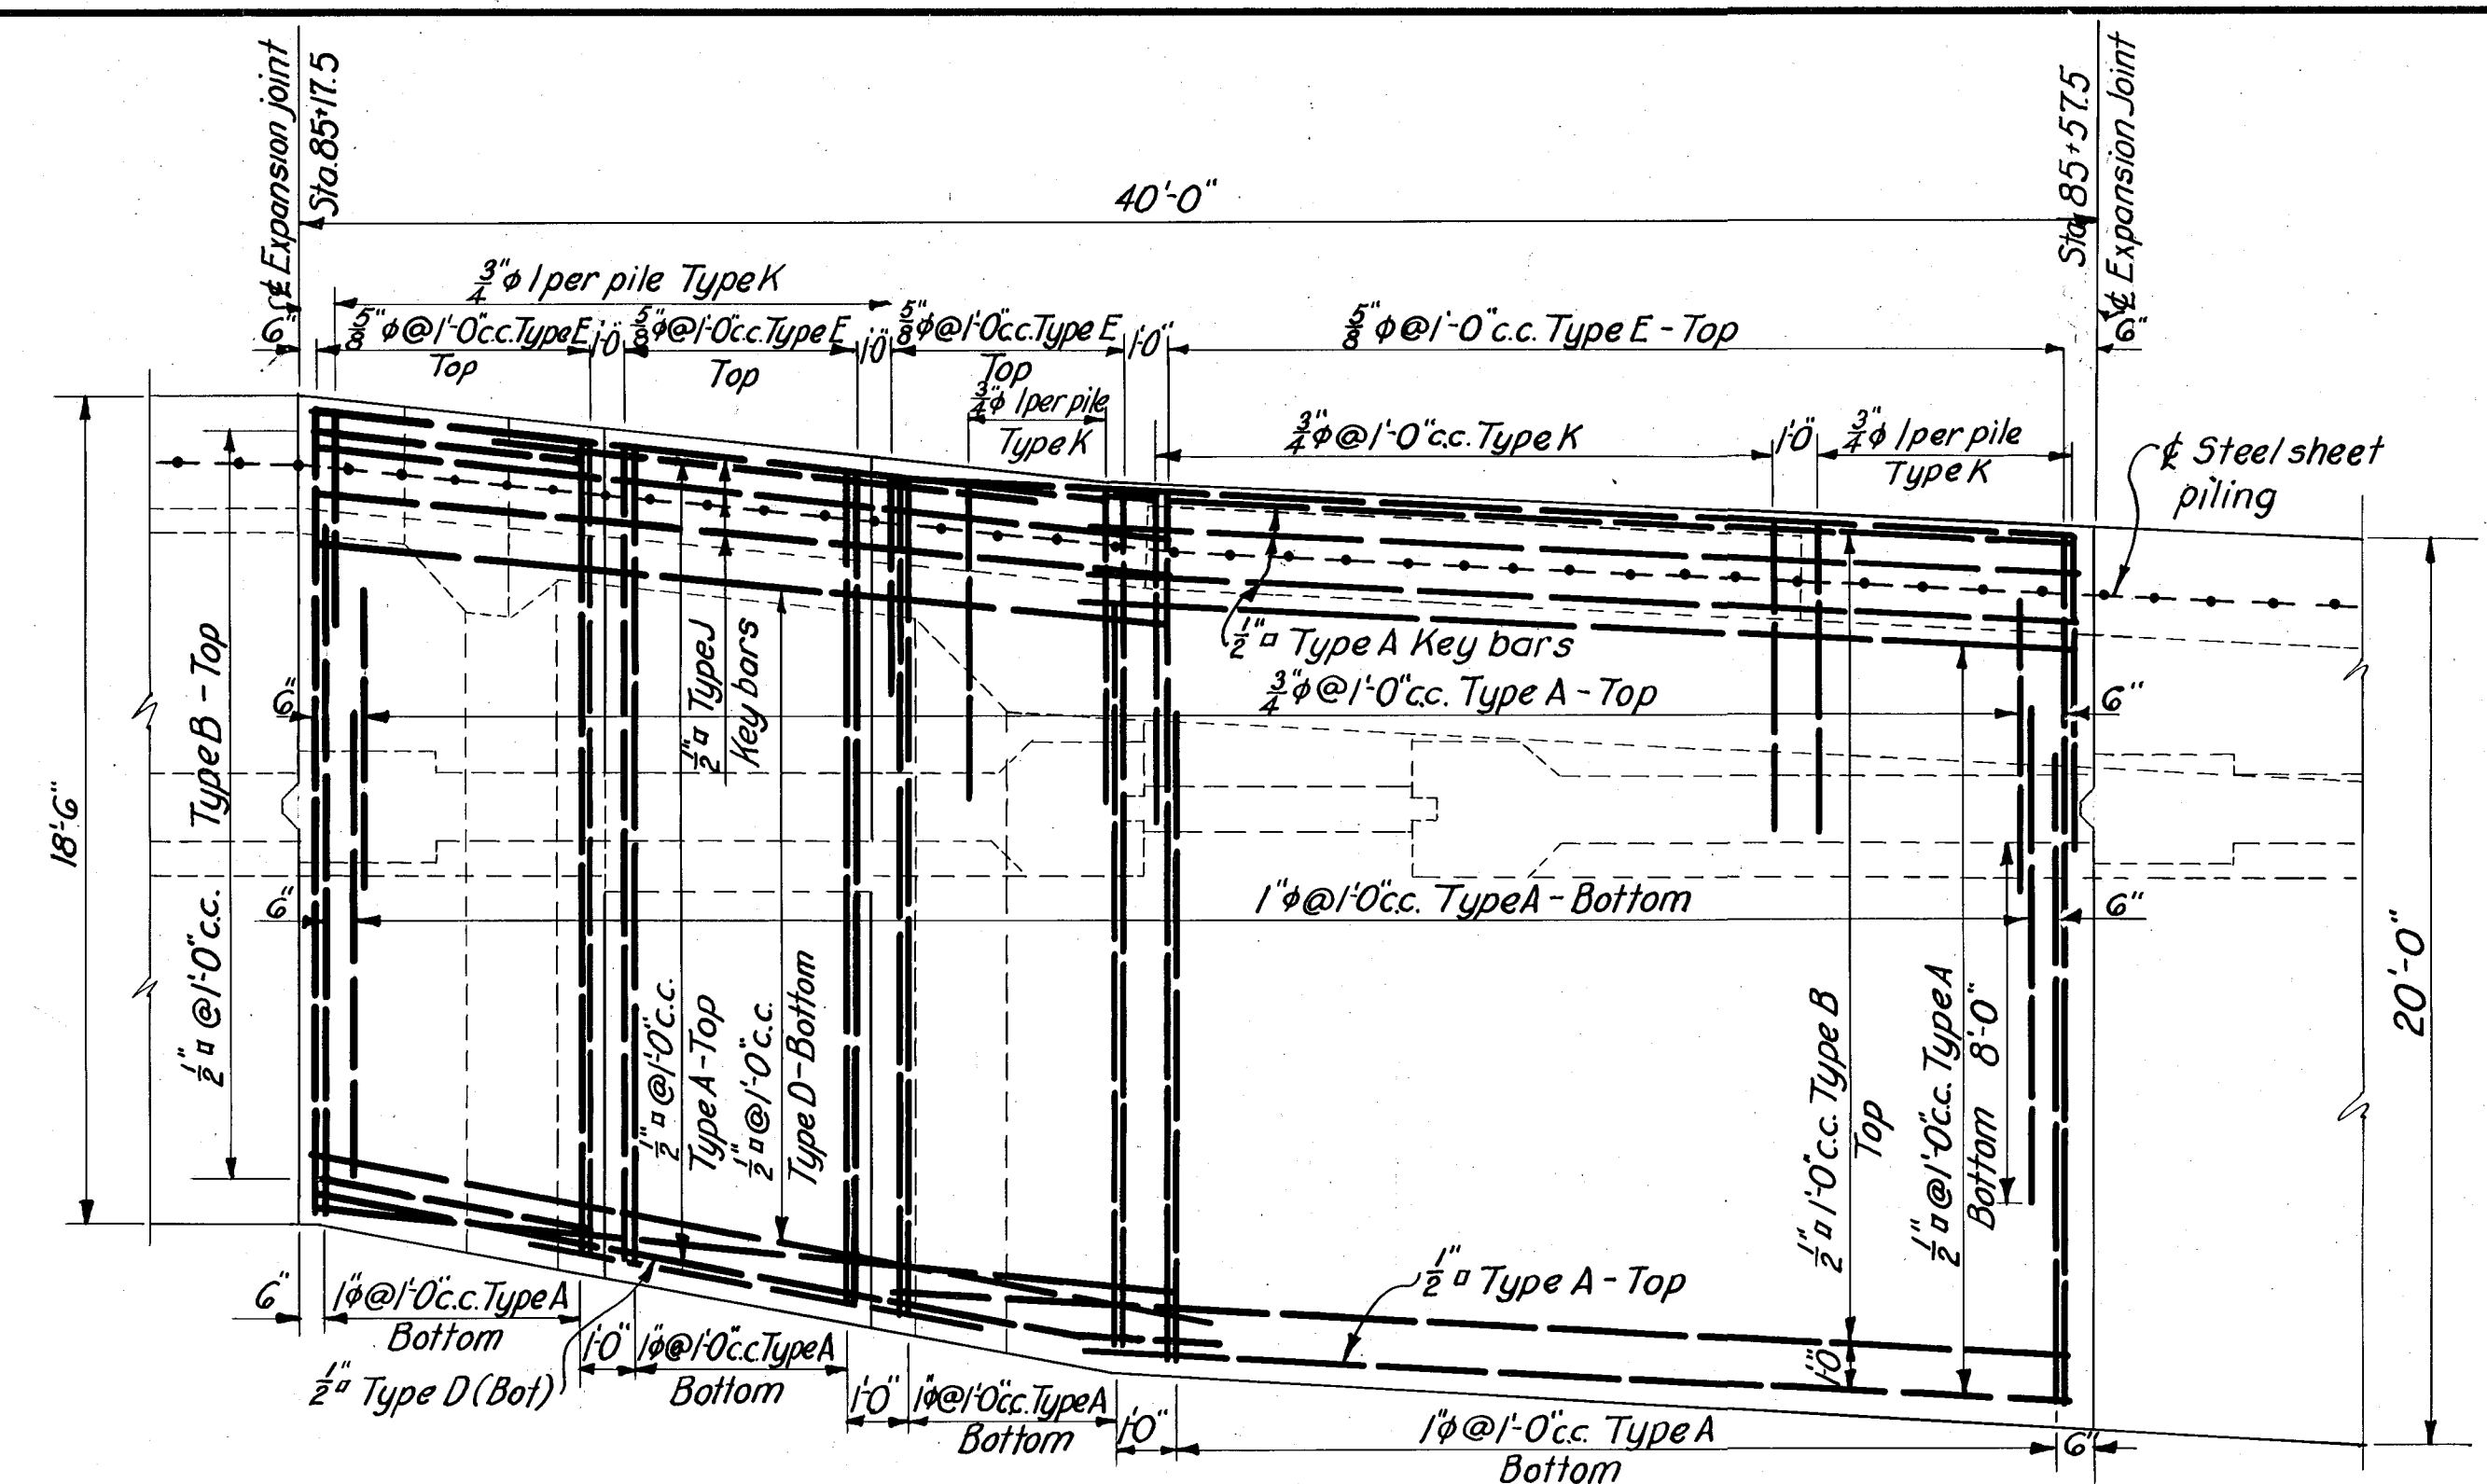

PLAN
BASE STEEL

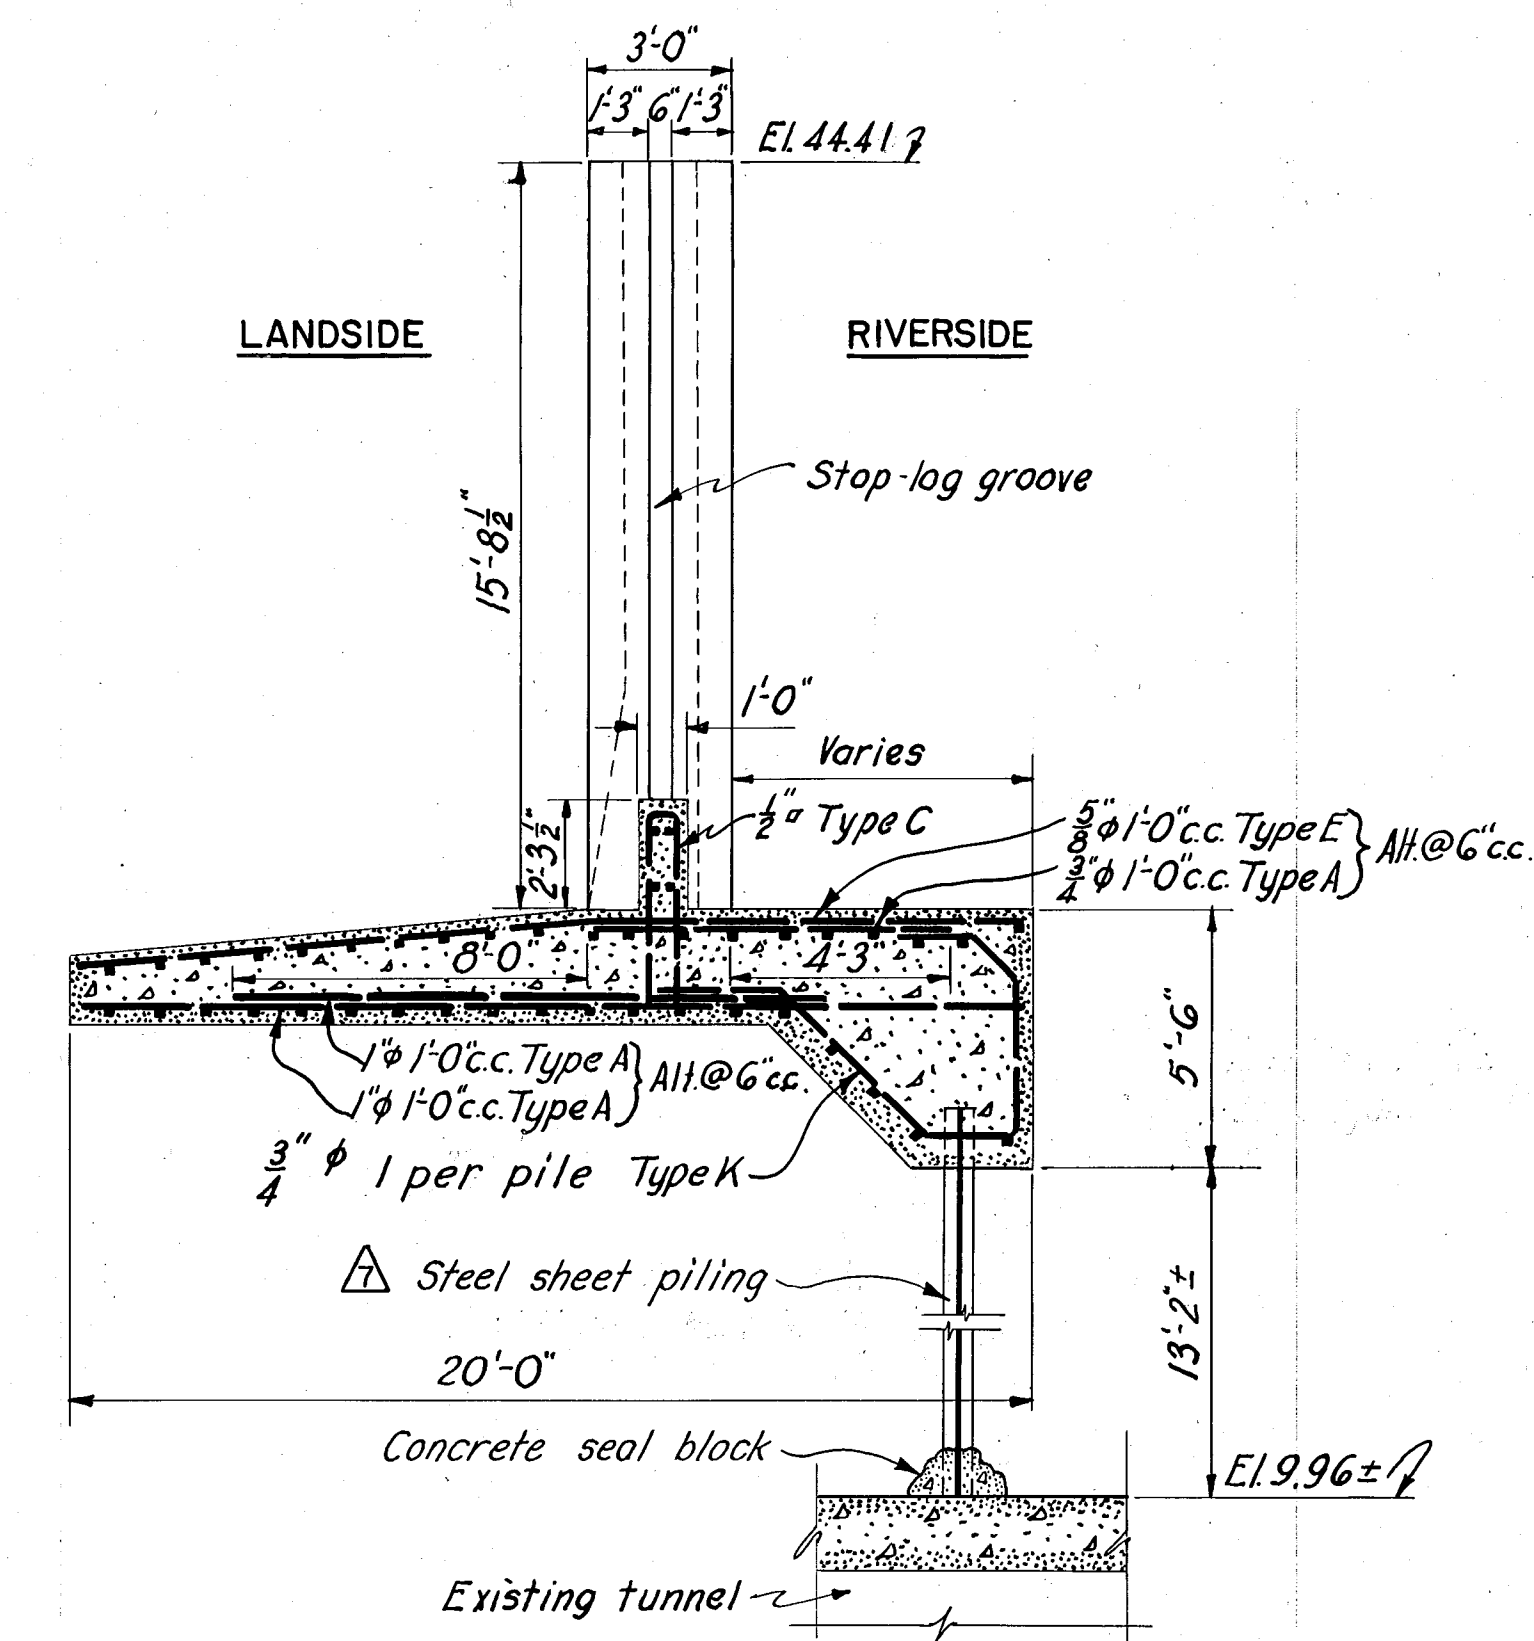

SECTION $\frac{A}{113}$

For concrete details see Sheet No.64 .
For general notes see Sheet No.112 .

	12-31-45	As built revisions			
△	3-10-41	Change curtain wall	JCS	FW	MM
KEY	DATE	REVISION (Indicated by △)	REV. BY	CK. BY	AP. E

CONNECTICUT RIVER FLOOD CONTROL		
HARTFORD DIKE		
RIVERFRONT, MORGAN ST. TO STA. 96+73.		
STOP-LOG STRUCTURE NO. I		
STEEL REINFORCEMENT NO. I		
CONNECTICUT RIVER		CONNECTICUT
IN 135 SHEETS	SCALE: 1/4"=1 FT.	SHEET NO. 113
		
U.S. ENGINEER OFFICE, PROVIDENCE, R.I.,		MAY 1940
SUBMITTED:	APPROVAL RECOMMENDED:	APPROVED:
<i>Harold B. Fisher</i>	<i>W. C. Burns</i>	<i>W. C. Burns</i>
SENIOR ENGINEER	PRINCIPAL ENGINEER	LT. COL., CORPS OF ENGINEERS
HEAD, DESIGN SECTION	CHIEF, F.C. ENGINEERING DIV.	DISTRICT ENGINEER
DESIGNED BY:	DRAWN: U.M.S.	FISCAL YEAR 1940 FILE NO. CT-4-2573
<i>W. C. Burns</i>	TRACED: P.A.B.	
ASSIST. ENGINEER	CHECKED: <i>A. J. M.</i>	