




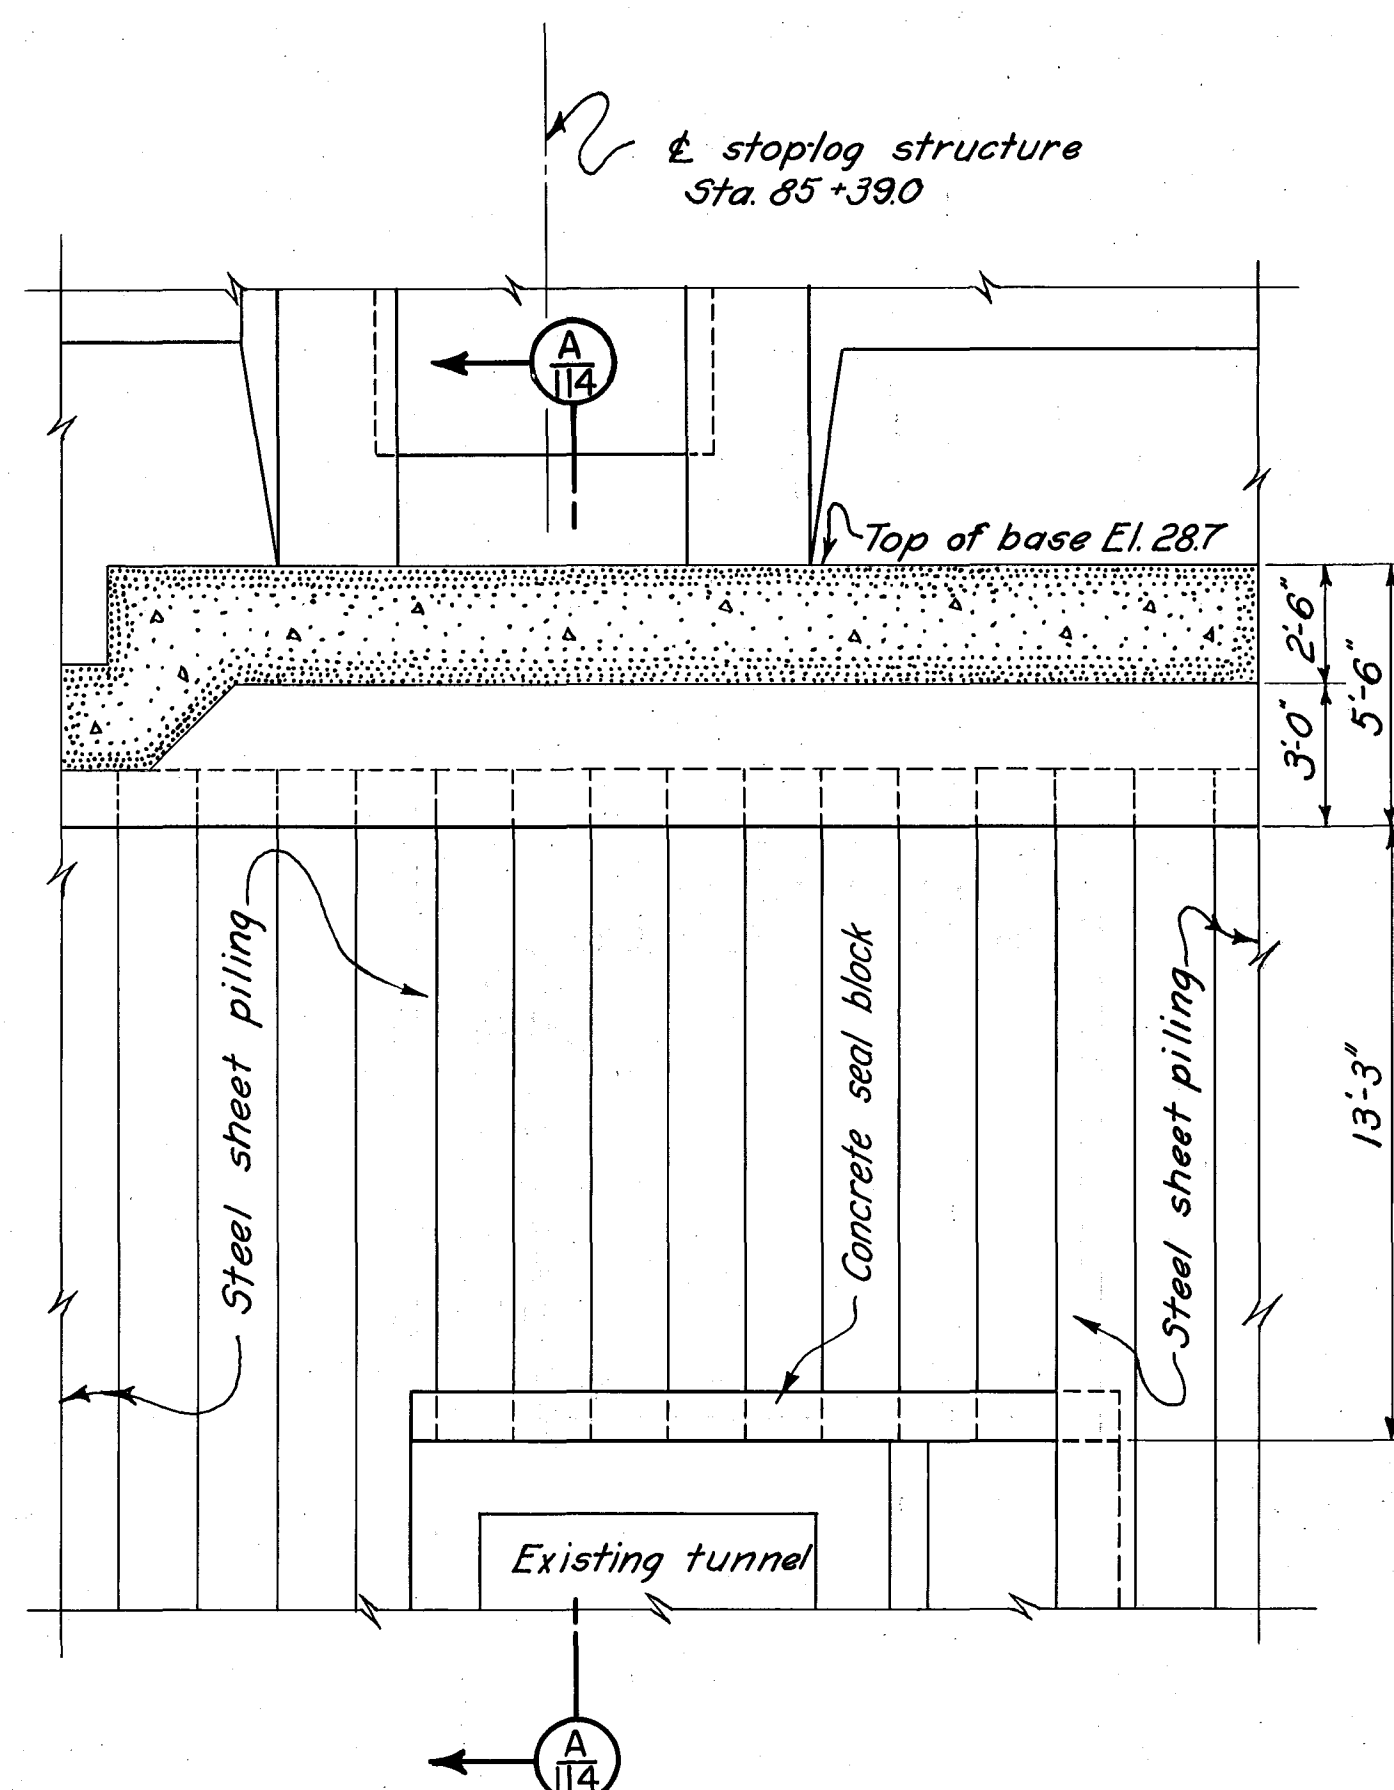




STEEL SHEET PILE CURTAIN WALL - STA. 85+43 ±

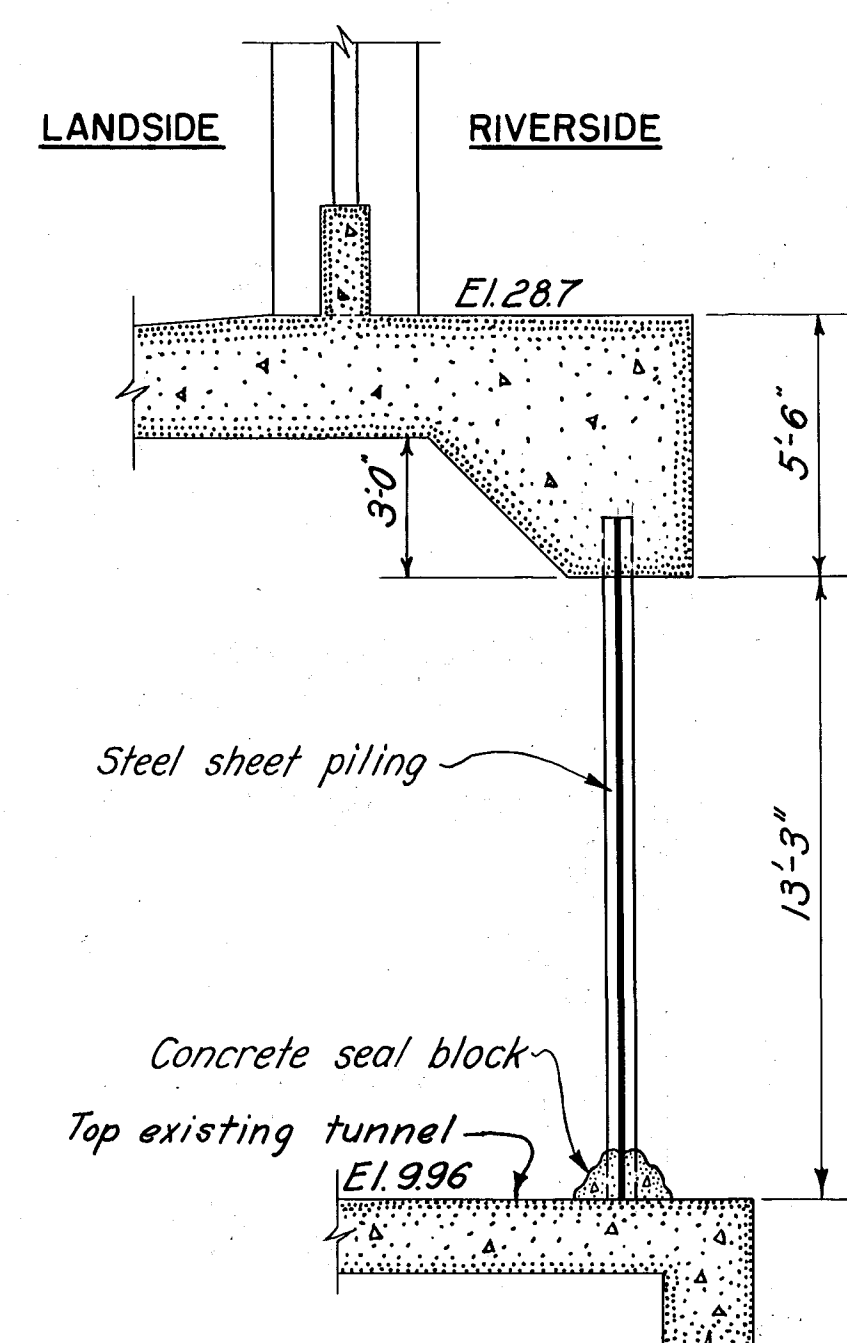

SECTION A 114

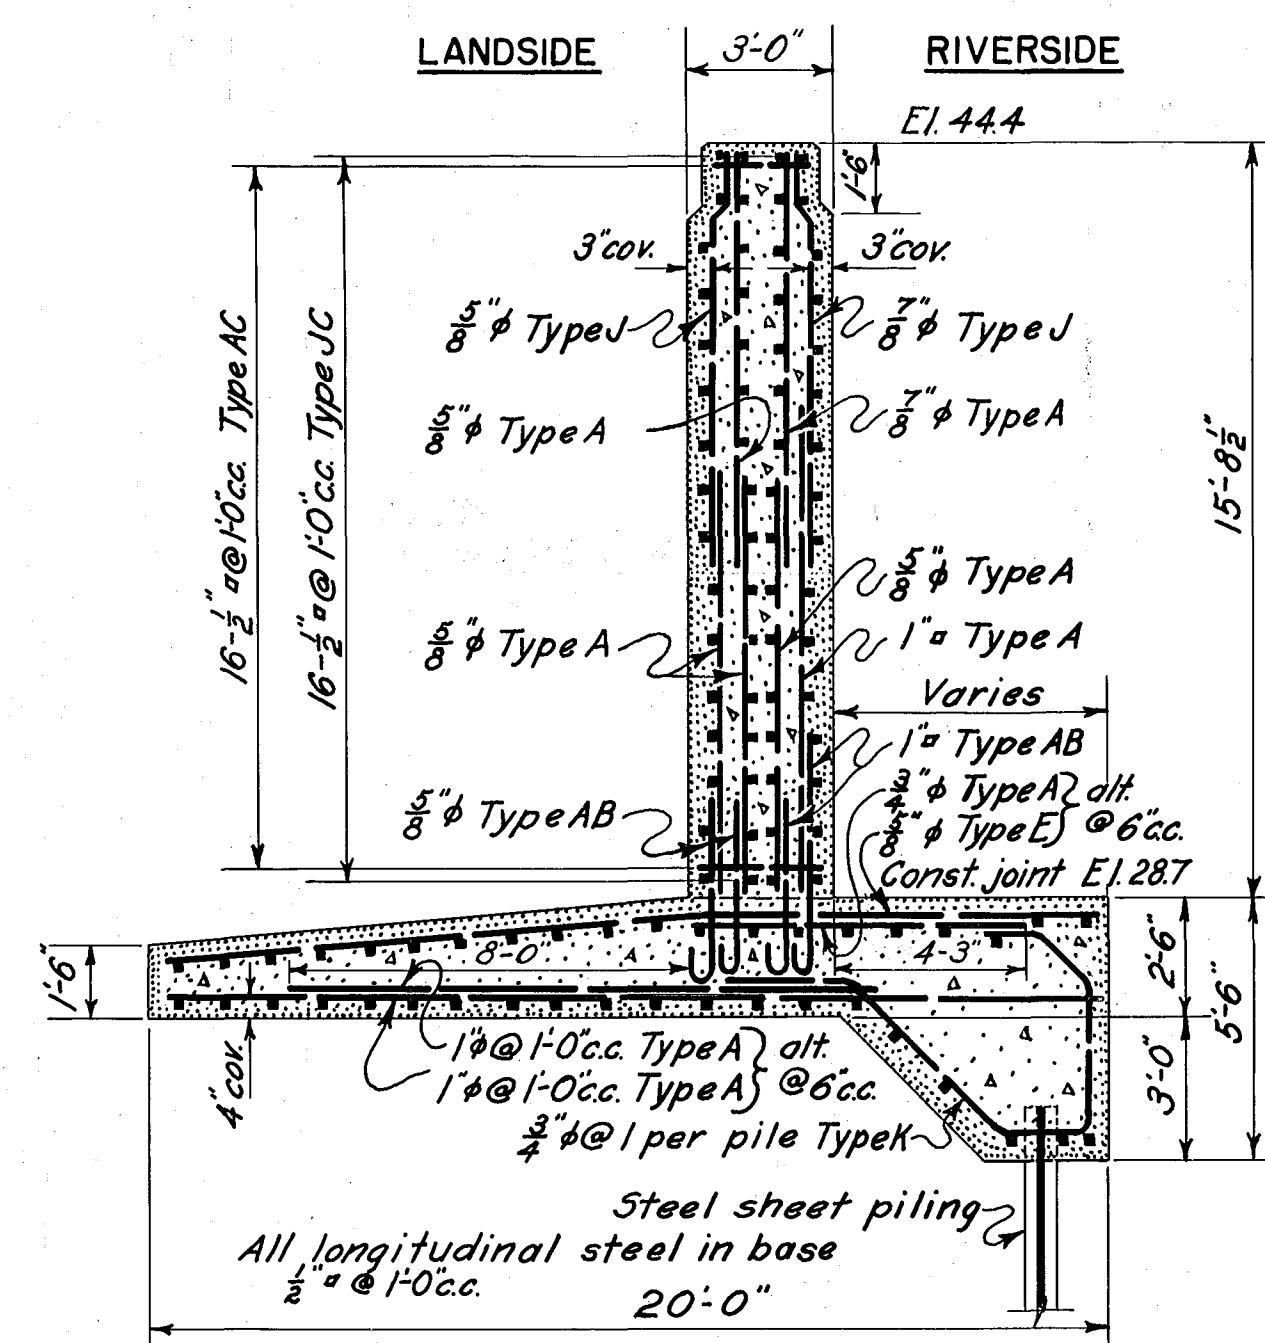

SECTION C 113

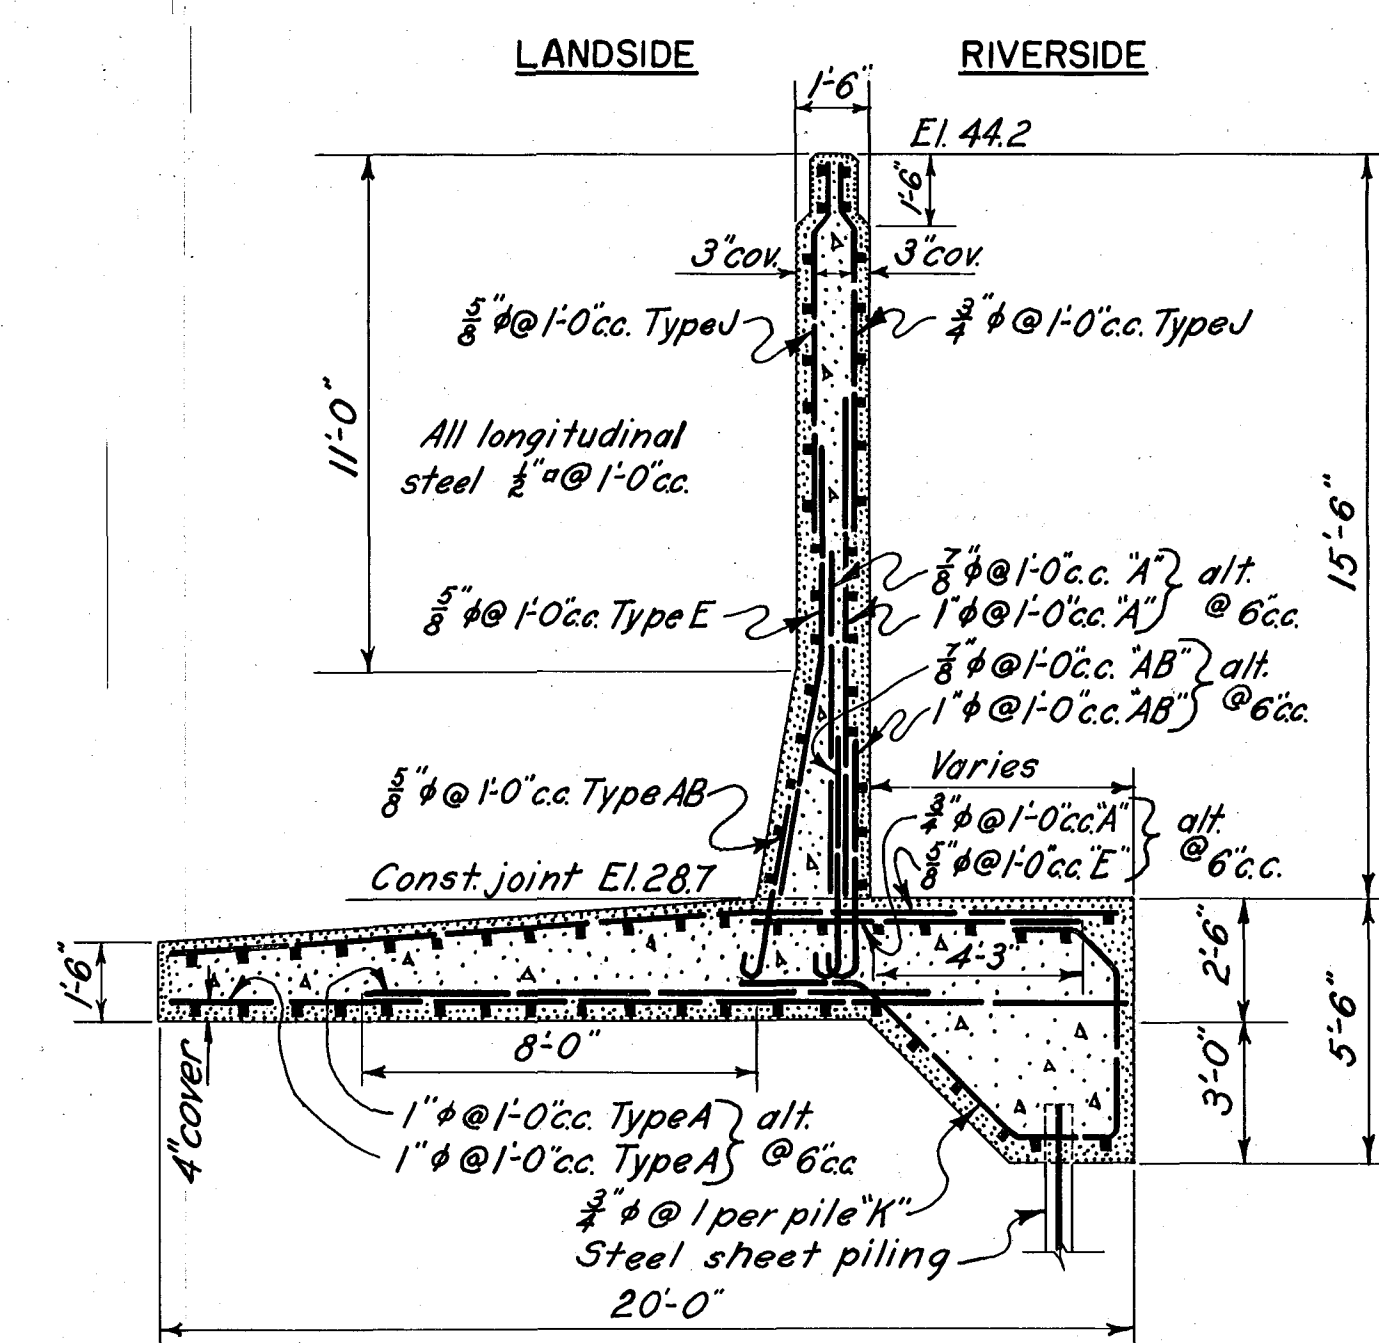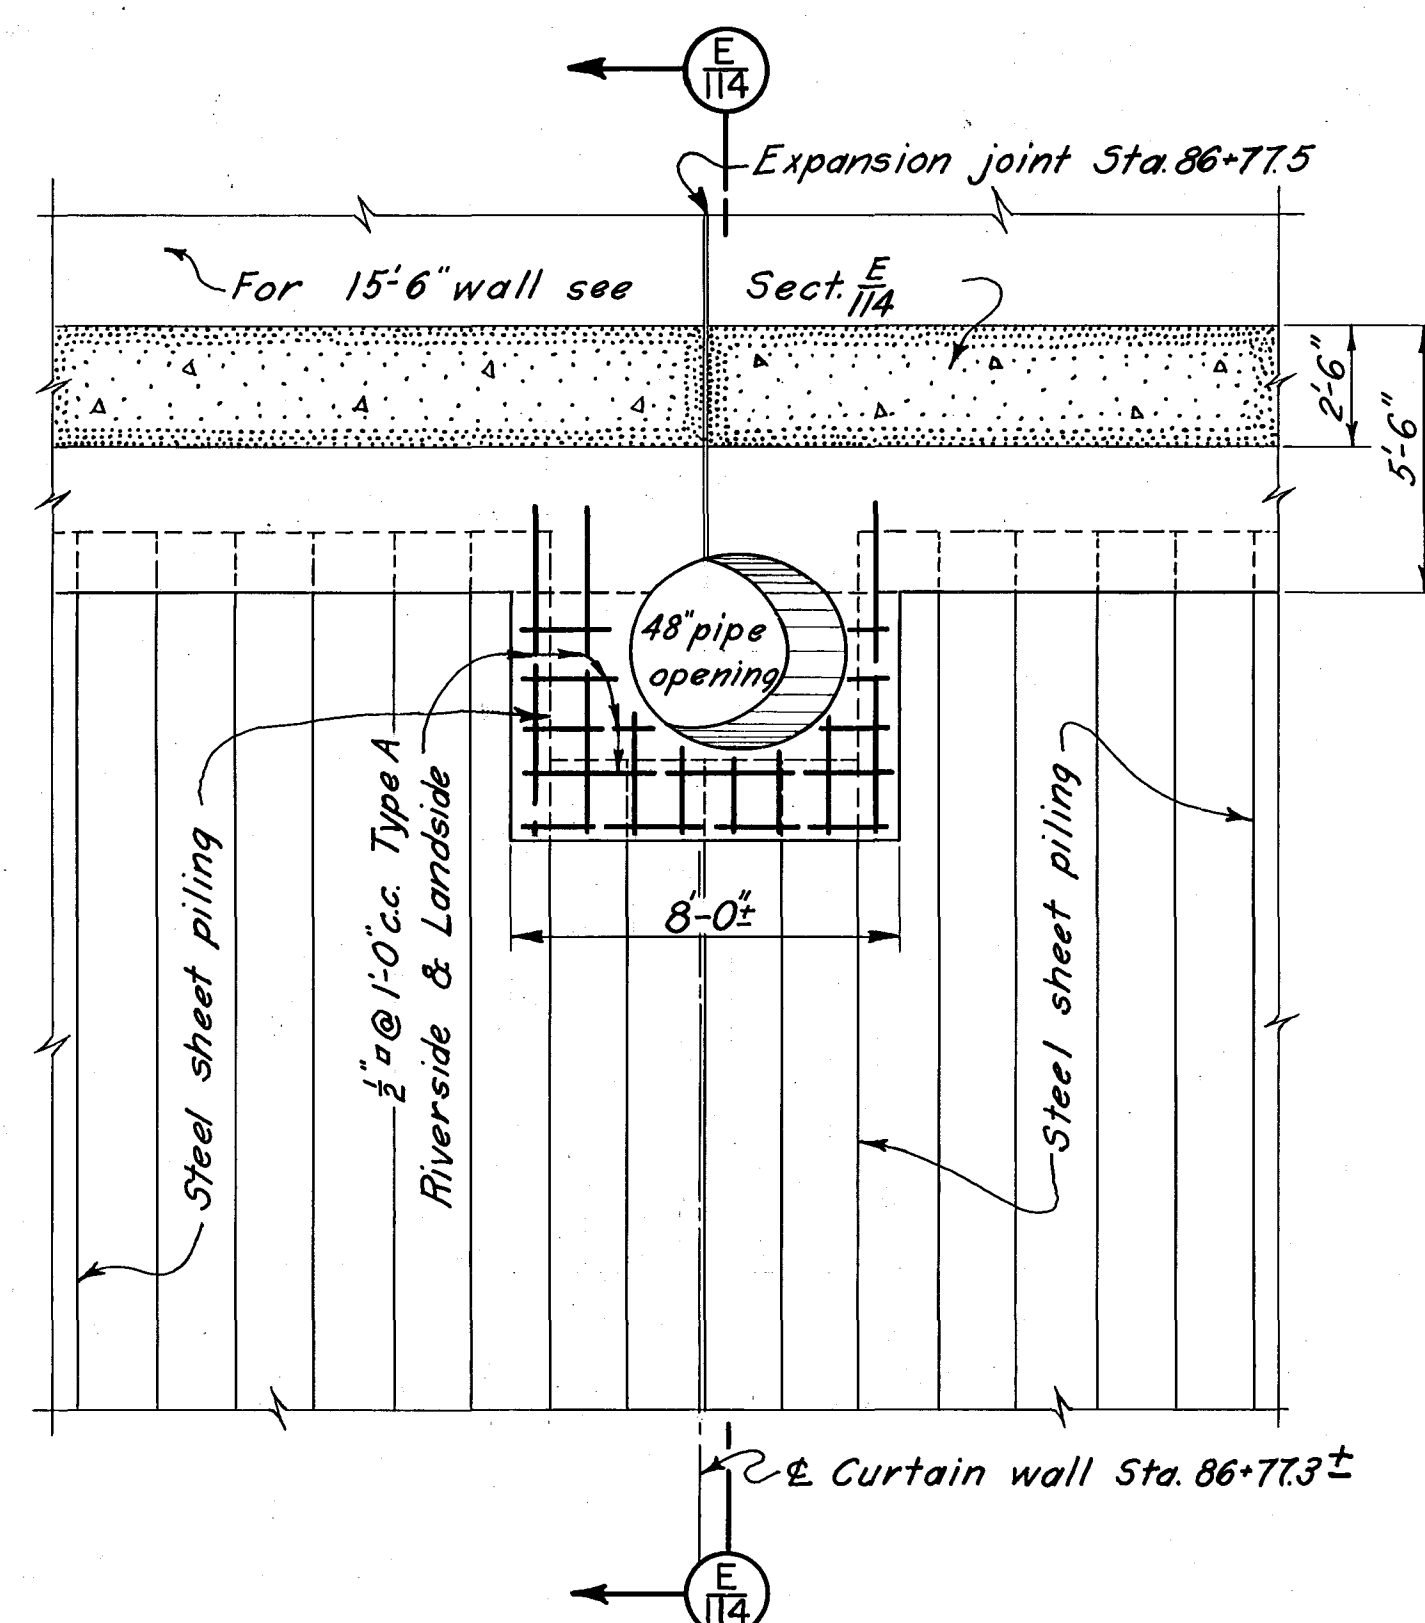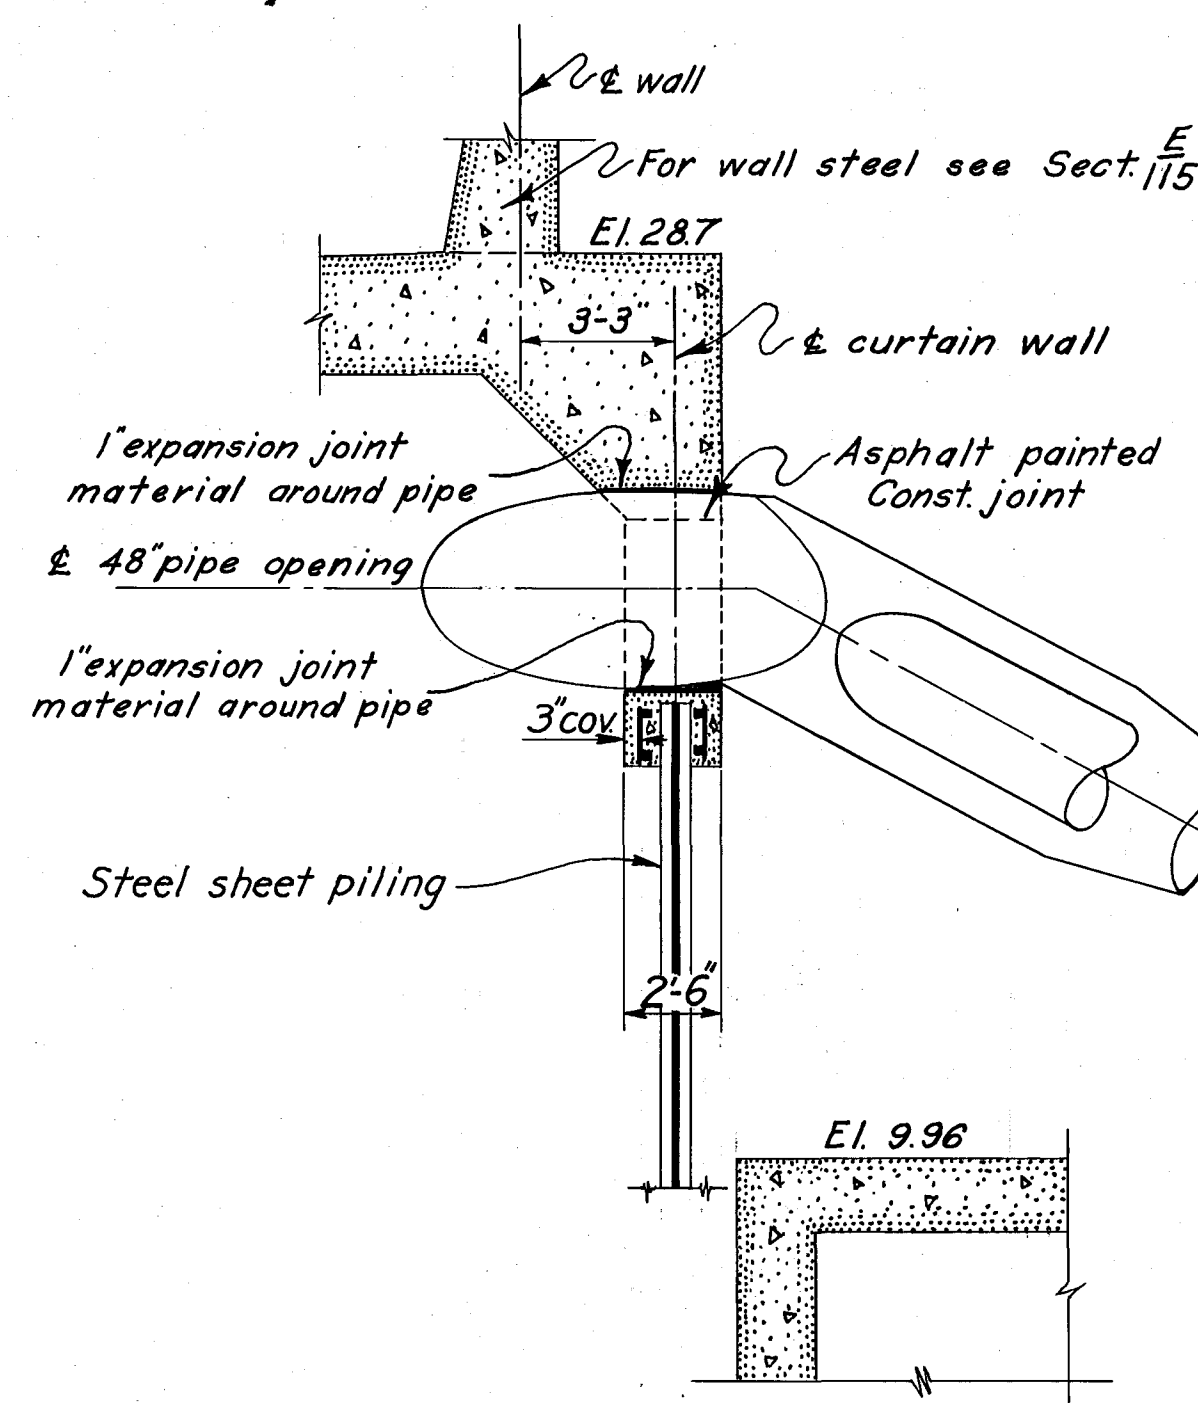SECTION D 113
TYPICAL FROM STA. 85+57.5 TO STA. 85+97.5LANDSIDE ELEVATION OF CURTAIN WALL
(STA. 86+80)

SECTION E 114

NOTES

For concrete details see Sheet No. 64 and 60
For general notes see Sheet No. 112

CONNECTICUT RIVER FLOOD CONTROL			
HARTFORD DIKE			
RIVERFRONT, MORGAN ST. TO STA. 96+73			
STOP-LOG STRUCTURE NO. 1			
STEEL REINFORCEMENT NO. 2			
CONNECTICUT RIVER		CONNECTICUT	
IN 135 SHEETS		SCALE: 1/4 IN. = 1 FT.	
SHEET NO. 114		SHEET NO. 114	
U.S. ENGINEER OFFICE, PROVIDENCE, R.I., MAY 1940			
SUBMITTED: <i>W. B. Nichols</i>		APPROVED: <i>W. B. Nichols</i>	
SENIOR ENGINEER		PRINCIPAL ENGINEER	
HEAD, DESIGN SECTION		CHIEF, F.O. ENGINEERING DIV.	
DESIGNED: <i>J. C. Duggan</i>		DRAWN: U.S. TRACED: U.S. CHECKED: <i>J. S. M.</i>	
ASSOC. ENGINEER		FISCAL YEAR 1940	
FILE NO. CT-4-2574			

KEY	DATE	REVISION (Indicated by Δ)	REV. BY	CK. BY	AP. BY
	12-31-45	As built revisions			
A	3/10/41	Change curtain walls	J.C.D.	W.B.	J.B.