




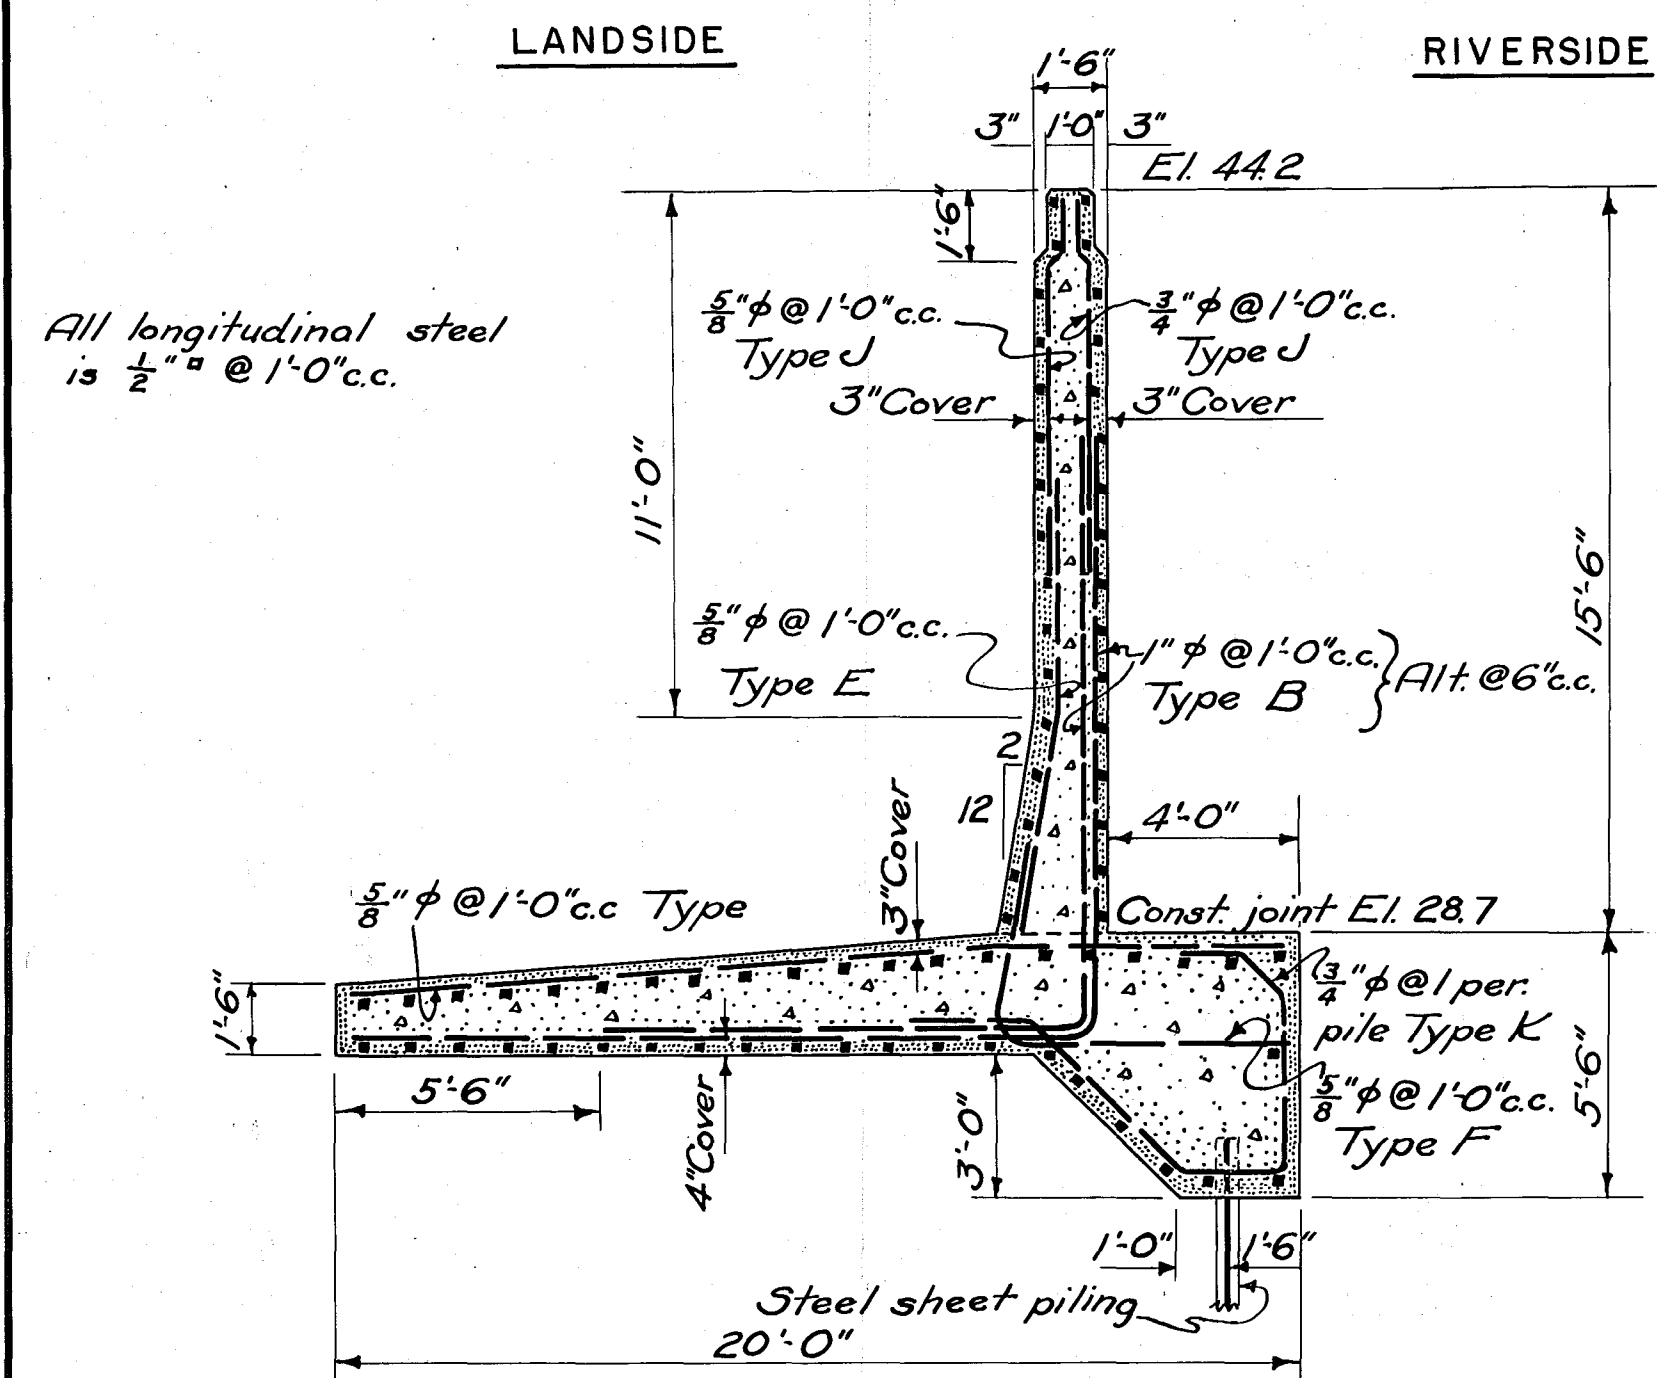


15'-6" WALL - SECTION A 118
STA. 87+17.5 TO STA. 87+39.93

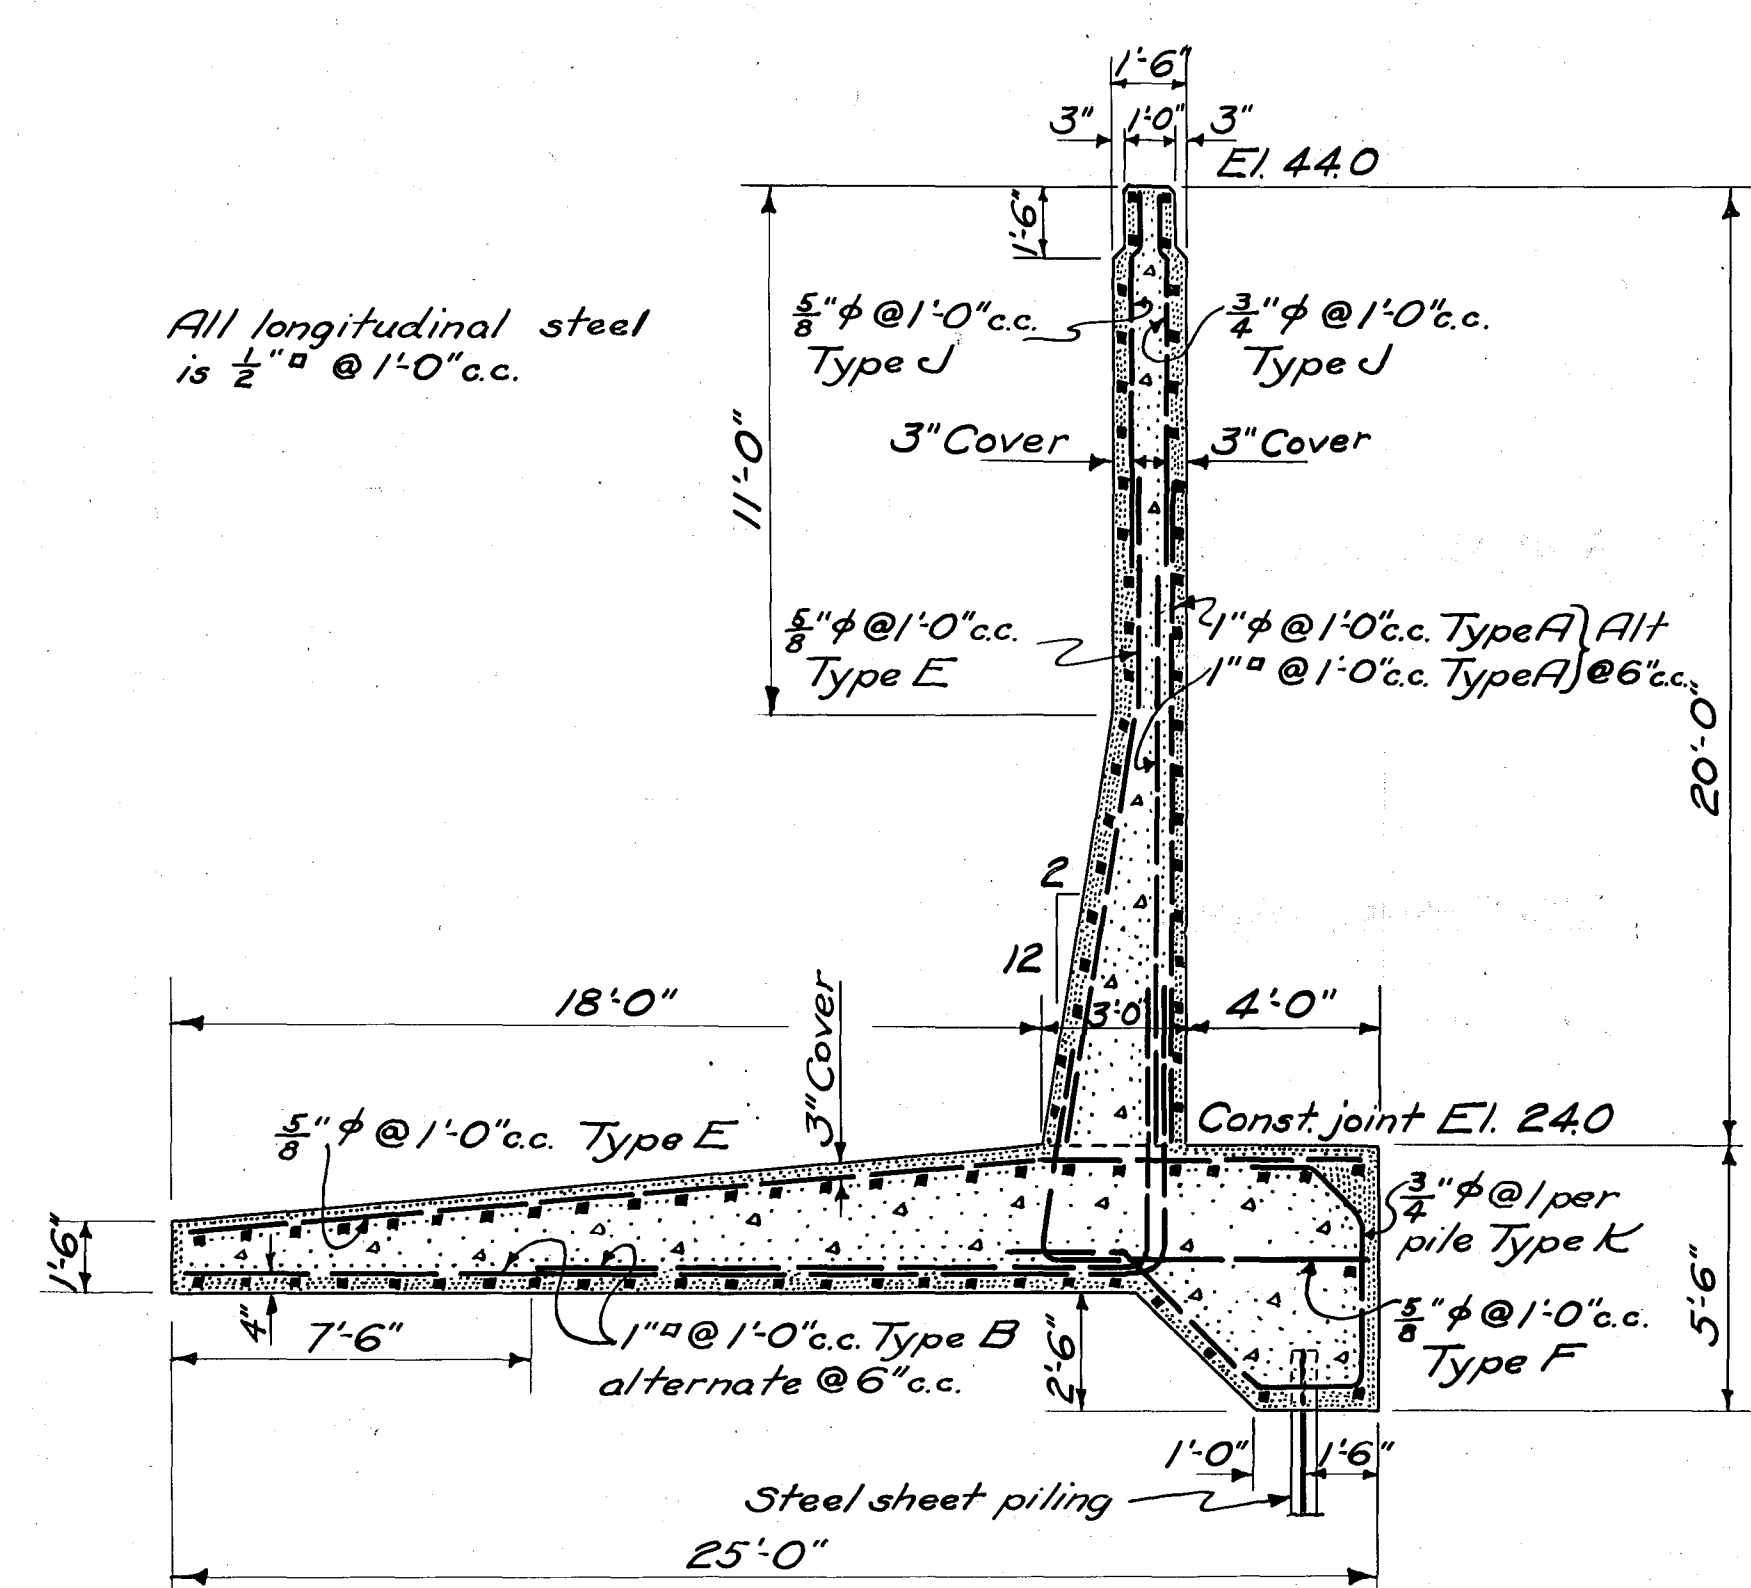


20'-0" WALL - SECTION B 118
STA. 87+98.86 TO STA. 88+38.86

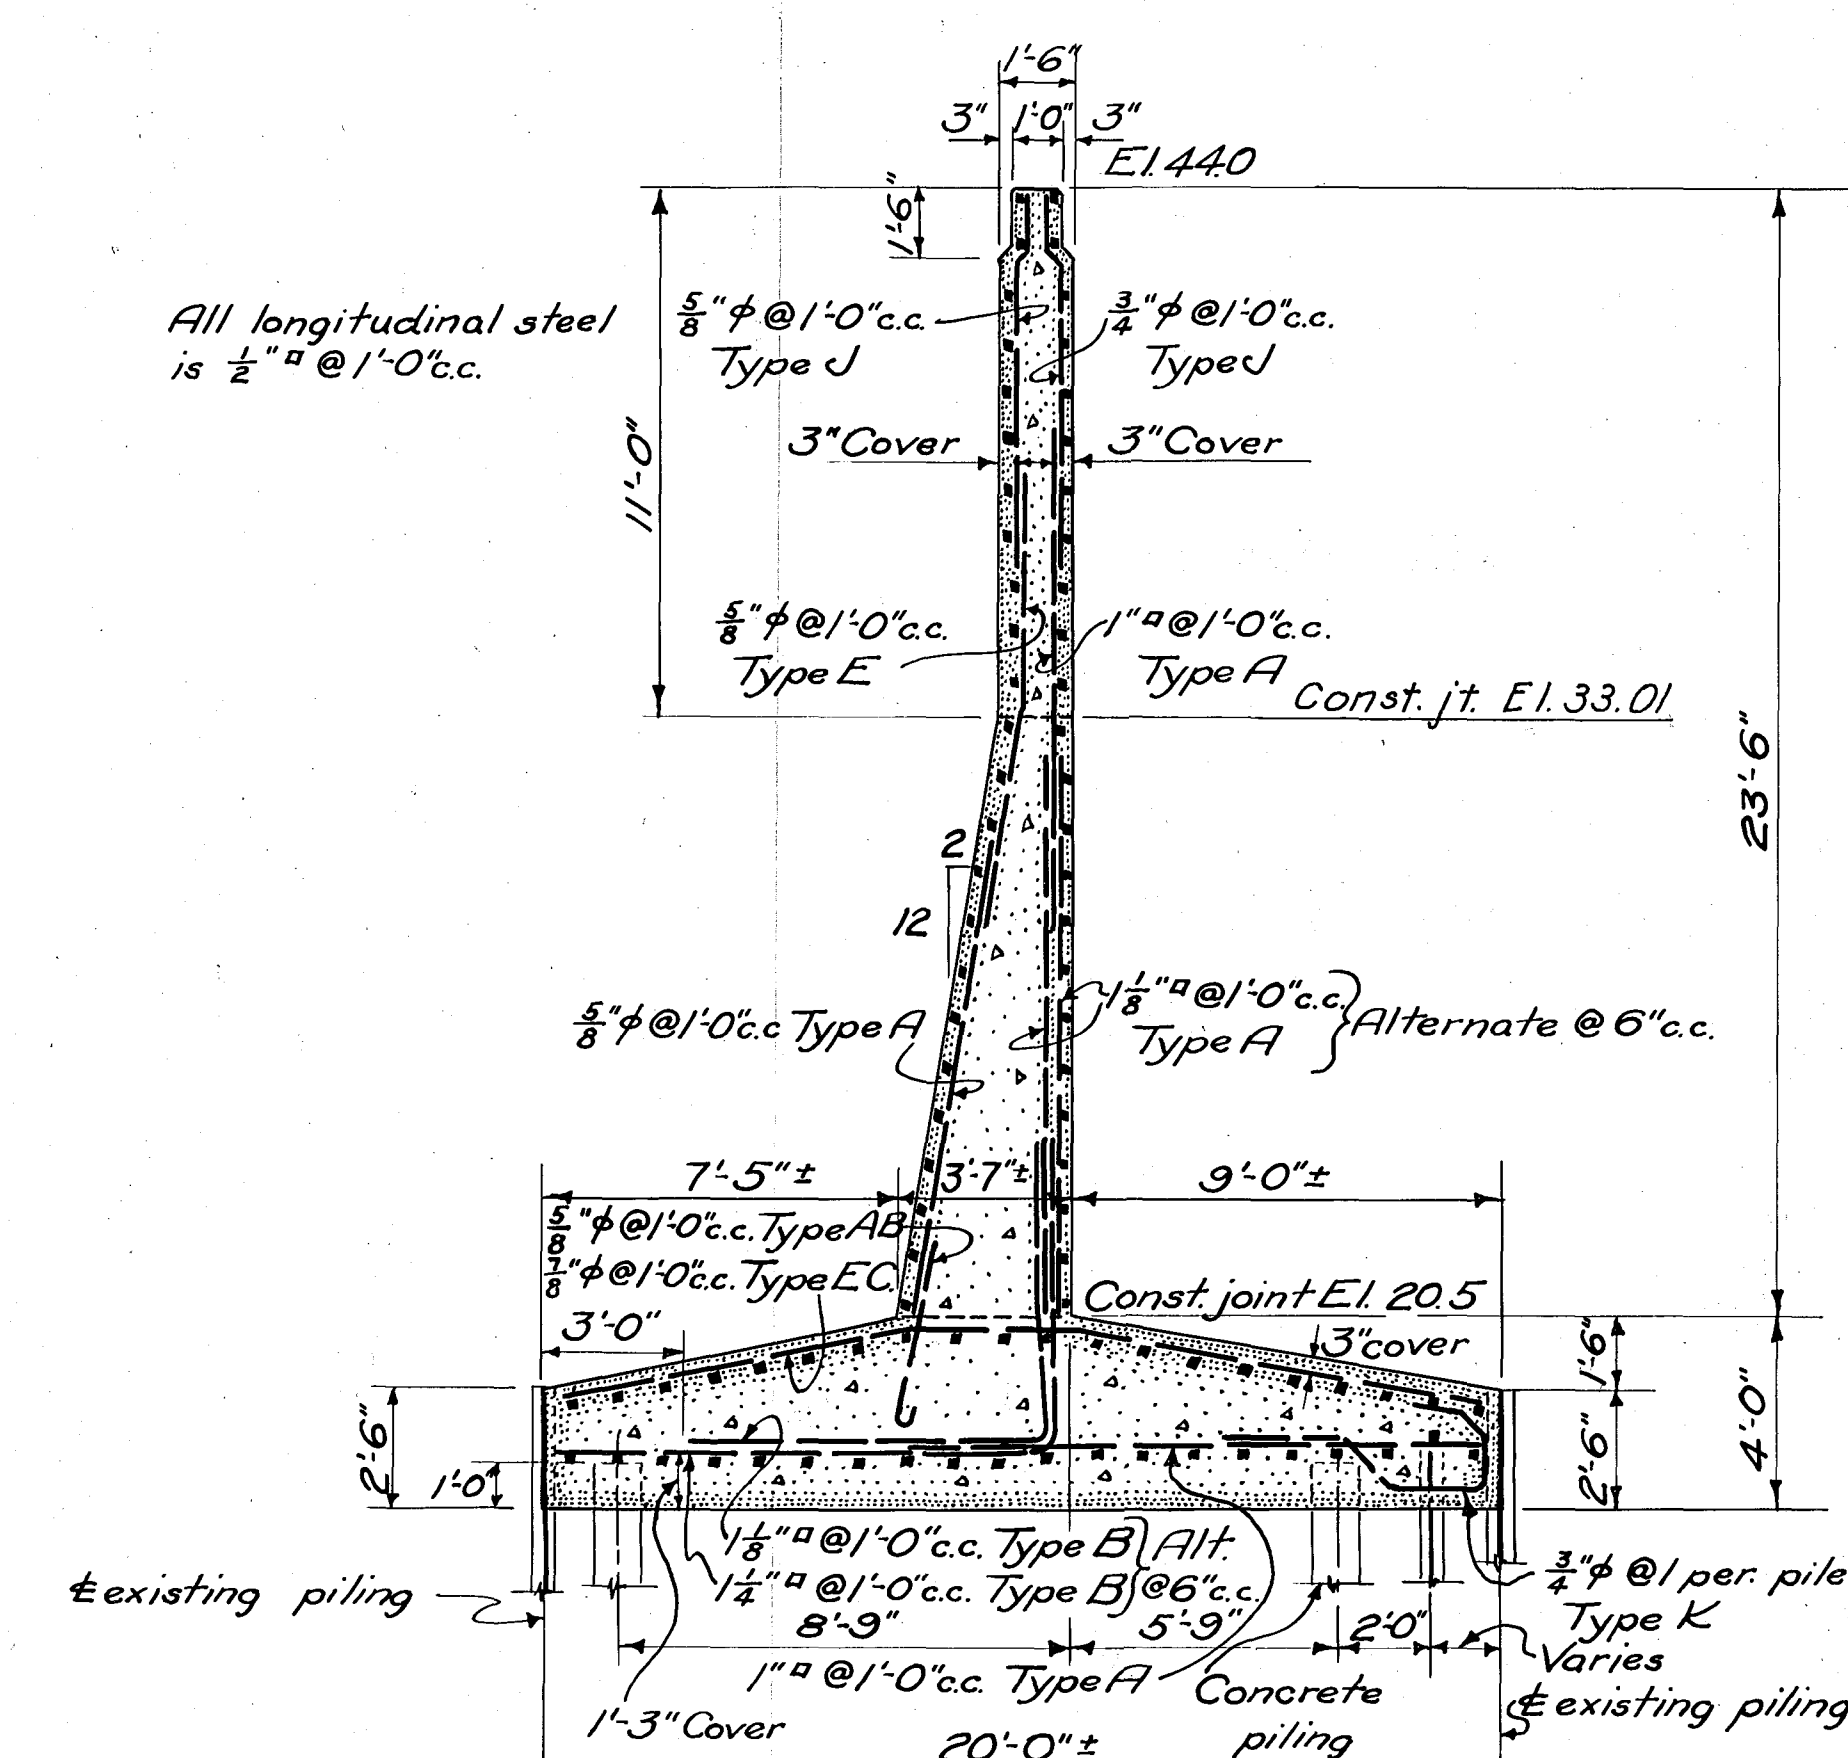

23'-6" WALL - SECTION C 126
STA. 88+38.86 TO STA. 88+85.34

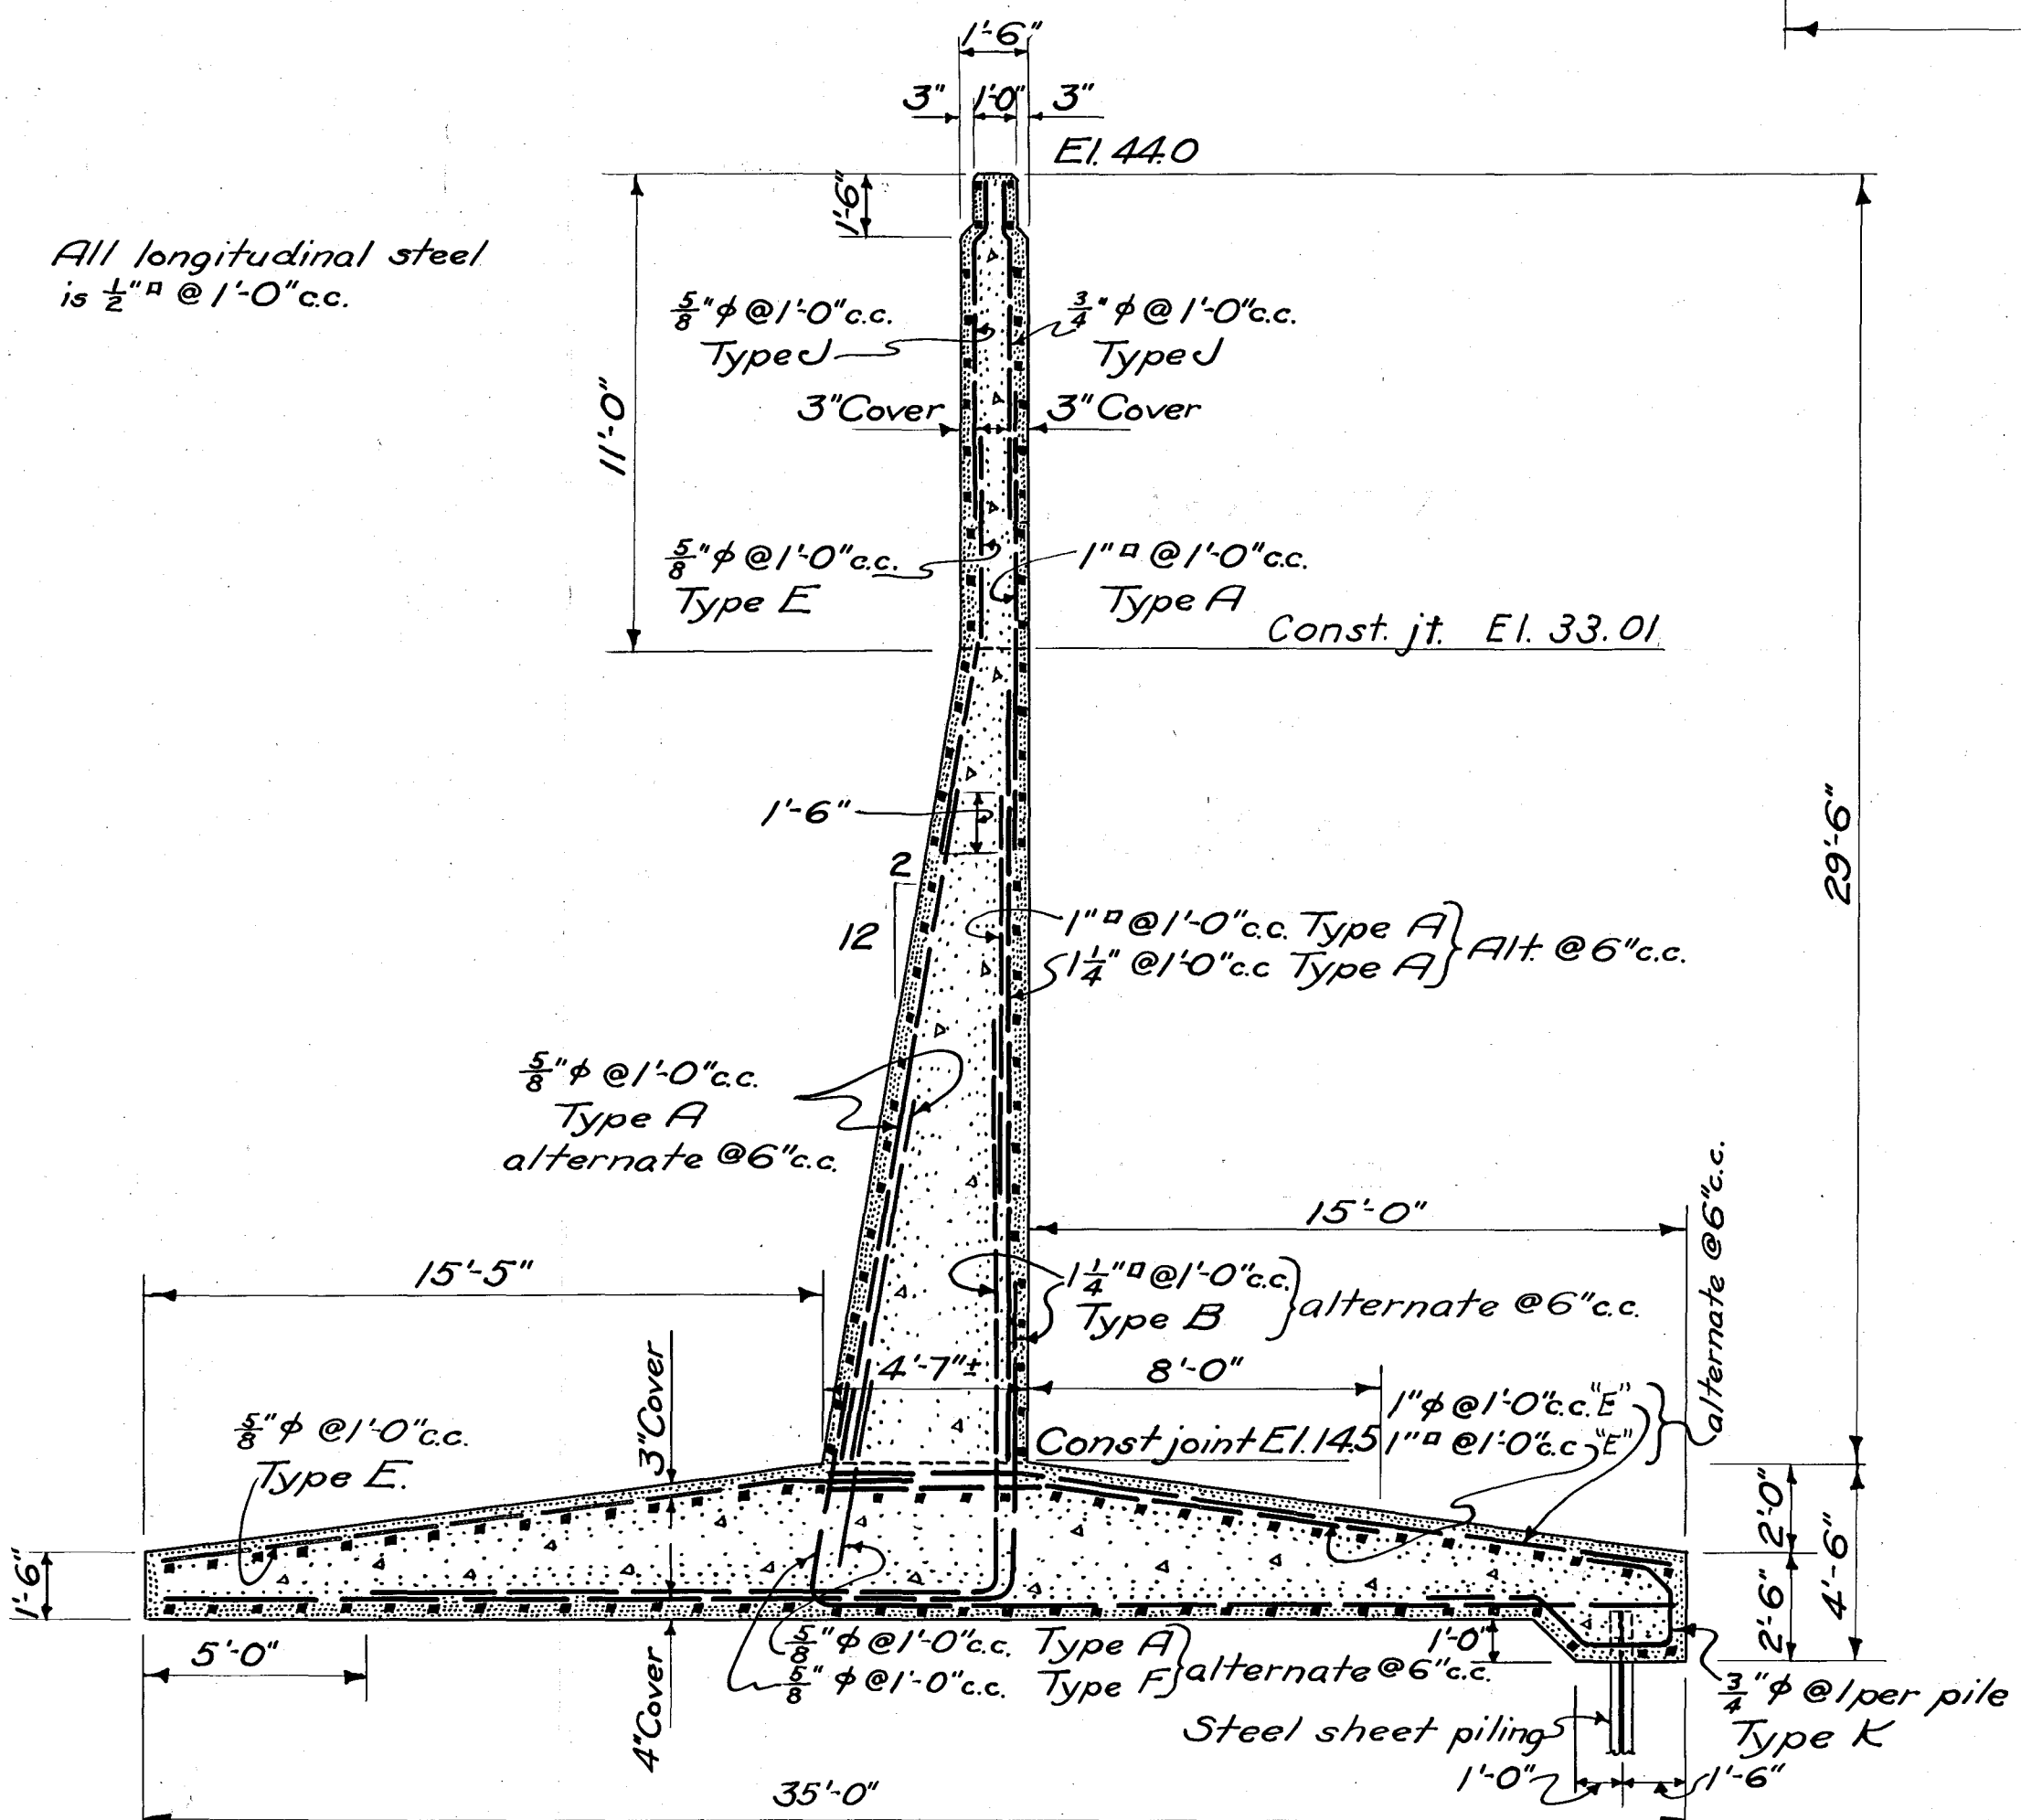

29'-6" WALL - SECTION D 126
STA. 88+85.34 TO STA. 89+17.67

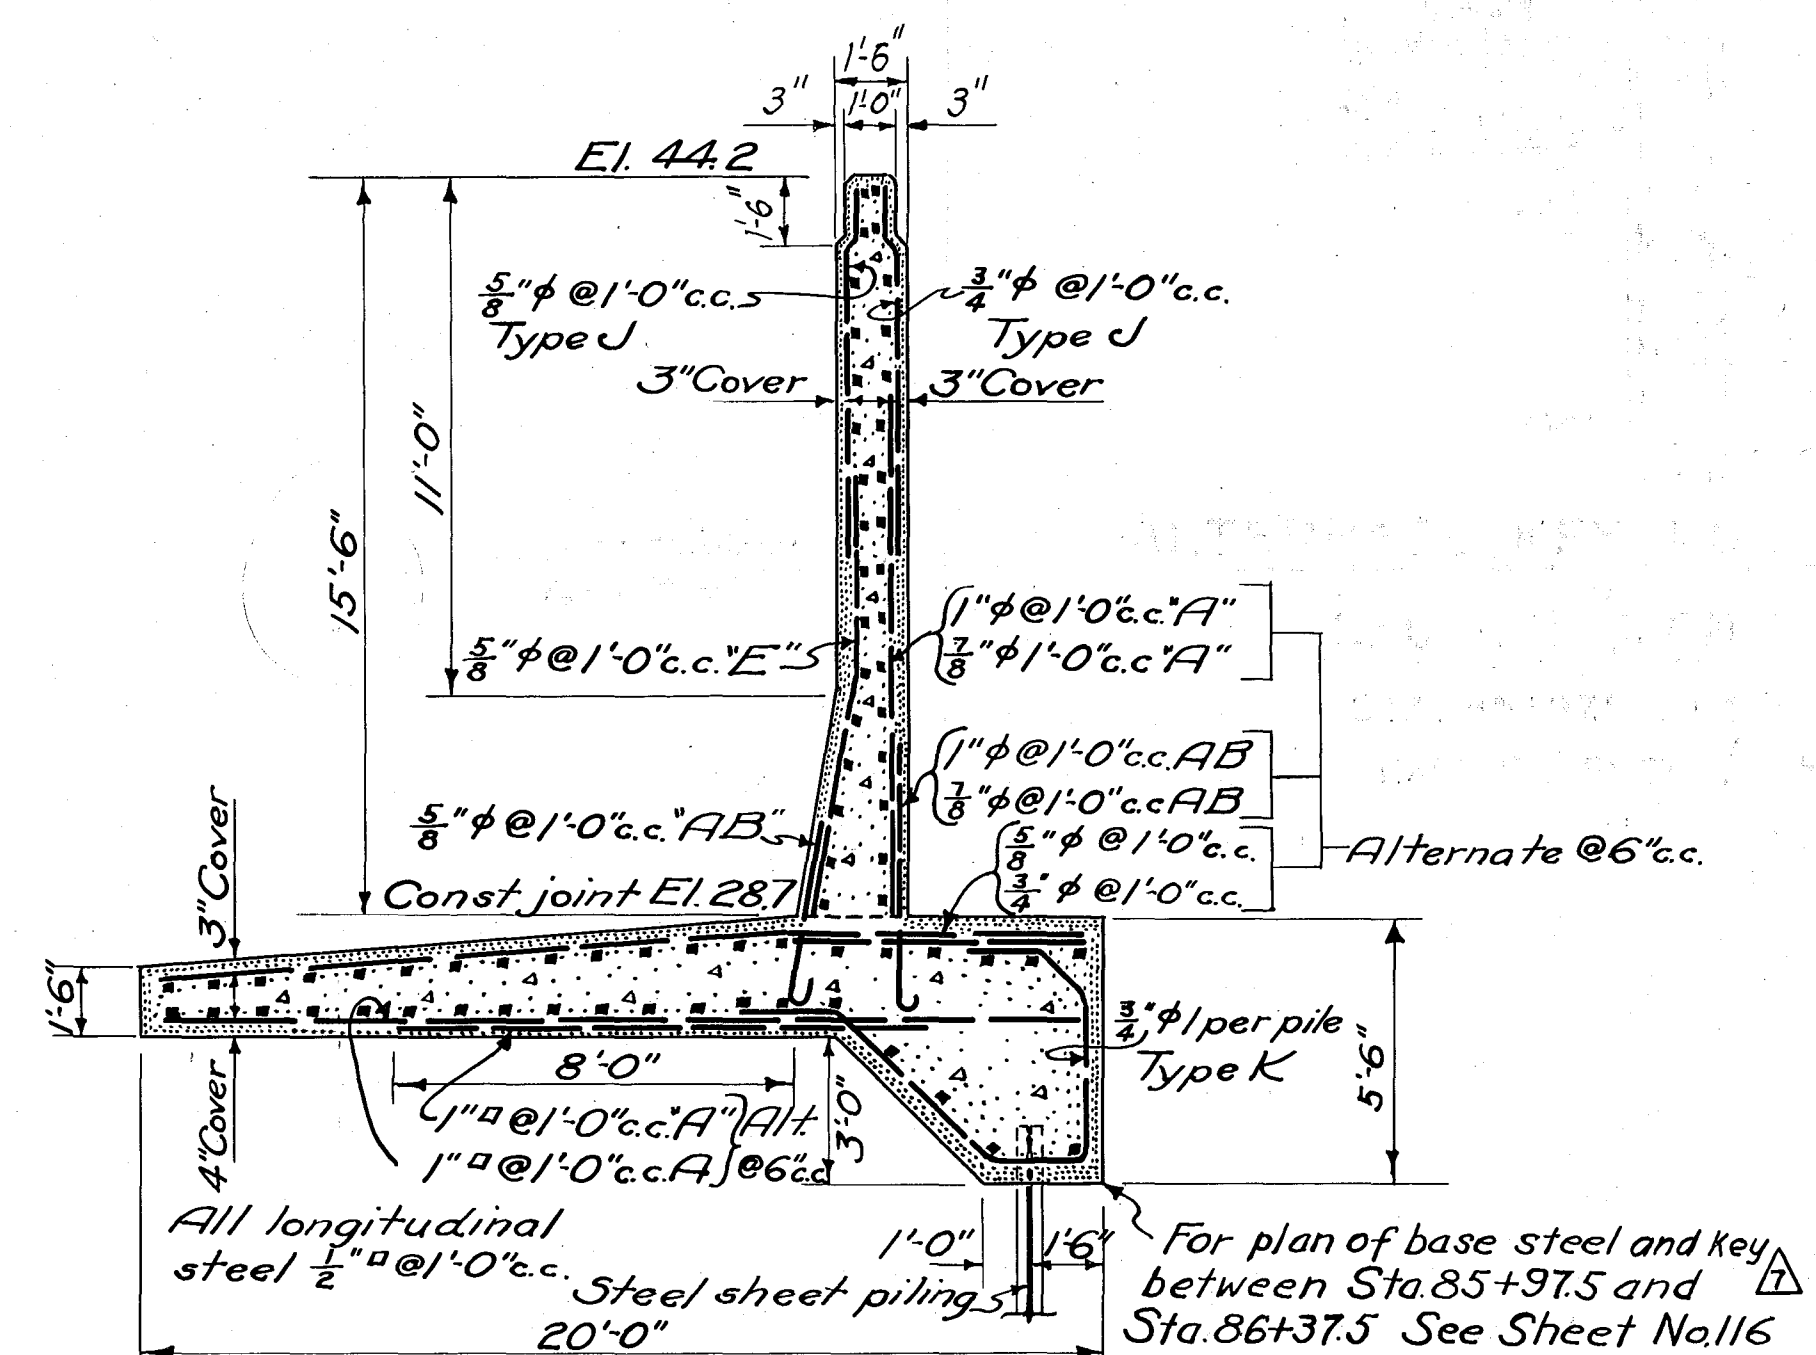

15'-6" WALL - SECTION E 117 & E 116
STA. 85+97.5 TO STA. 86+98.5

NOTES
For concrete details see Sheet No. 74 and 75
For general notes see Sheet No. 112.

CONNECTICUT RIVER FLOOD CONTROL			
HARTFORD DIKE			
RIVERFRONT, MORGAN ST. TO STA. 96+73			
WALL DETAILS-STA. 85+97.5 TO STA. 89+17.67			
STEEL REINFORCEMENT			
CONNECTICUT RIVER	SCALE: 1/4 IN. = 1 FT.	CONNECTICUT	SHEET NO. 115
IN 135 SHEETS			
U.S. ENGINEER OFFICE, PROVIDENCE, R.I., MAY 1940			
SUBMITTED:	APPROVAL RECOMMENDED:	APPROVED:	
Benjamin B. B. B.	Benjamin B. B. B.	Benjamin B. B. B.	
SENIOR ENGINEER	PRINCIPAL ENGINEER	DISTRICT ENGINEER	
HEAD, DESIGN SECTION	CHIEF, F.C. ENGINEERING DIV.	CHIEF, DISTRICT ENGINEERS	
DESIGNED:	DRAWN: E. H. V.	FISCAL YEAR, 1940	
ASSOC. ENGINEER	TRACED: R. L. H.	FILE NO. CT-4-2575	
CHECKED: J. S. H.			

KEY	DATE	REVISION (Indicated by Δ)	REV. BY	CK. BY	AP. BY
	12-31-45	As built revisions			
Δ	3/10/41	Remove curtain walls	JCD	KW	JHB