
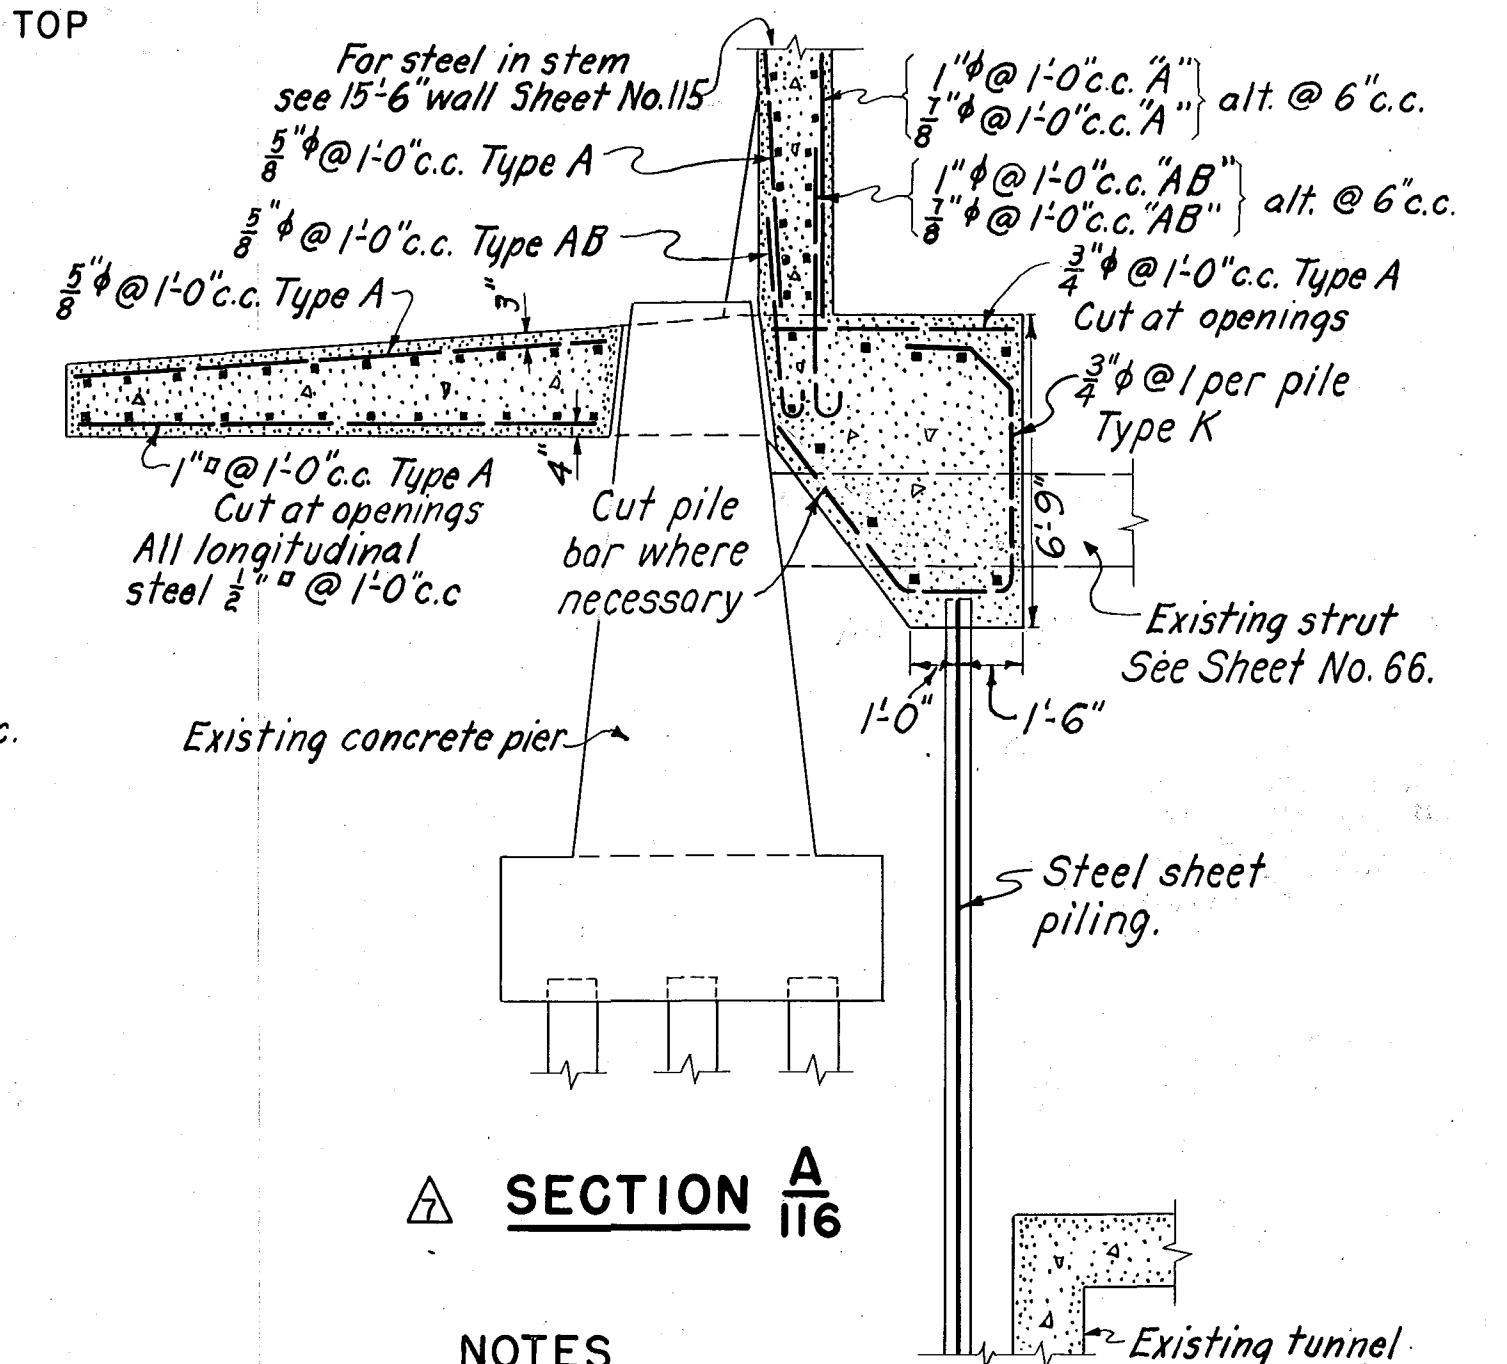
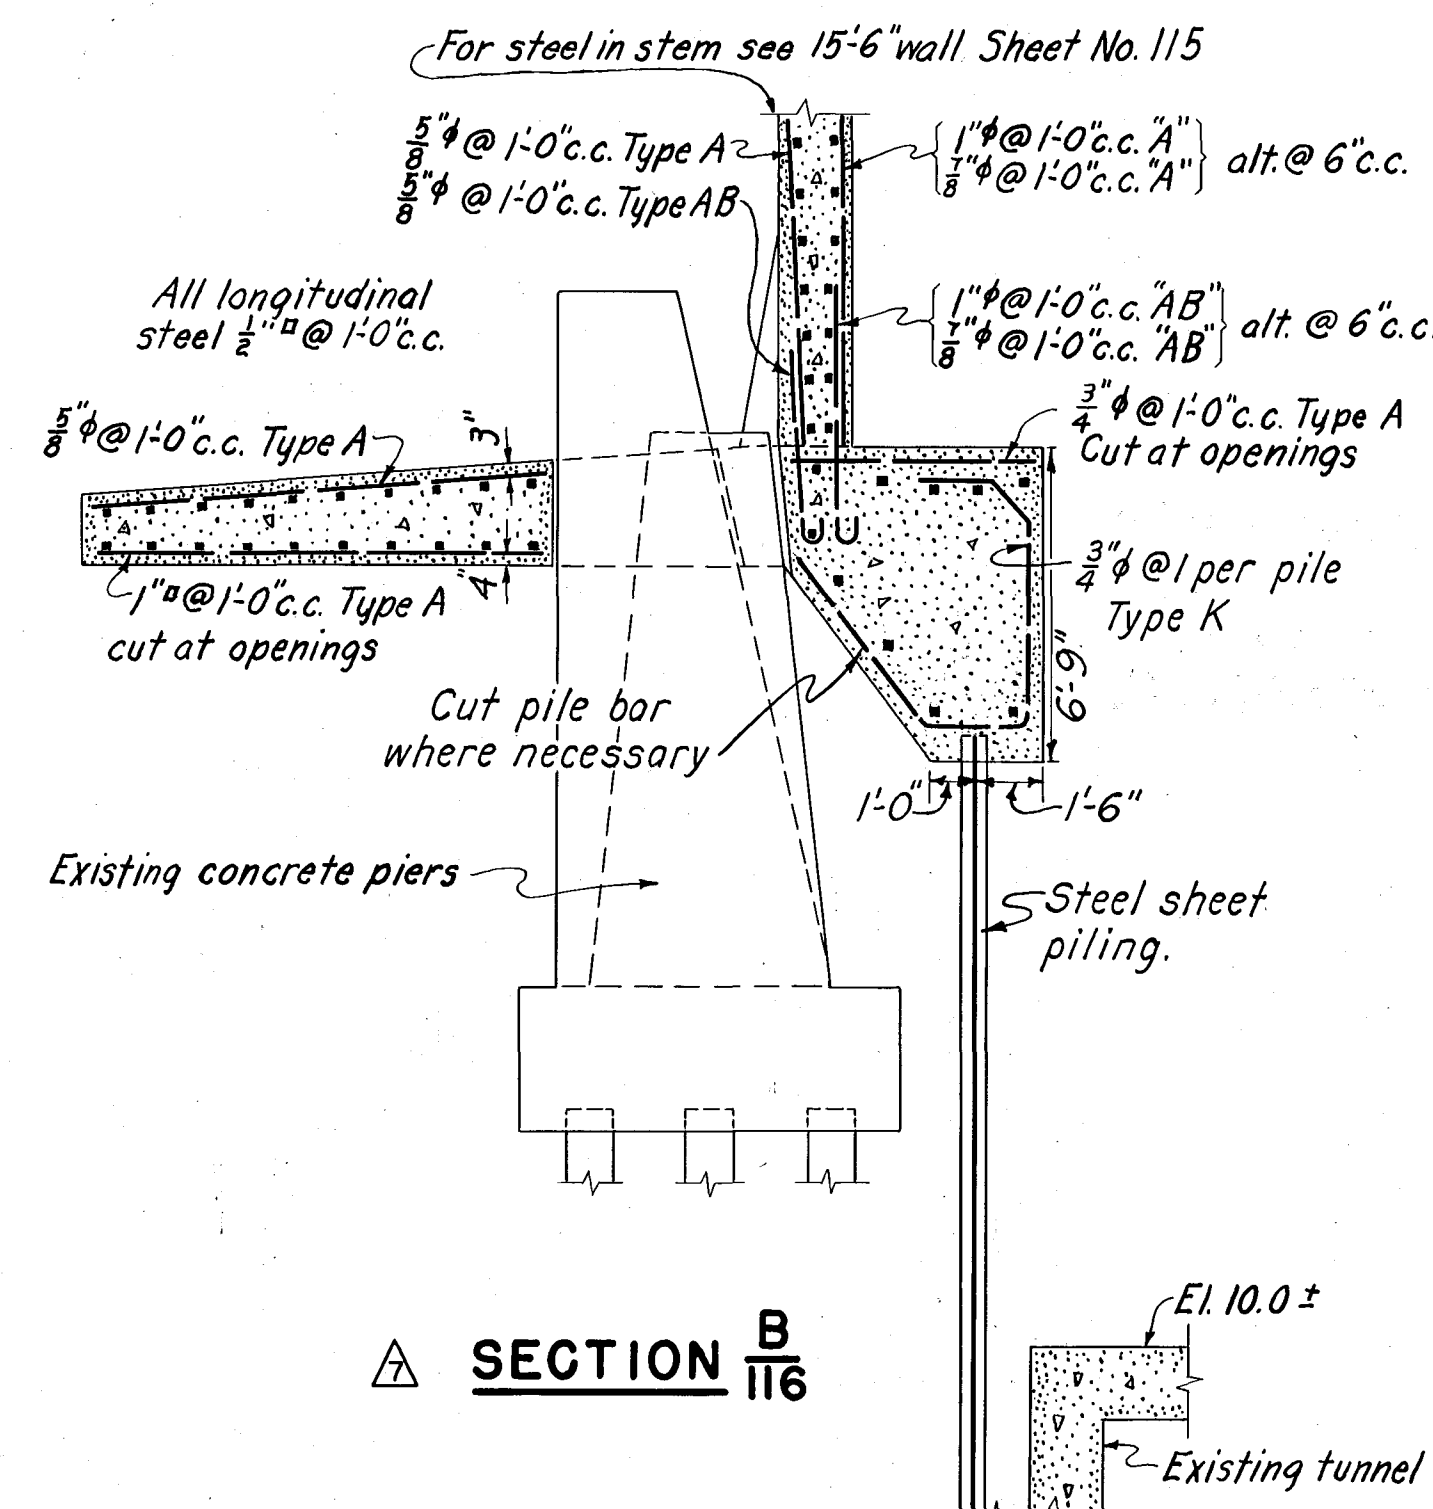


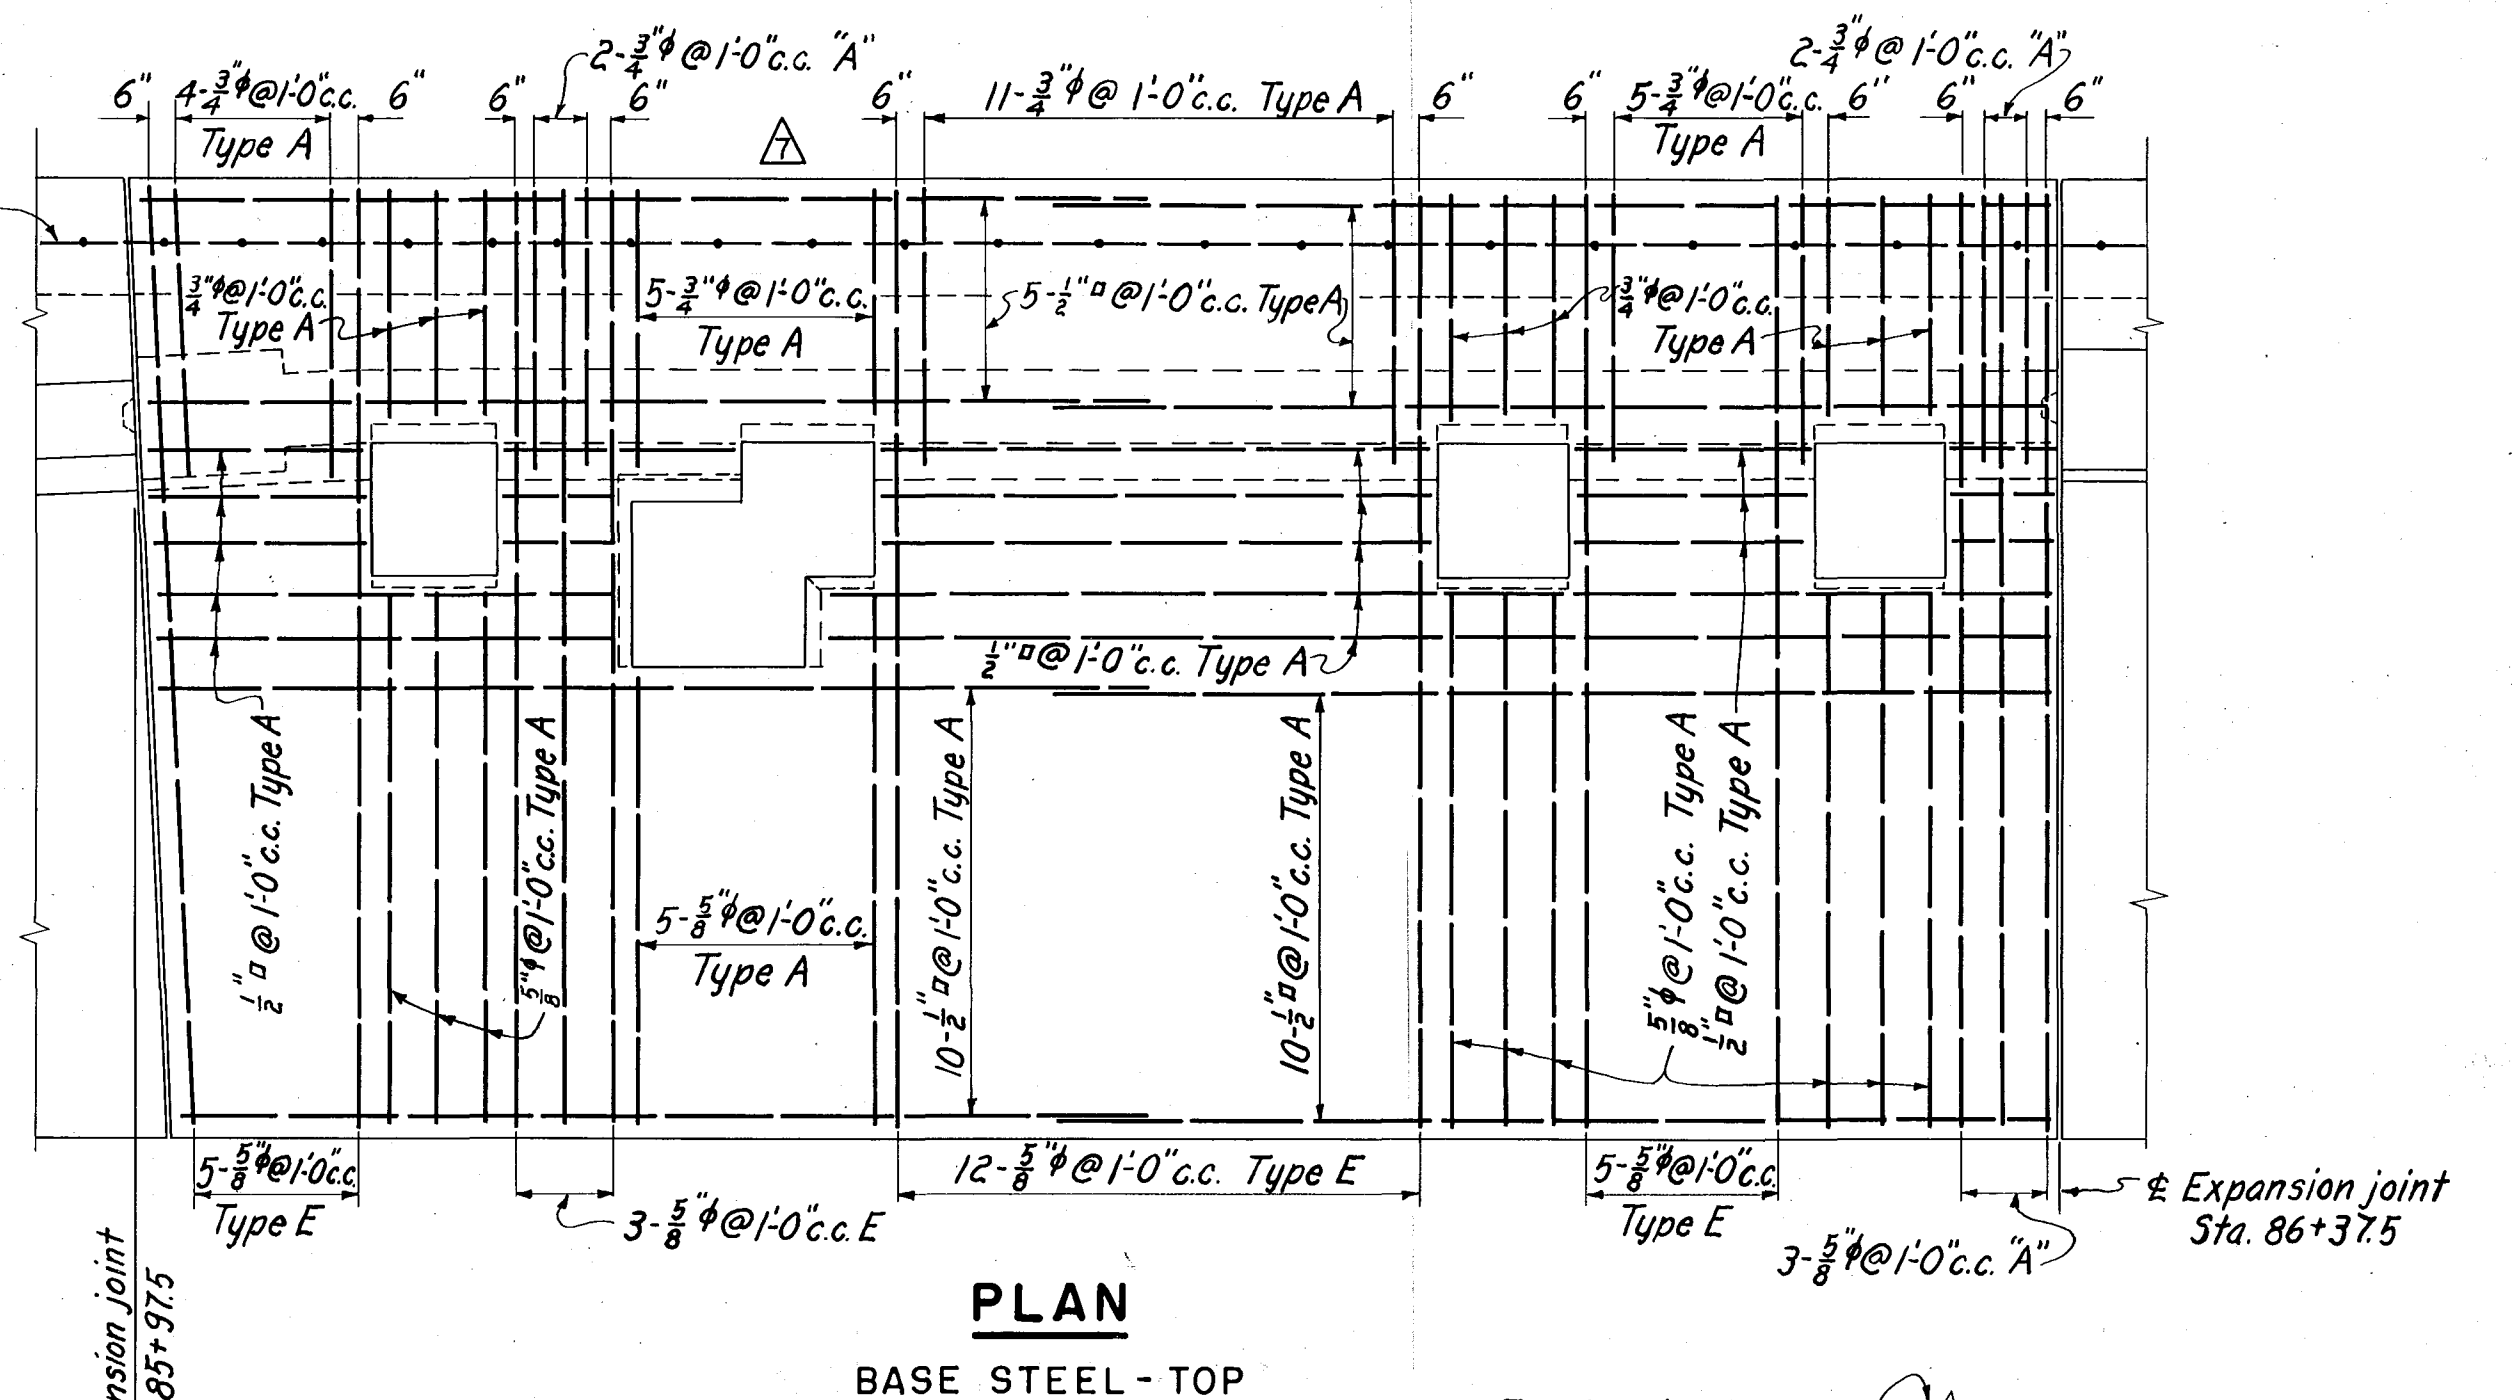

NOTES

For concrete details see Sheet No. 66.
For general notes see Sheet No. 112.

	12-31-45	As Built			
Δ	3-10-41	Curtain wall removed	gpd	184	280
KEY	DATE	REVISION (Indicated by Δ)	REV. BY	CK. BY	AP. BY

CONNECTICUT RIVER			FLOOD CONTROL		
HARTFORD DIKE					
RIVERFRONT, MORGAN ST. TO STA. 96+73					
WALL DETAILS STA. 85+97.5 TO STA. 86+37.5					
STEEL REINFORCEMENT					
CONNECTICUT RIVER				CONNECTICUT	
IN 135 SHEETS		SCALE: 1/4 IN. = 1 FT.		SHEET NO. 116	
5		0		10	
U. S. ENGINEER OFFICE, PROVIDENCE, R.I., MAY 1940					
SUBMITTED:		APPROVAL REQUIRED:		APPROVED:	
<i>Robert B. Fisher</i>		<i>Ed Burns</i>		<i>W. C. Seagler</i>	
SENIOR ENGINEER		PRINCIPAL ENGINEER		CH. OF ENGRS.	
HEAD, DESIGN SECTION		CHIEF, F.C. ENGINEERING DIV.		DISTRICT ENGINEER	
DESIGNED:		DRAWN:		FISCAL YEAR 1940	
<i>W. C. Seagler</i>		U. S. S.			
ASSOC. ENGINEER		CHECKED: J. S. H.			
		1179		FISCAL NO. CT-4-2576	