
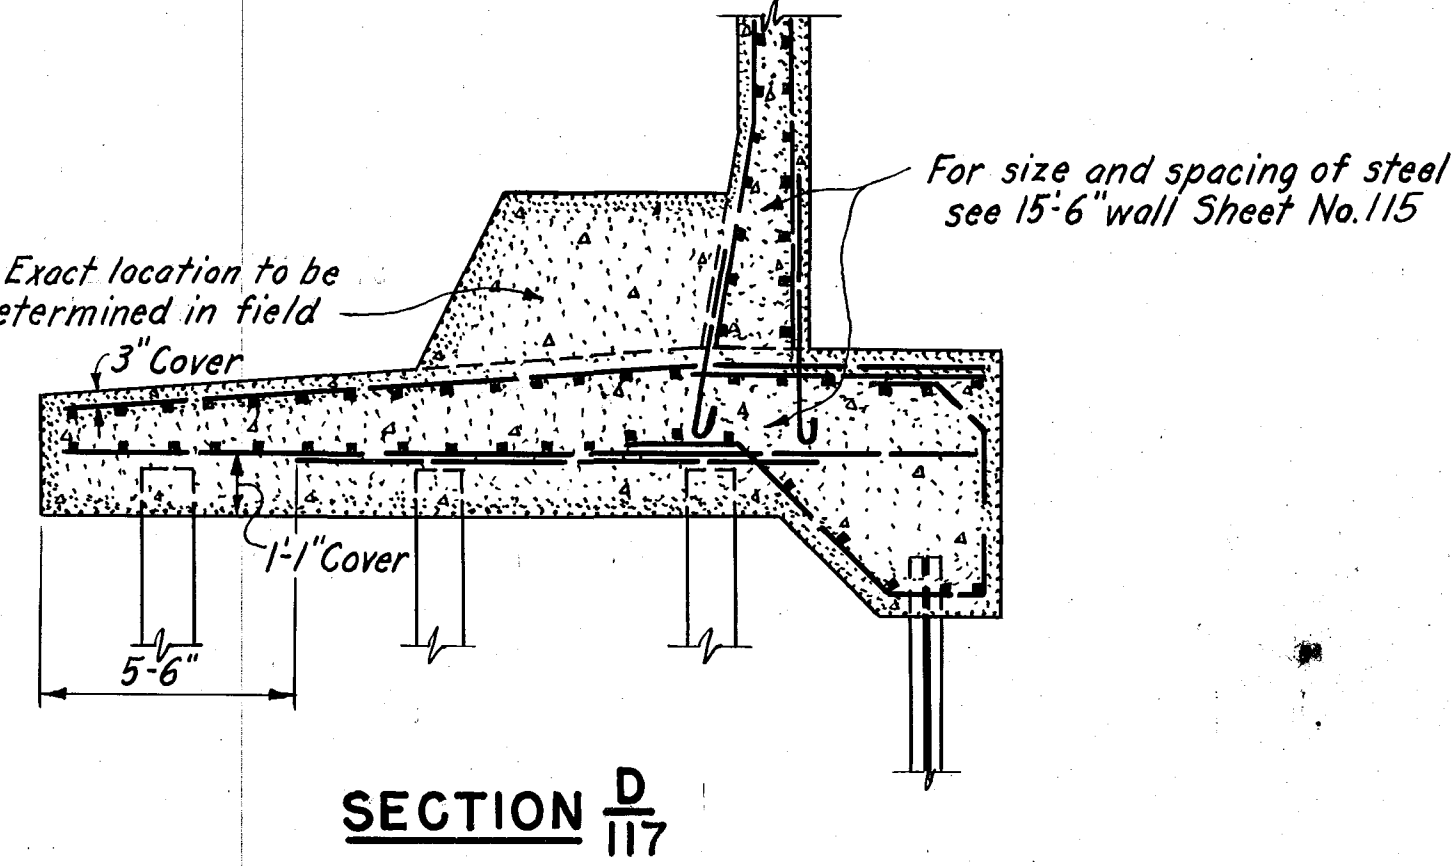
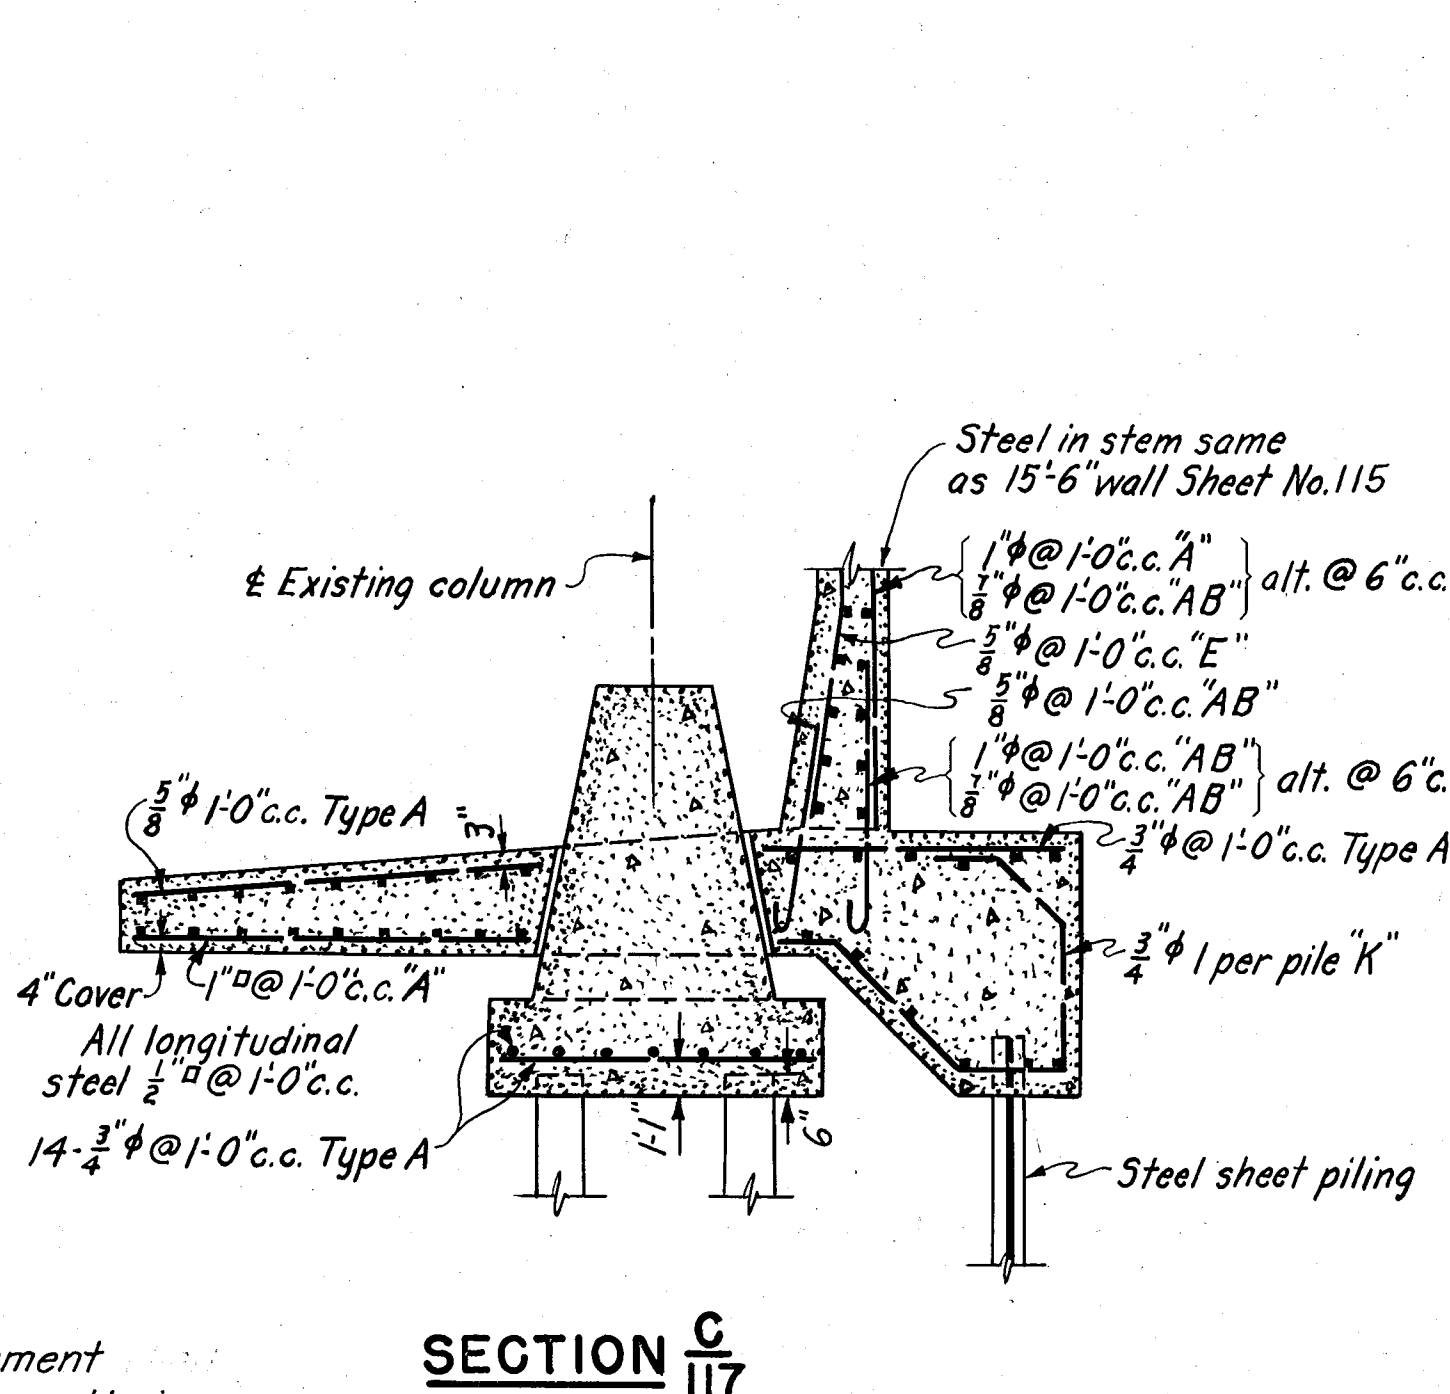
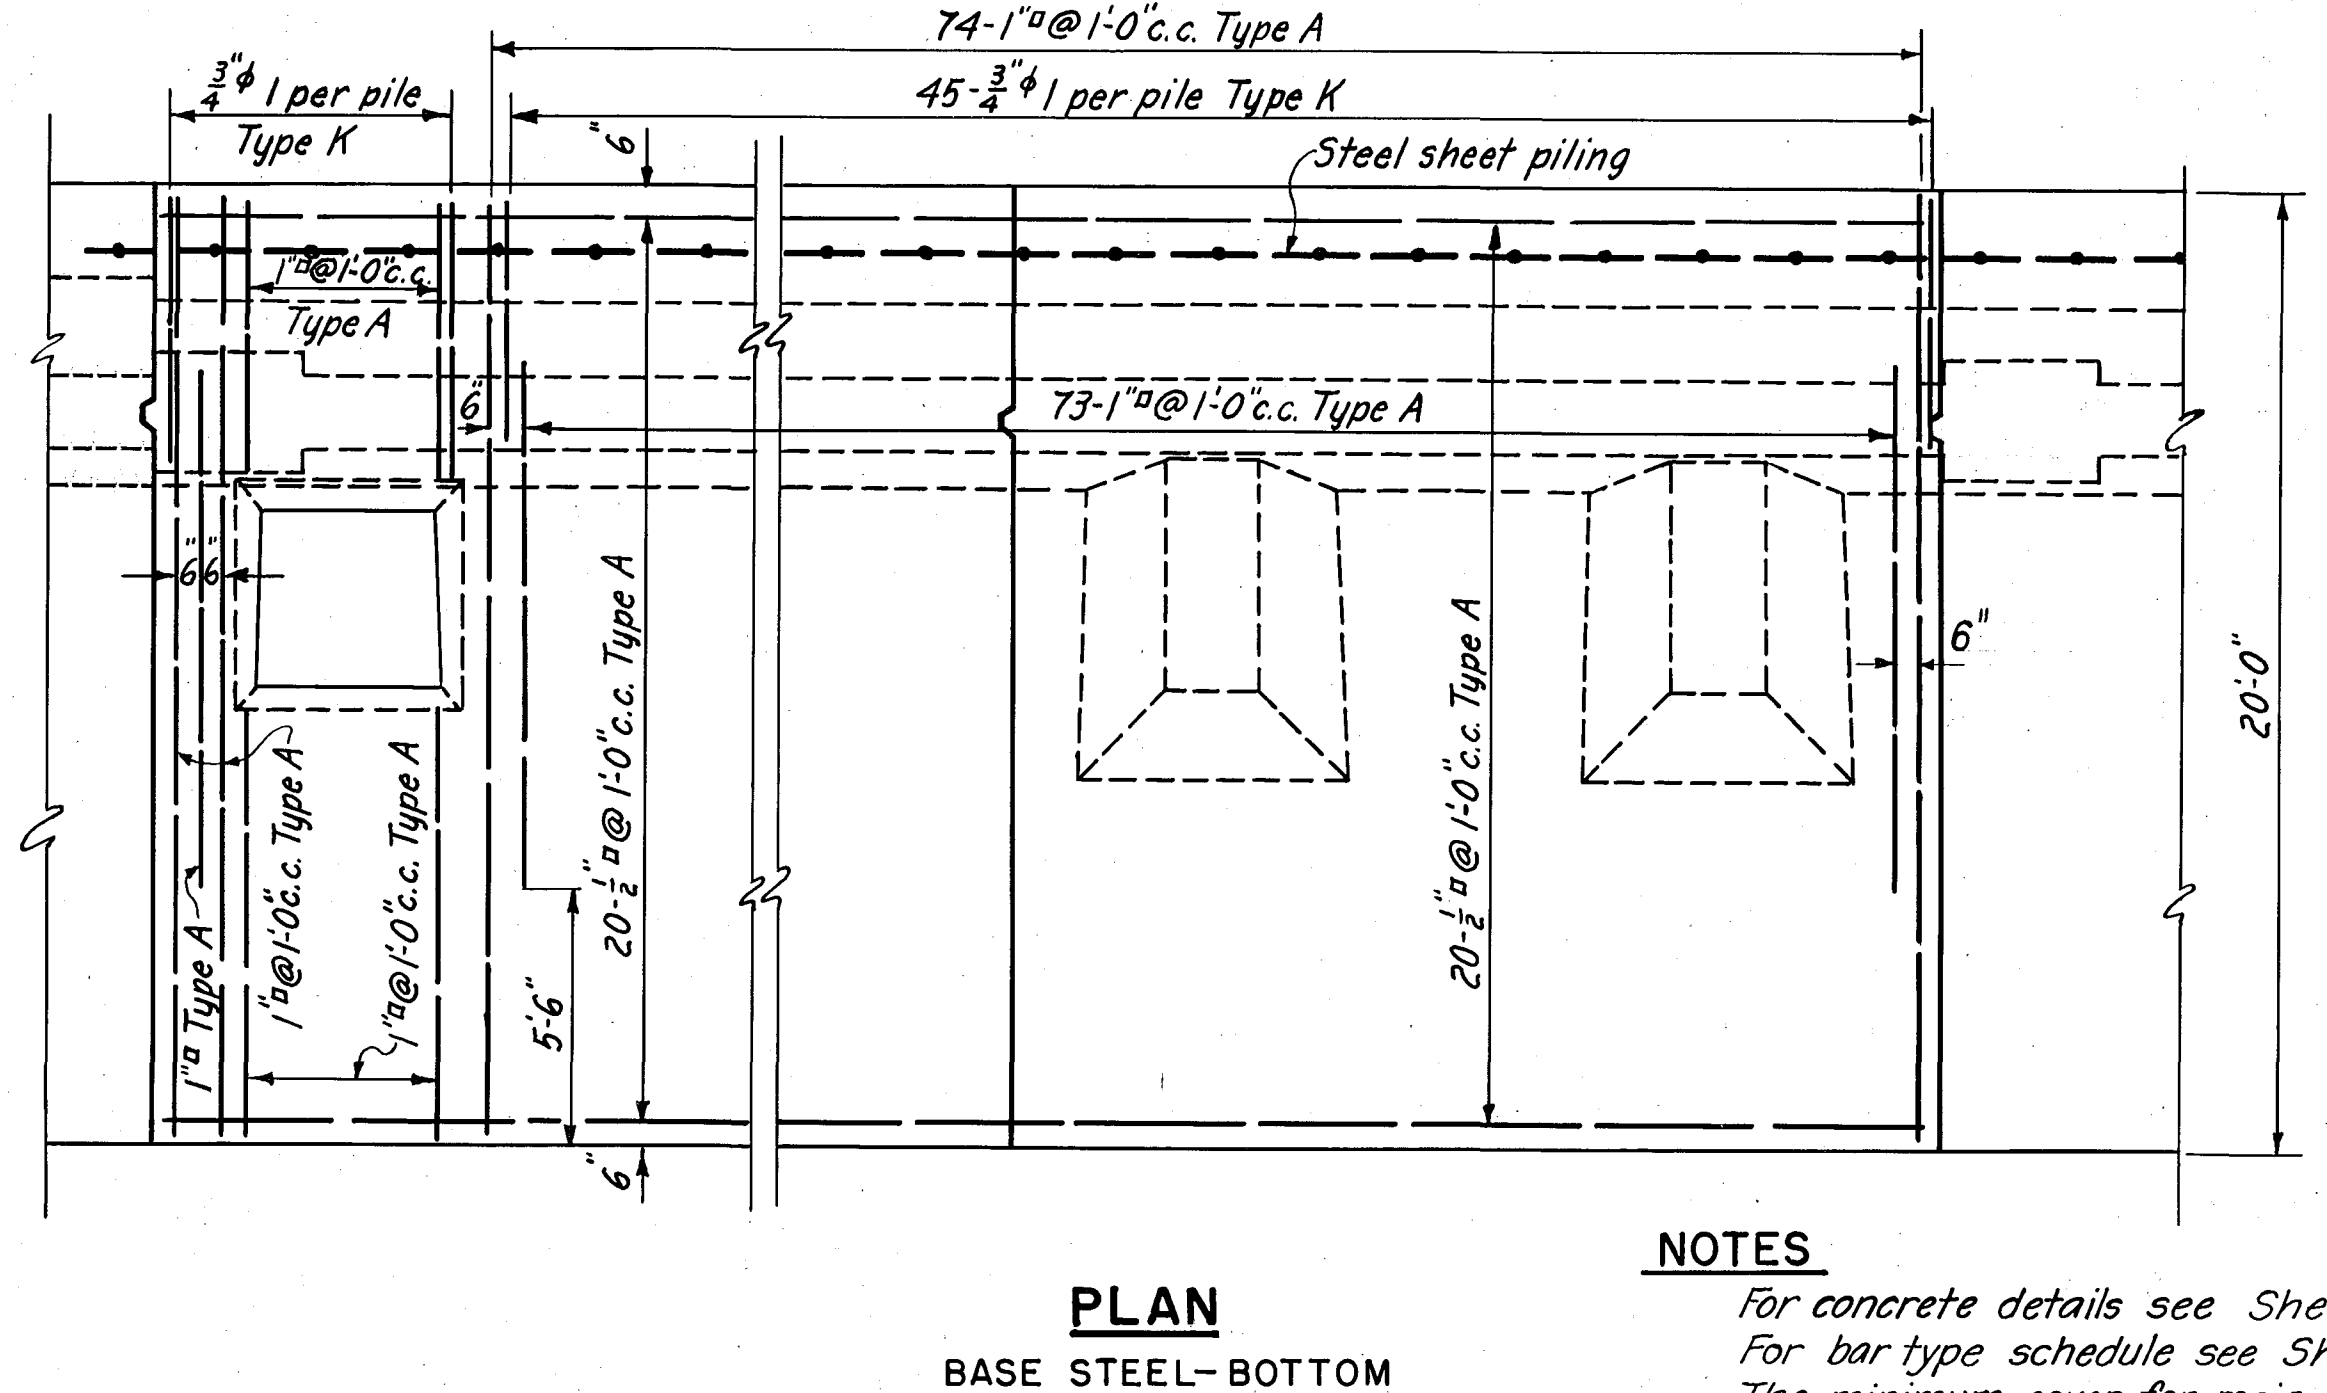
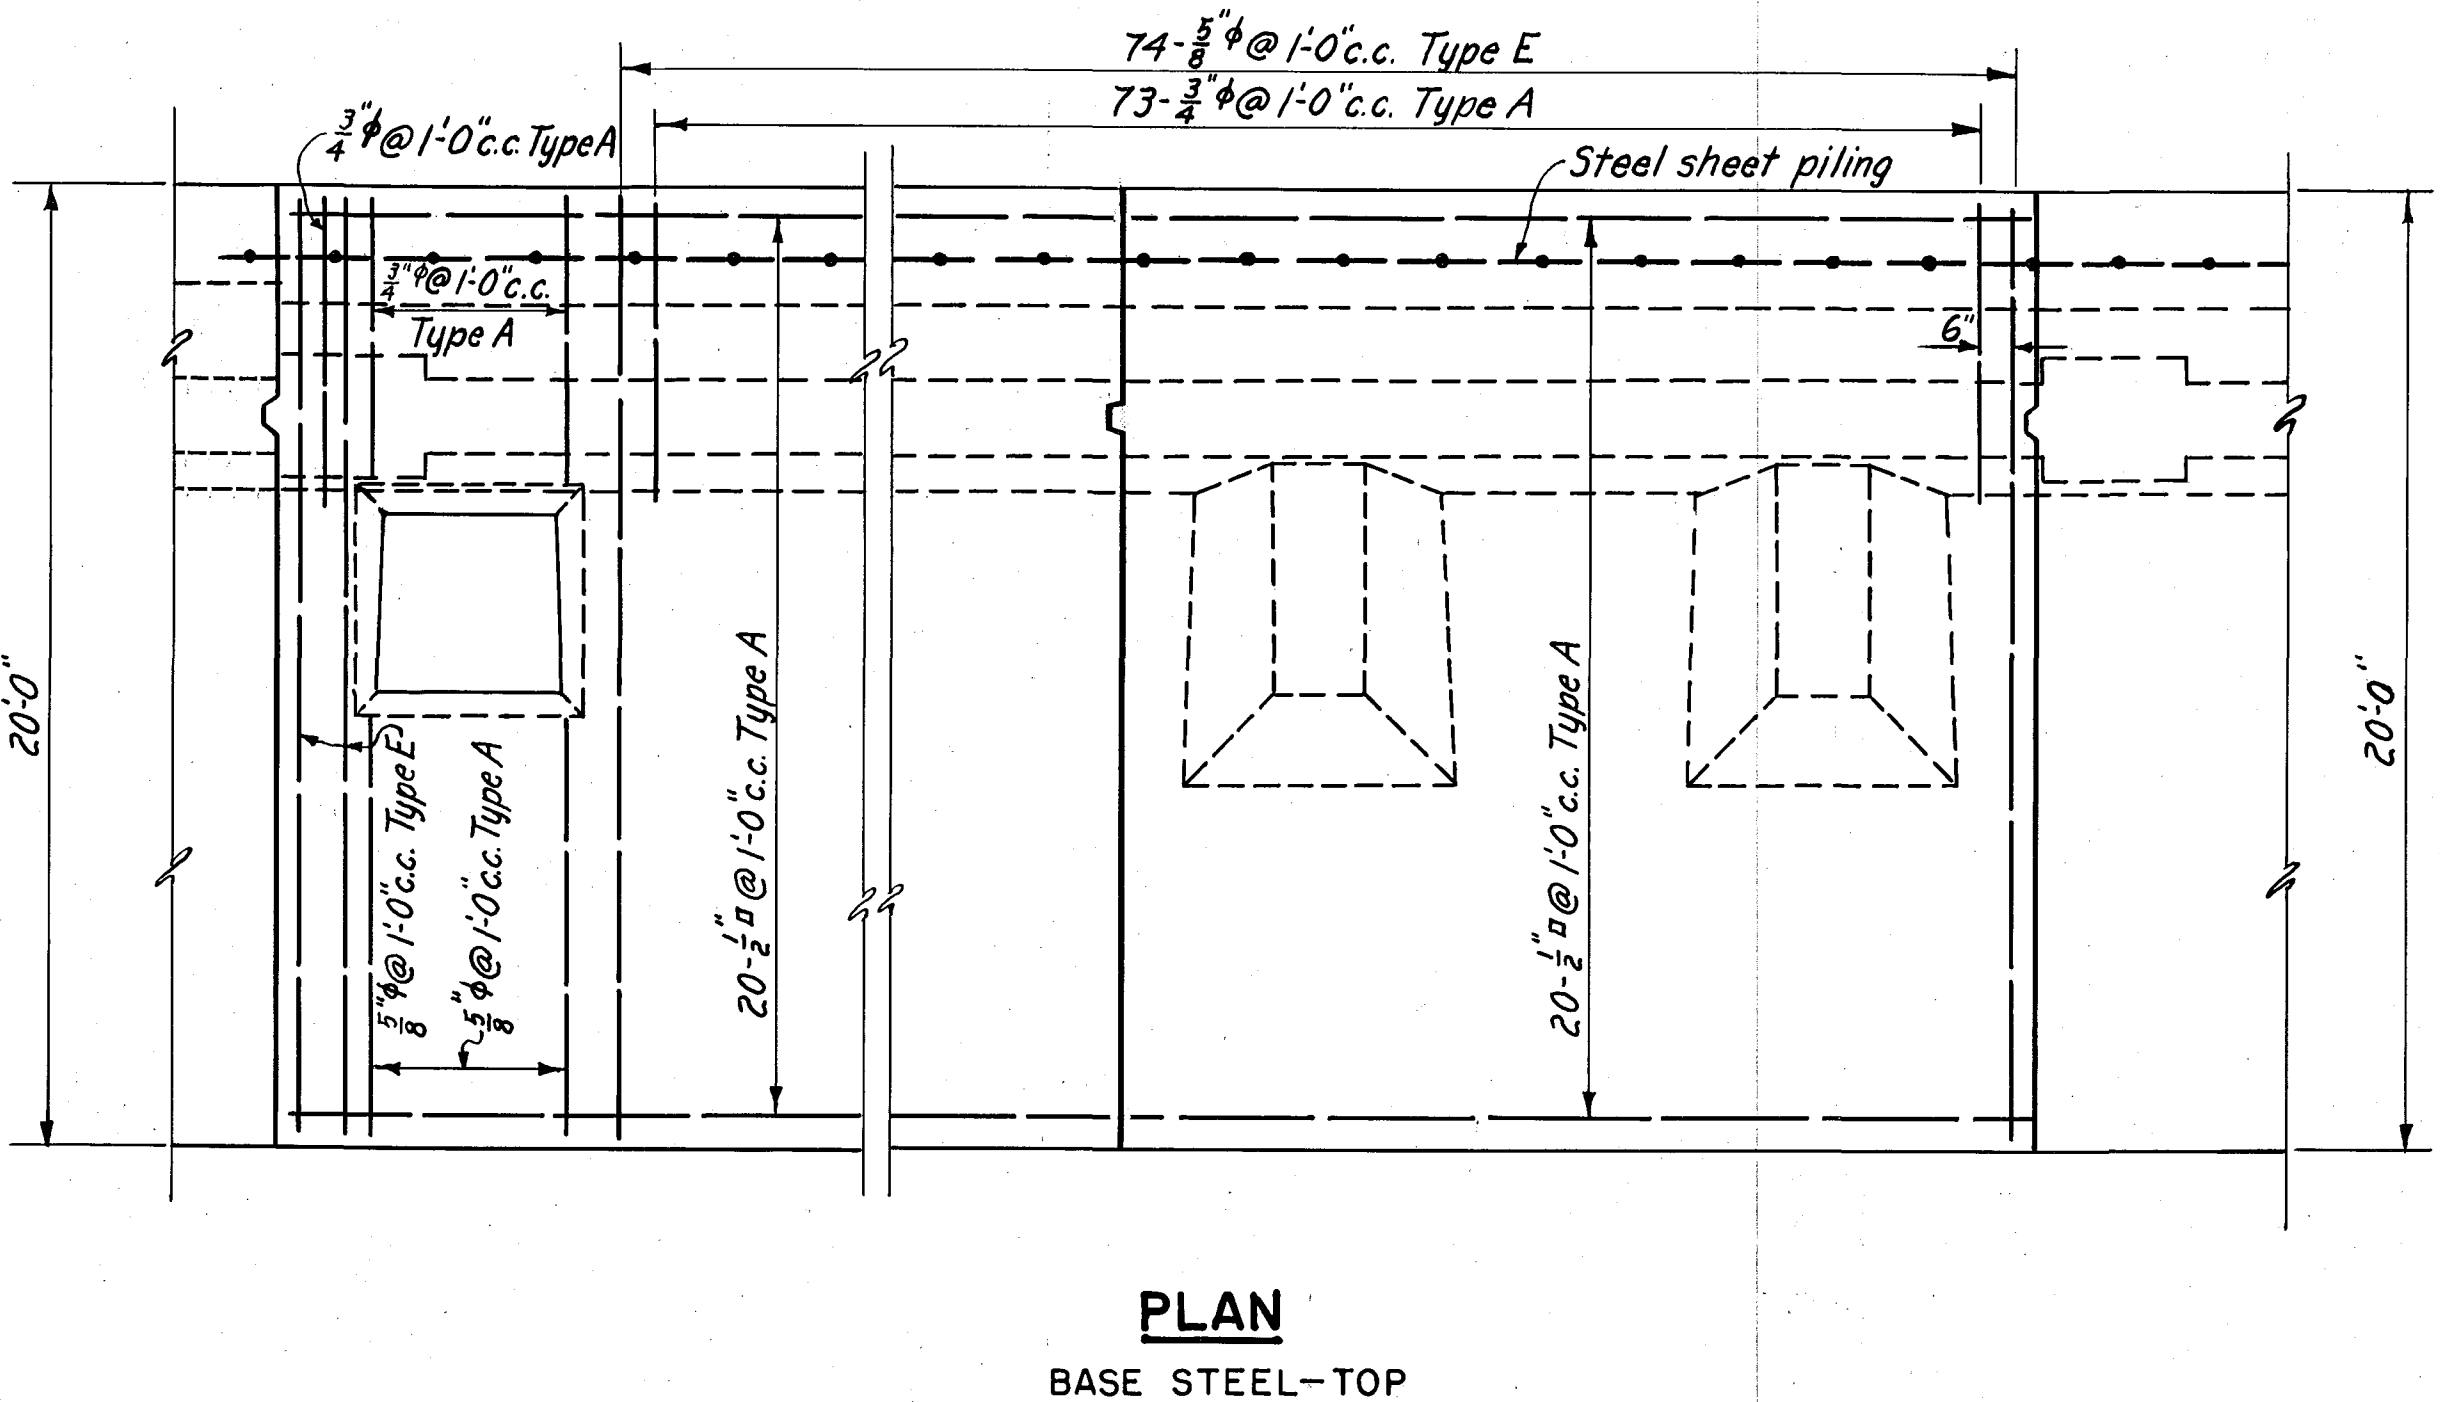


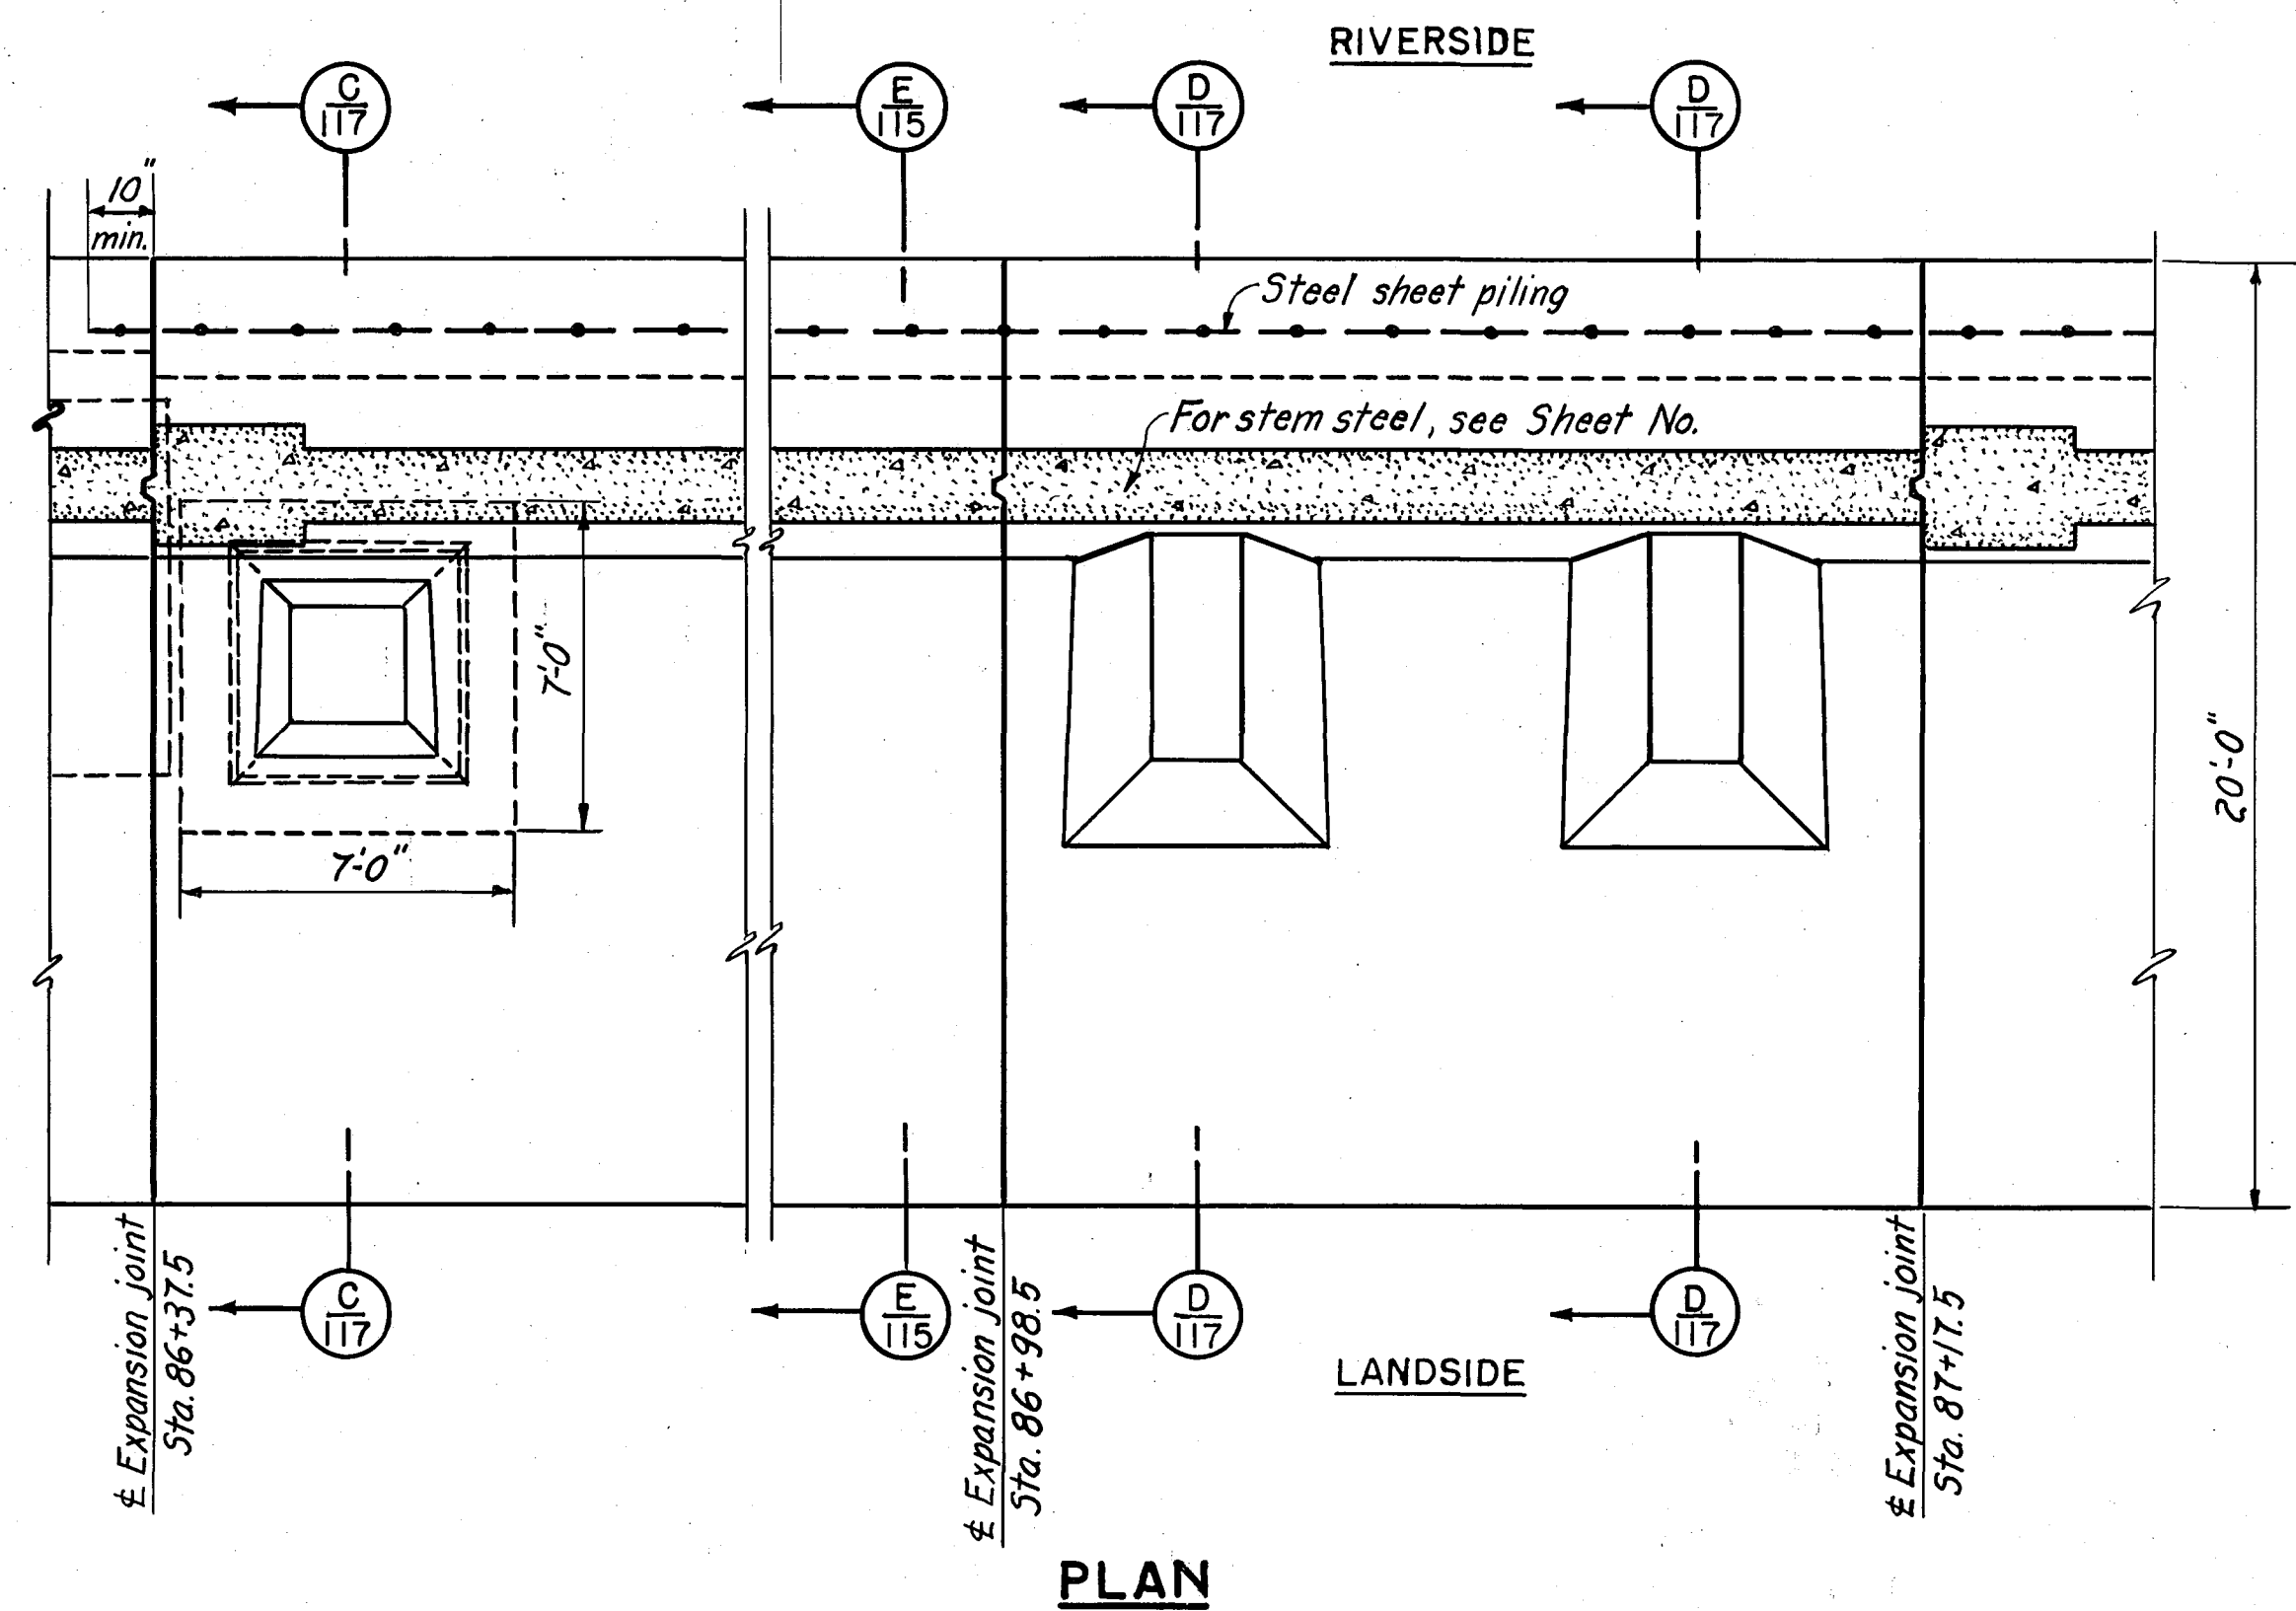

NOTES
For concrete details see Sheet No. 66.
For bar type schedule see Sheet No. 85.
The minimum cover for main steel reinforcement is 3" except where concrete is poured against earth in which case it is 4".
Bar splices are equal in length to 40 diameters of the smaller bar.
Radius of bend of bars is equal to 4 diameters of the bar.
Payment for furnishing, bending, and placing of steel reinforcement was made under Item No. 25.

KEY	DATE	REVISION (Indicated by Δ)	REV. BY	CK. BY	AP. BY
	12-31-45	As built revisions			

CONNECTICUT RIVER FLOOD CONTROL		
HARTFORD DIKE		
RIVERFRONT, MORGAN ST. TO STA. 96+73		
WALL DETAILS-STA. 86+37.5 TO STA. 87+17.5		
STEEL REINFORCEMENT		
CONNECTICUT RIVER	SCALE: 1/4 IN. = 1 FT.	CONNECTICUT
IN 135 SHEETS	5	SHEET NO. 117
U.S. ENGINEER OFFICE, PROVIDENCE, R.I., MAY 1940		
SUBMITTED:	APPROVAL RECOMMENDED:	APPROVED:
Senior Engineer	Principal Engineer	Chief, Corps of Engineers
HEAD, DESIGN SECTION	CHIEF, E.C. ENGINEERING DIV.	DISTRICT ENGINEER
DESIGNED:	DRAWN: U.M.S.	FISCAL YEAR 1940
Assoc. Engineer	TRACED: A.R.A.S. B.M.	FILE NO. CT-4-2577
	CHECKED: 1/1/4	