



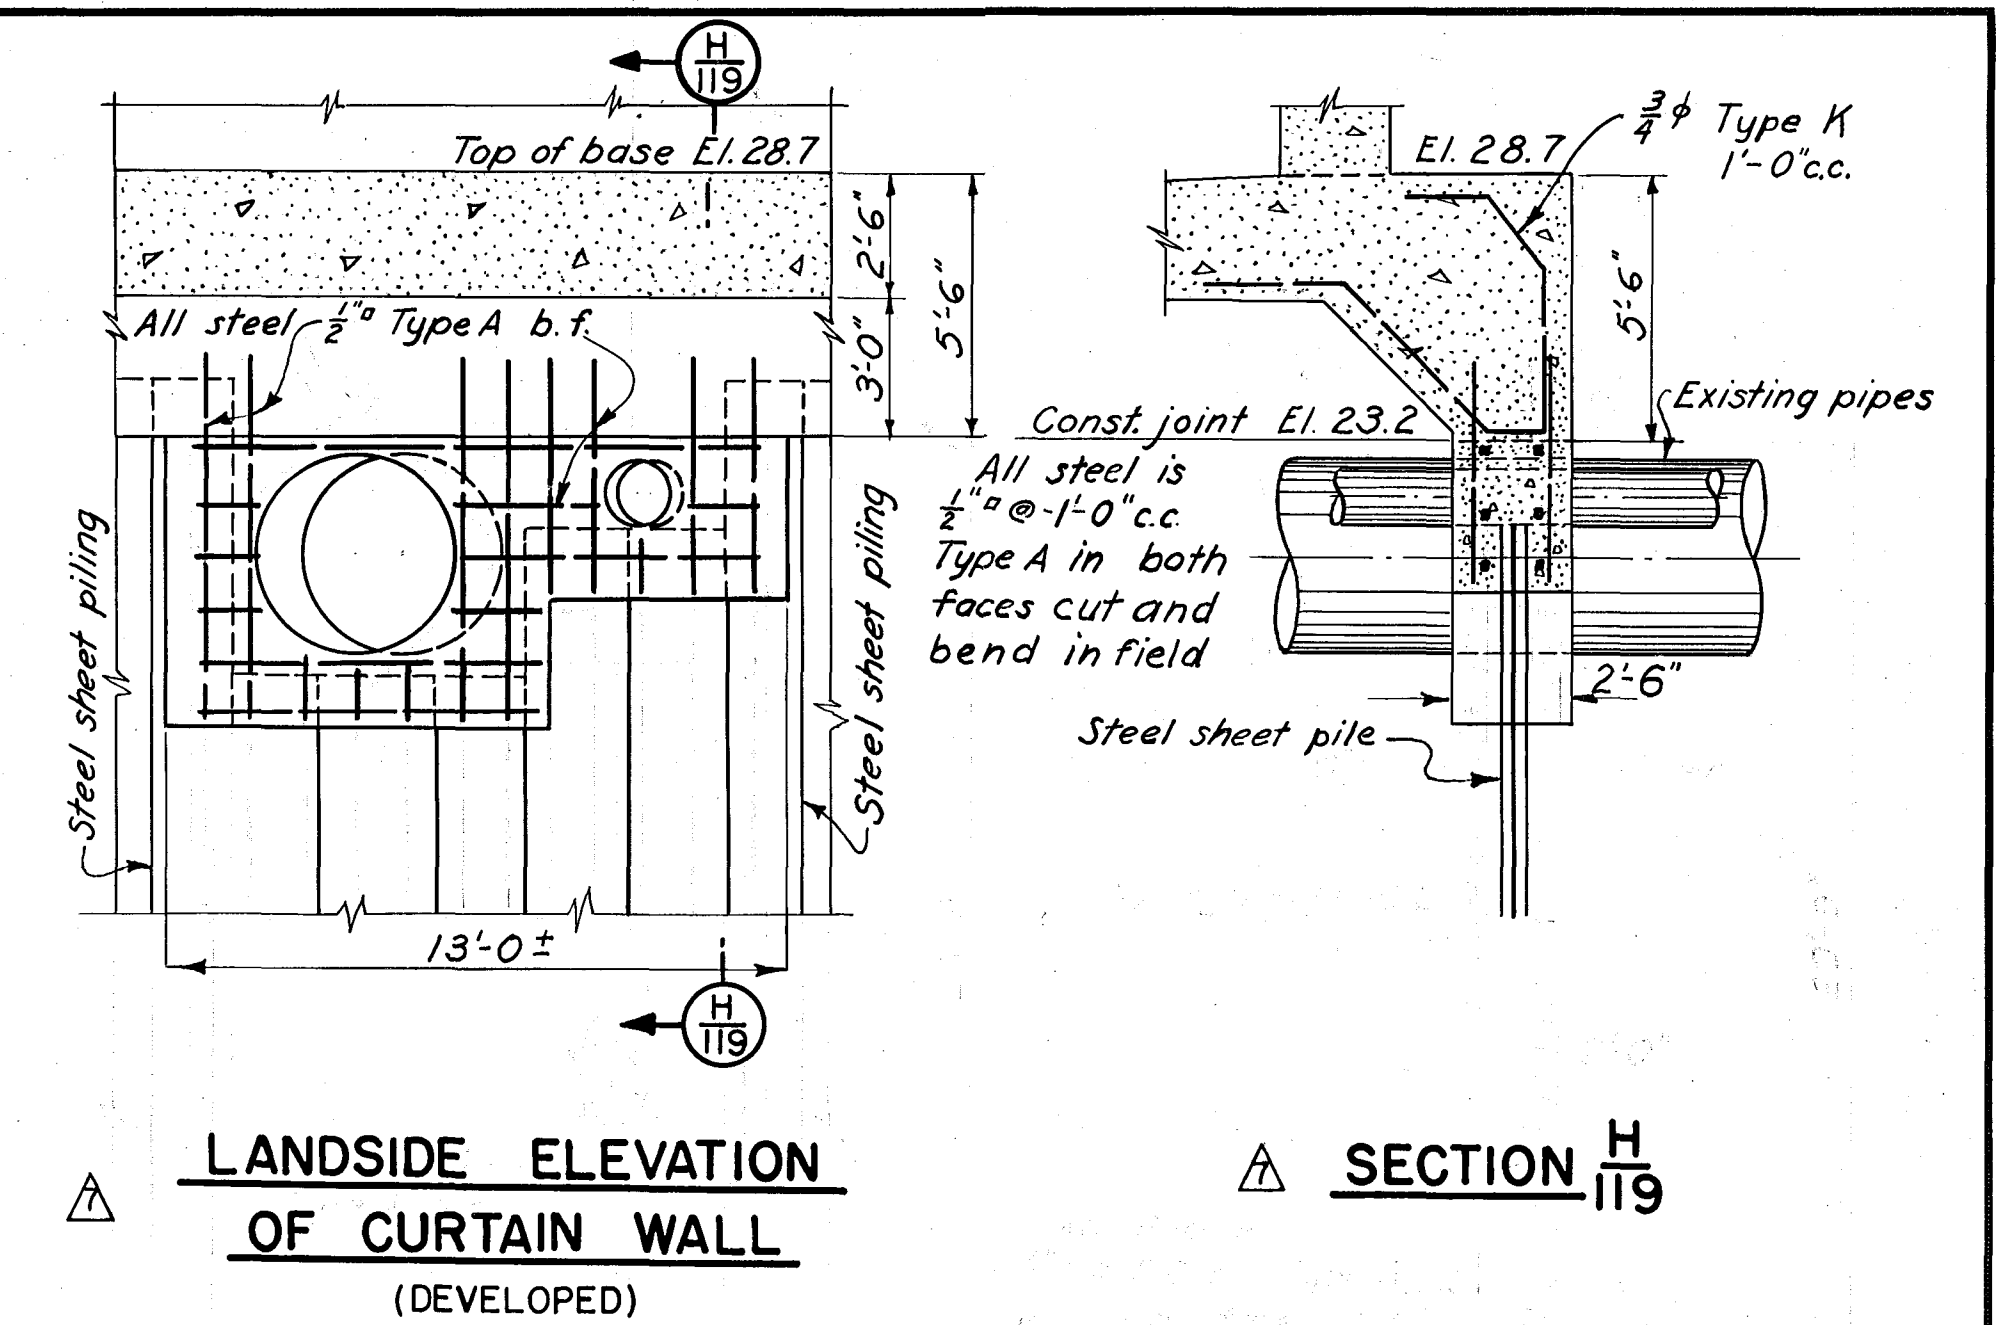

LANDSIDE ELEVATION
OF CURTAIN WALL
(DEVELOPED)

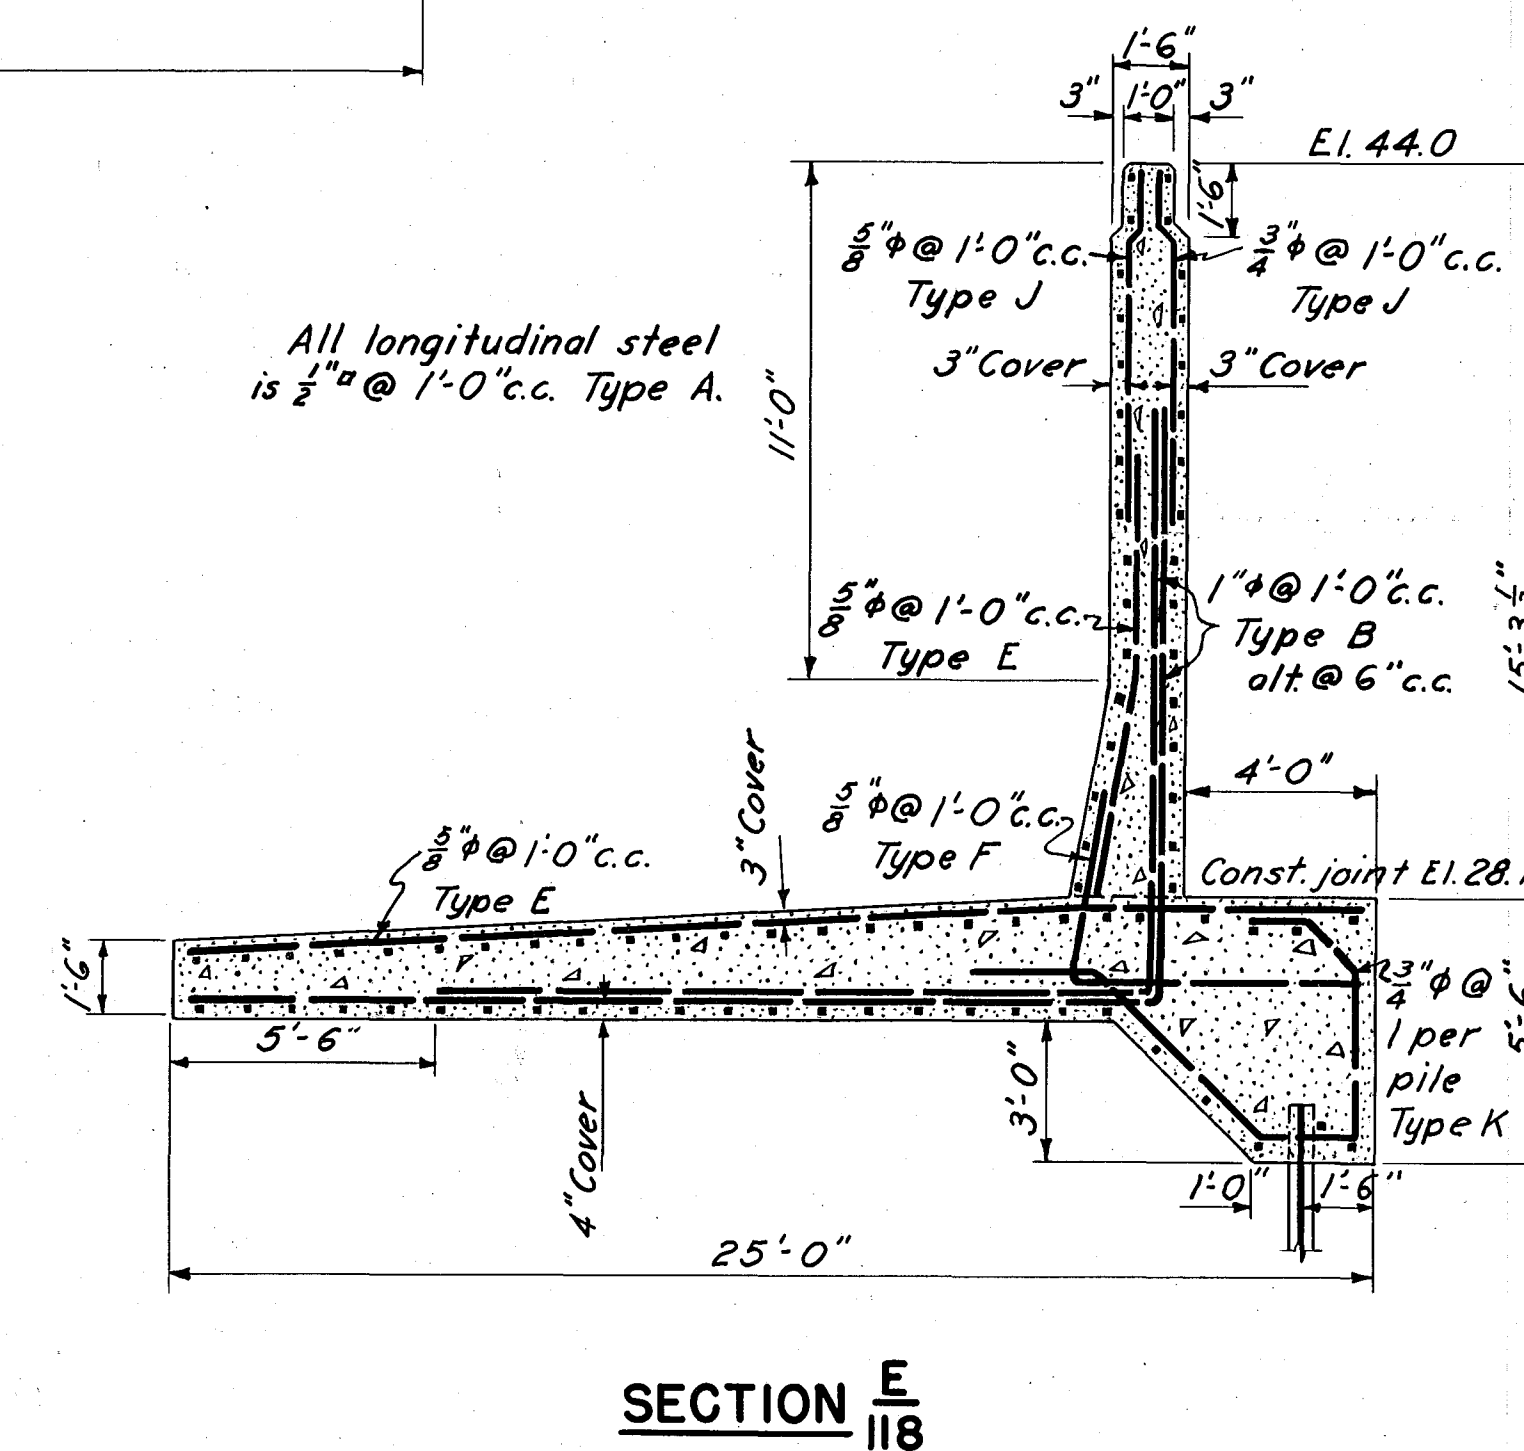

SECTION E
118

For concrete details see Sheet No. 65.
For additional reinforcement details see Sheet No. 118.
For general notes see Sheet No. 117.

SECTION G
118

	12-31-45	As built revisions			
A	3-10-41	Change curtain wall	JCD	MM	HL
KEY	DATE	REVISION (Indicated by Δ)	REV. BY	CK. BY	AP.

CONNECTICUT RIVER FLOOD CONTROL HARTFORD DIKE RIVERFRONT, MORGAN ST. TO STA. 96+73 STOP-LOG STRUCTURE NO. 2 STEEL REINFORCEMENT NO. 2		
CONNECTICUT RIVER	SCALE: 1/4" IN. = 1 FT.	CONNECTICUT
IN 135 SHEETS		SHEET NO. 119
U.S. ENGINEER OFFICE, PROVIDENCE, R.I., MAY 1940		
SUBMITTED: <i>Wm. B. Dick</i> SENIOR ENGINEER HEAD, DESIGN SECTION	APPROVAL RECOMMENDED: <i>W. B. Dick</i> PRINCIPAL ENGINEER CIVIL & ENGINEERING DIV.	APPROVED: <i>W. B. Dick</i> LT. COL. CORPS OF ENGINEERS DISTRICT ENGINEER
DESIGNER: <i>W. B. Dick</i> ASSOC. ENGINEER	DRAWN: E. H. V. TRACED: B. G. CHECKED: <i>Wm. B. Dick</i>	FISCAL YEAR 1940 FILE NO. CT-4-2579