



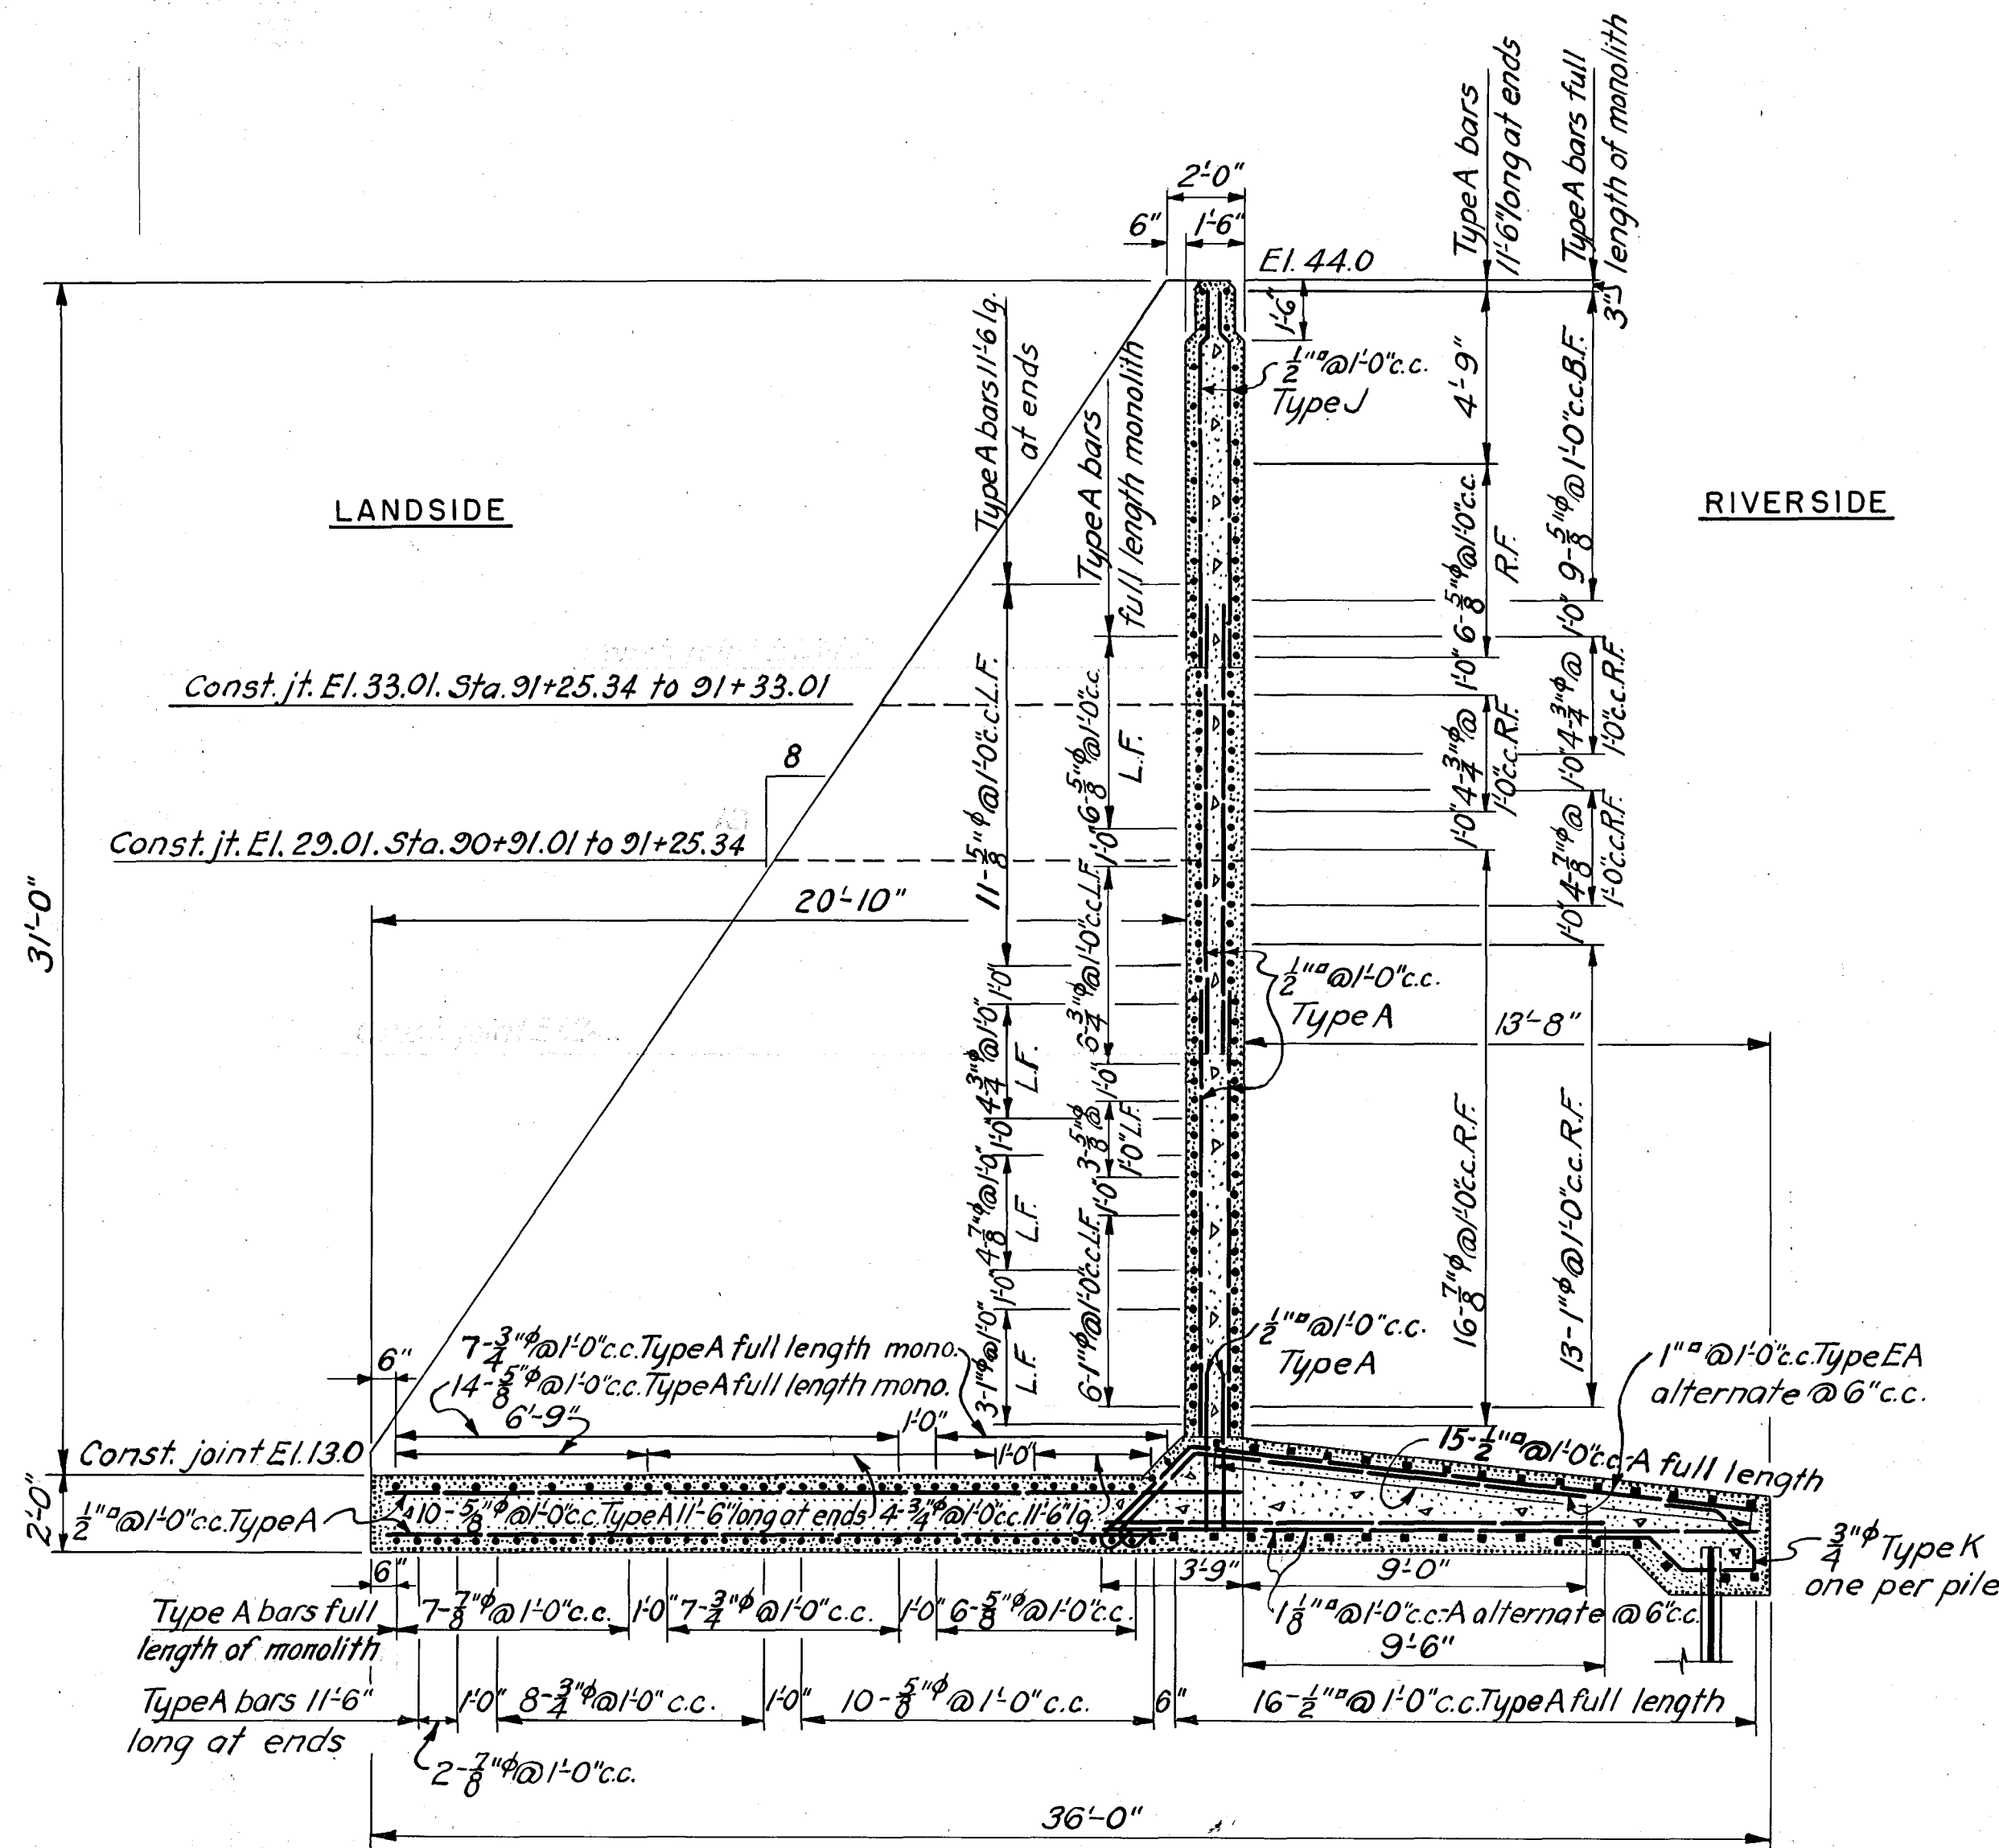


31'-0" WALL SECTION
STEM AND BASE STEEL
STA. 90+91.01 TO STA. 91+33.01

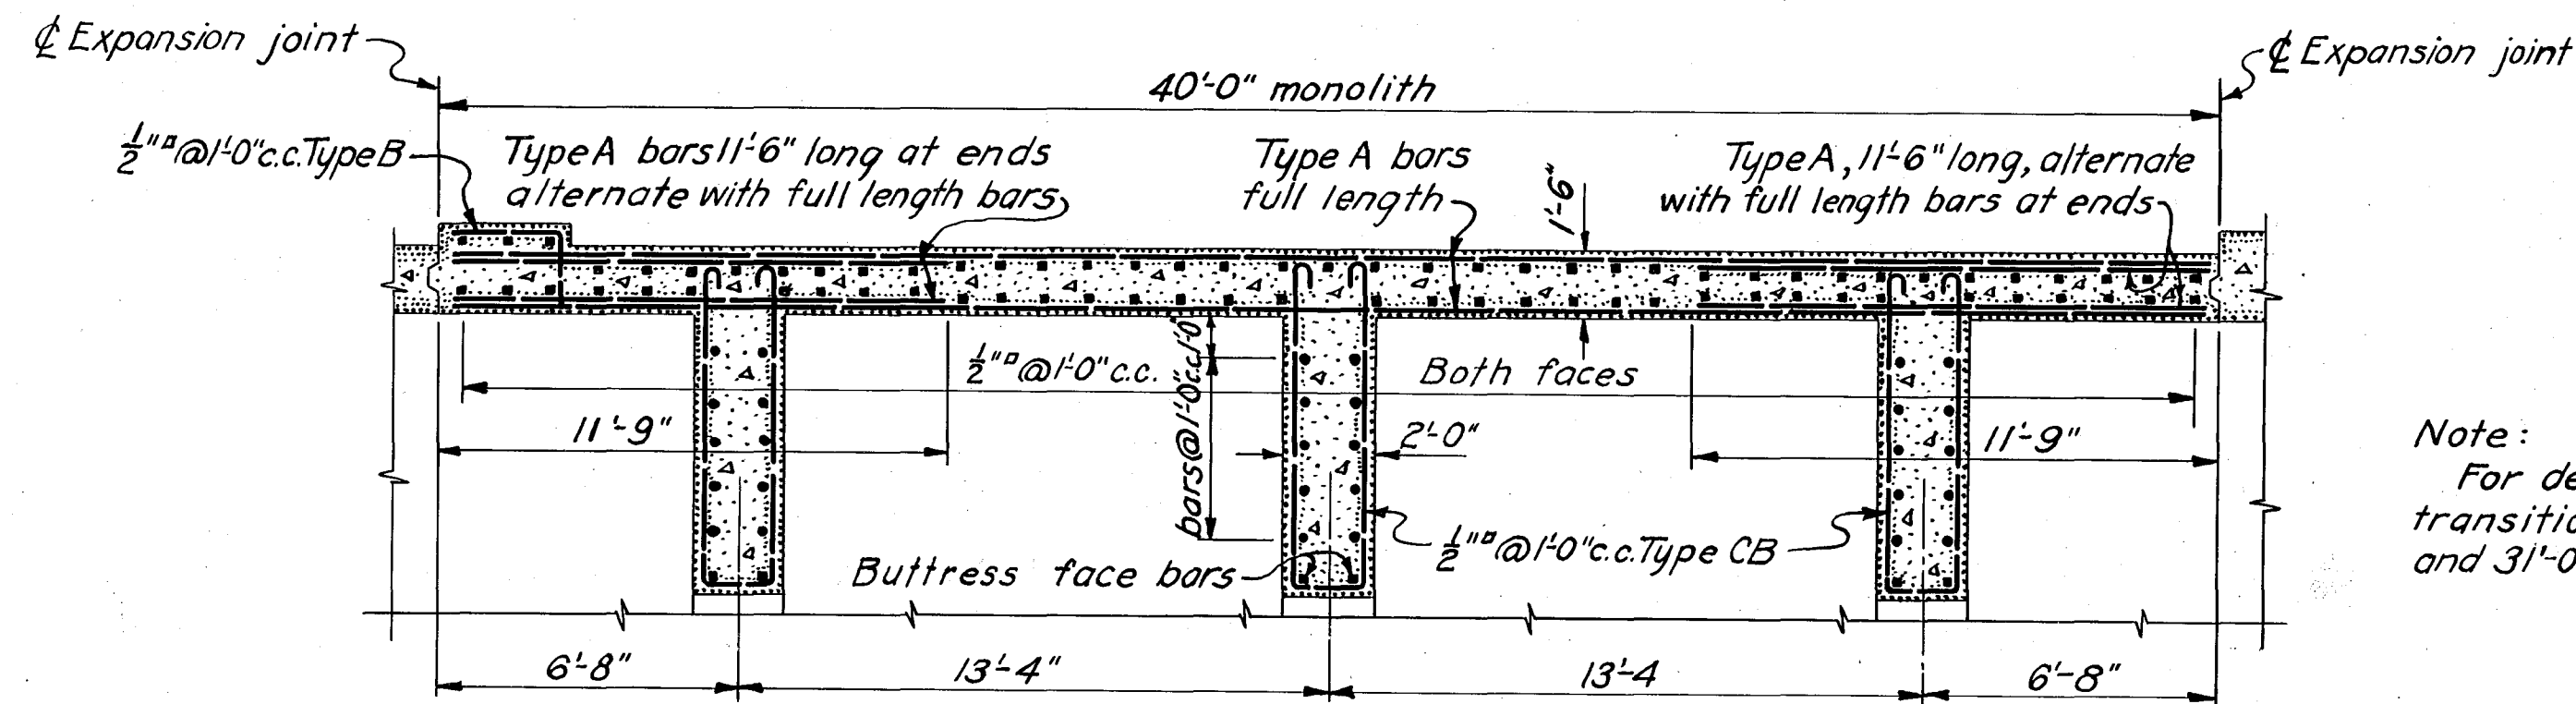

TYPICAL SECTION OF BUTTRESSED WALL
STEEL IN STEM AND BUTTRESS

Note:
For detail of steel in base
transition between 34'-0" wall
and 31'-0" wall see Sheet No. 125

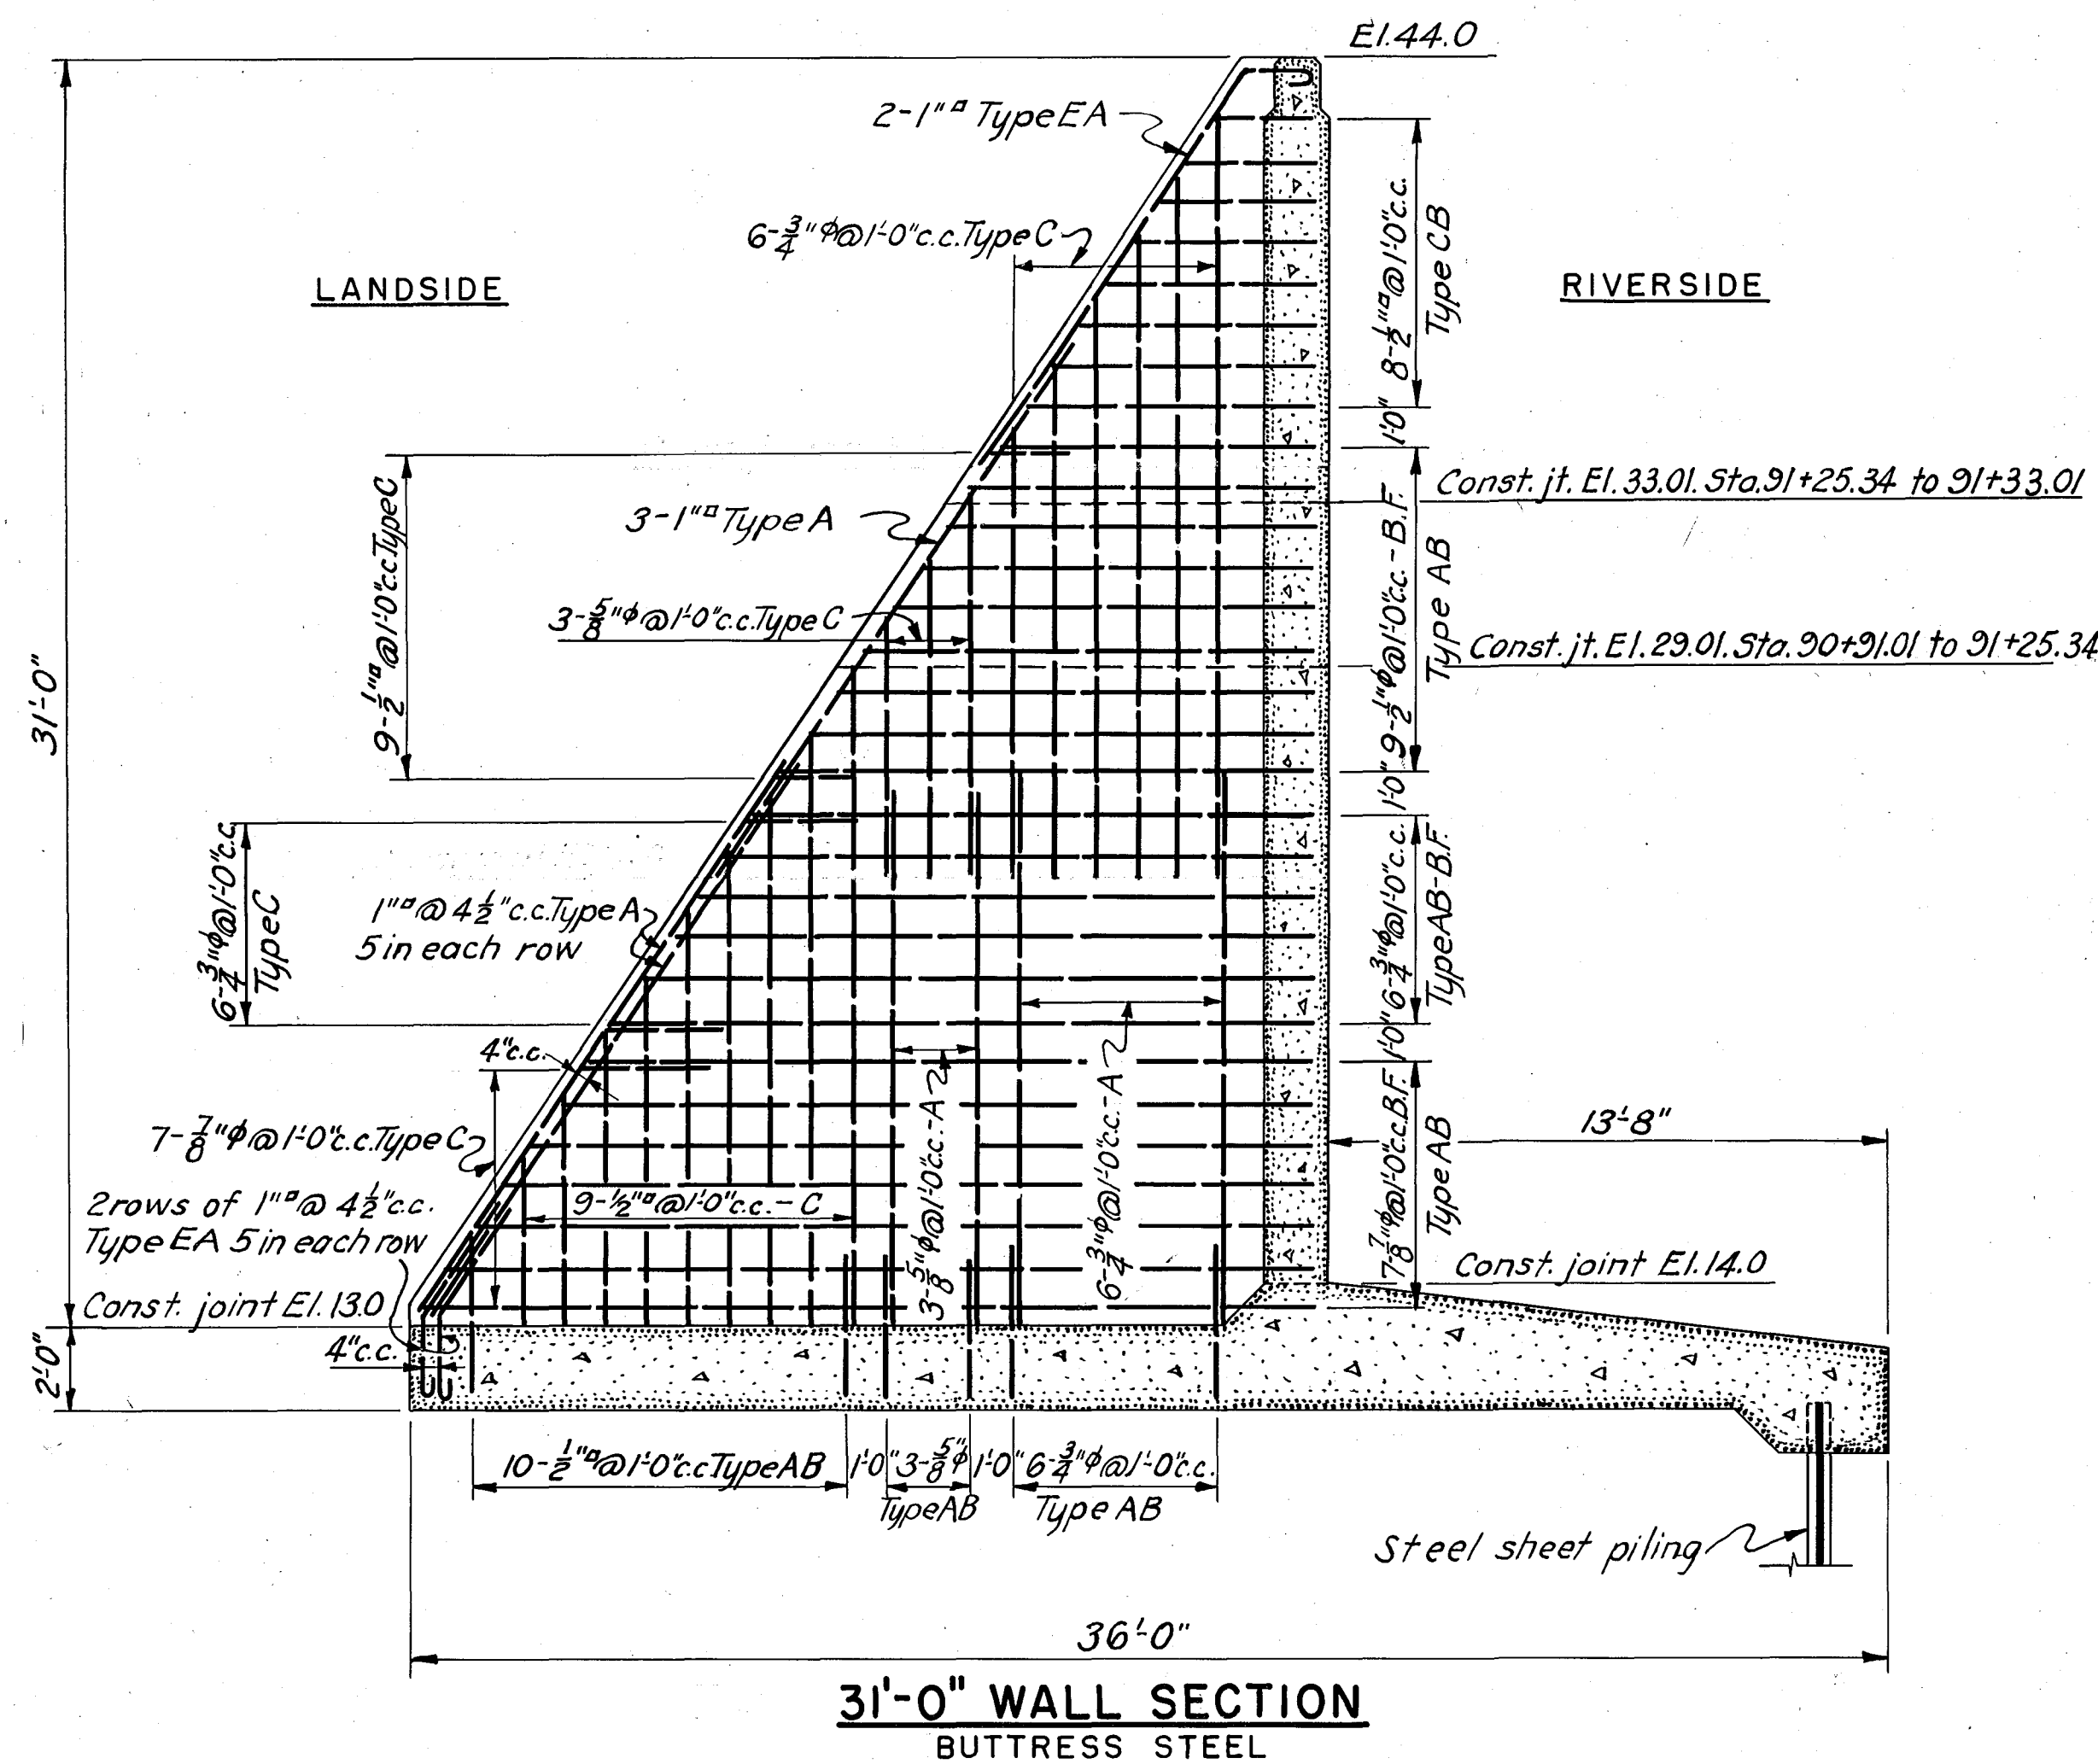

31'-0" WALL SECTION
BUTTRESS STEEL

NOTES
For concrete details see Sheet No. 75.
For general notes see Sheet No. 121.

KEY	DATE	REVISION (Indicated by Δ)	REV. BY	CK. BY	AP. BY
	12-31-45	As built revisions			

CONNECTICUT RIVER FLOOD CONTROL		
HARTFORD DIKE		
RIVERFRONT, MORGAN ST. TO STA. 96+73		
WALL DETAILS-STA. 90+91 TO STA. 91+33.01		
STEEL REINFORCEMENT		
CONNECTICUT RIVER	SCALE: 1/4"=1 FT.	CONNECTICUT
IN 135 SHEETS		SHEET NO. 123
U. S. ENGINEER OFFICE, PROVIDENCE, R.I., MAY 1940		
SUBMITTED:	APPROVAL RECOMMENDED:	APPROVED:
SENIOR ENGINEER	PRINCIPAL ENGINEER	LT. COL. CORPS OF ENGINEERS
HEAD, DESIGN SECTION	CHIEF, F.C. ENGINEERING DIV.	DISTRICT ENGINEER
DESIGNED:	DRAWN: E. H. V.	FISCAL YEAR 1940
ASSOC. ENGINEER	CHECKED: J. S. M.	FILE NO. CT-4-2583