


100
101

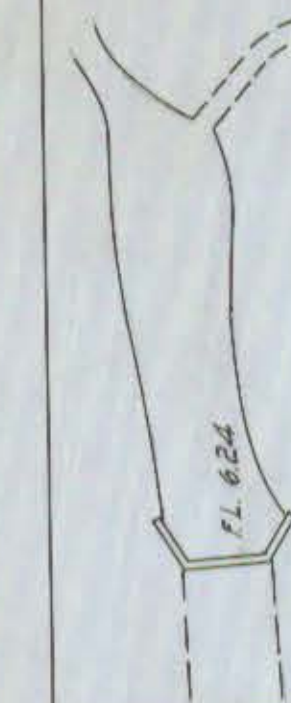

State of Connecticut

Street Line

End of Pipe

48" R.C.P. 1/2 302

WEST SERVICE ROAD

H.J. Enterprises, Inc.

Open Ditch

Future Manhole
B.M. NW cor. headwall
El. 15.298

Remove pipe in manhole

81° 15' 07"


WESTON STREET

24"


209

8

12" R.C.P.

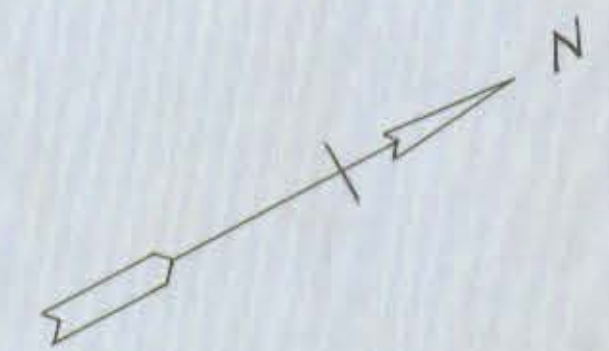

CITY OF HARTFORD
DEPARTMENT OF ENGINEERING
SCALES H. 1" = 40' OCTOBER 1964
V. 1" = 10'
DAYBOOK No. 09849

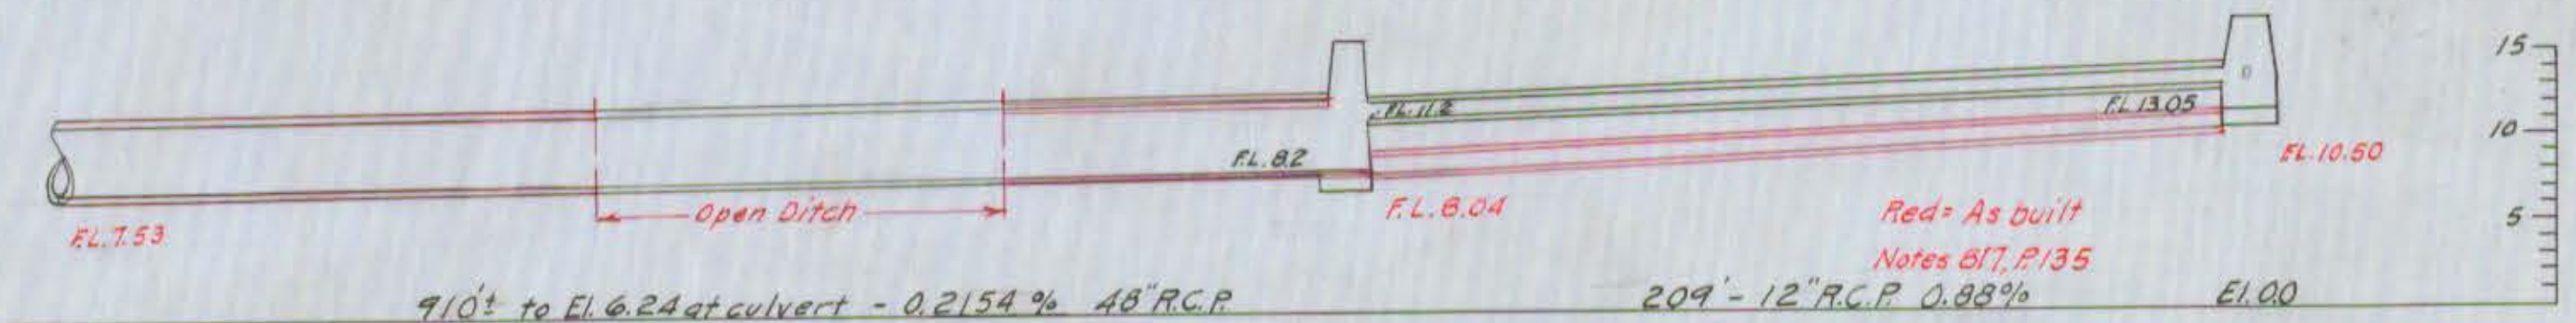

Red = As built
Notes 617, P. 135

910' to El. 6.24 at culvert - 0.2154% 48" R.C.P.

209' - 12" R.C.P. 0.88%

EL 00

Notebook 819 P. 105