



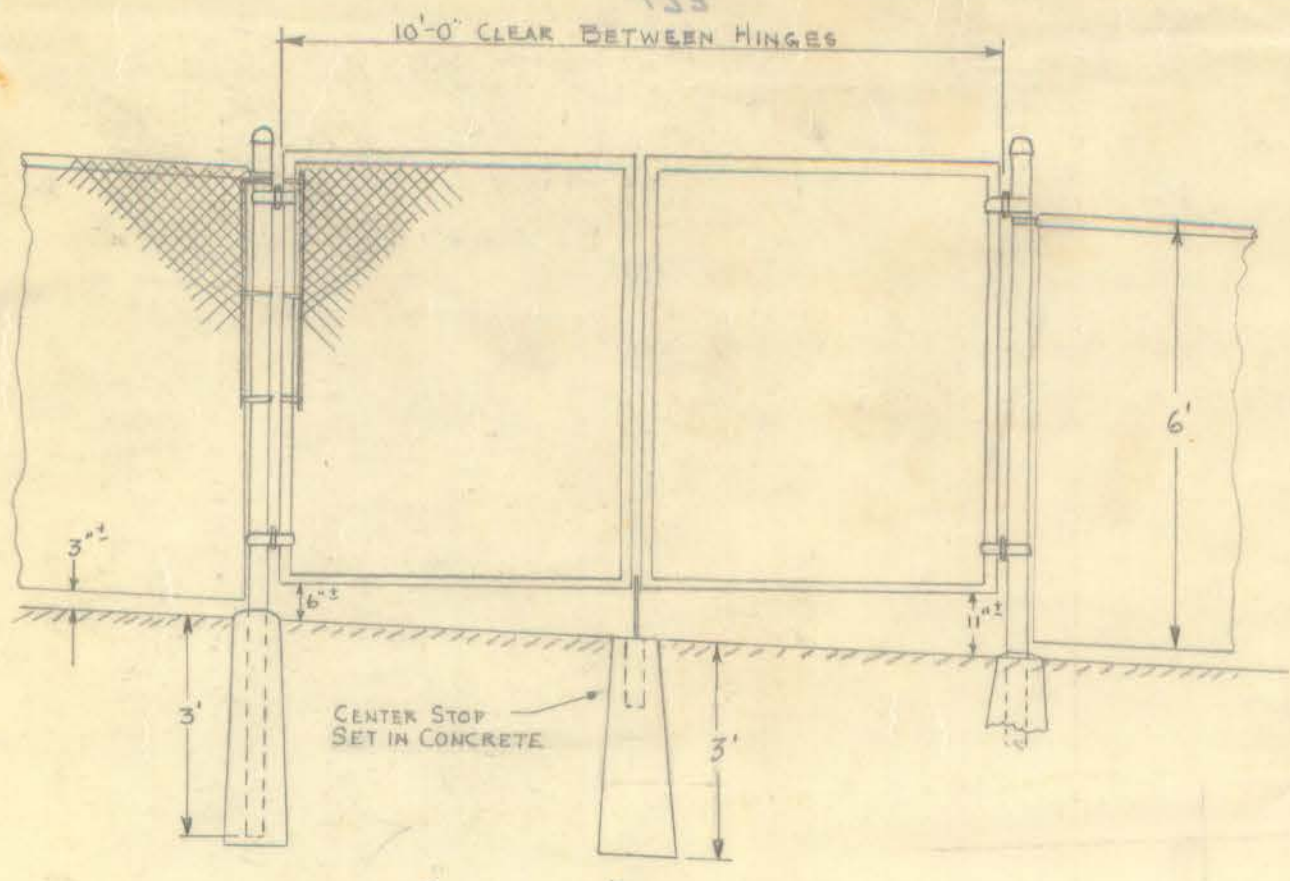

~ GATE DETAIL ~
SCALE ~ 3/8" = 1'-0"

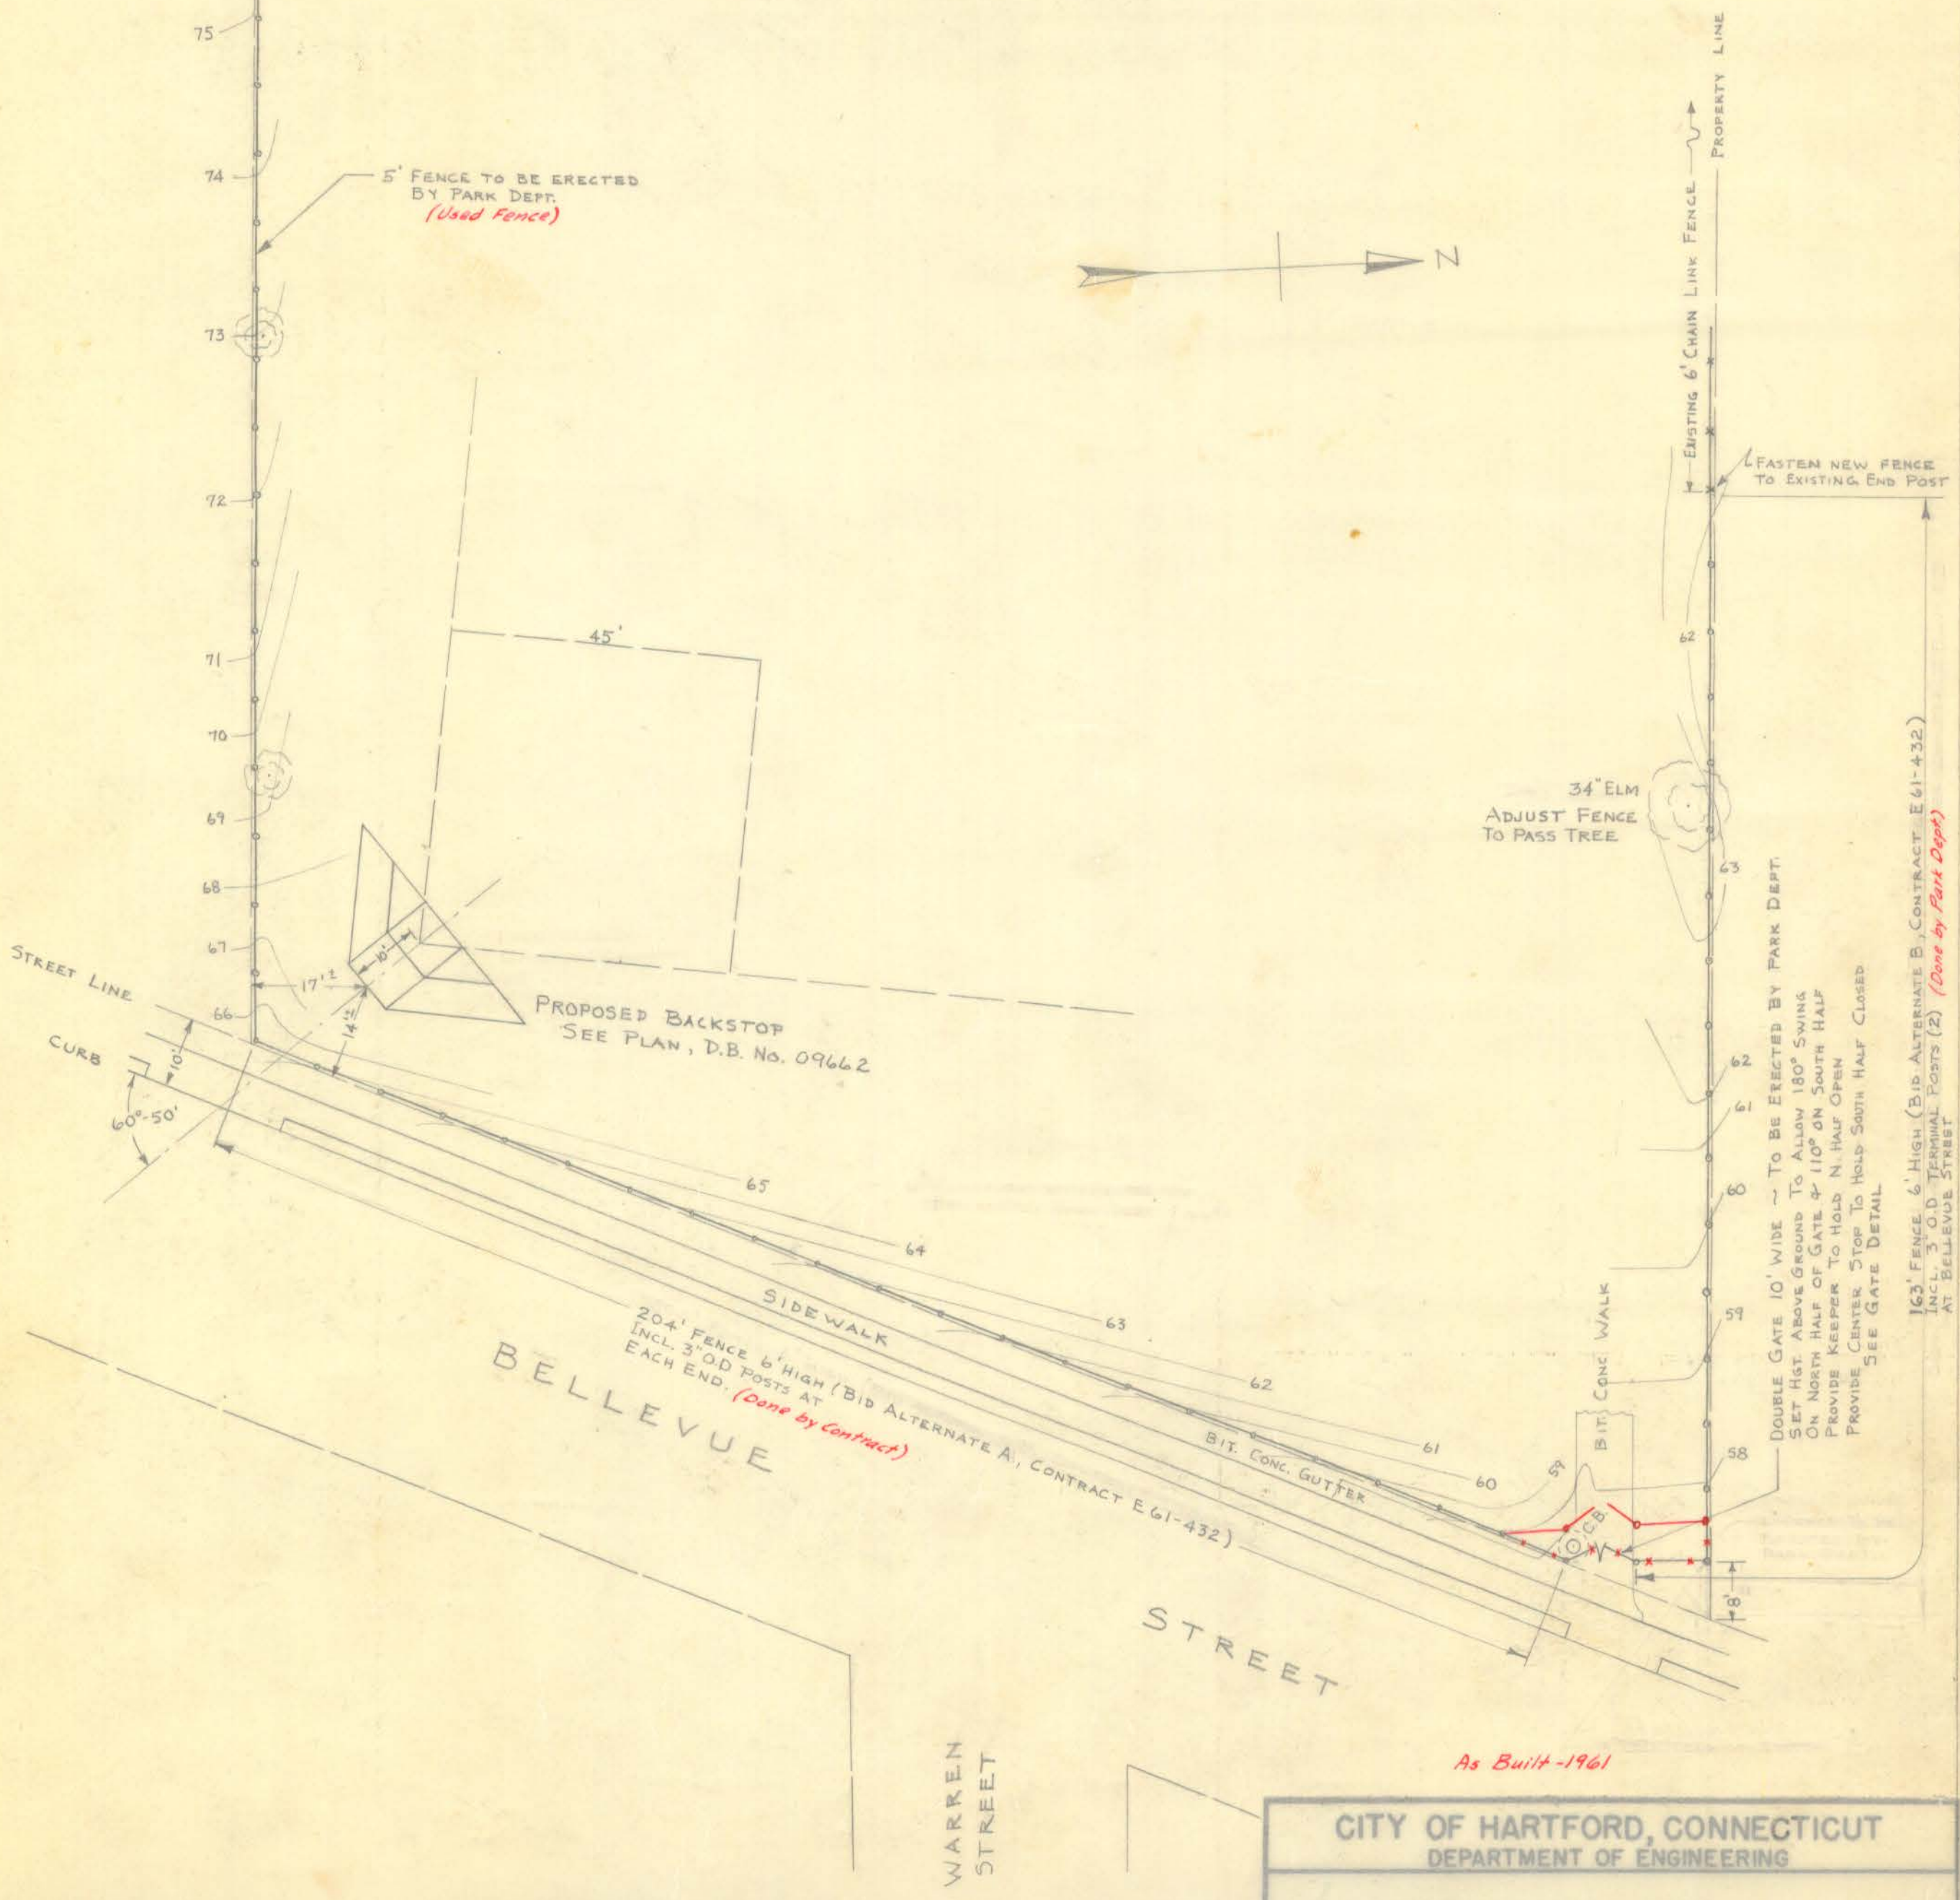

As Built - 1961

~ LEGEND ~

○ — ○ — ○ — PROPOSED CHAIN LINK FENCE 5'4-6' HIGH

× — × — × — EXISTING " " "

— — — — STREET & PROPERTY LINES

— — — — 67 CONTOURS

NOTE: 1. EXACT LOCATION OF FENCE TO BE DETERMINED BY ENGINEER

2. FENCING WILL BE ERECTED BY CONTRACT IN ONLY ONE LOCATION UNDER ALTERNATE A OR B. FENCE UNDER THE ALTERNATE NOT INCLUDED IN THE CONTRACT WILL BE ERECTED BY THE PARK DEPT.

3. NO FENCE WILL BE ERECTED BY THE PARK DEPT. BEFORE ALL WORK UNDER CONTRACT E 61-432 IS COMPLETED.

CITY OF HARTFORD, CONNECTICUT DEPARTMENT OF ENGINEERING		
BELLEVUE STREET PLAY AREA CHAIN LINK FENCE 5'4-6' HIGH AND BACKSTOP SCALE ~ 1" = 20'-0"		
SUBMITTED <i>George E. Heppner</i> DIVISION ENGINEER	RECOMMENDED <i>Robert A. Benson</i> ASST. CITY ENG.	APPROVED <i>Winifred W. Bellway</i> CITY ENGINEER
DESIGN	DRAWN <i>E.L.P.</i>	DAYBOOK NO. 09651
TRACED <i>E.L.P.</i>	CHECK <i>G.E.H.</i>	DATE DECEMBER 1960