
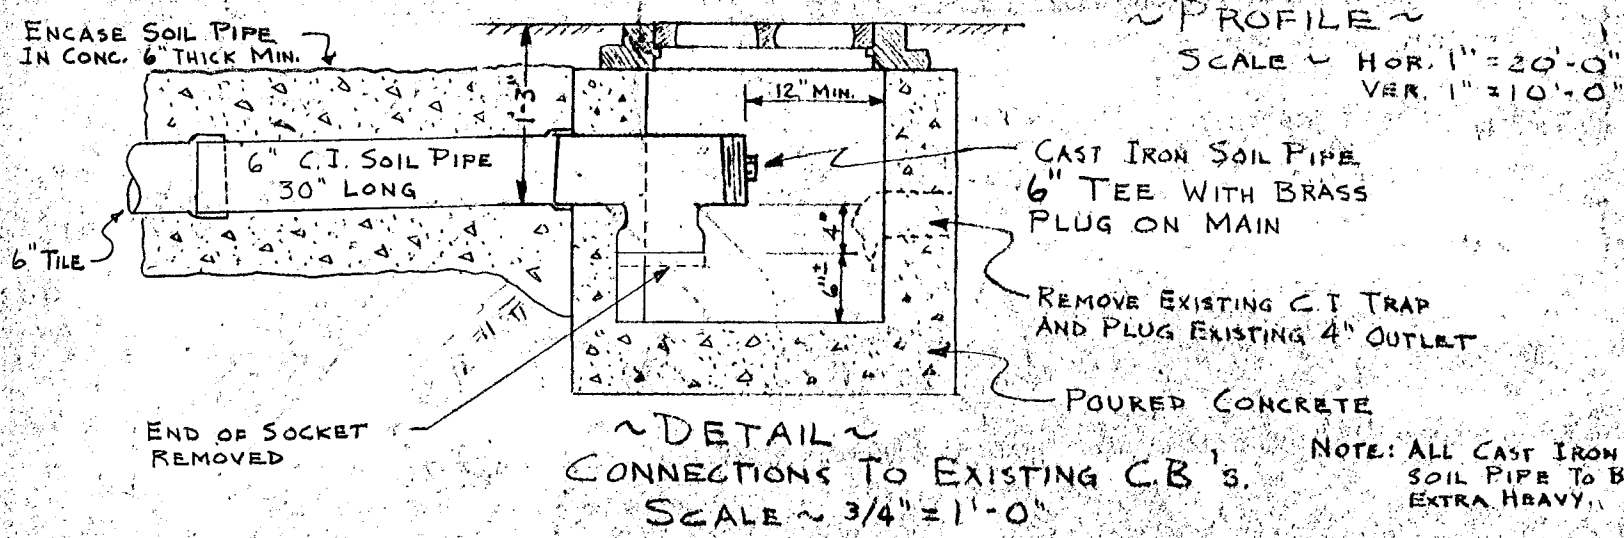
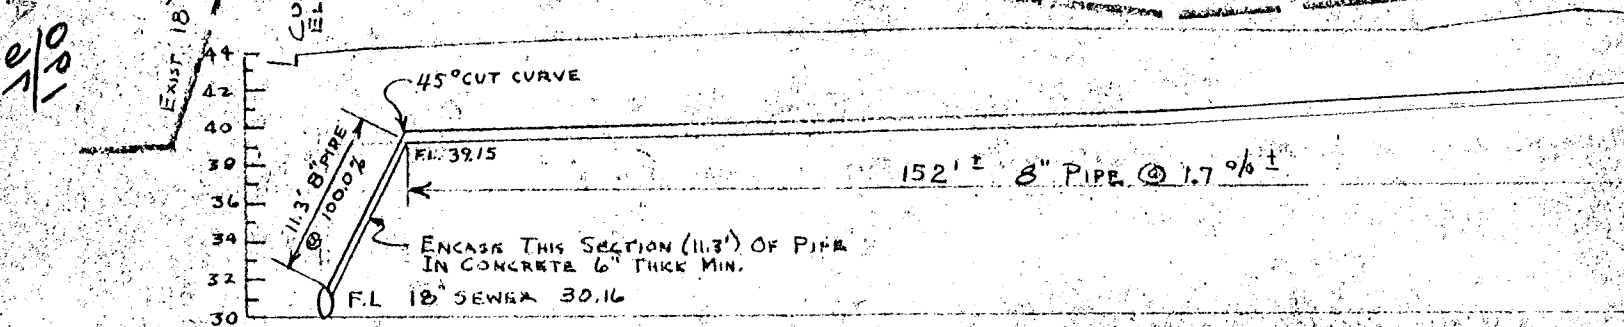


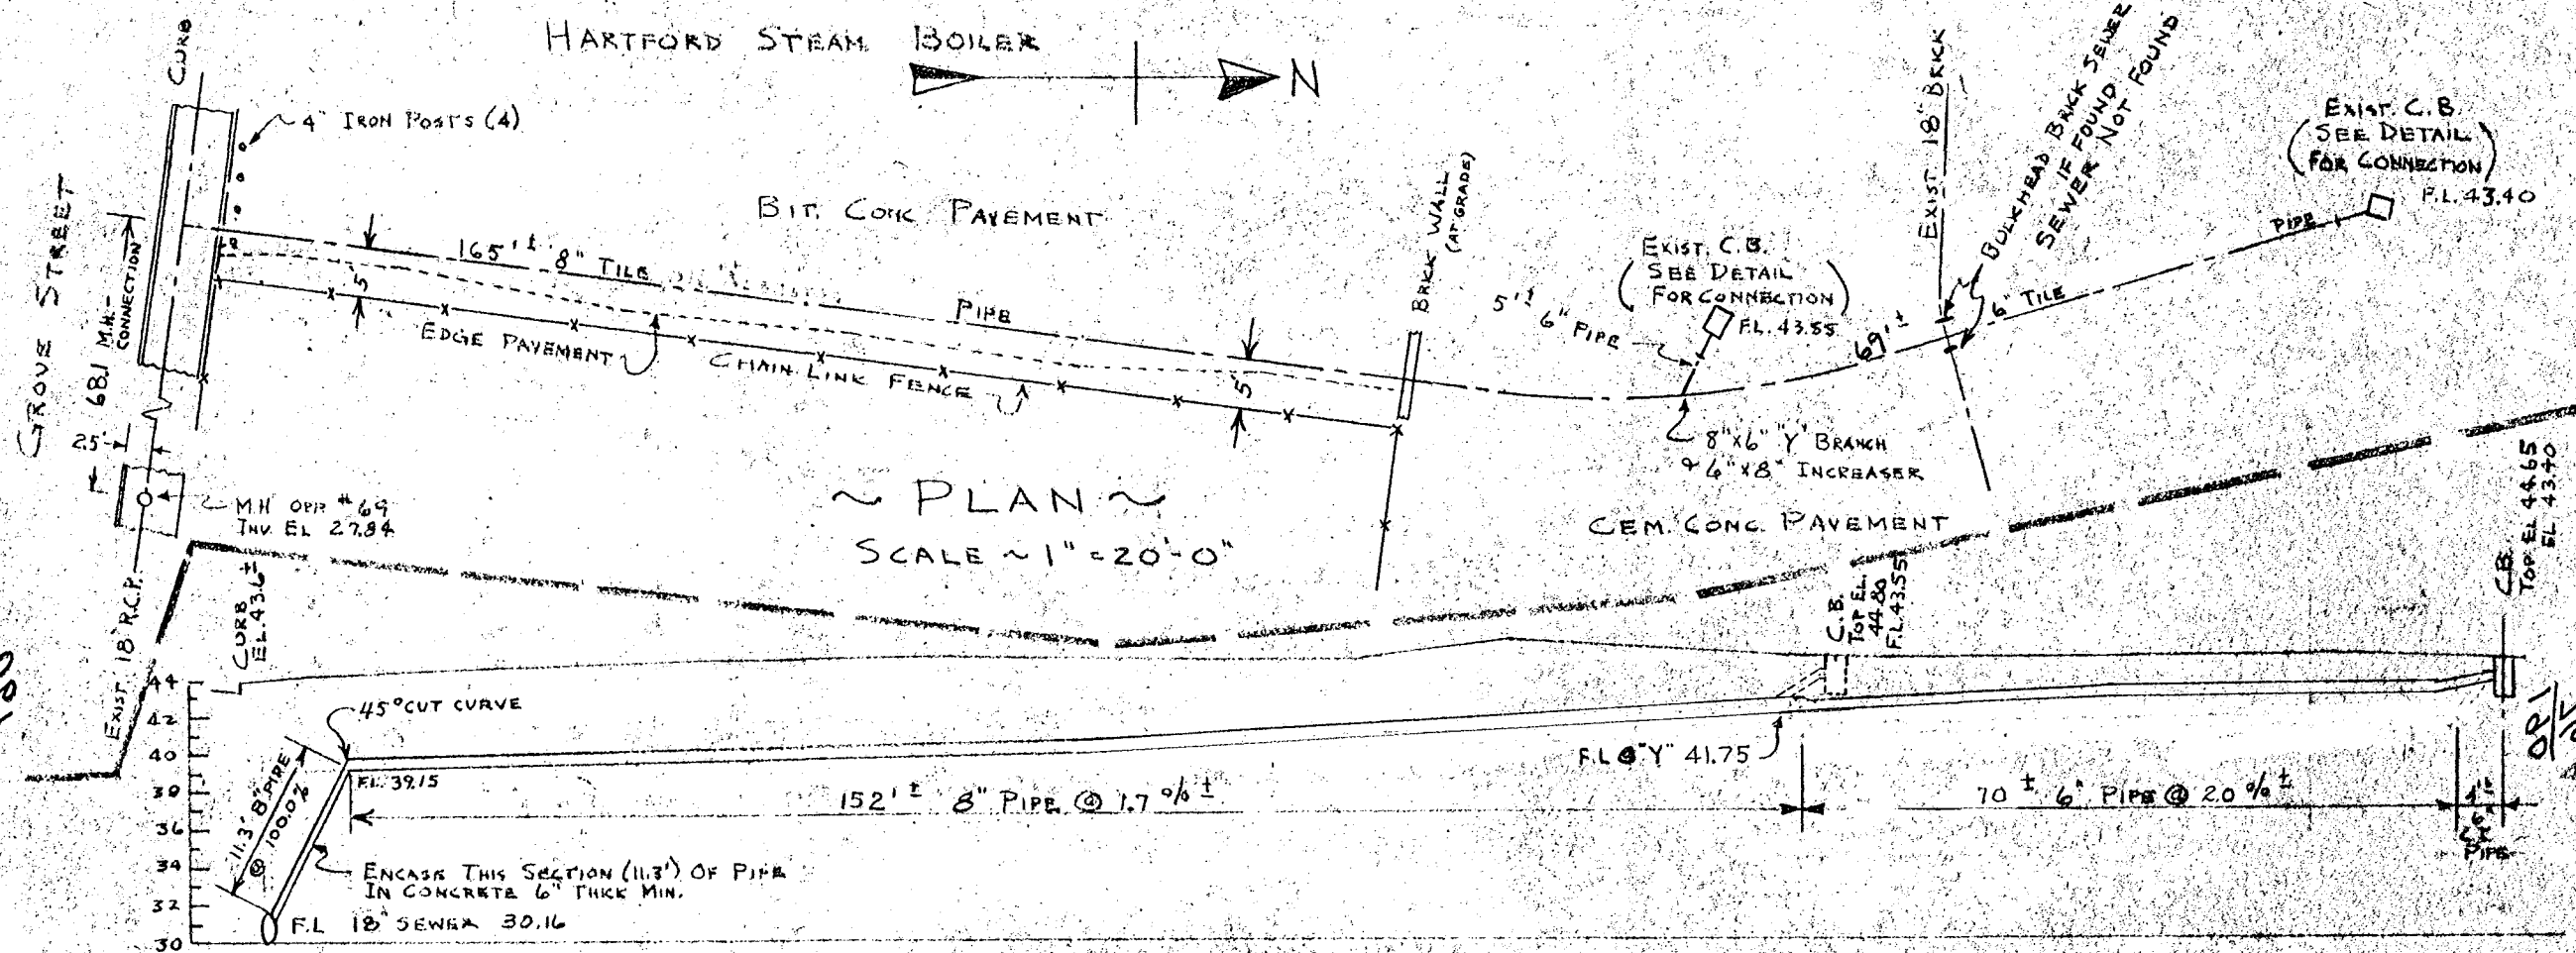

CITY OF HARTFORD, CONNECTICUT DEPARTMENT OF ENGINEERING		
NEW HOUSE CONNECTION NO 58 GROVE STREET		
FOR TWO EXISTING CATCH BASINS ON PROPERTY OF HARTFORD STEAM BOILER INSPECTION & INSURANCE COMPANY PLAN AS BUILT JUNE 16, 1961 E.J.P.		
SUBMITTED <i>George E. Hoppner</i> DIVISION ENGINEER	RECOMMENDED <i>Paul H. Bowers</i> ASST. CITY ENG.	APPROVED <i>Winfred W. Dellboy</i> CITY ENGINEER
DESIGN <i>E.J.P.</i>	DRAWN <i>E.J.P.</i>	DAYBOOK NO. 09660 A
TRACED <i>E.J.P.</i>	CHECK <i>G.E.H.</i>	DATE APRIL 1961