


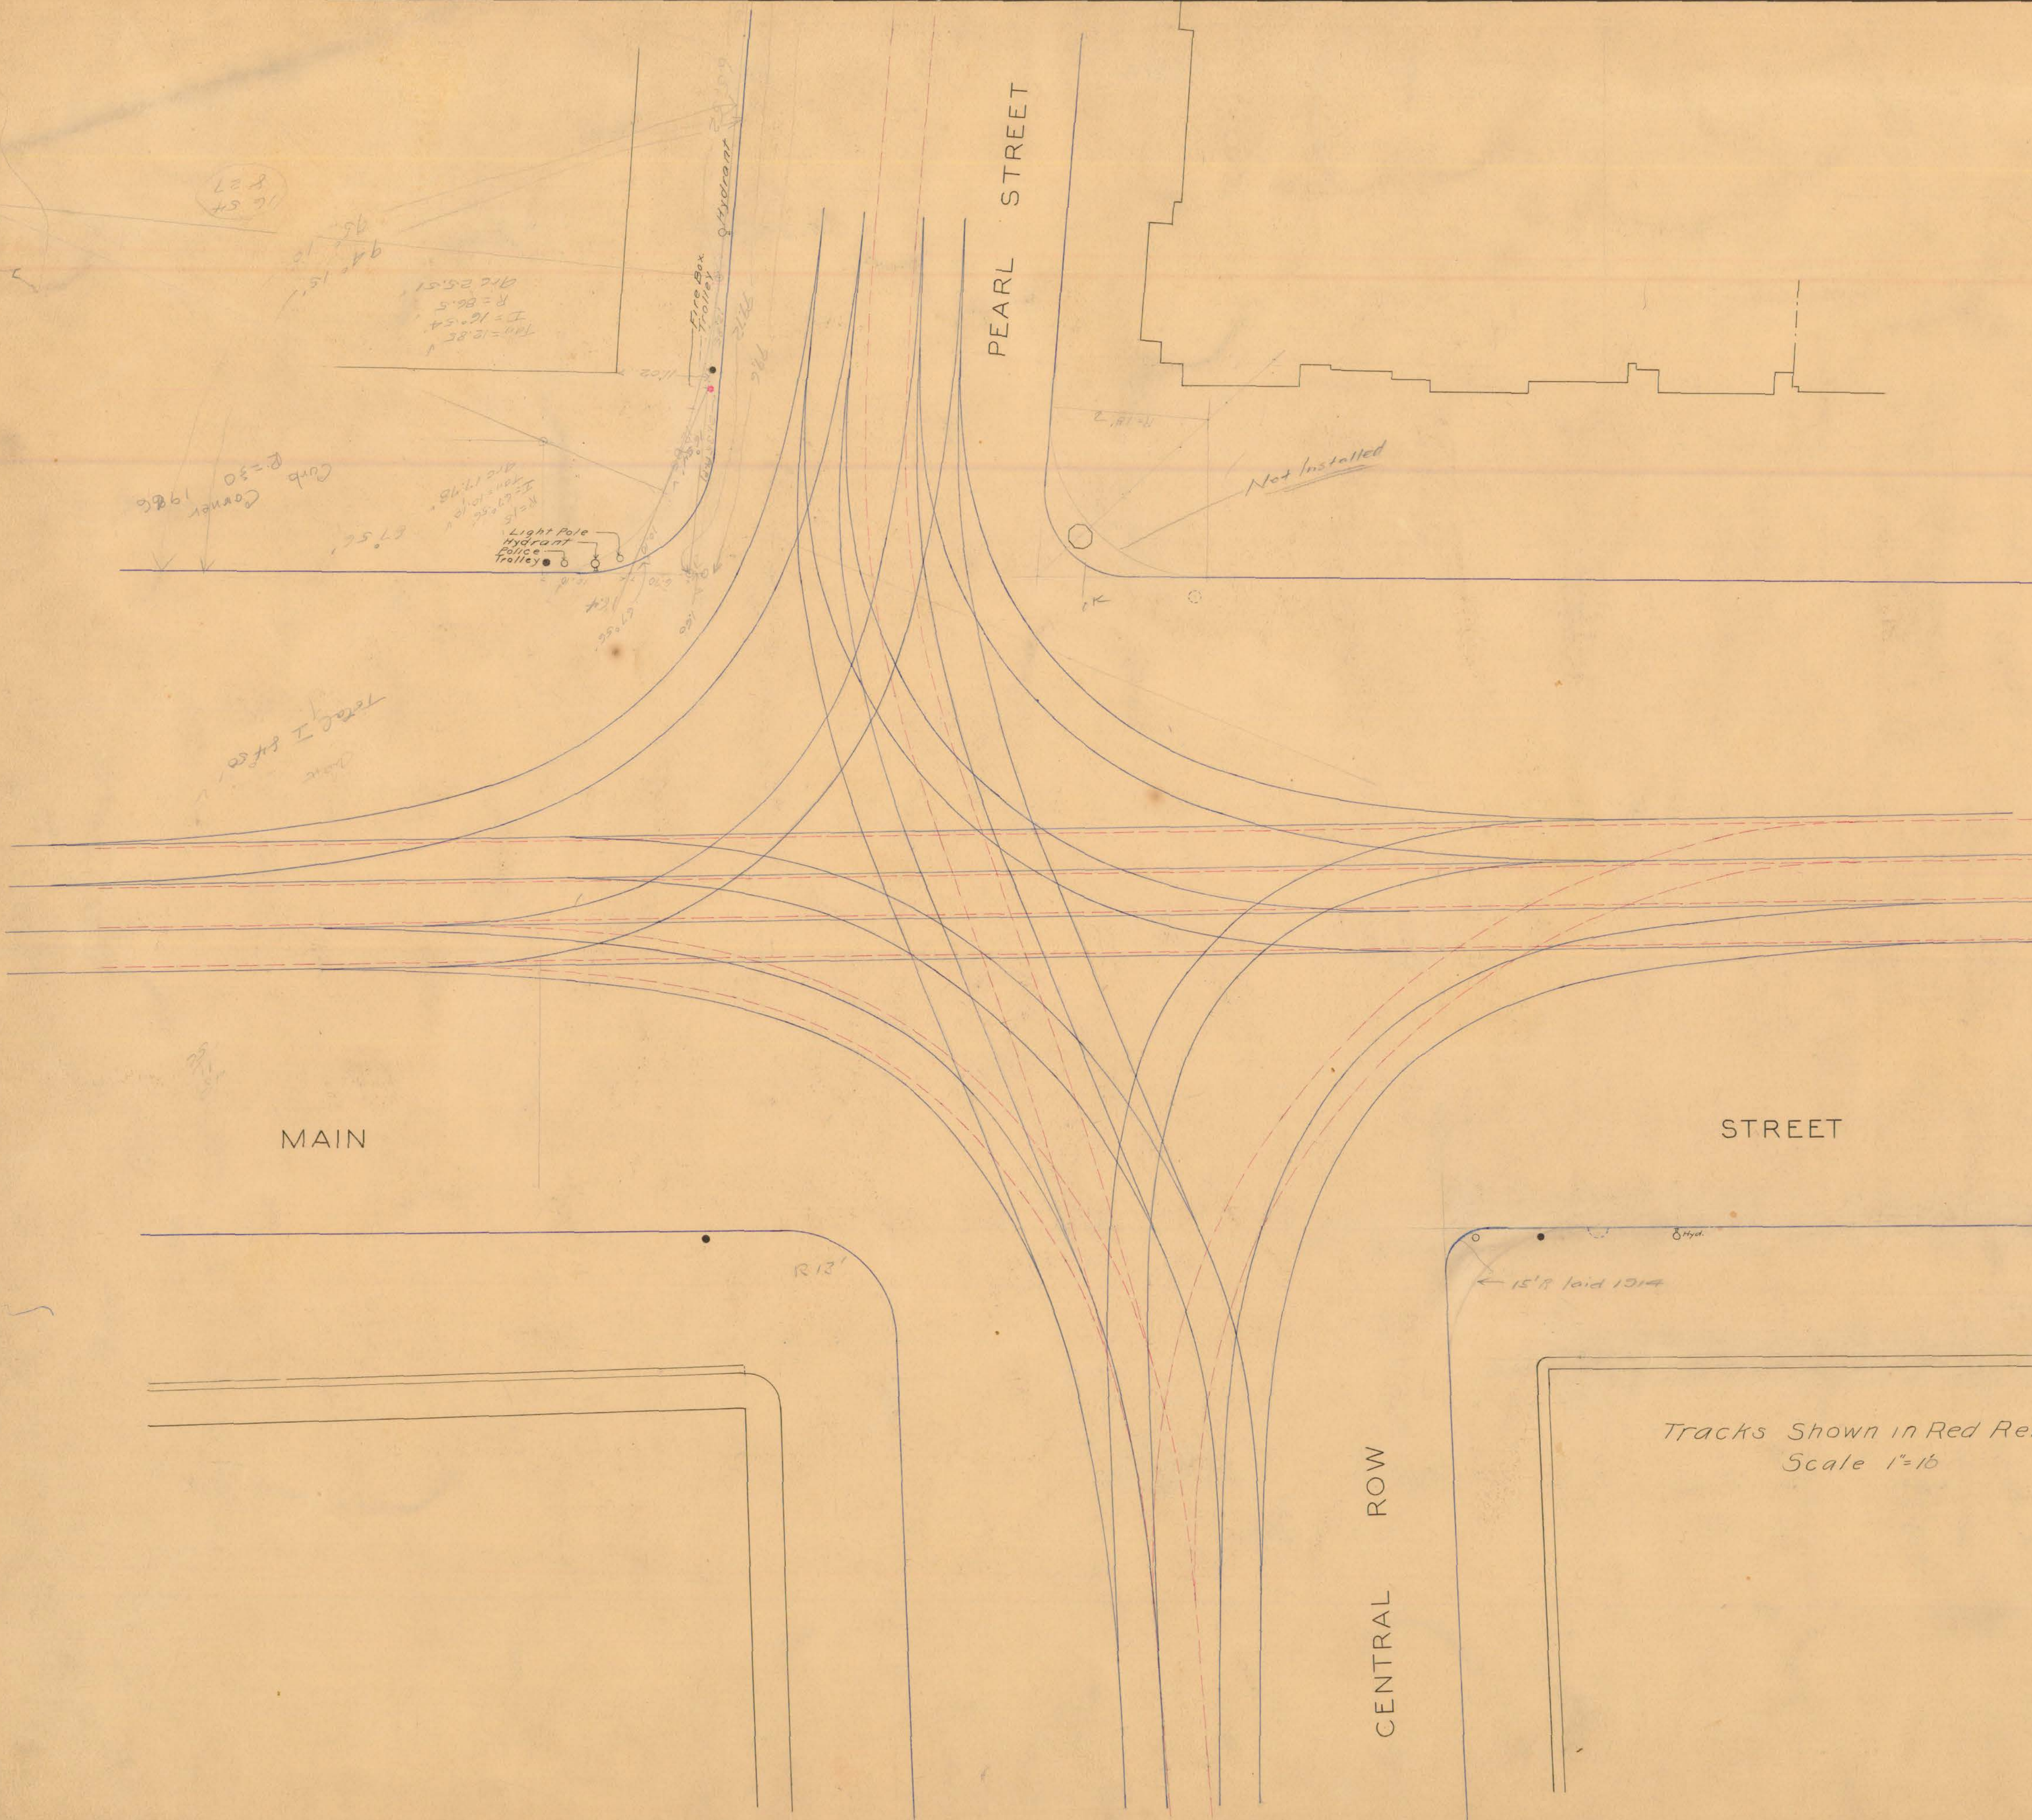

MAIN

PEARL STREET

STREET

CENTRAL ROW

Tracks Shown in Red Removed 1909
Scale 1"=16'

OVERSEER OF THE CITY
HARTFORD, CONN.
Date Mar 1909 Day Book No. 92170
Notes 684-142
City Engineer