
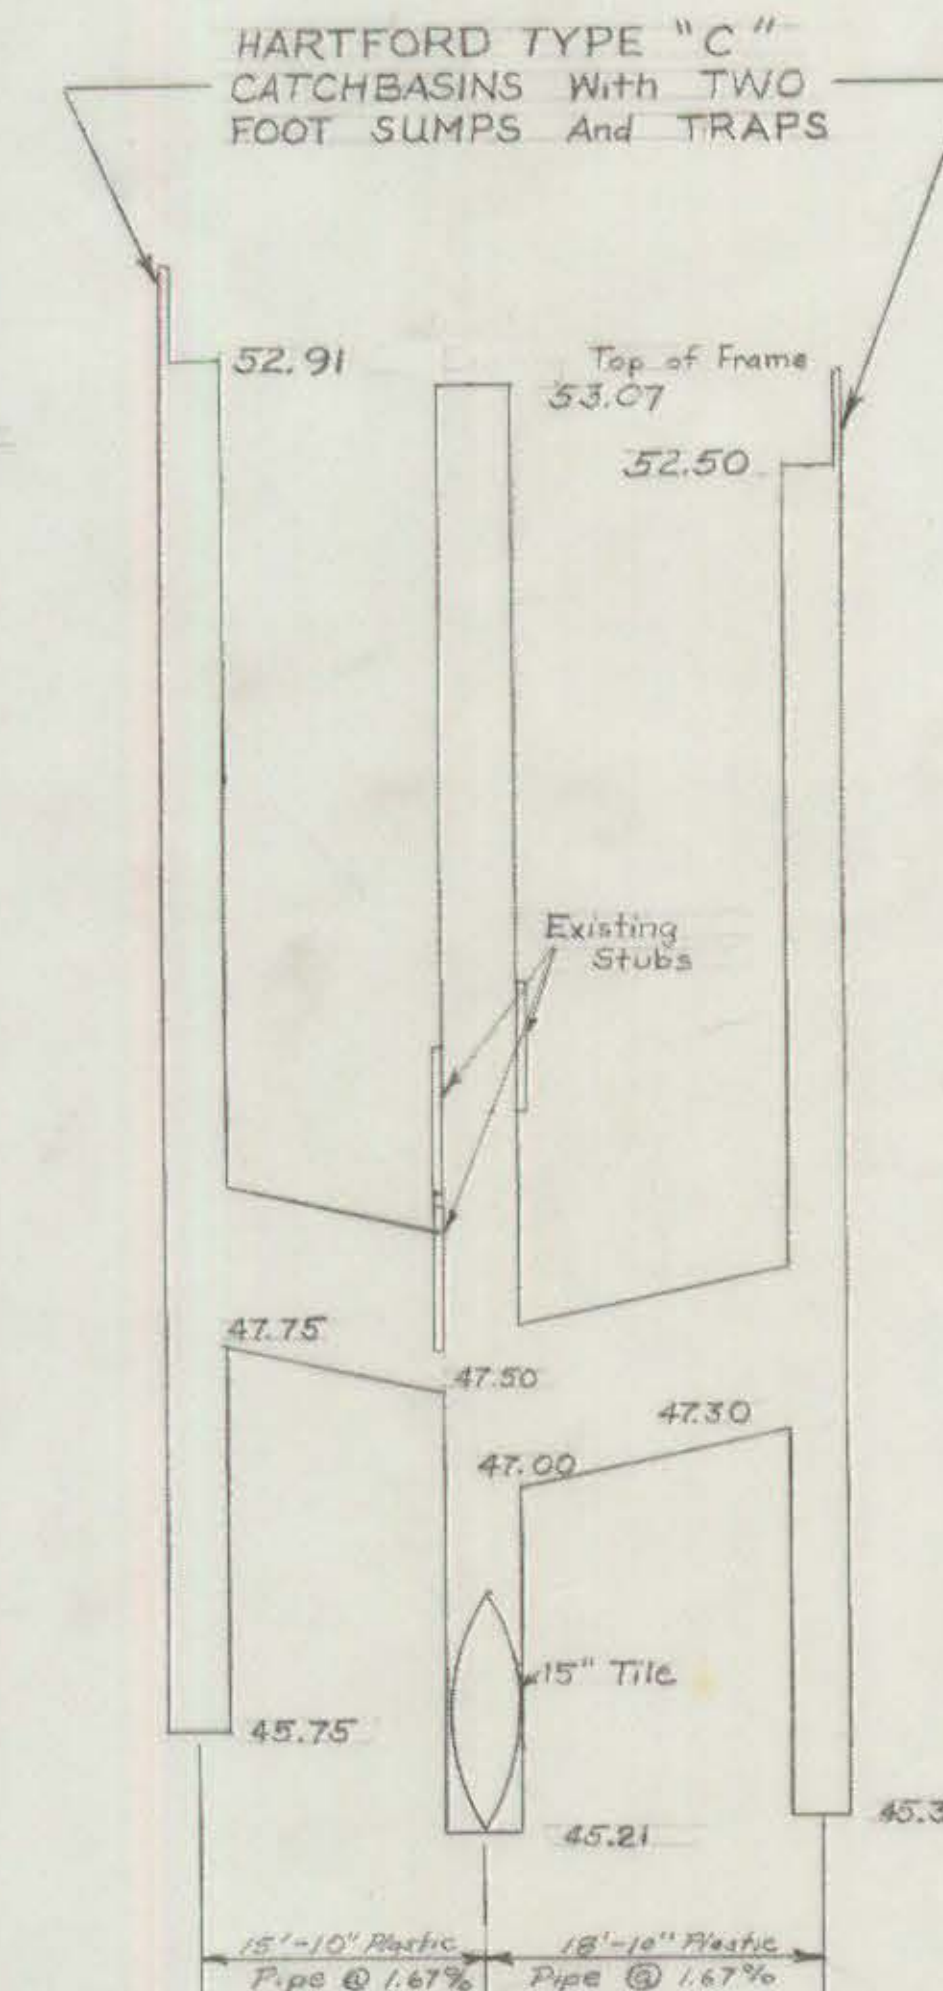


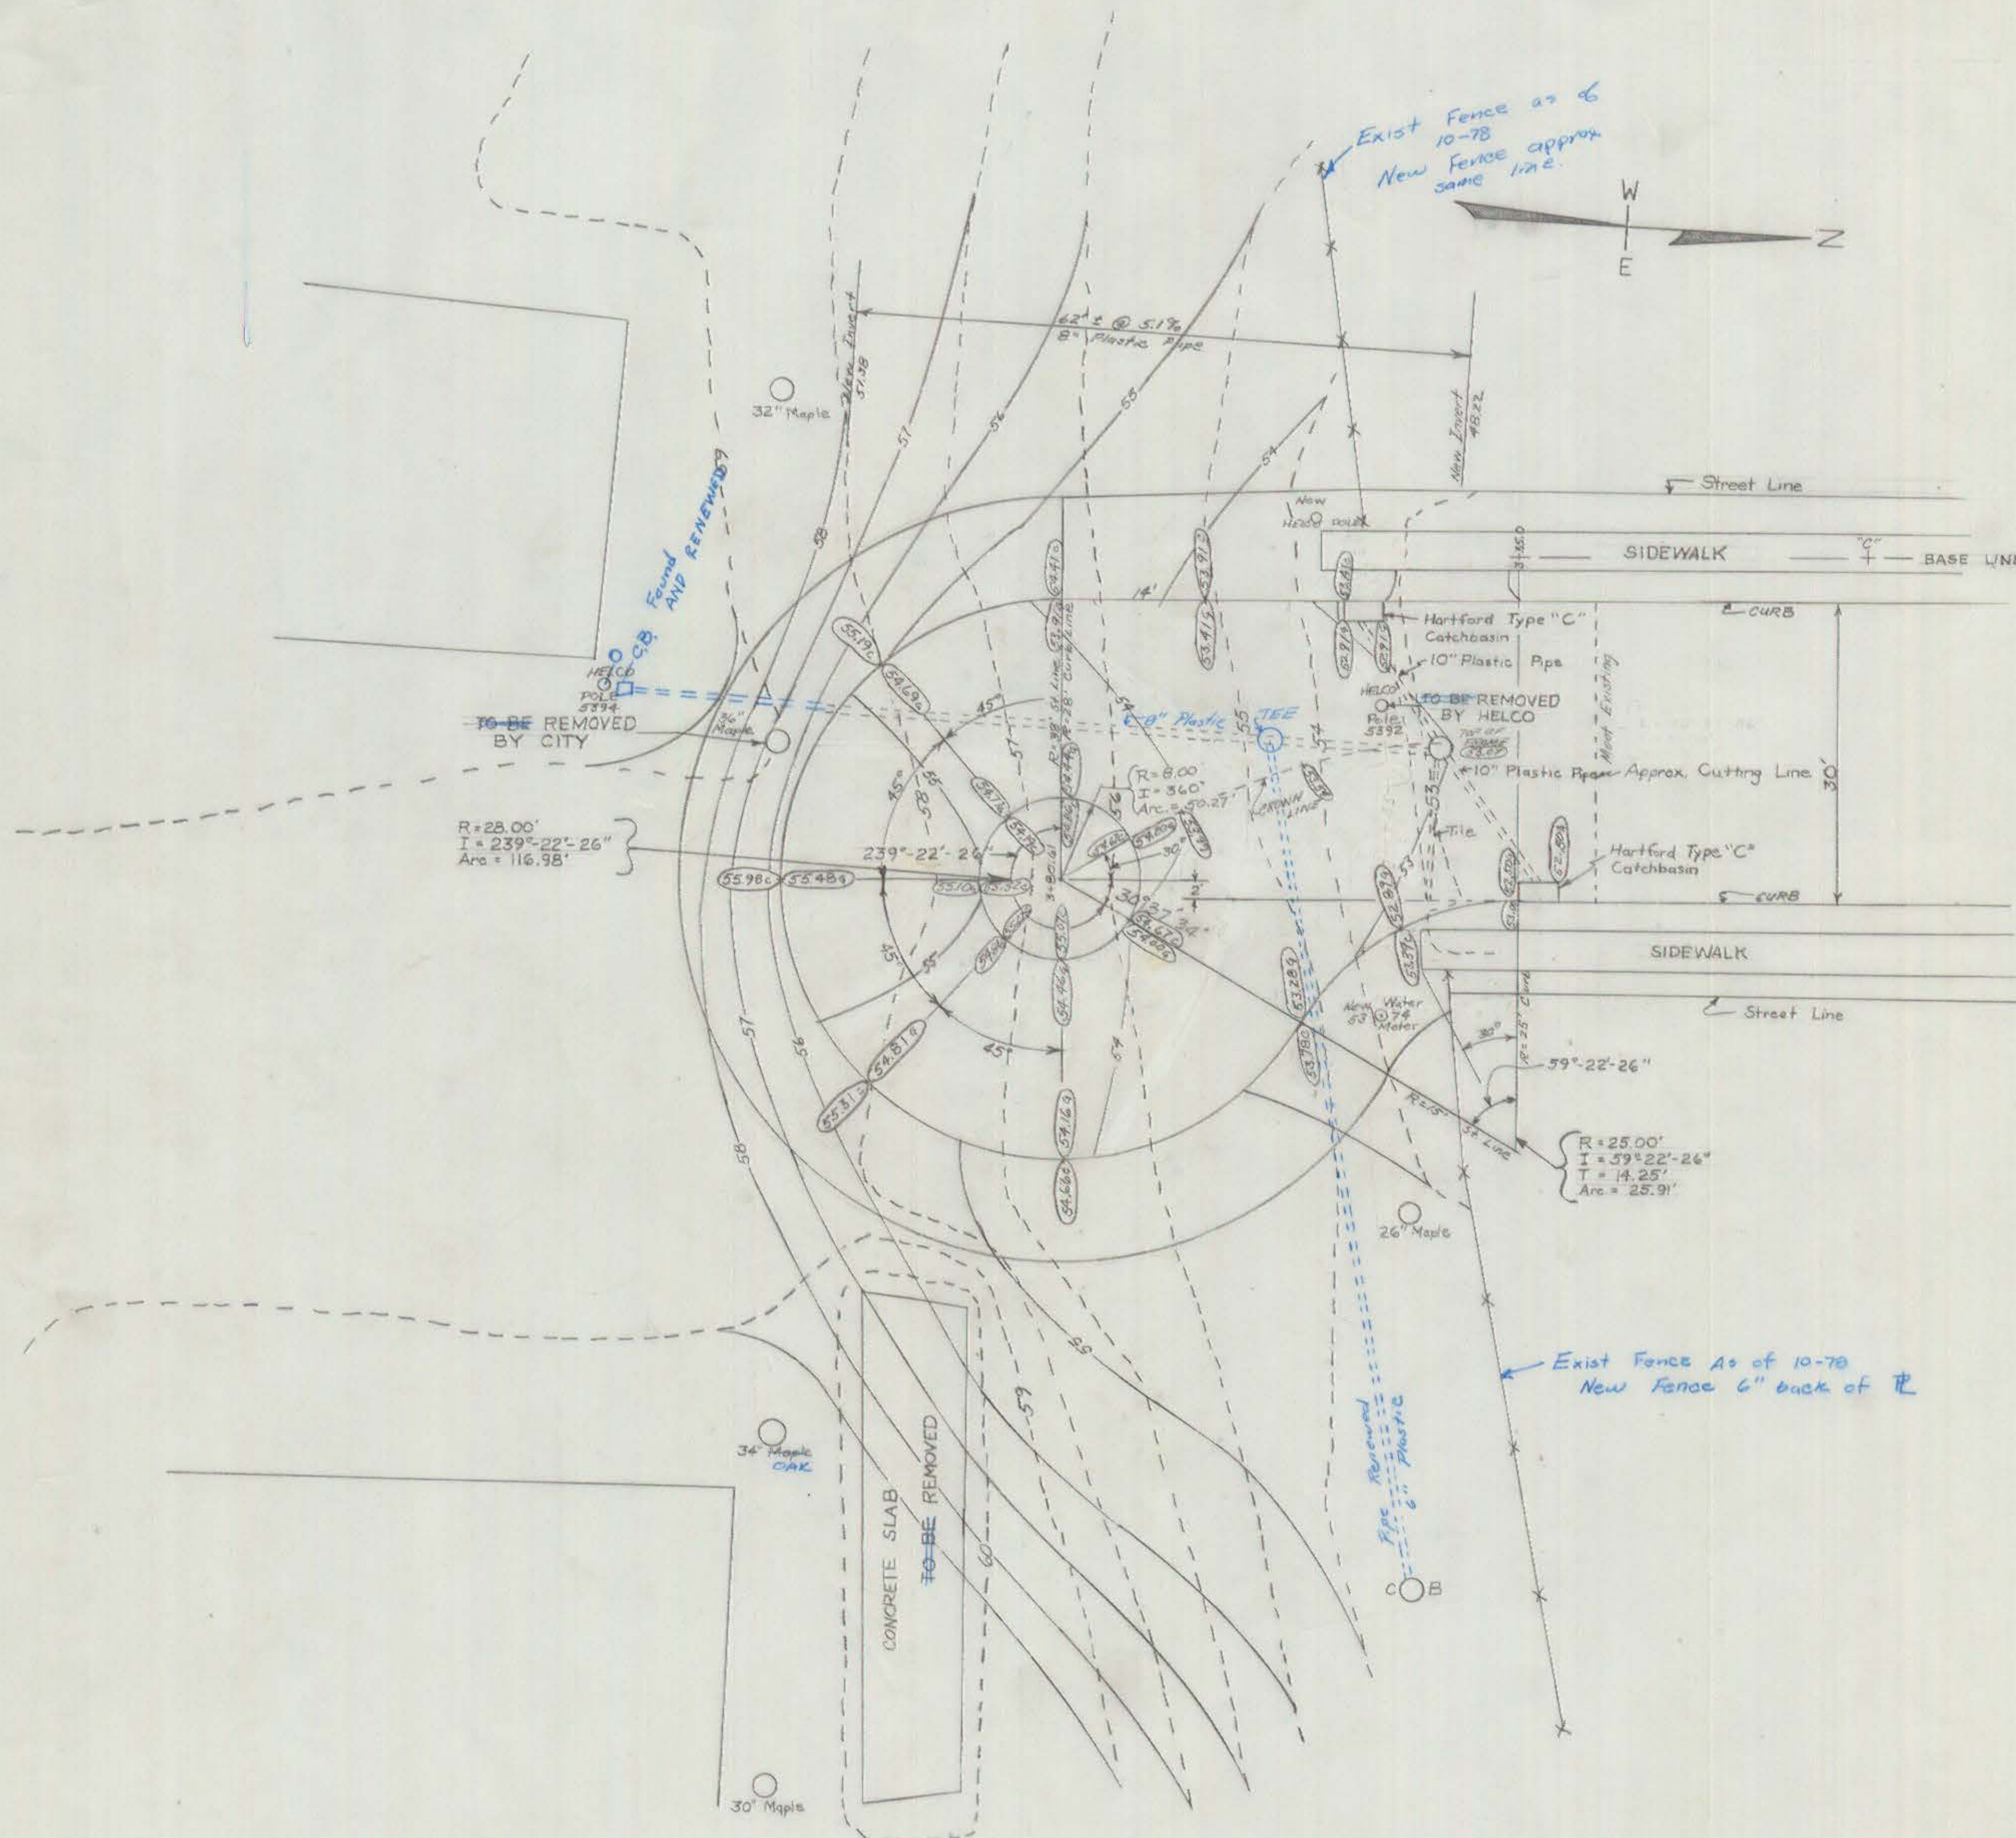

NOTE:
MEET EXISTING CURB FOR LINE
AND GRADE

NOTEBOOK 876/62

-- 100 -- Existing Contours
--- 100 --- Proposed Contours (100.00)

CITY OF HARTFORD, CONNECTICUT
DEPARTMENT OF PUBLIC WORKS
BUREAU OF ENGINEERING SERVICES

COLUMBIA ST. CUL-DE-SAC

Revised: June 1978 W.G.W.
Revised: AS BUILT W.G.W.

SUBMITTED <i>Gregory L. [Signature]</i> DIVISION ENGINEER	RECOMMENDED <i>Russell E. [Signature]</i> CHIEF OF ENG. SERV.	APPROVED ASST. DIR. & CITY ENG.
DRAWN W.G.W.	SCALE 1" = 10'	DAYBOOK NO. 010643
CHECKED		DATE MARCH 1978