
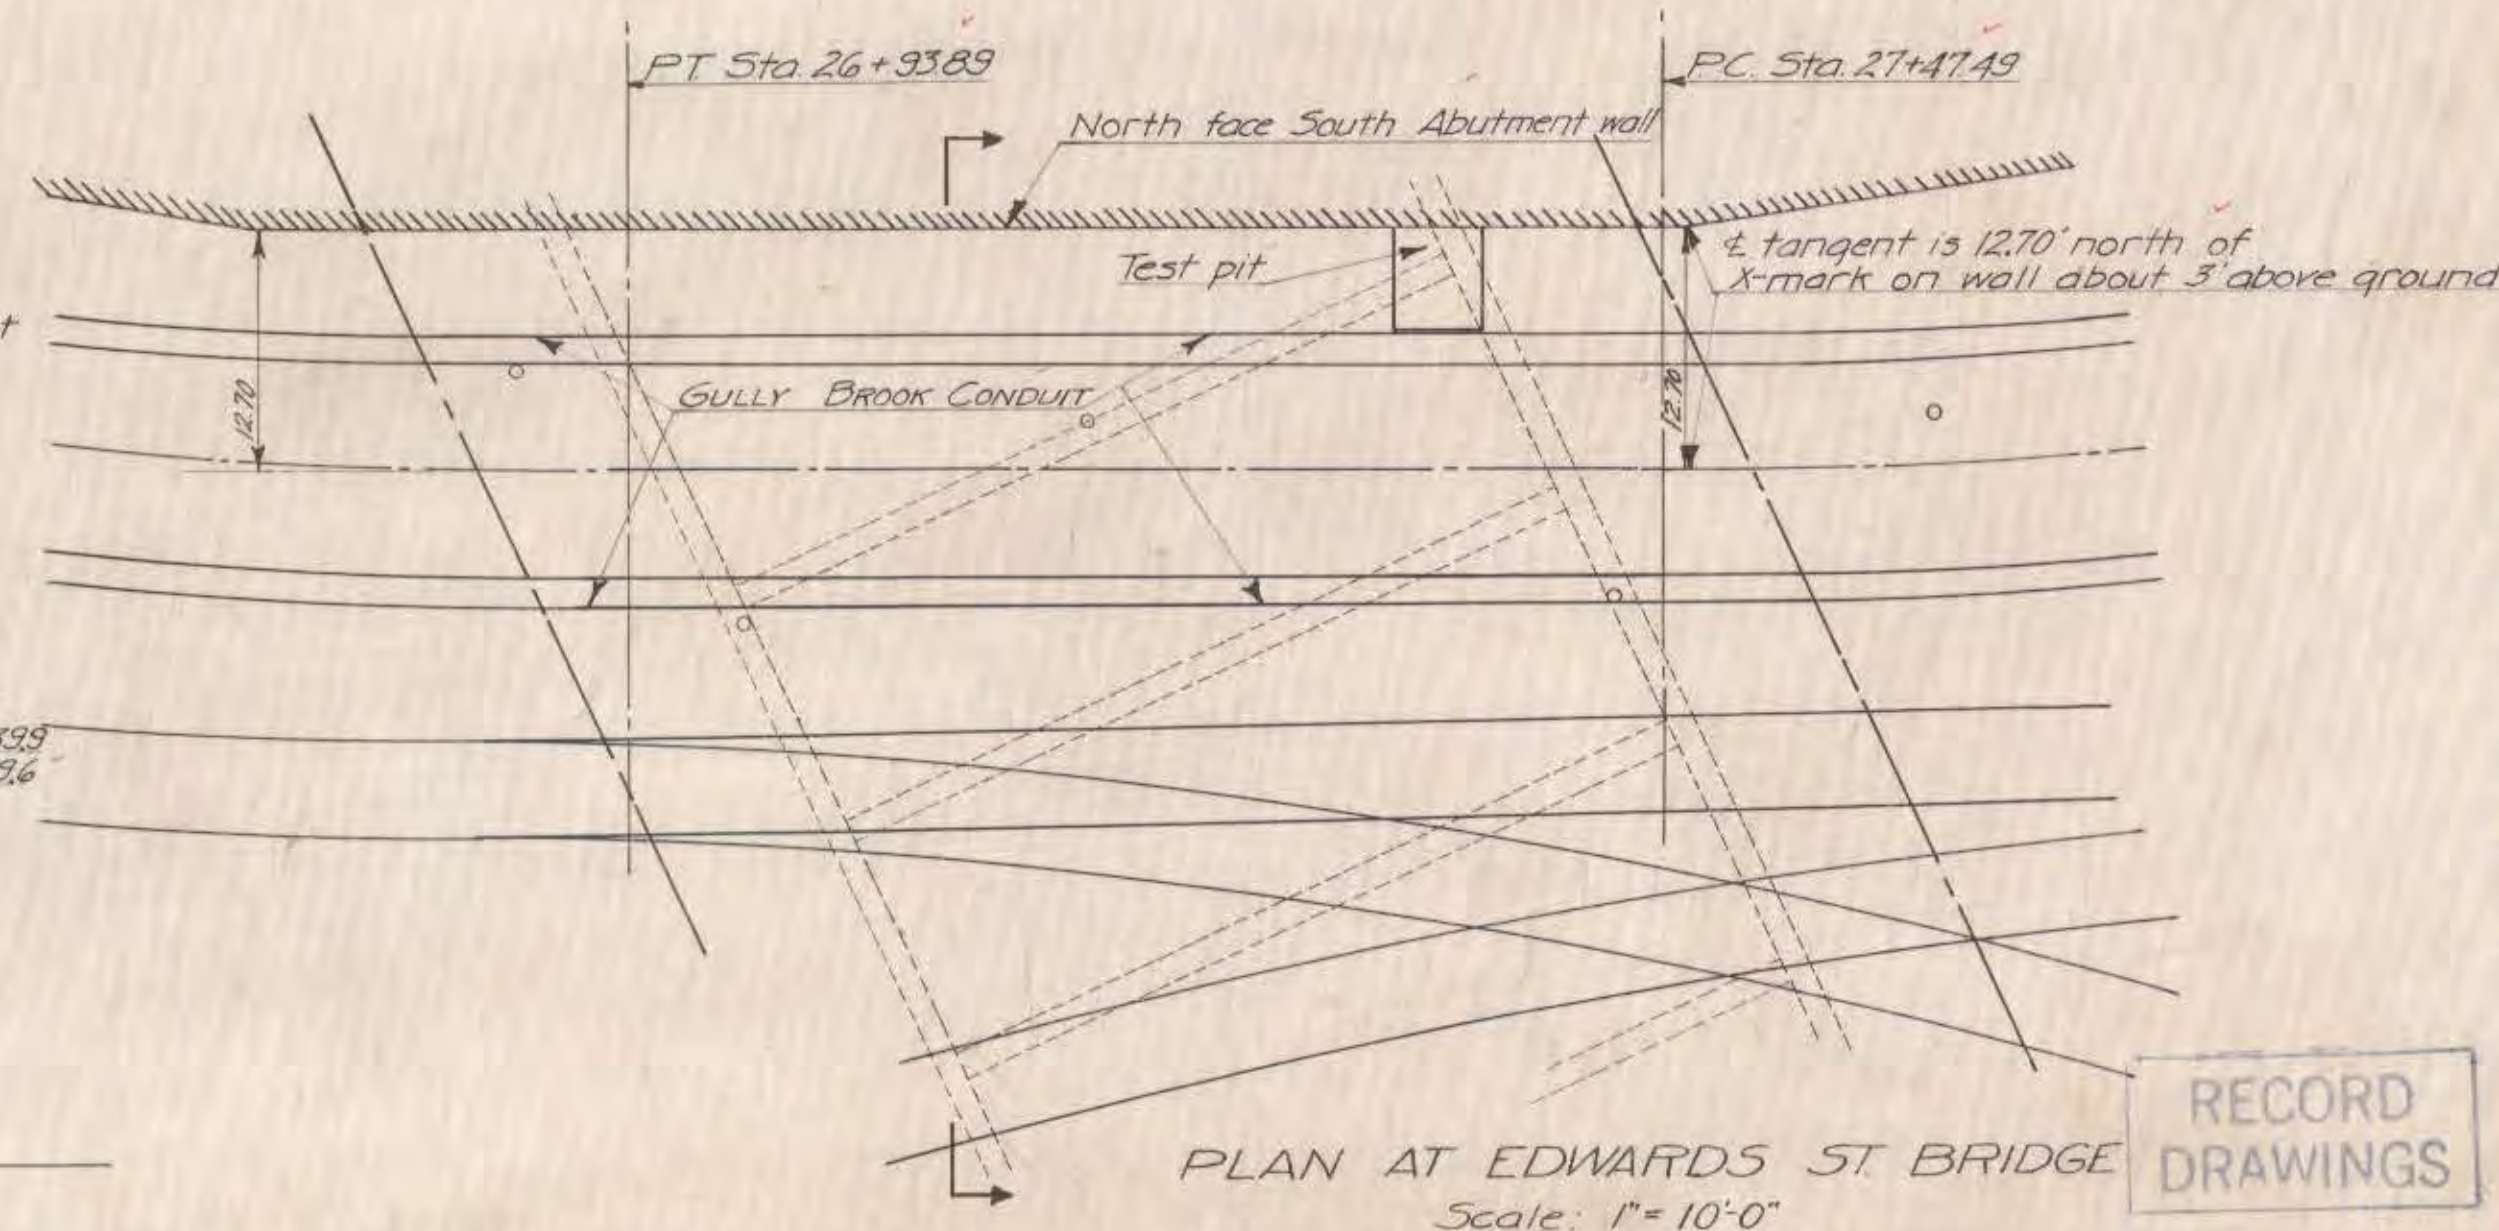


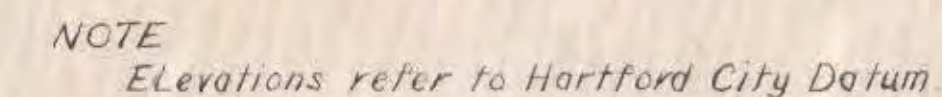

		123145	As built revisions			
⚠	9-4-43	Conduit Roof lowered 1ft.		Aug	COMP.	280
KEY	DATE	REVISION (indicated by ⚠)			REVBY	CHK. BY AP BY
CONNECTICUT RIVER FLOOD CONTROL GULLY BROOK CONDUIT HARTFORD CONN. PLAN AND PROFILE FROM CHURCH STREET TO EDWARDS STREET STA. 19 + 17.68 TO STA. 28 + 37.68						
PARK RIVER				CONNECTICUT		
IN 9 SHEETS				SCALE AS SHOWN		SHEET NO. 4
U.S. ENGINEER OFFICE, PROVIDENCE, R.I.,						JULY, 1943
REVIEWED: <i>E. M. Vine</i> ENGINEER		APPROVAL RECOMMENDED: <i>E. M. Burns</i> PRINCIPAL ENGINEER CHIEF, F.C. PLANNING DIV.		APPROVED: <i>W. G. D.</i> LT. COL. CORPS OF ENGINEERS DISTRICT ENGINEER		
BASIC DESIGN BY THE CITY OF HARTFORD		DRAWN: W.G.D. CHECKED: W.G.D. THROU: A.W.S.		FILE NO. CT-4-3152		