


SCHOOL STREET

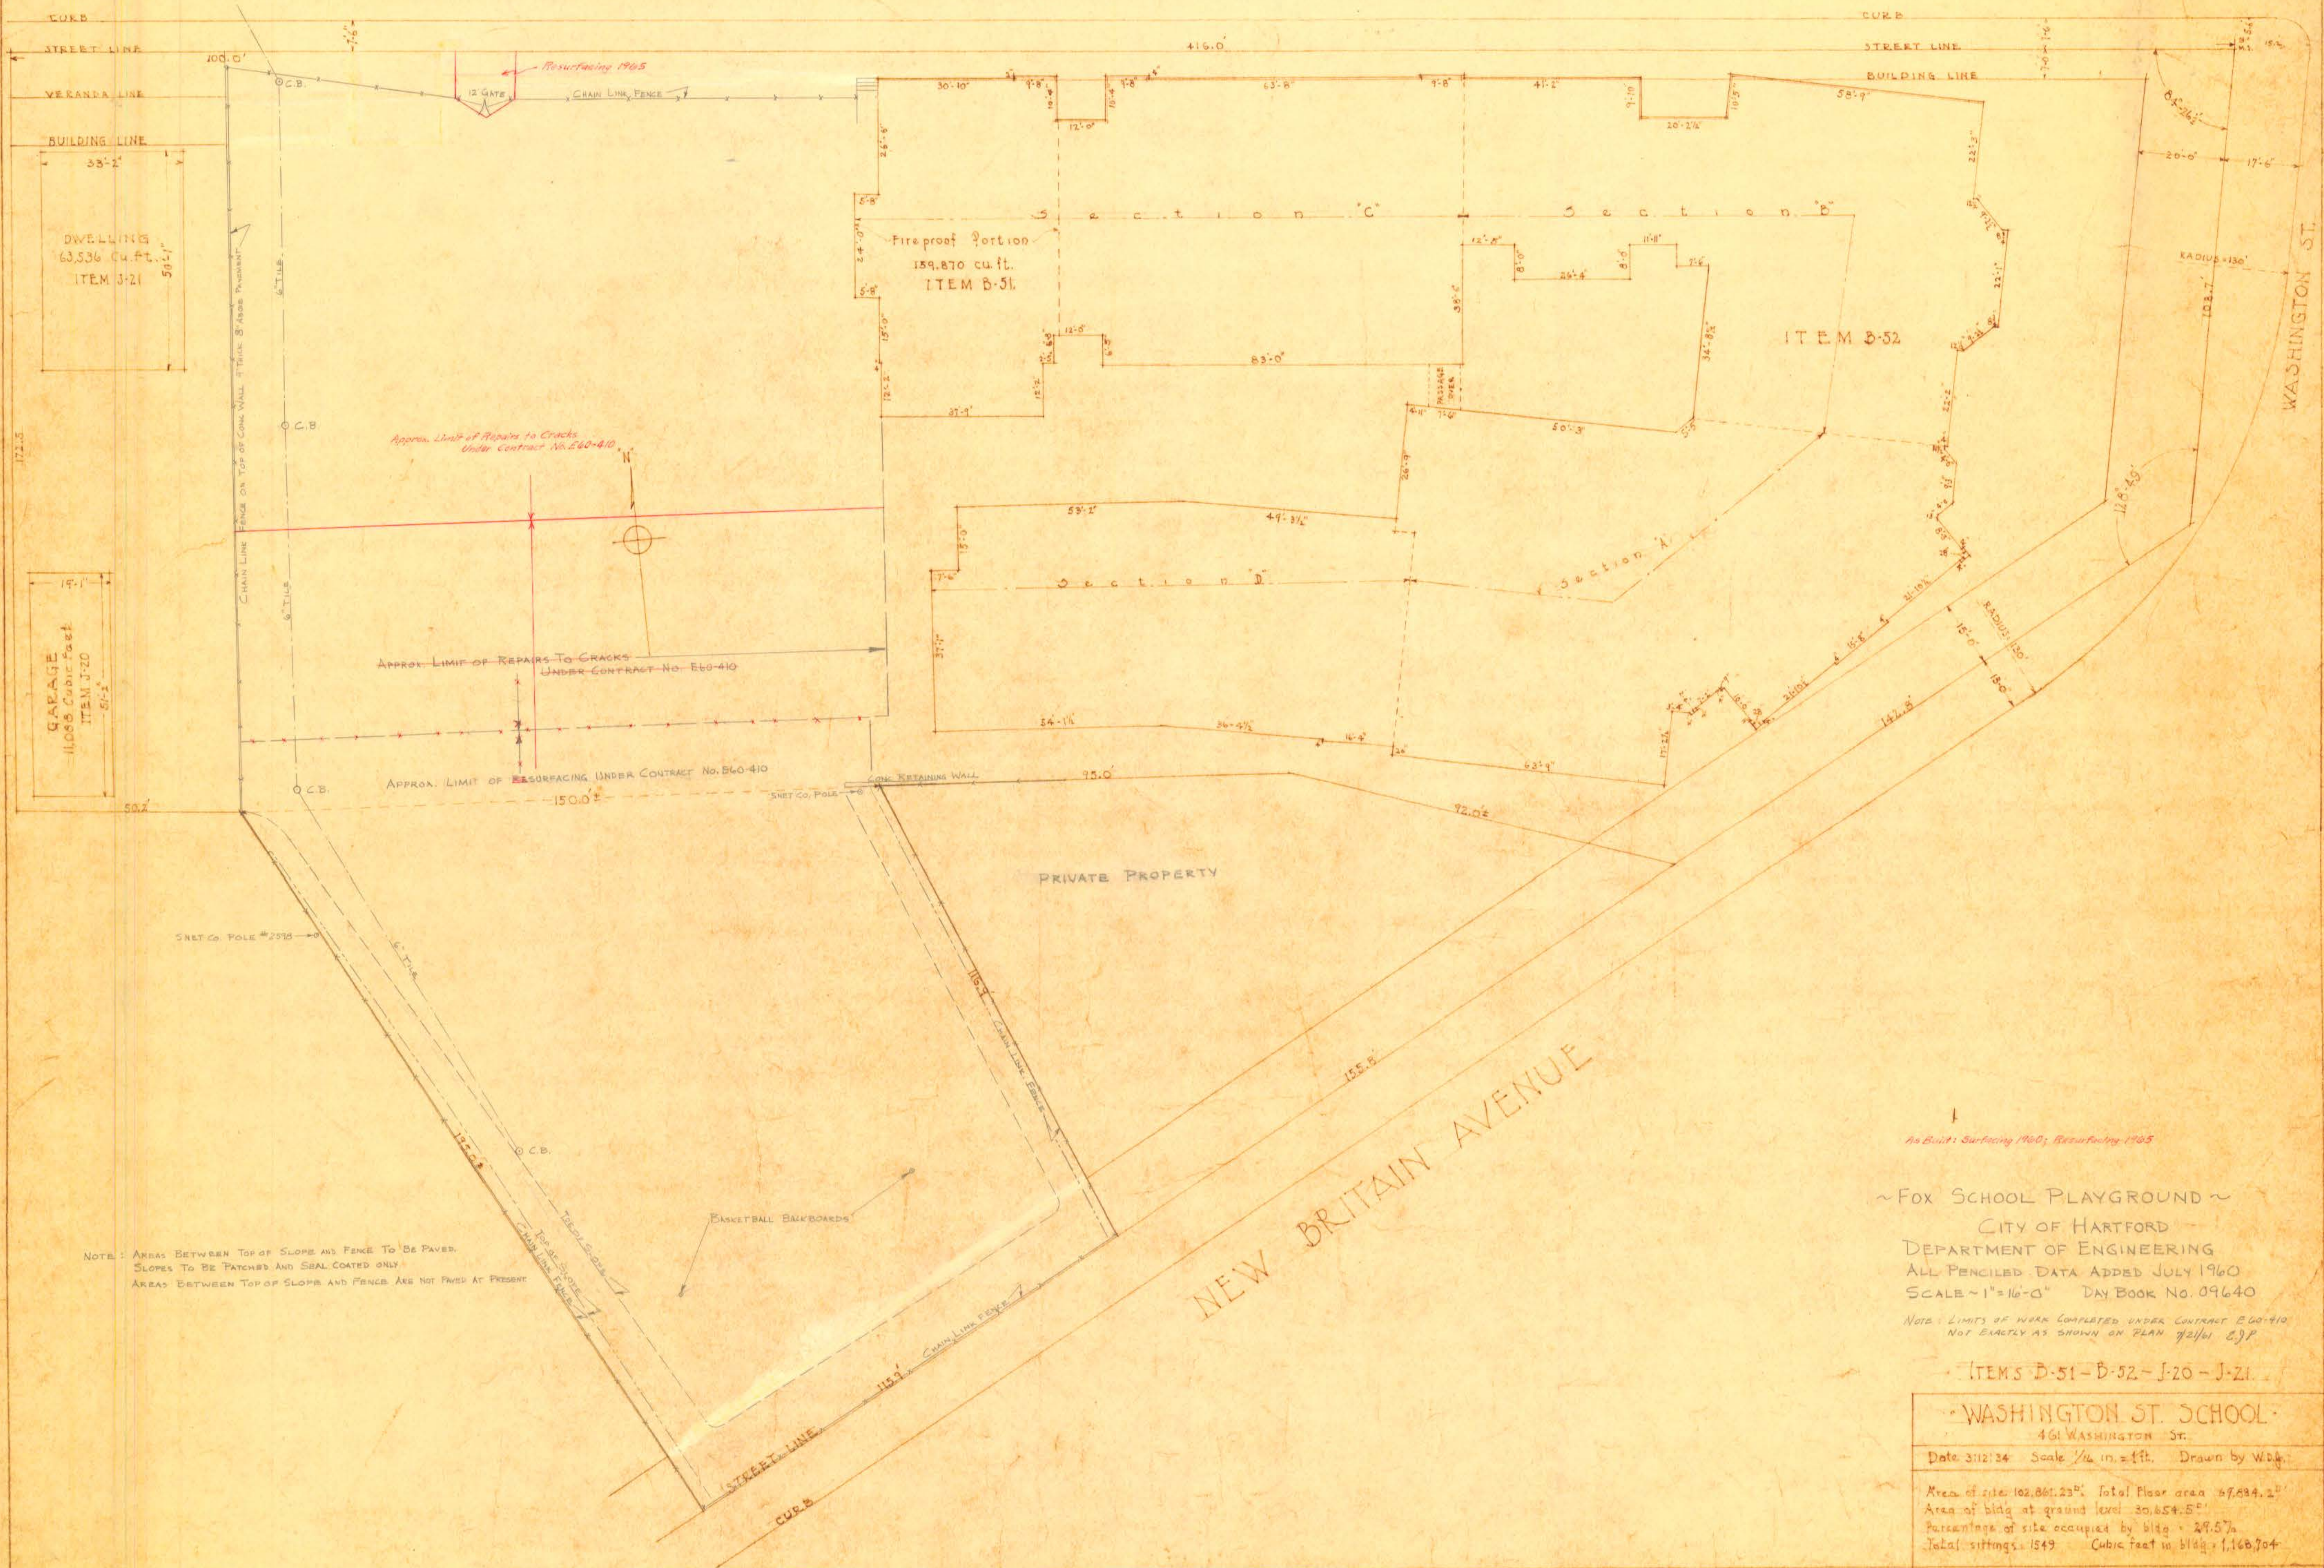

NOTE: AREAS BETWEEN TOP OF SLOPE AND FENCE TO BE PAVED.
SLOPES TO BE PATCHED AND SEAL COATED ONLY.
AREAS BETWEEN TOP OF SLOPE AND FENCE ARE NOT PAVED AT PRESENT.

As Built: Surfacing 1960; Resurfacing 1965

~ Fox School Playground ~

CITY OF HARTFORD
DEPARTMENT OF ENGINEERING
ALL PENCILED DATA ADDED JULY 1960
SCALE 1" = 16'-0" DAY BOOK NO. 09640

NOTE: LIMITS OF WORK COMPLETED UNDER CONTRACT E60-410
NOT EXACTLY AS SHOWN ON PLAN 7/21/61 EJP

ITEMS D-51-D-52-J-20-J-21

WASHINGTON ST. SCHOOL
461 Washington St.

Date 3/12/34 Scale 1/4" = 1 ft. Drawn by W.B.

Area of site 102,861.25^{sq} ft. Total floor area 57,884.2^{sq} ft.
Area of bldg at ground level 30,854.5^{sq} ft.
Percentage of site occupied by bldg 29.57%
Total sitings 1549 Cubic feet in bldg 1,160,704