


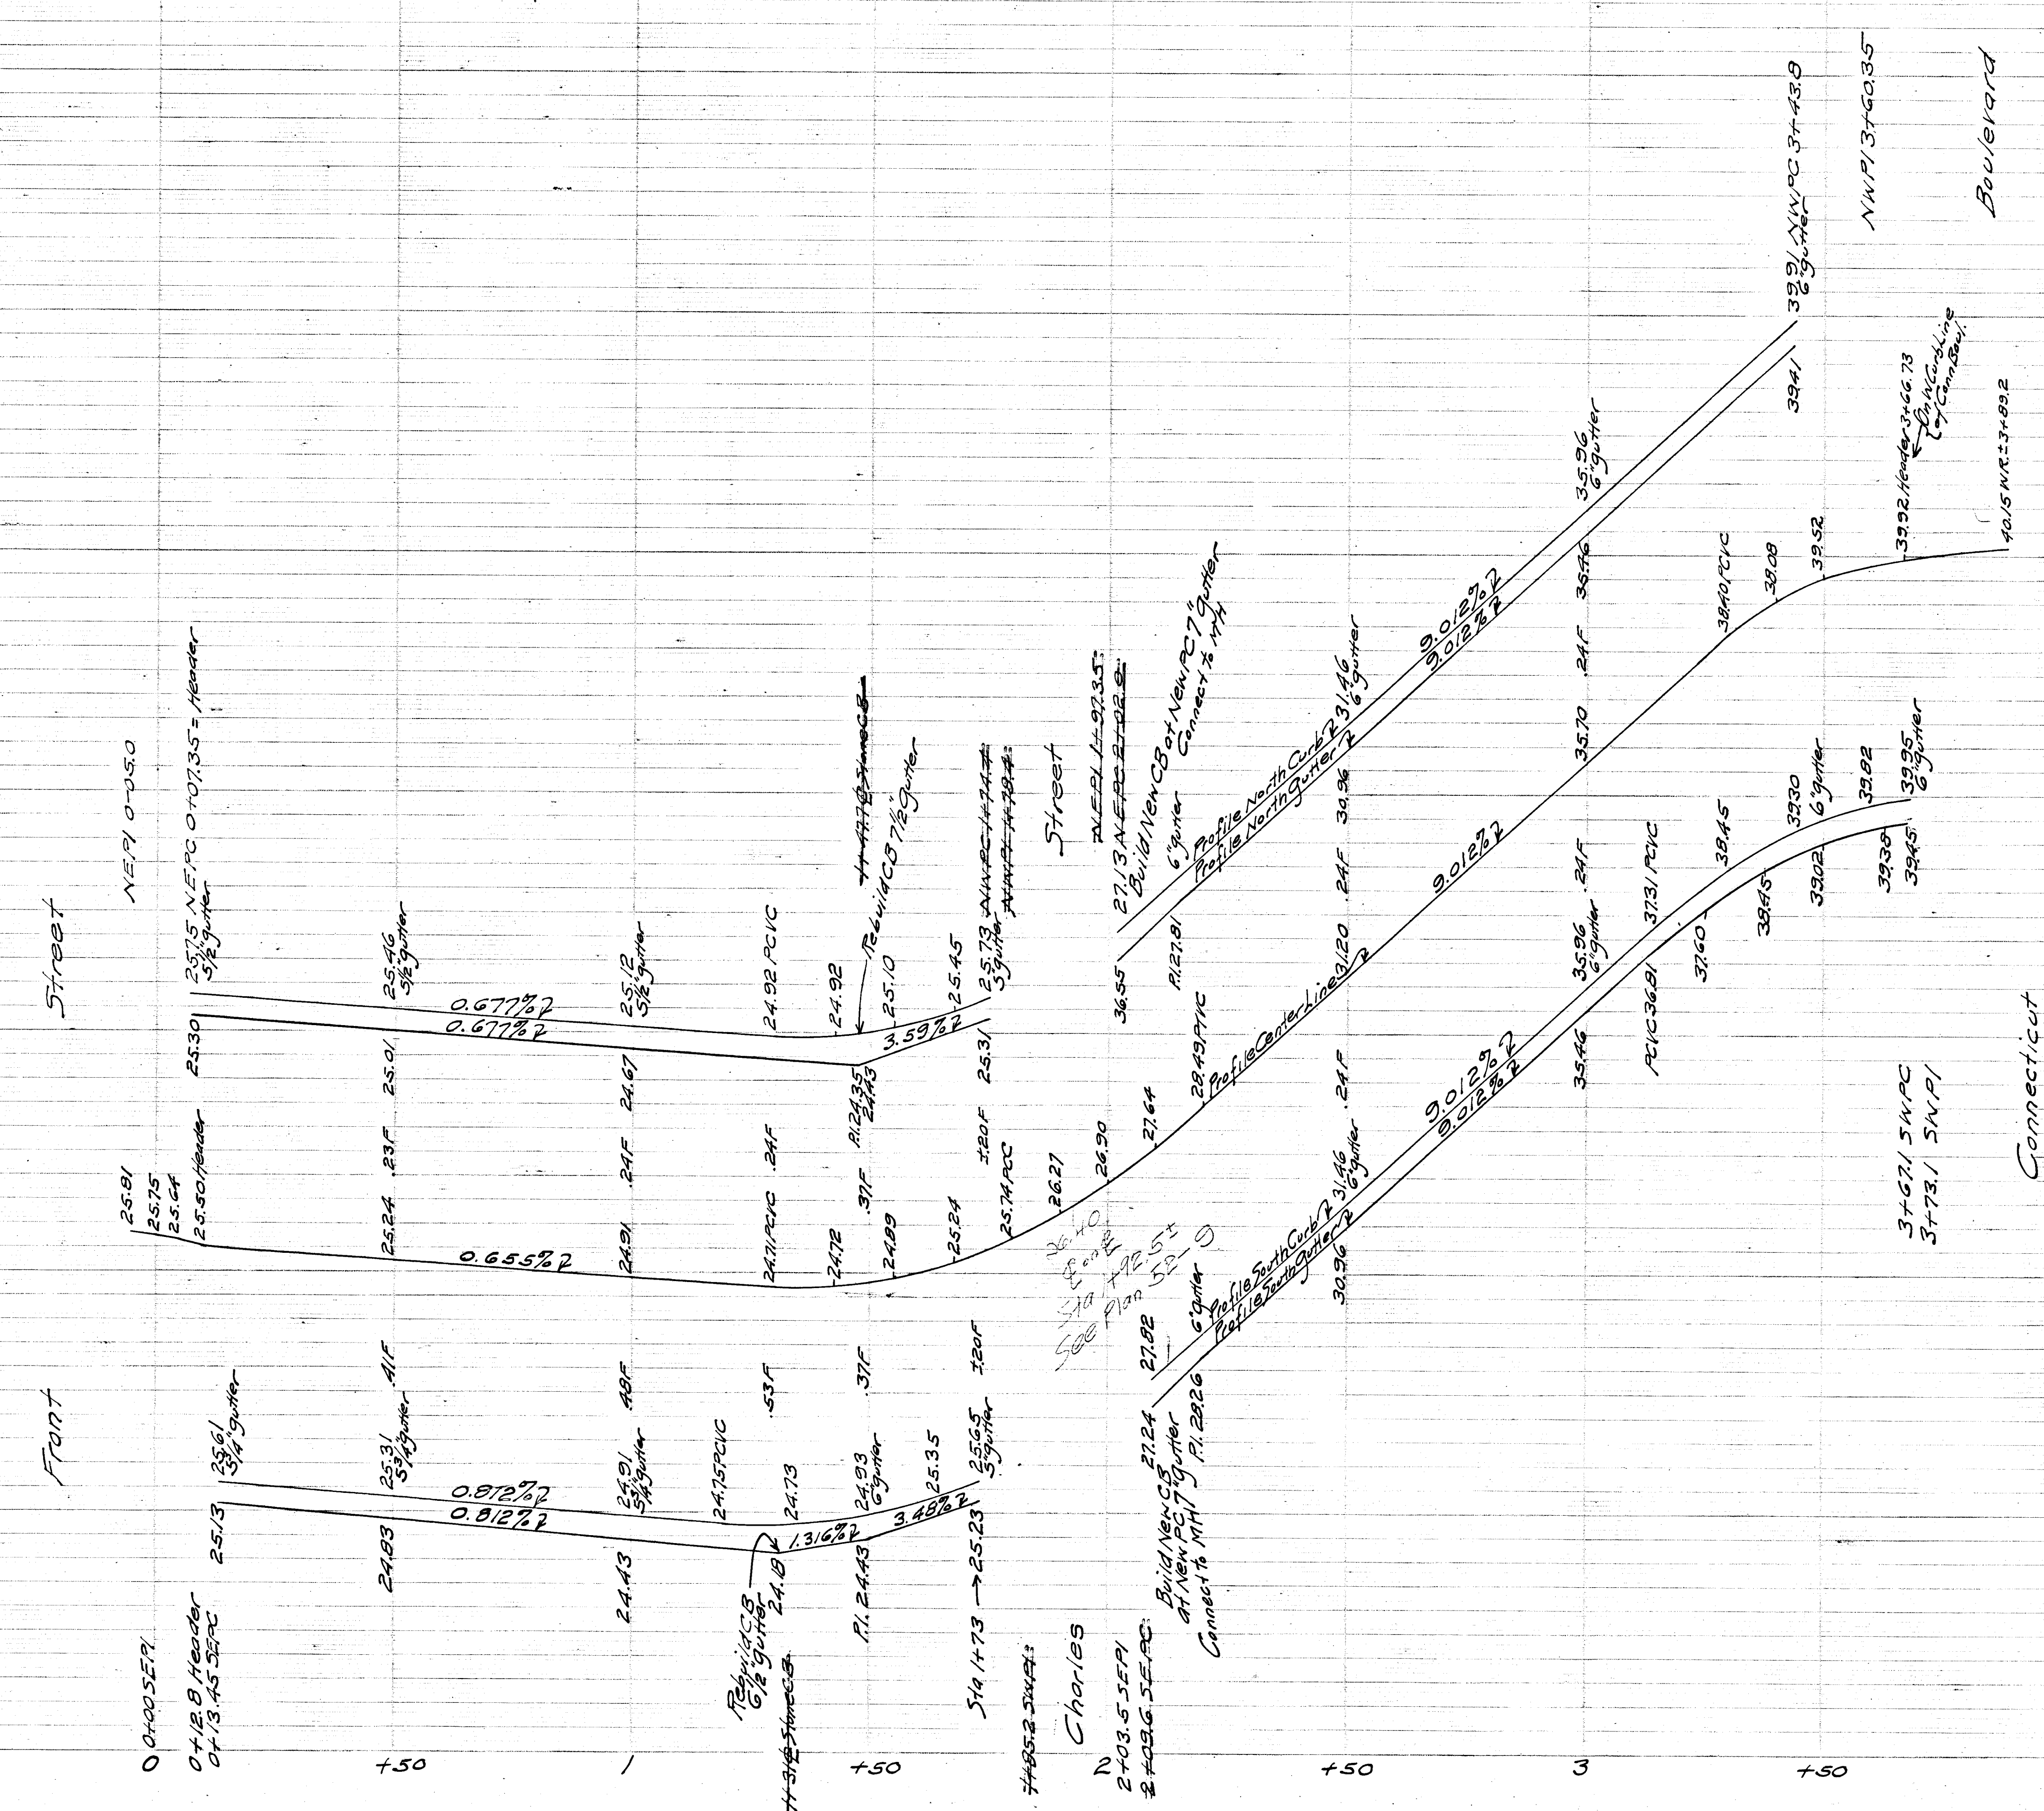

TALCOTT STREET
 FRONT STREET TO CONNECTICUT BOULEVARD
 CURB AND PAVING PROFILES
 HOR. SCALES 1" = 20'
 VER. SCALES 1" = 2'
 Note: North Side Shown in Green, South in Black
 New Grade Shown in Red
 Stations Measured on Curb Lines
 Dry Book No. 04470 Notebook 434

Department of Engineering
 Hartford, Conn.
 Feb. 1918

