


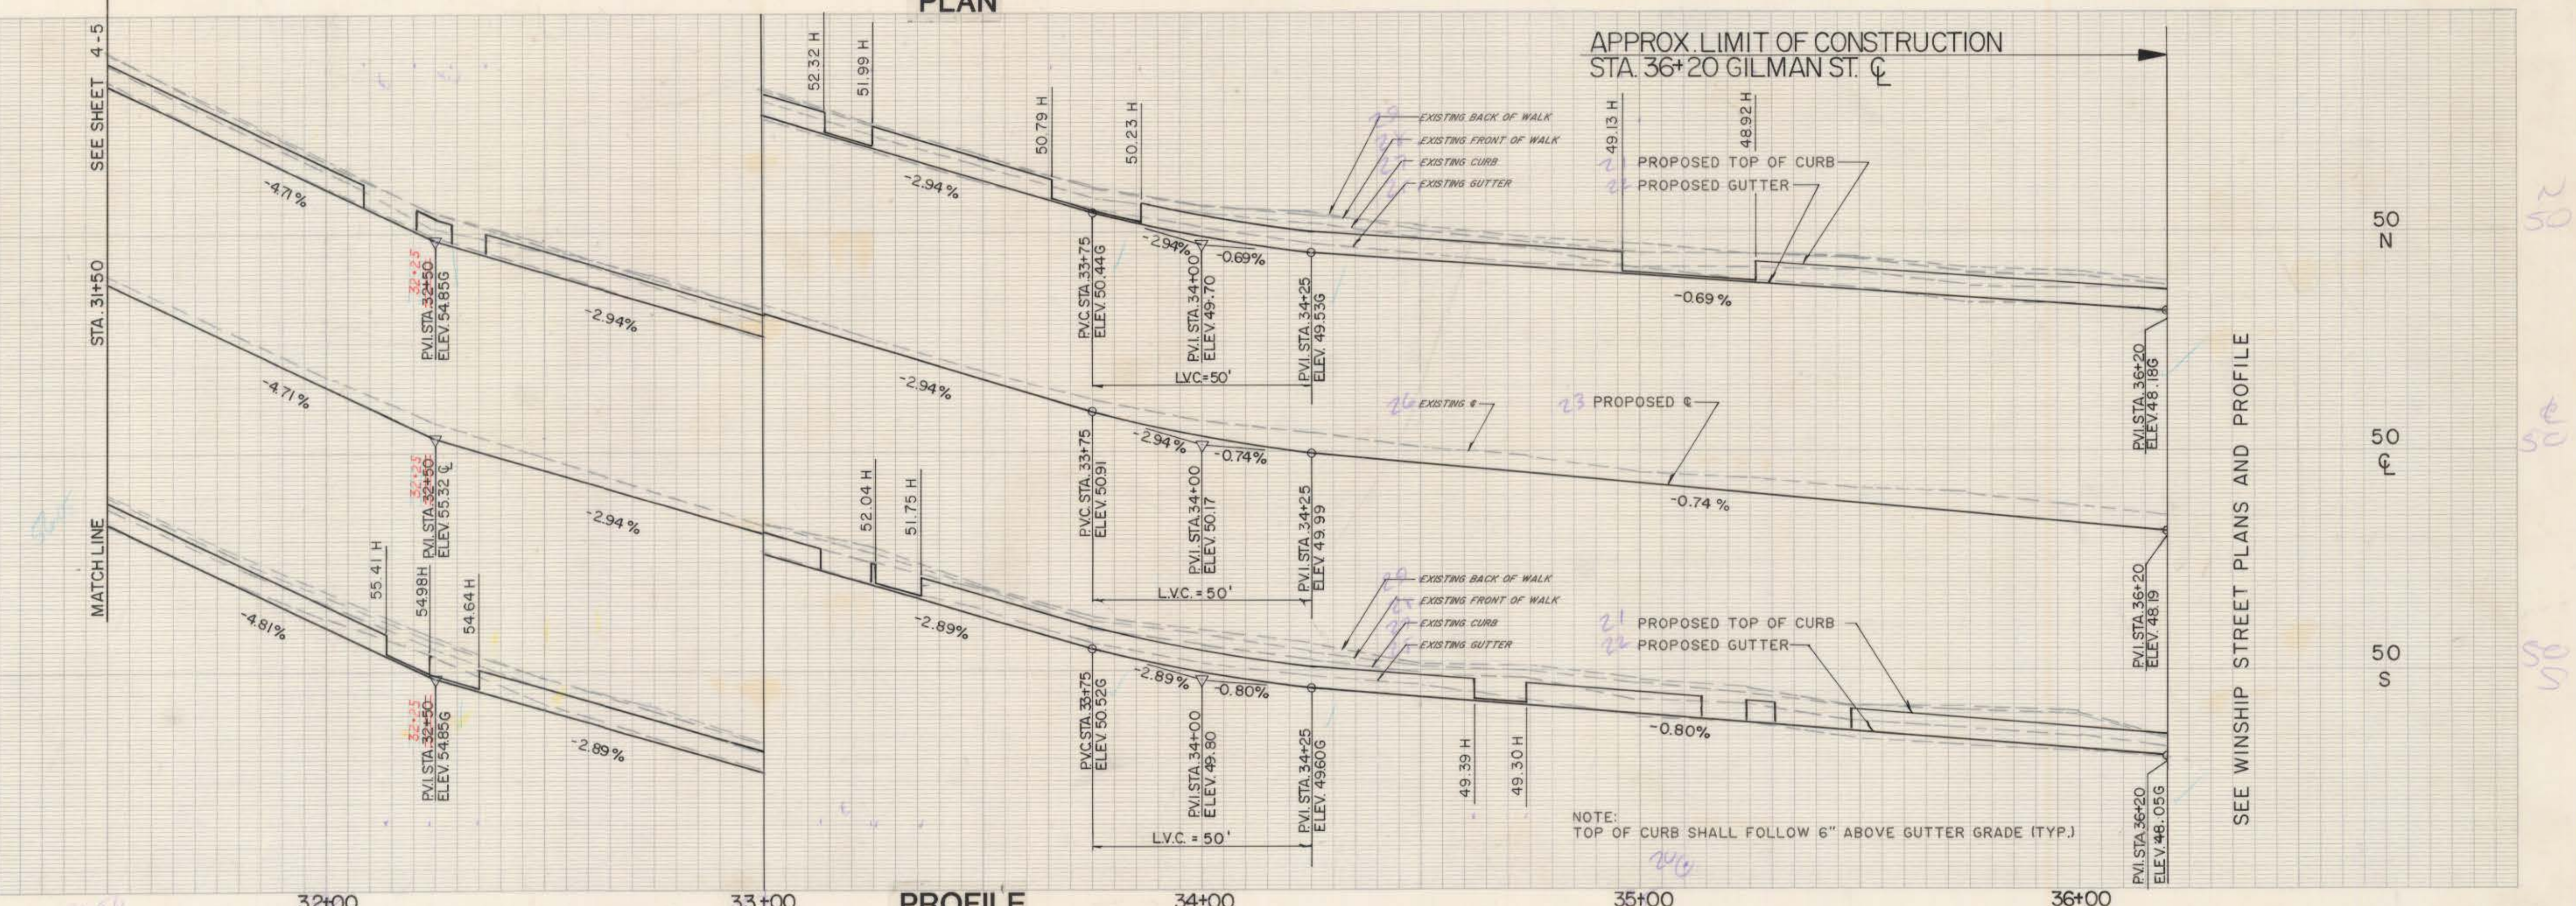

		SUPV. <i>ARW</i>		GRAPHIC SCALES		ROADWAY RECONSTRUCTION HARTFORD, CONNECTICUT				Hayden Wegman Consulting Engineers		CITY OF HARTFORD, CONNECTICUT DEPARTMENT OF PUBLIC WORKS BUREAU OF ENGINEERING SERVICES		GILMAN STREET		STA. 31+50 TO STA. 36+20		PLAN AND PROFILE		SHEET 5-5	
		DESIGN <i>MOH/LAC</i>		HORIZ. 1" = 20'																	
		DRAWN <i>21</i>		VERT. 1" = 2'																	
NO. DATE		CHECKED BY <i>MOH</i> AS-BUILT DRAWN BY <i>RUE</i>		CHECKED <i>JAC</i>								DRAWN		SCALE		DAYBOOK NO. 010947					
REVISIONS		DESCRIPTION		DATE <i>6/3/85</i>								CHECKED				DATE		Contract No. E 85 - 28 Job No. - 845304			