



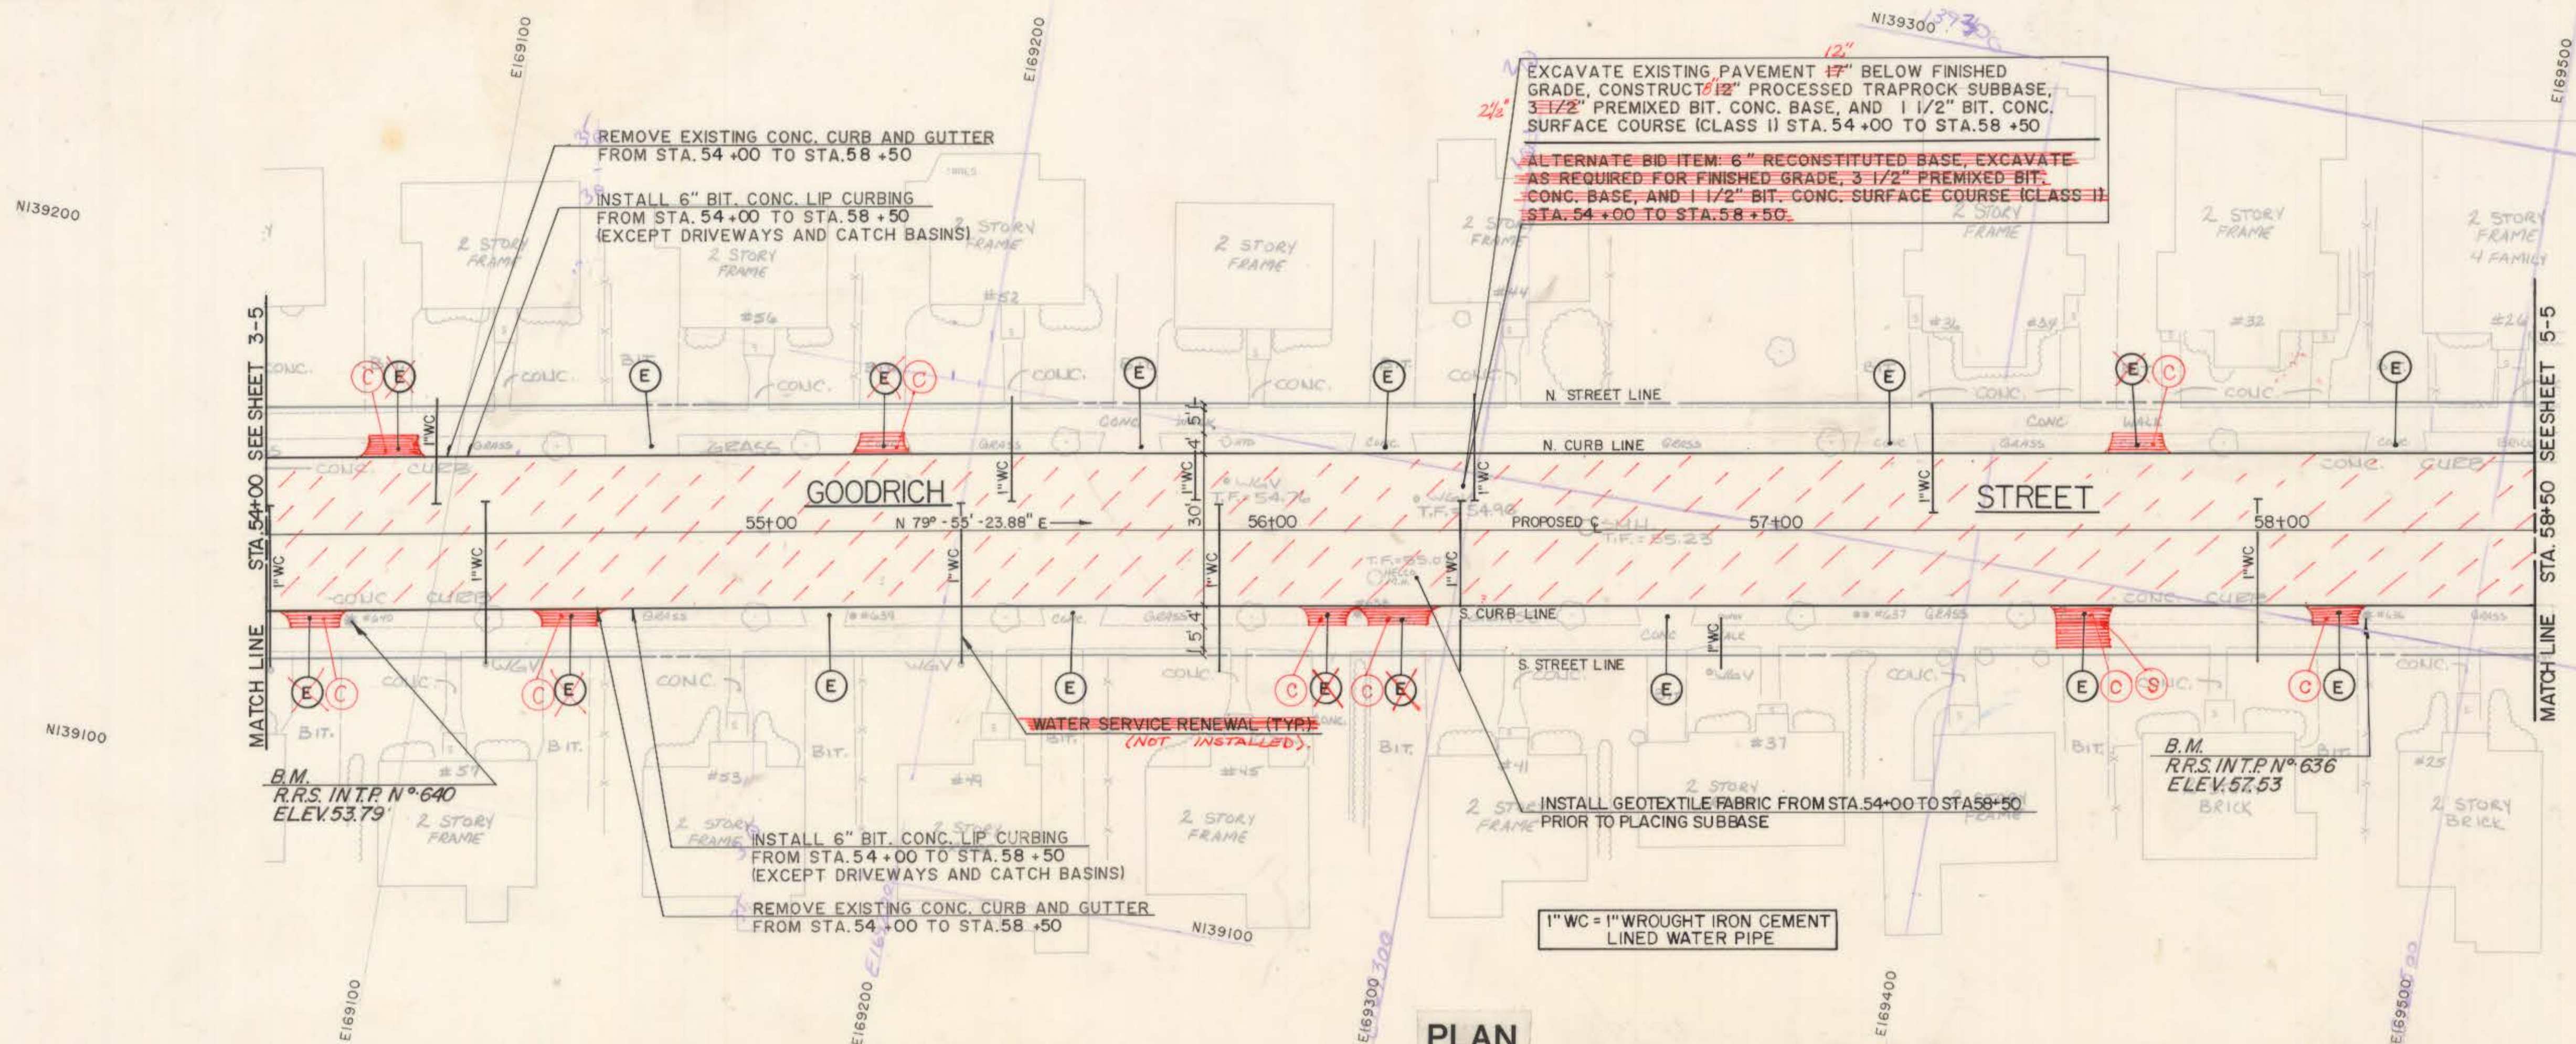

- NOTES:
- INSTALL 6" OF 6"x20" GRANITE CURB ON EACH SIDE OF CATCH BASIN WHERE INSTALLING BITUMINOUS CONCRETE LIP CURBING
 - CONSTRUCT BITUMINOUS CONCRETE DRIVEWAY RAMP
 - CONSTRUCT 8" REINFORCED CONCRETE DRIVEWAY RAMP
 - EXISTING DRIVEWAY RAMP TO REMAIN
- CALL BEFORE YOU DIG - THE CONTRACTOR IS HEREBY REMINDED THAT TITLE 16 CHAPTER 293 OF THE CONNECTICUT GENERAL STATUTES REQUIRES NOTIFICATION TO UTILITY COMPANIES OF PENDING EXCAVATION AT OR NEAR PUBLIC UTILITIES. THE CONTRACTOR SHALL CALL 1-800-922-4455 AT LEAST 48 HOURS PRIOR TO EXCAVATION.
- CONSTRUCT 8" REINFORCED CONCRETE SIDEWALK

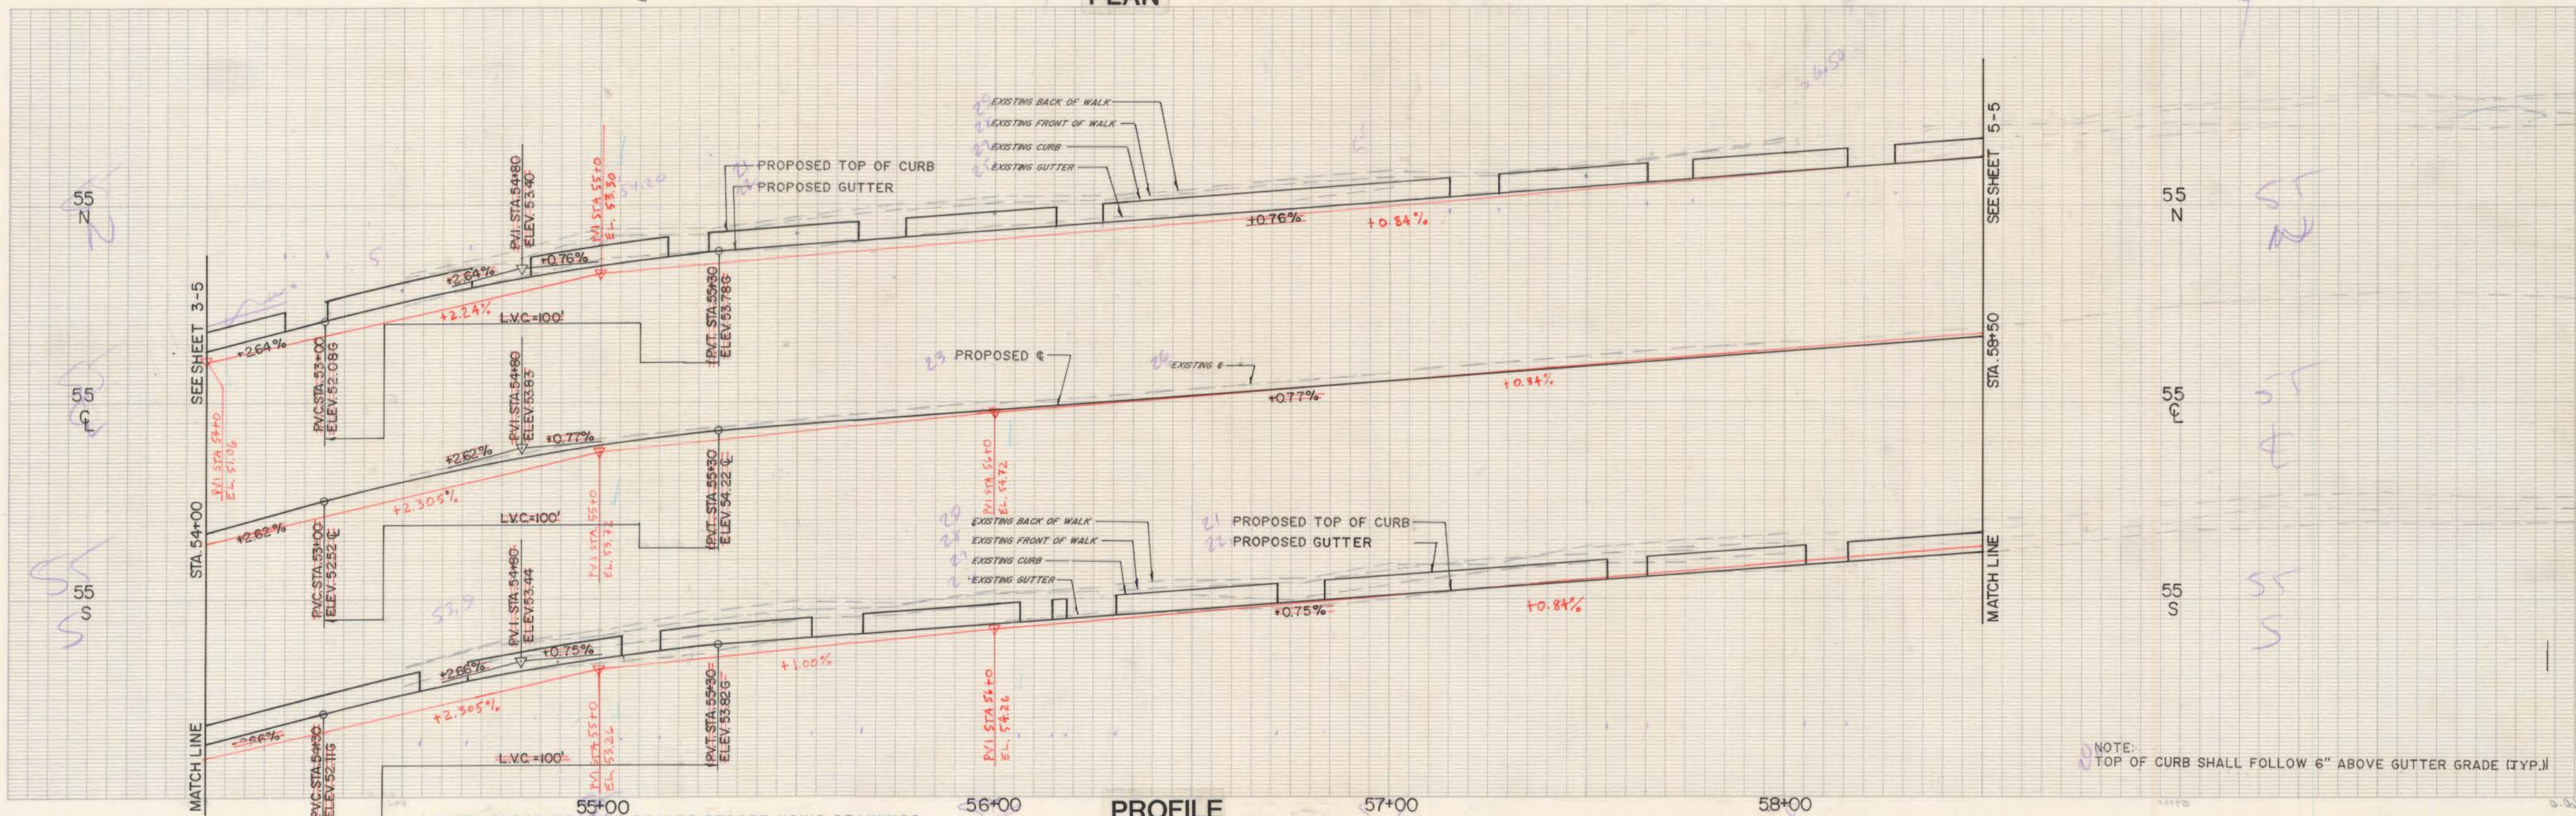

NOTE: CHECK GRAPHIC SCALES BEFORE USING DRAWINGS

SUPV. <i>APW</i> DESIGN <i>MDH/AEC</i> DRAWN <i>021</i> CHECKED <i>JAC</i> DATE <i>6/3/85</i>		GRAPHIC SCALES HORIZ. 1"=20' VERT. 1"=2'	ROADWAY RECONSTRUCTION HARTFORD, CONNECTICUT		Hayden Wegman Consulting Engineers WEST HARTFORD NEW YORK • BOSTON • BUFFALO ATLANTA • MEMPHIS	CITY OF HARTFORD, CONNECTICUT DEPARTMENT OF PUBLIC WORKS BUREAU OF ENGINEERING SERVICES	GOODRICH STREET STA. 54+00 TO STA. 58+50 PLAN AND PROFILE	SHEET 4-5
REVISIONS 1. JAN. 87 CHECKED BY JAC 2. JAN. 87 AS BUILT - CHECKED BY M.J.N.		Contract No. E85-28 Job No. 845304						