
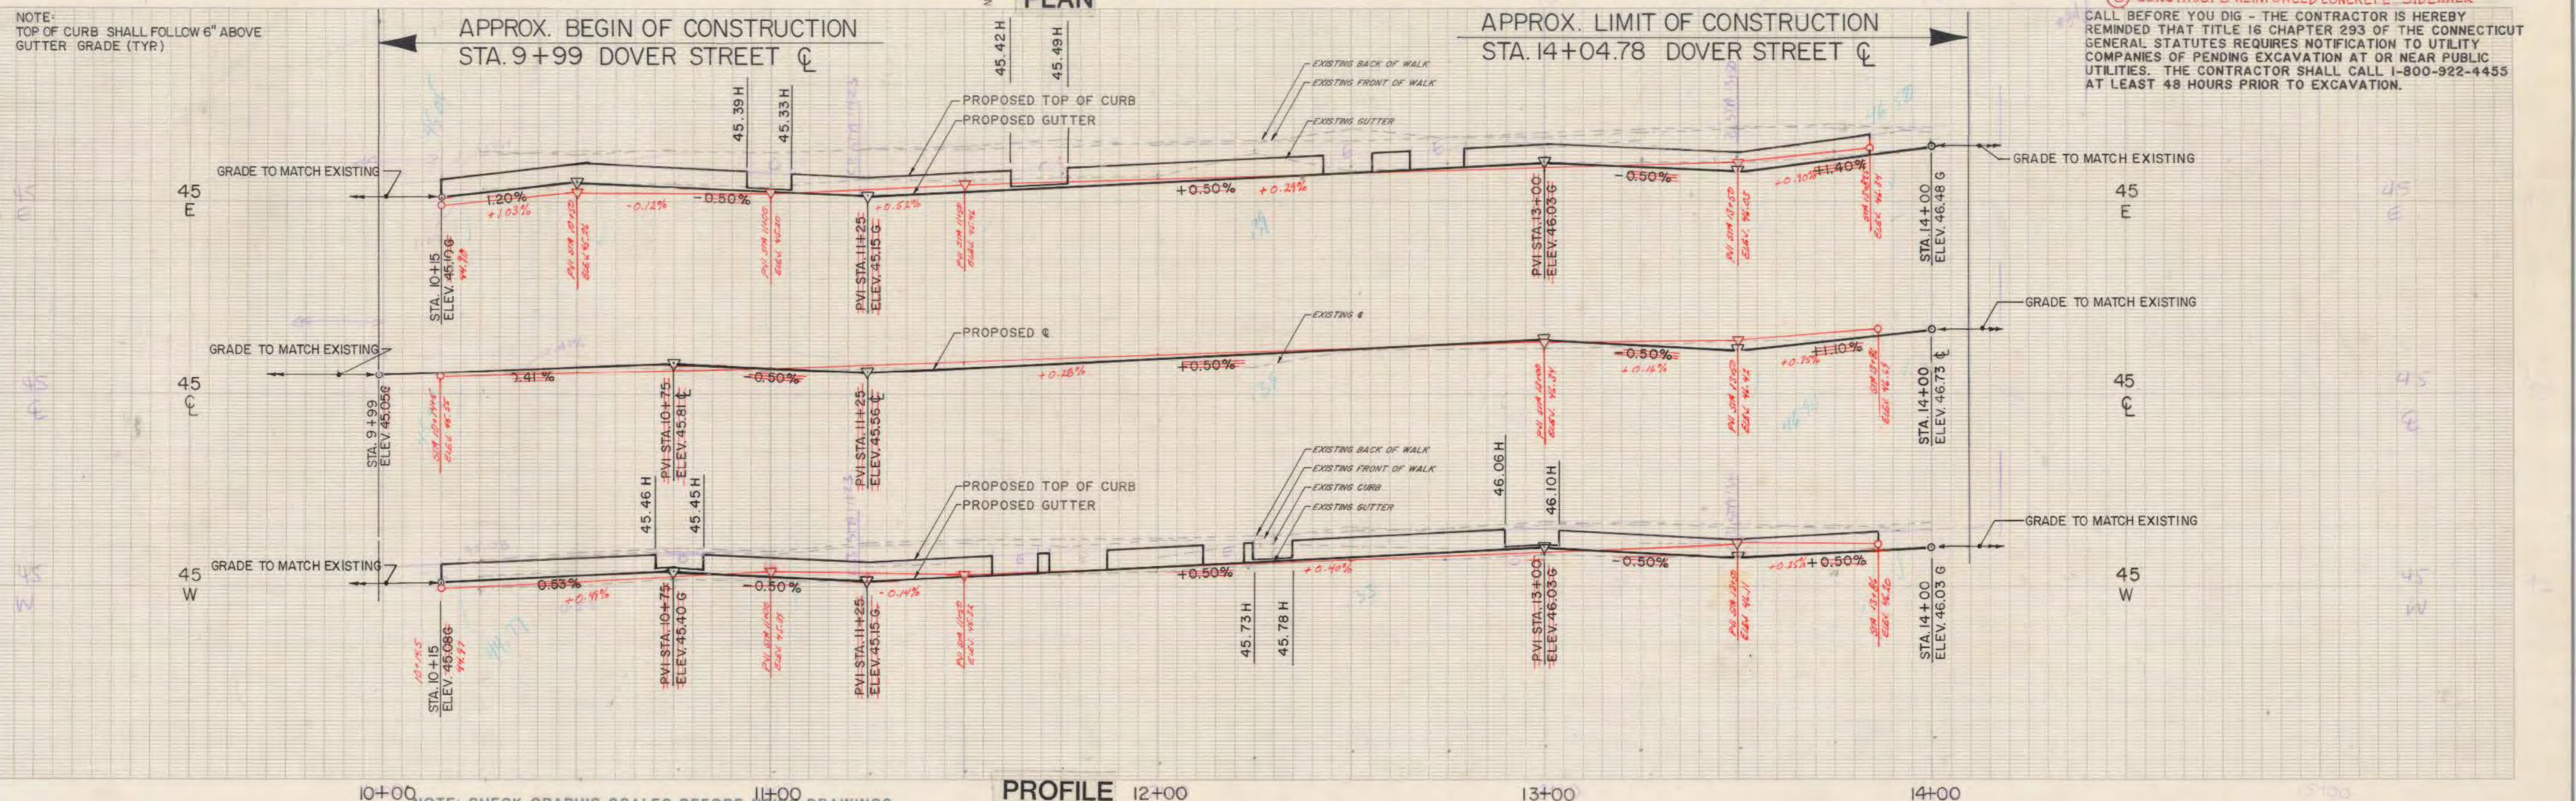


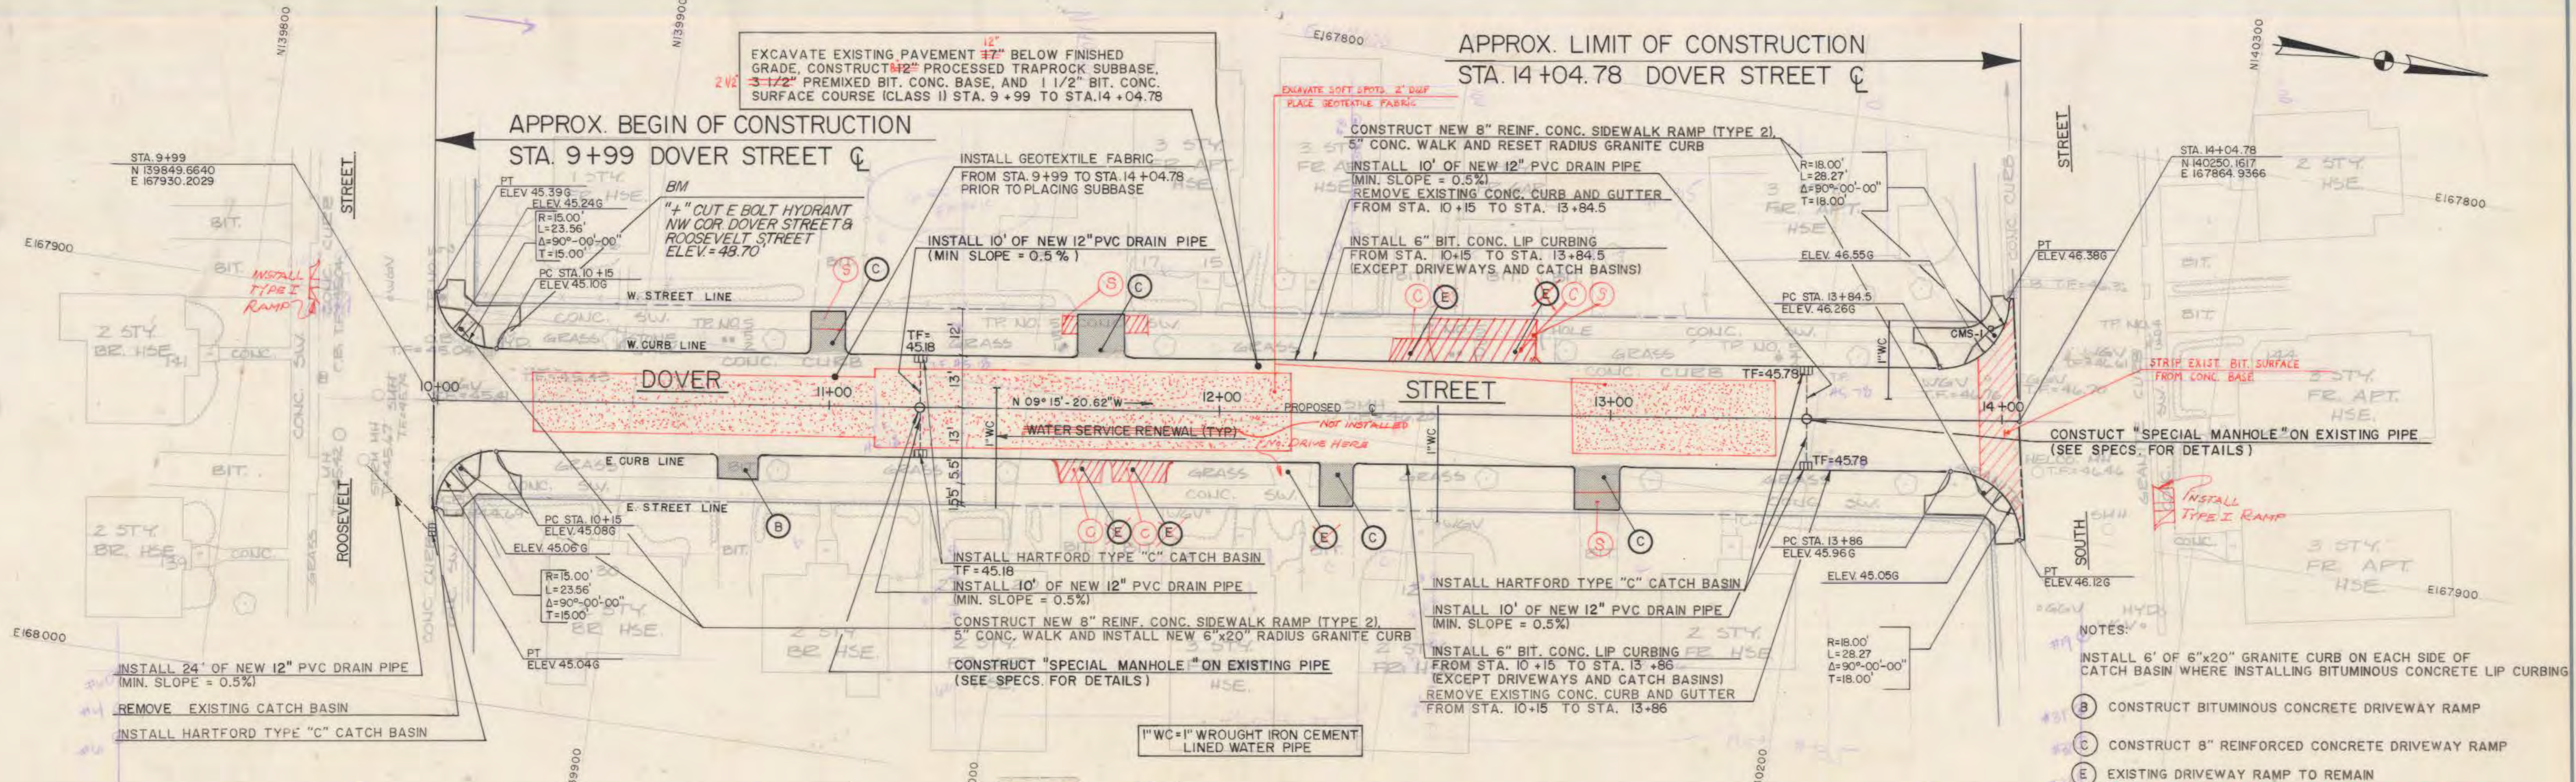

REVISIONS		SUPV. ARW		GRAPHIC SCALES HORIZ. 1"=20' VERT. 1"=2'		ROADWAY RECONSTRUCTION HARTFORD, CONNECTICUT		Hayden Wegman Consulting Engineers WEST HARTFORD NEW YORK • BOSTON • BUFFALO ATLANTA • MEMPHIS		CITY OF HARTFORD, CONNECTICUT DEPARTMENT OF PUBLIC WORKS BUREAU OF ENGINEERING SERVICES		DOVER STREET STA. 9+99 TO STA. 14+04.78		PLAN AND PROFILE SHEET 1-1	
NO.	DATE	DESCRIPTION	CHECKED	DATE											
1	DEC 86	AS BUILT BY RJE CHECKED BY MLC	JAC	6/3/85											
DRAWN		SCALE		DAYBOOK NO. 010947		Contract No. E 85-28		Job No. 845304		OF					
CHECKED		DATE													