
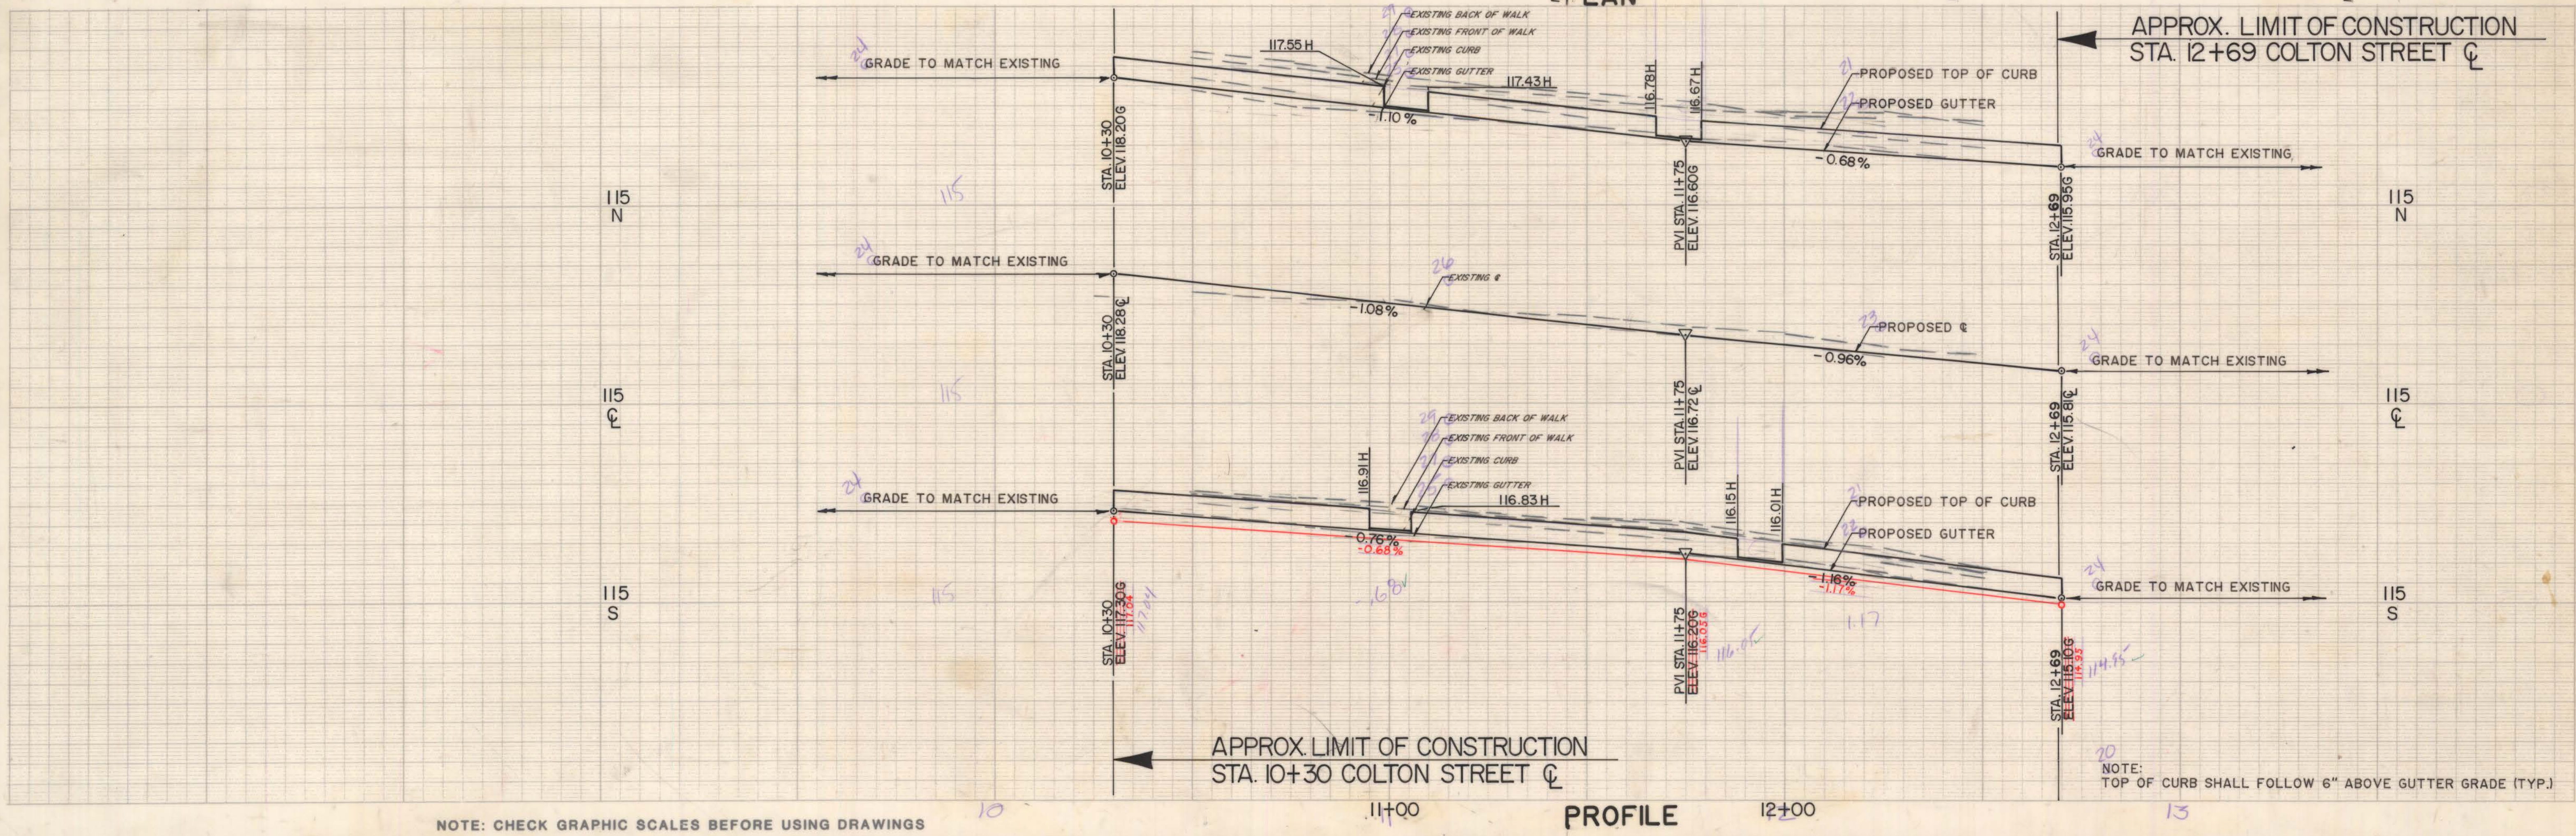


- 19 NOTES:
- INSTALL 6" OF 6"x20" GRANITE CURB ON EACH SIDE OF CATCH BASIN WHERE INSTALLING BITUMINOUS CONCRETE LIP CURBING
 - 31 (B) CONSTRUCT BITUMINOUS CONCRETE DRIVEWAY RAMP
 - 32 (C) CONSTRUCT 8" REINFORCED CONCRETE DRIVEWAY RAMP
 - 33 (E) EXISTING DRIVEWAY RAMP TO REMAIN
- CALL BEFORE YOU DIG - THE CONTRACTOR IS HEREBY REMINDED THAT TITLE 16 CHAPTER 293 OF THE CONNECTICUT GENERAL STATUTES REQUIRES NOTIFICATION TO UTILITY COMPANIES OF PENDING EXCAVATION AT OR NEAR PUBLIC UTILITIES. THE CONTRACTOR SHALL CALL 1-800-922-4455 AT LEAST 48 HOURS PRIOR TO EXCAVATION.

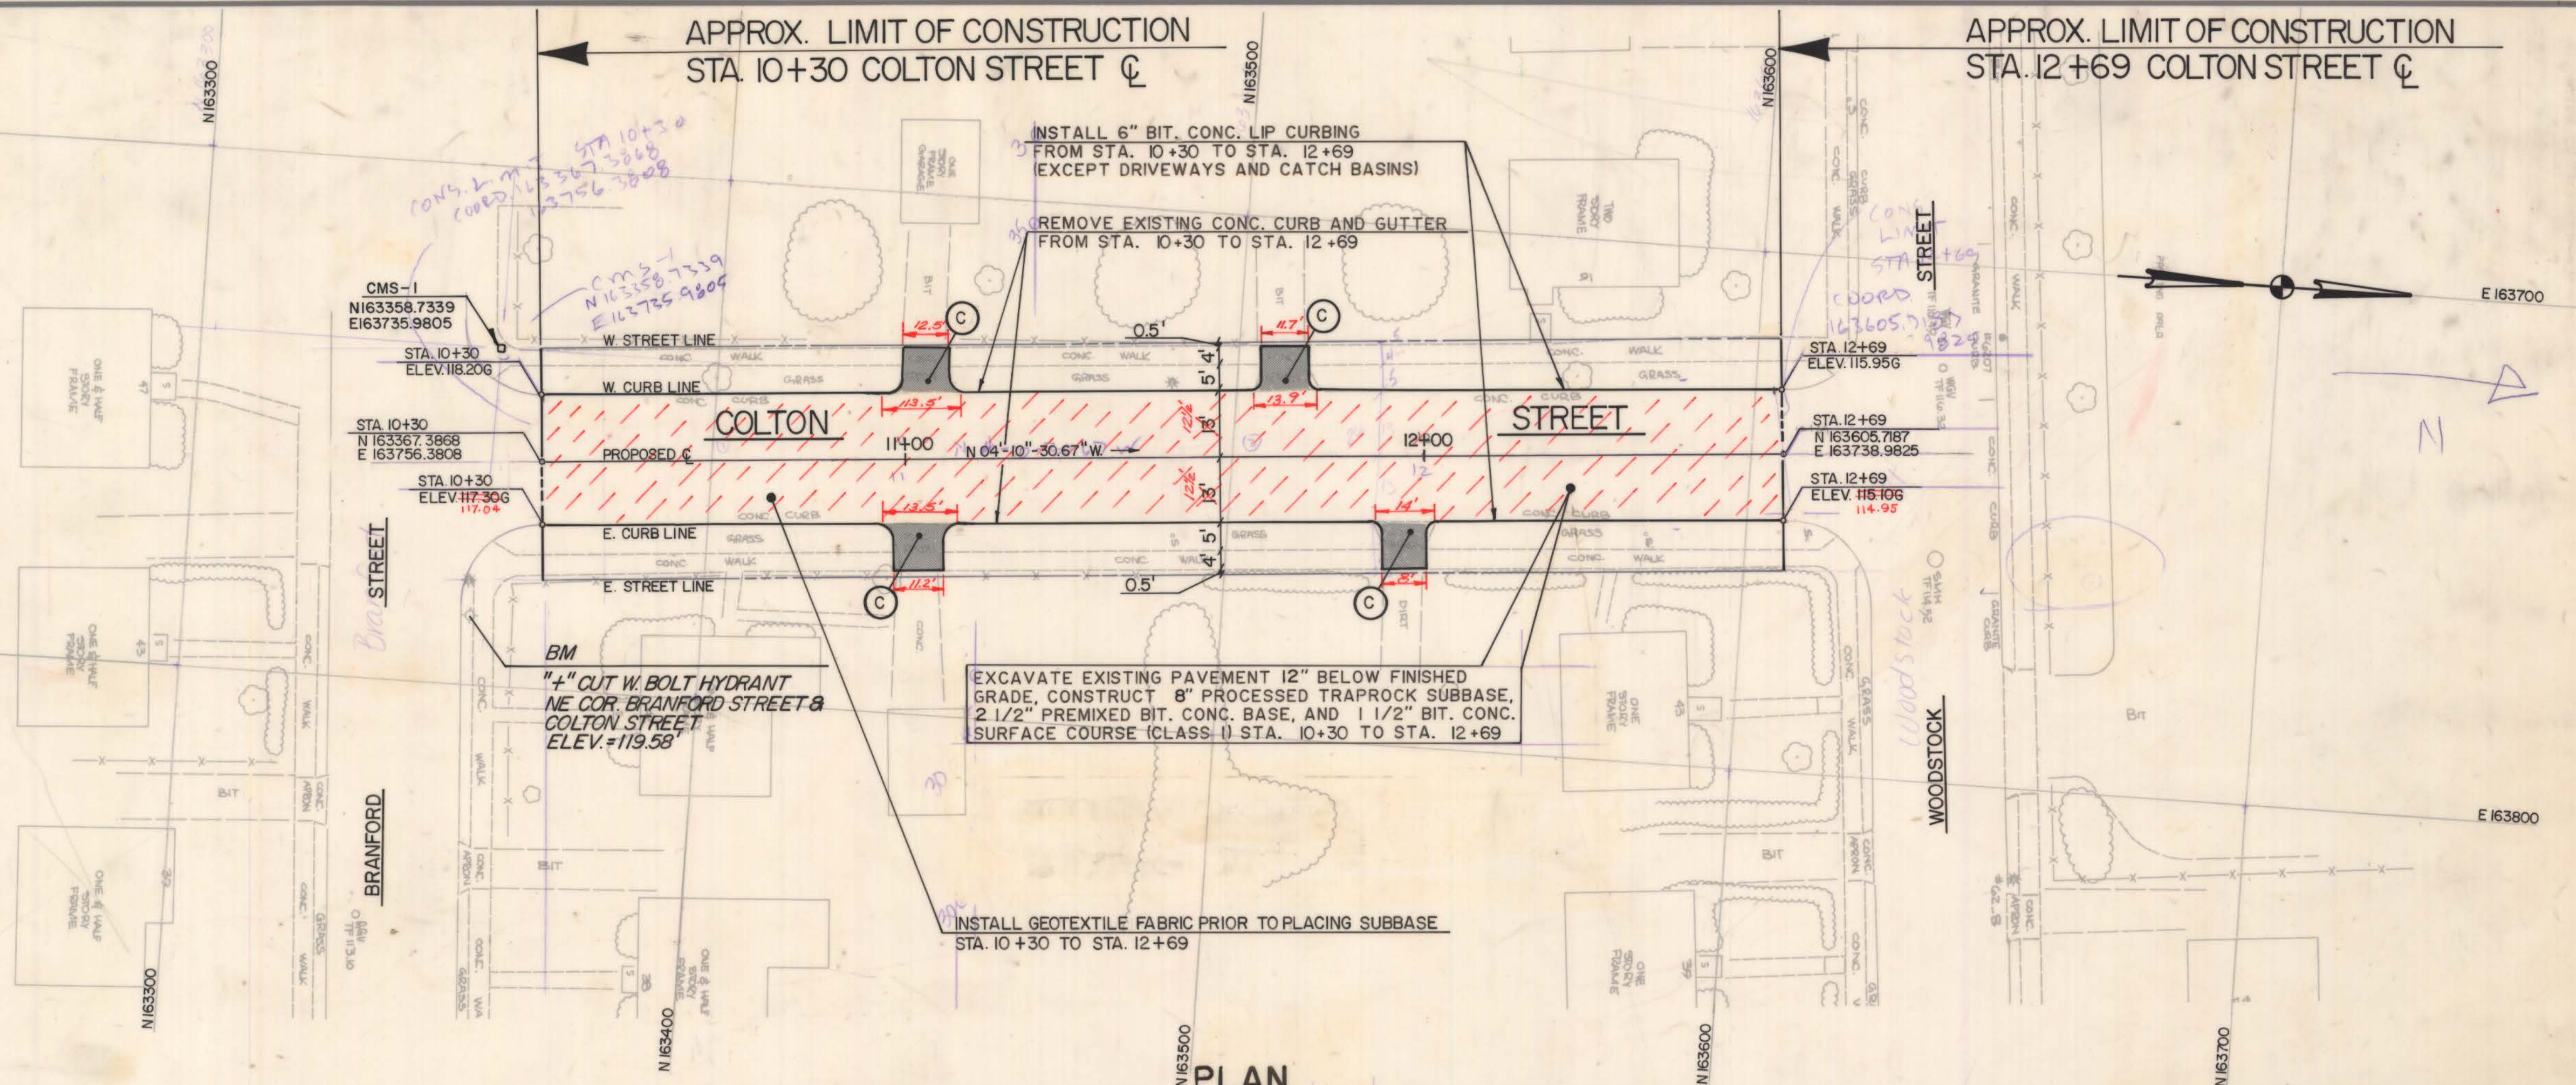

NO. DATE DESCRIPTION		REVISIONS		SUPV. ARW		DESIGN AEC/DH		DRAWN KHT		CHECKED JAC		DATE 6-25-85			
NOV 86				AS BUILT BY R.J.F. CHECKED BY M.C.C.											

GRAPHIC SCALES		HORIZ. 1"=20'		VERT. 1"=2'		ROADWAY RECONSTRUCTION HARTFORD, CONNECTICUT		HAYDEN WEGMAN Consulting Engineers		CITY OF HARTFORD, CONNECTICUT DEPARTMENT OF PUBLIC WORKS BUREAU OF ENGINEERING SERVICES		COLTON STREET STA. 10+30 TO STA. 12 TO 69	
WEST HARTFORD NEW YORK • BOSTON • BUFFALO ATLANTA • MEMPHIS		DAYBOOK NO. 0958		SCALE		DATE		SHEET 1		Contract #E85-36		Job No. 845304 OF 1	