


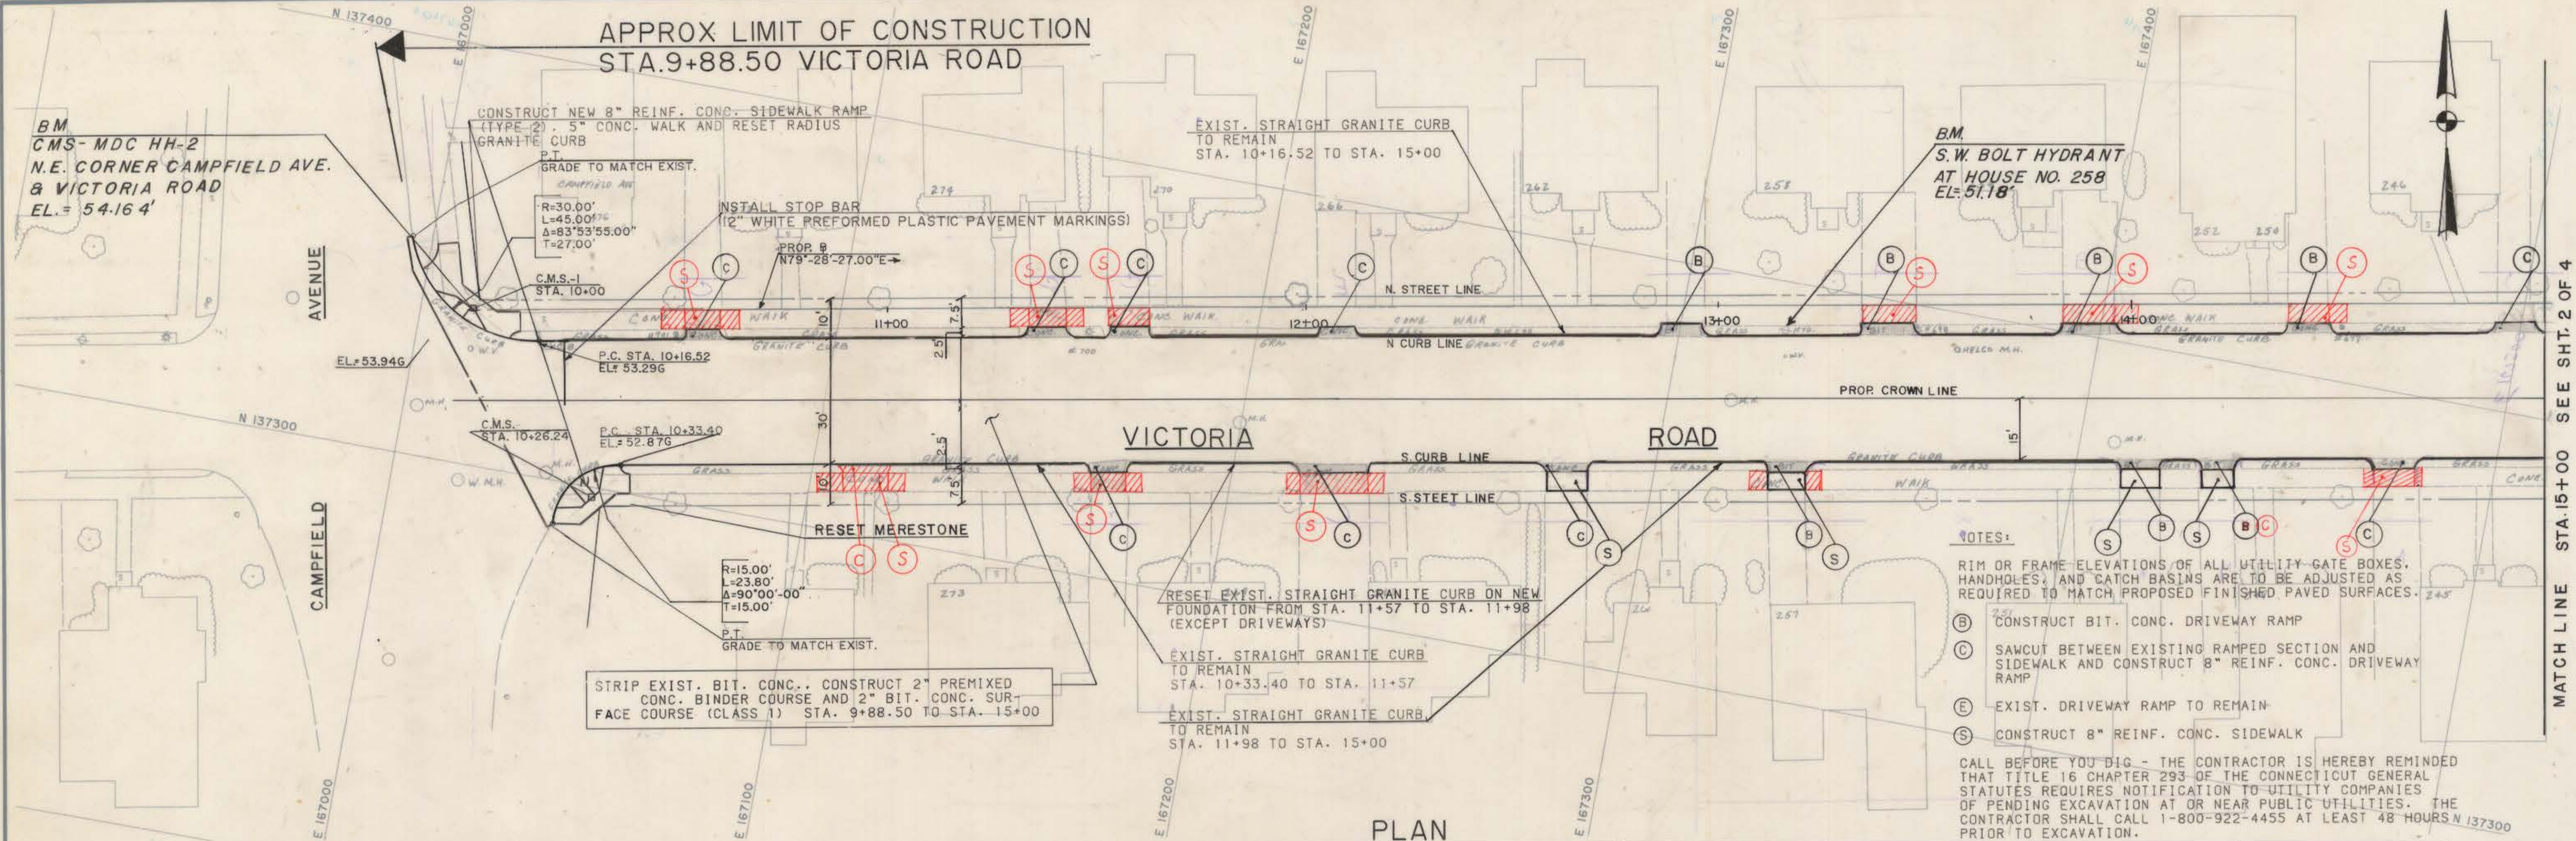


PLAN

NOTES:

- (B) RIM OR FRAME ELEVATIONS OF ALL UTILITY-GATE BOXES, HANDHOLES, AND CATCH BASINS ARE TO BE ADJUSTED AS REQUIRED TO MATCH PROPOSED FINISHED PAVED SURFACES.
- (C) CONSTRUCT BIT. CONC. DRIVEWAY RAMP
- (S) SAWCUT BETWEEN EXISTING RAMPED SECTION AND SIDEWALK AND CONSTRUCT 8" REINF. CONC. DRIVEWAY RAMP
- (E) EXIST. DRIVEWAY RAMP TO REMAIN
- (S) CONSTRUCT 8" REINF. CONC. SIDEWALK

CALL BEFORE YOU DIG - THE CONTRACTOR IS HEREBY REMINDED THAT TITLE 16 CHAPTER 293 OF THE CONNECTICUT GENERAL STATUTES REQUIRES NOTIFICATION TO UTILITY COMPANIES OF PENDING EXCAVATION AT OR NEAR PUBLIC UTILITIES. THE CONTRACTOR SHALL CALL 1-800-922-4455 AT LEAST 48 HOURS PRIOR TO EXCAVATION.

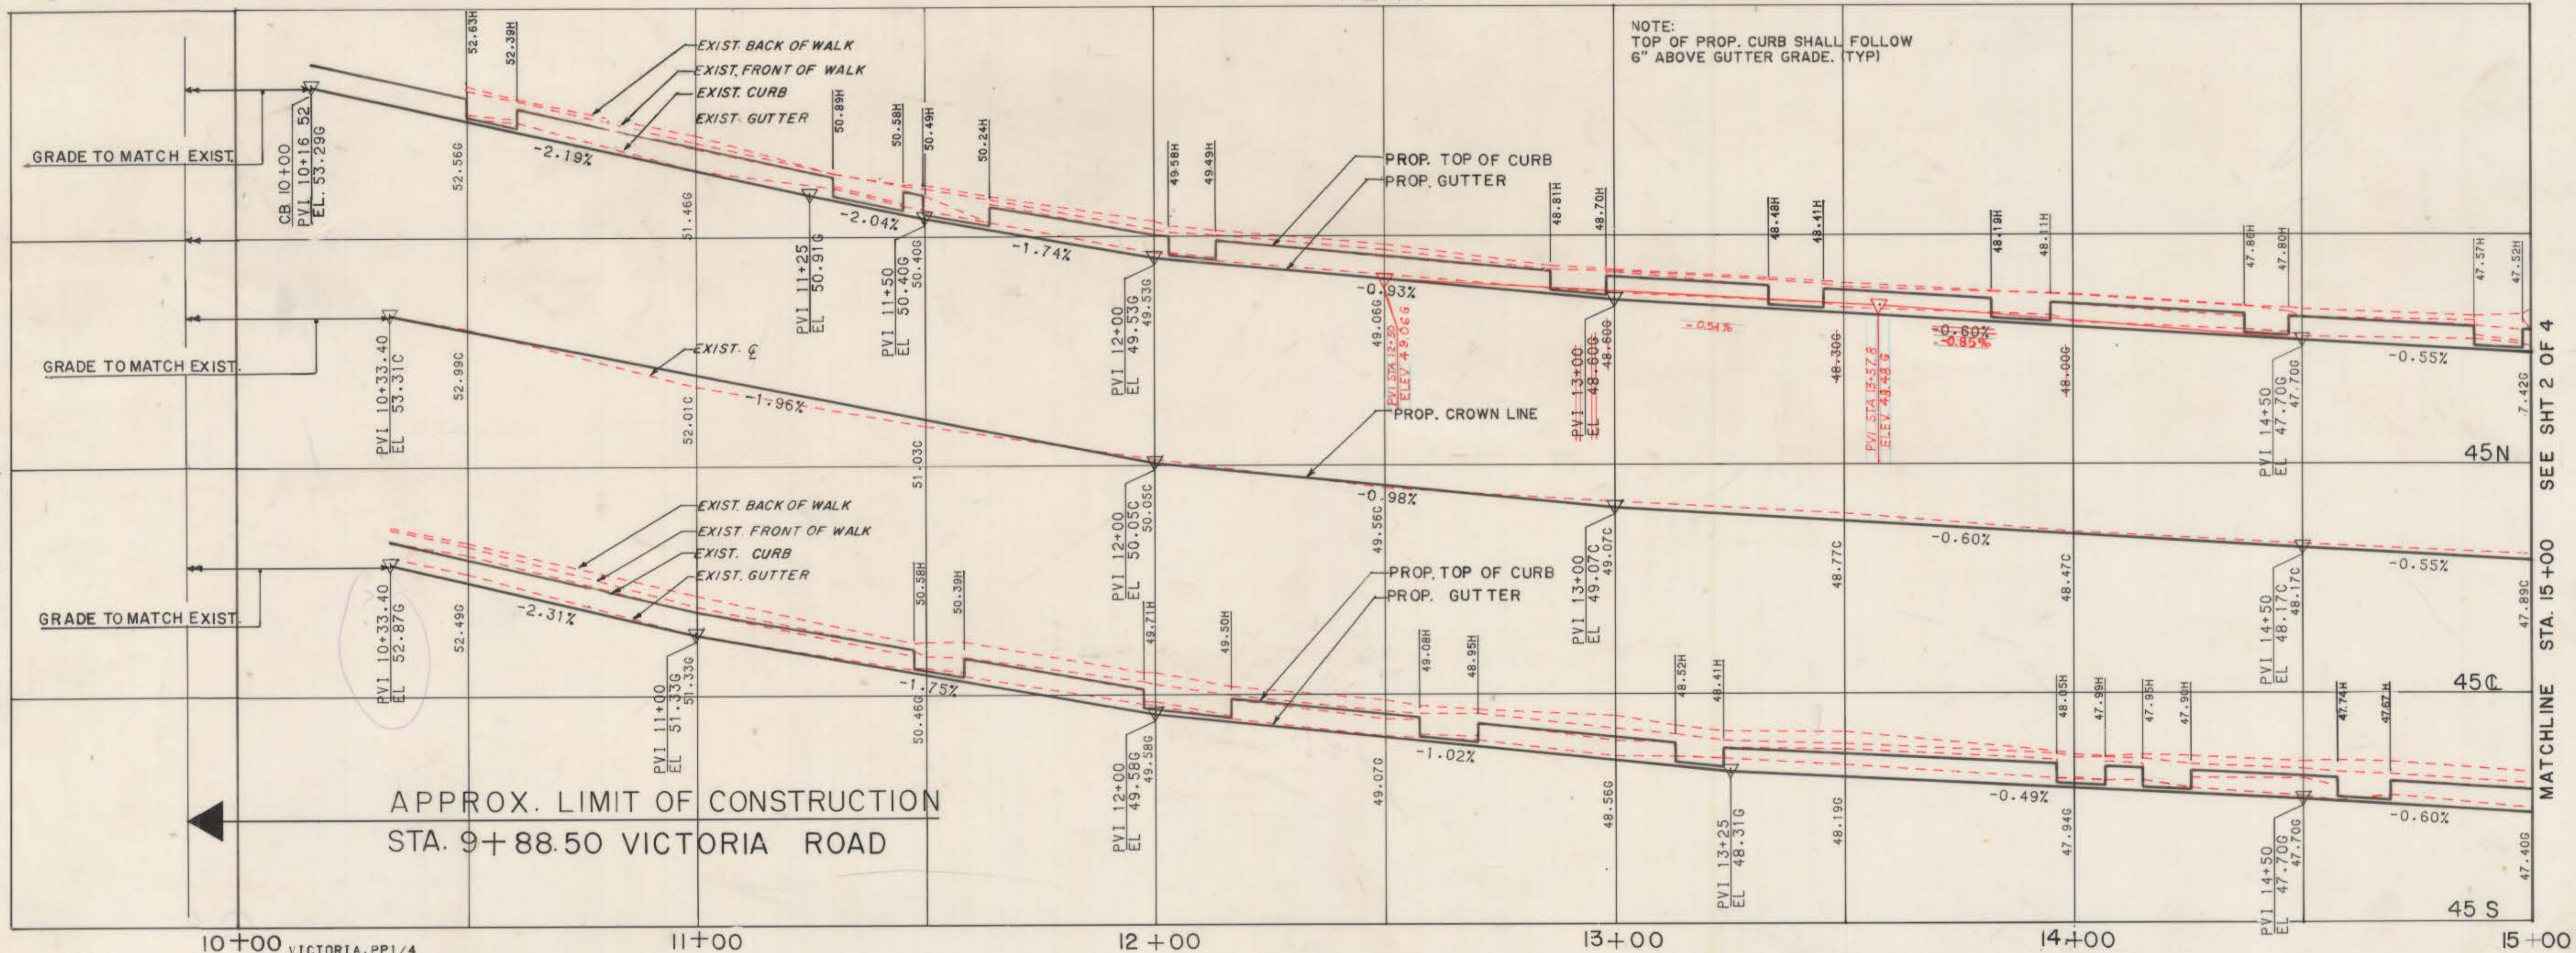

PROFILE

SUPV. JAC DESIGN MDH/AEC DRAWN K.G. CHECKED FTD/JAC DATE 01-31-86		GRAPHIC SCALES HORIZ. 1"=20' VERT. 1"=2'		ROADWAY RECONSTRUCTION HARTFORD, CONNECTICUT		CITY OF HARTFORD, CONNECTICUT DEPARTMENT OF PUBLIC WORKS BUREAU OF ENGINEERING SERVICES		VICTORIA ROAD STA. 9+88.5 TO STA. 15+00	
AS BUILT - RED SOLID LINES AS BUILT BY R/JF CHECKED BY NO.		NO. DATE JAN 87 DESCRIPTION REVISIONS		HAYDEN WEGMAN Consulting Engineers WEST HARTFORD NEW YORK • BOSTON • BUFFALO ATLANTA • MEMPHIS		DAYBOOK NO. 011009 DATE		PLAN AND PROFILE CONTRACT NO. E86-6 Job No. 852534 OF 4	