


APPROX. LIMIT OF CONSTRUCTION STA. 9+77 SOUTH WHITNEY STREET

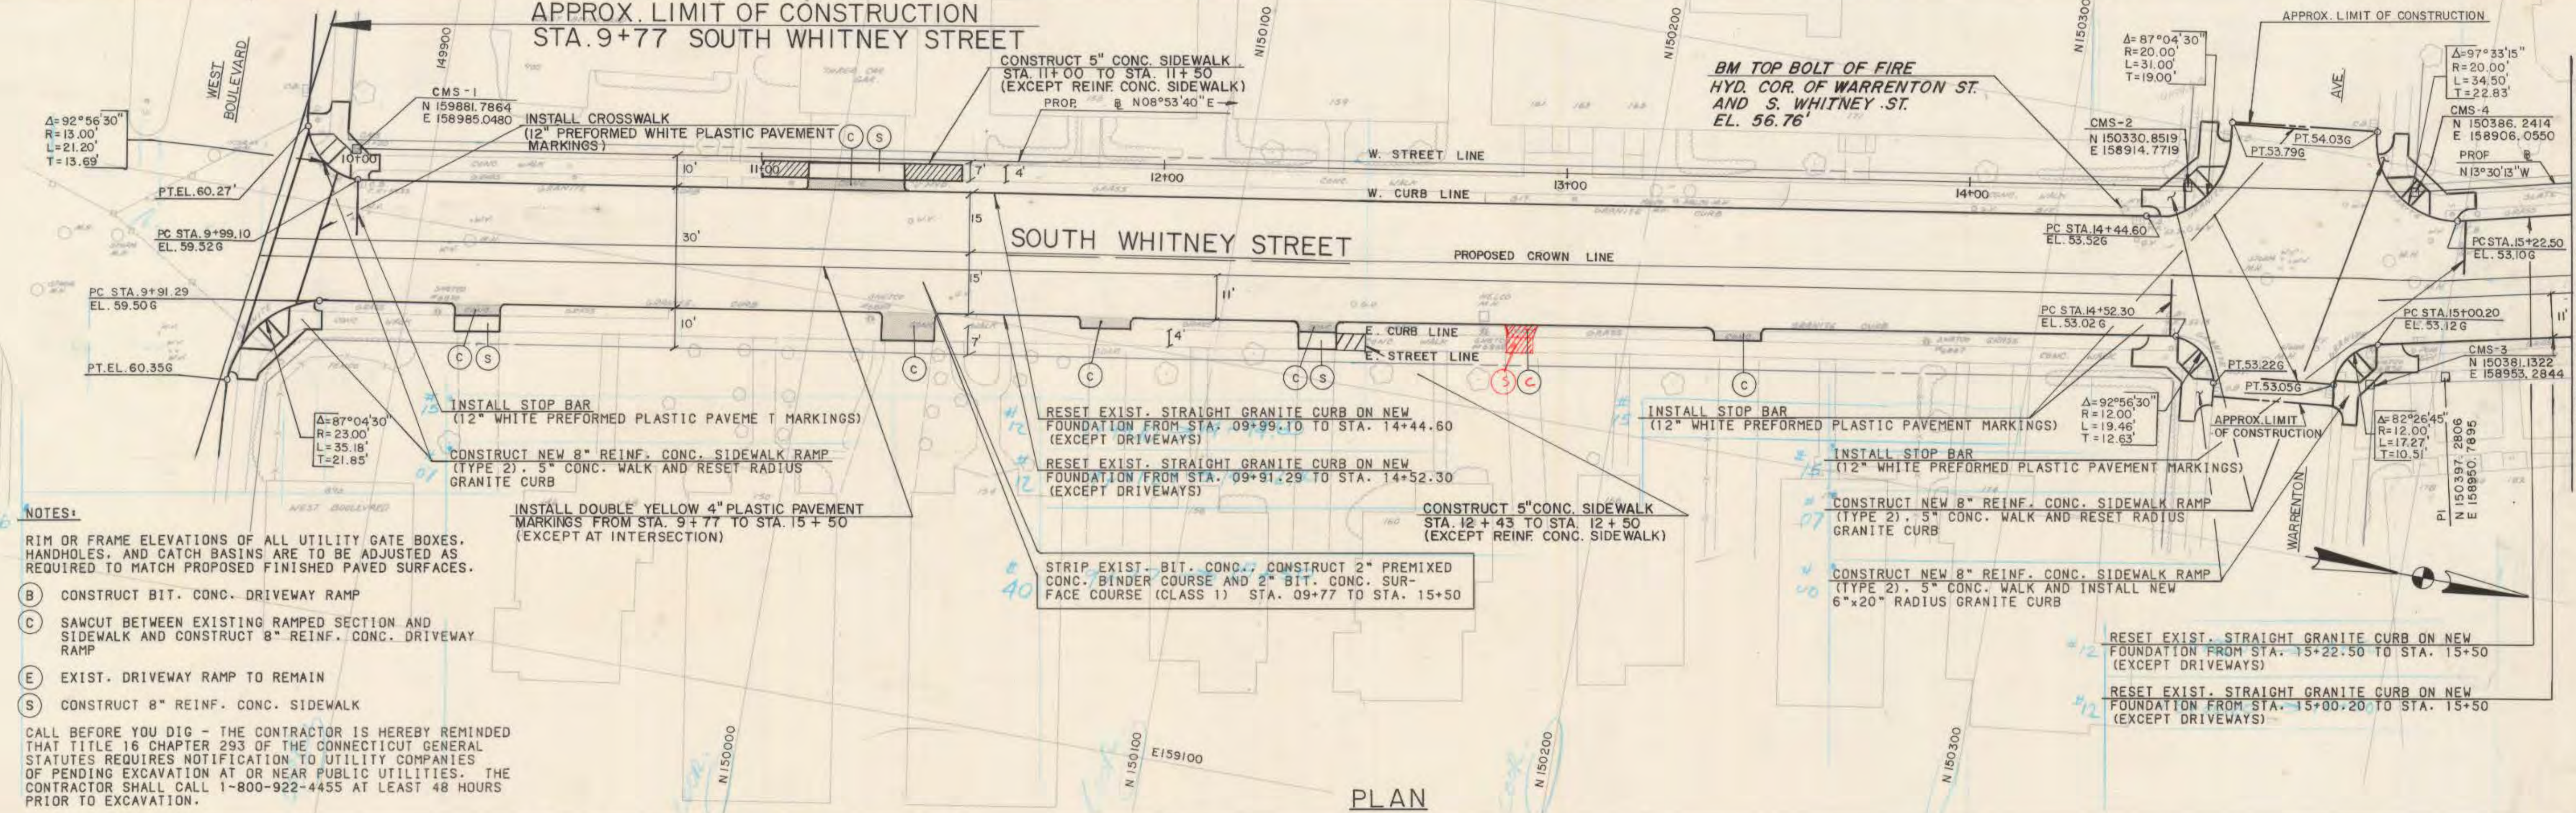

NOTES:

RIM OR FRAME ELEVATIONS OF ALL UTILITY GATE BOXES, HANDHOLES, AND CATCH BASINS ARE TO BE ADJUSTED AS REQUIRED TO MATCH PROPOSED FINISHED SURFACES.

(B) CONSTRUCT BIT. CONC. DRIVEWAY RAMP

(C) SAWCUT BETWEEN EXISTING RAMPED SECTION AND SIDEWALK AND CONSTRUCT 8" REINF. CONC. DRIVEWAY RAMP


(E) EXIST. DRIVEWAY RAMP TO REMAIN

(S) CONSTRUCT 8" REINF. CONC. SIDEWALK

CALL BEFORE YOU DIG - THE CONTRACTOR IS HEREBY REMINDED THAT TITLE 16 CHAPTER 293 OF THE CONNECTICUT GENERAL STATUTES REQUIRES NOTIFICATION TO UTILITY COMPANIES OF PENDING EXCAVATION AT OR NEAR PUBLIC UTILITIES. THE CONTRACTOR SHALL CALL 1-800-922-4455 AT LEAST 48 HOURS PRIOR TO EXCAVATION.

PLAN

APPROX. LIMIT OF CONSTRUCTION STA. 9+77 SOUTH WHITNEY STREET

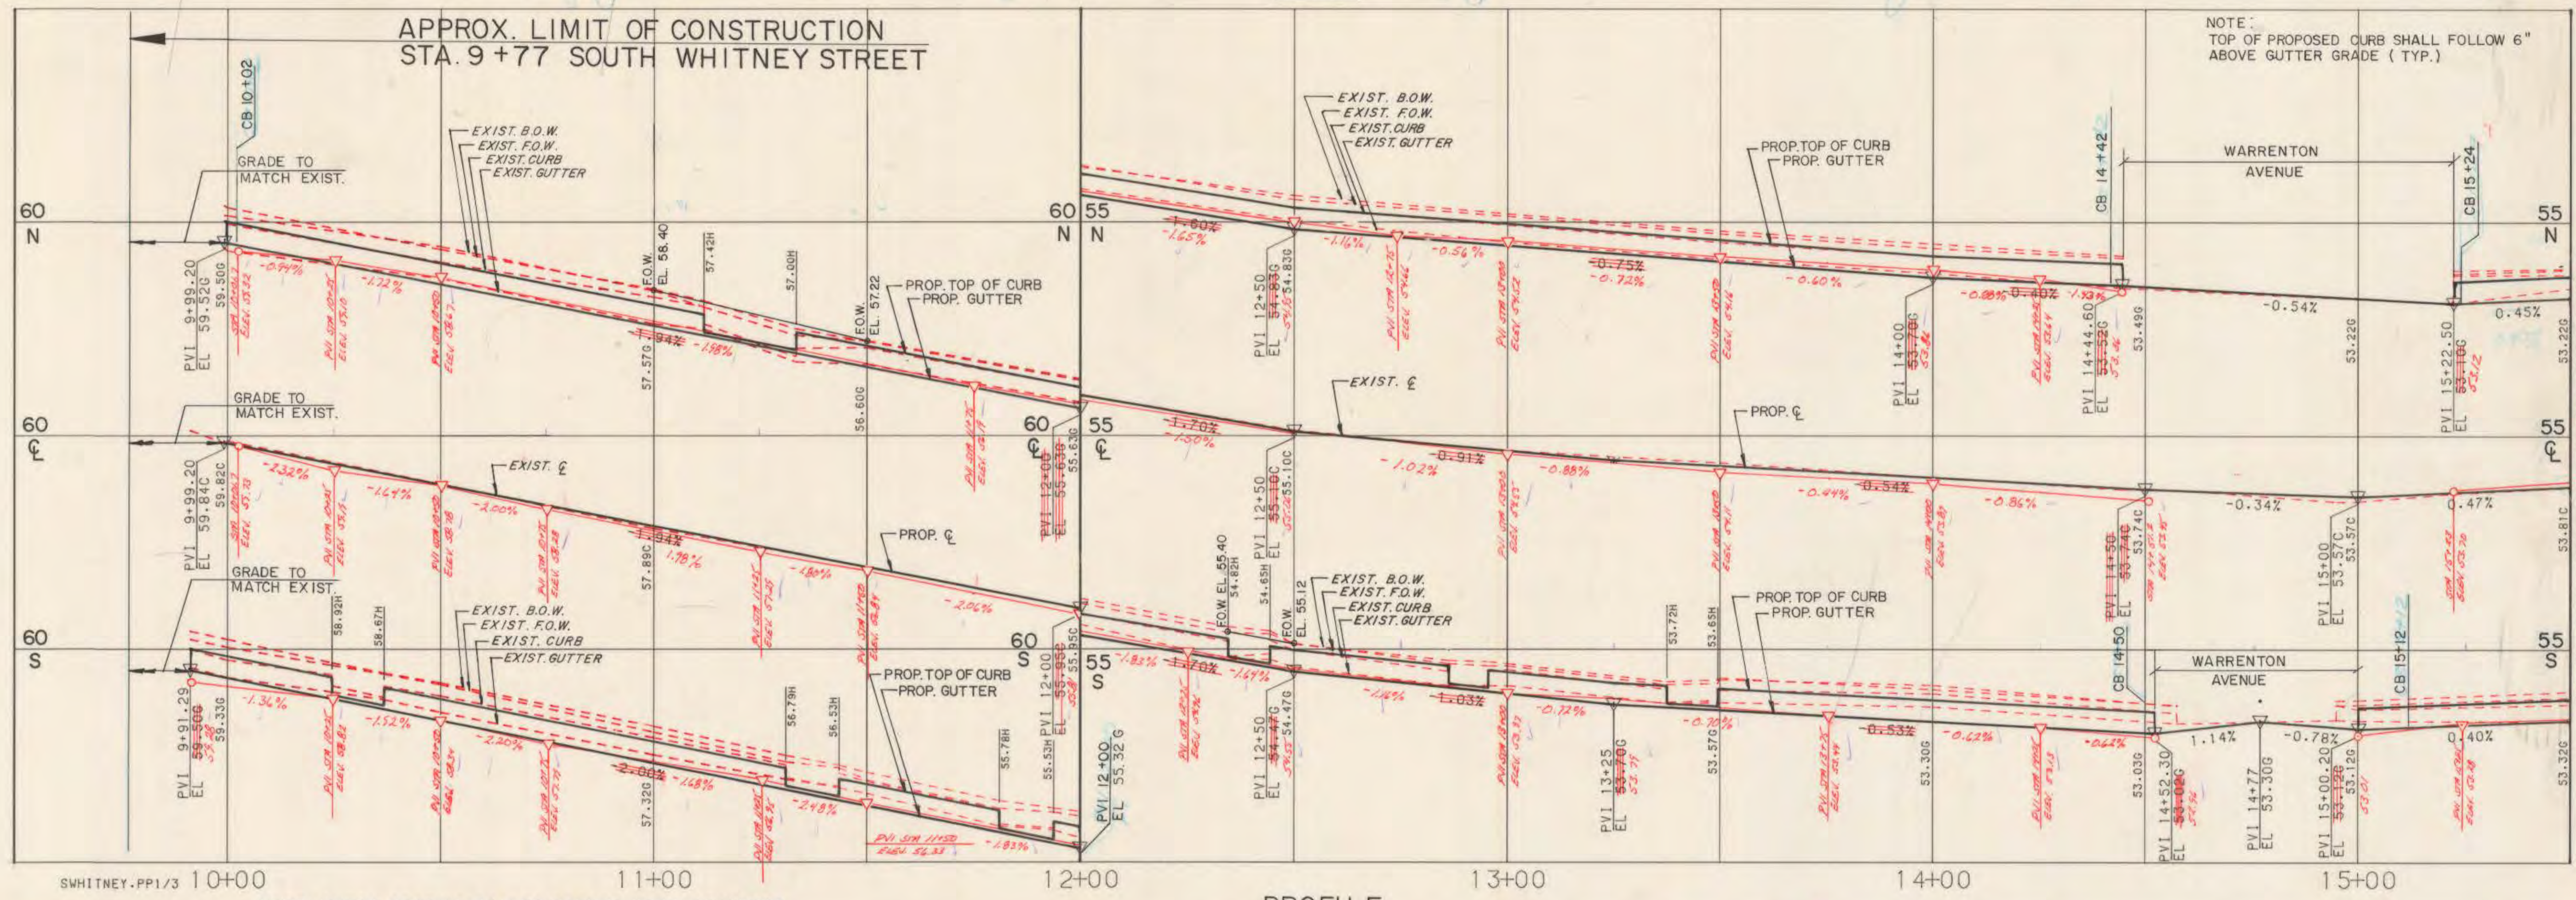

PROFILE

NOTE: AS-BUILT DRAWING IN SOLID RED 1/21/87 CHECKED BY RIF 1/21/87 AS-BUILT DRAWING BY RIF/MDH		SUPV. JAC DESIGN MDH/AEC DRAWN M J N CHECKED AEC DATE 02-25-86	GRAPHIC SCALES HORIZ. 1" = 20' VERT. 1" = 2'	ROADWAY RECONSTRUCTION HARTFORD, CONNECTICUT	STATE OF CONNECTICUT ALAN R. WEGMAN REGISTERED PROFESSIONAL ENGINEER No. 10606	Hayden Wegman Consulting Engineers WEST HARTFORD NEW YORK • BOSTON • BUFFALO ATLANTA • MEMPHIS	CITY OF HARTFORD, CONNECTICUT DEPARTMENT OF PUBLIC WORKS BUREAU OF ENGINEERING SERVICES DAYBOOK NO. 011013 DATE	SOUTH WHITNEY STREET STA. 9+77 TO STA. 15+50 1690-1550 PLAN AND PROFILE Contract No. E86-10 Job No. 852534	SHEET 1 OF 3
---	--	---	---	---	---	--	--	--	---------------------