
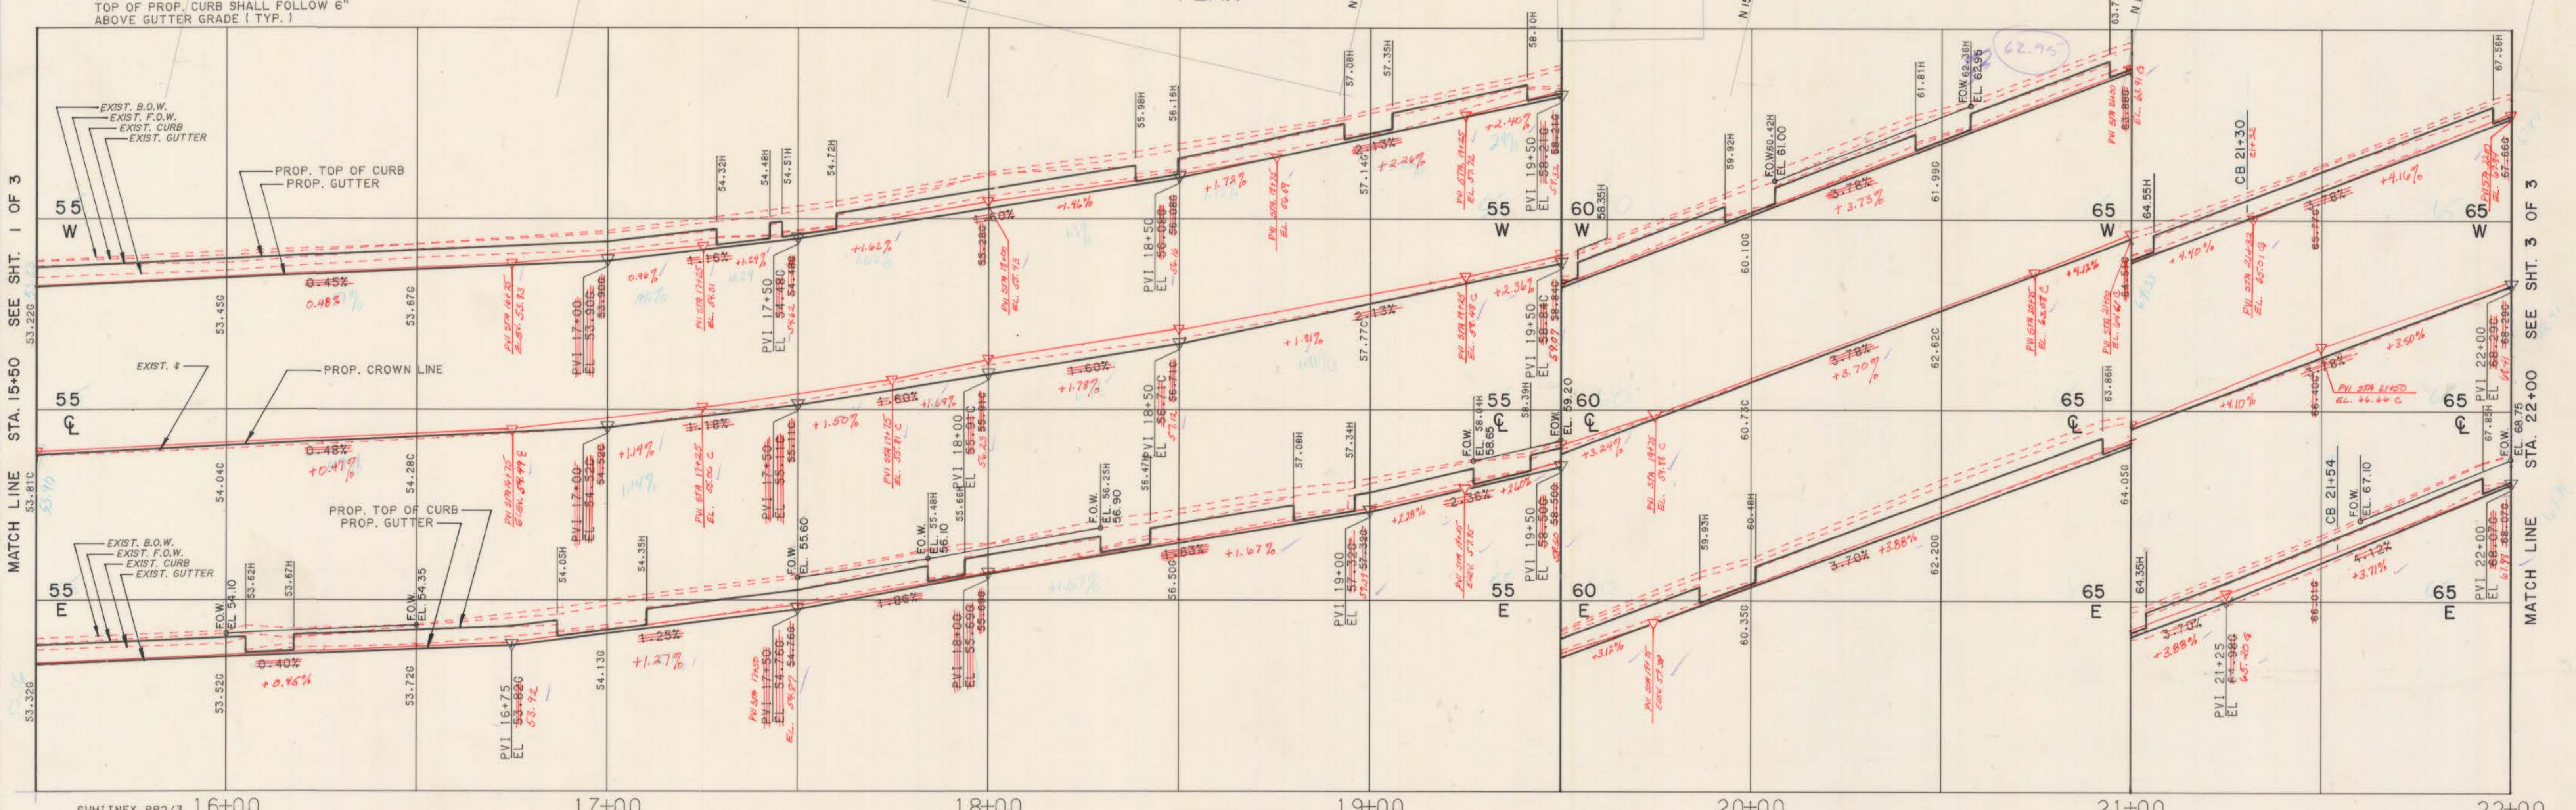


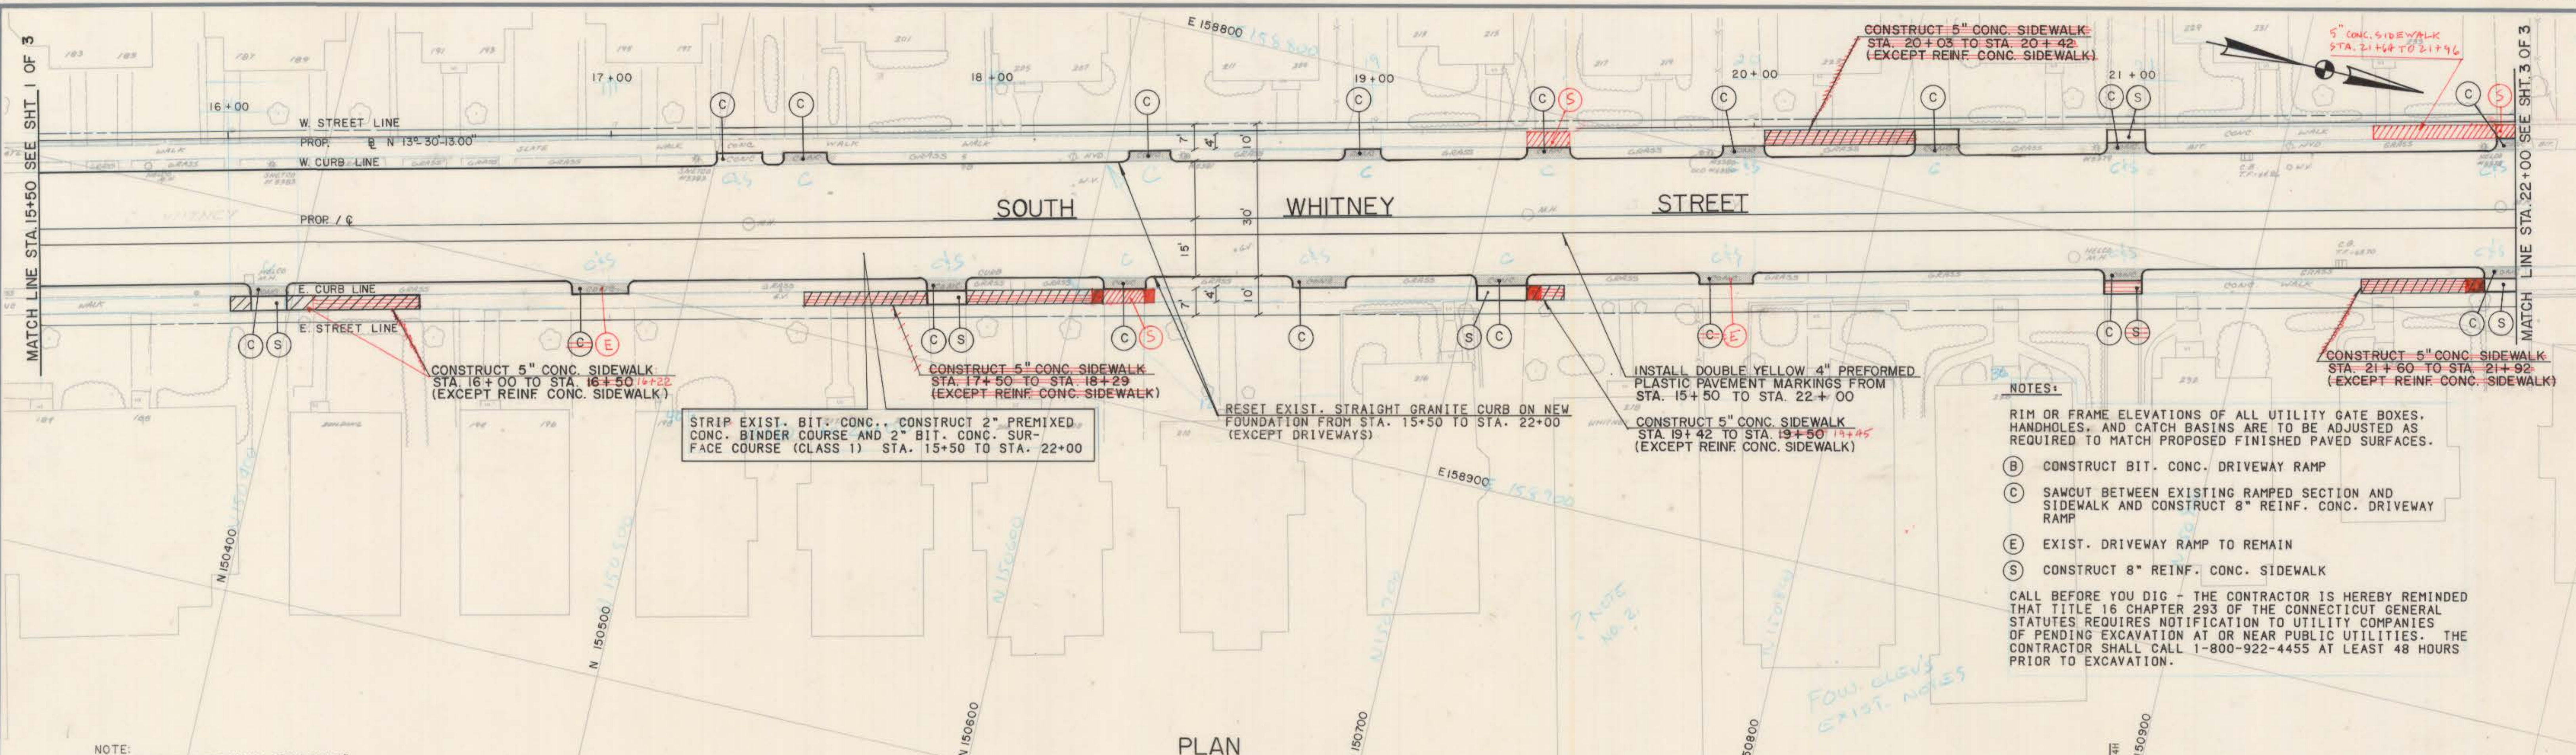

NOTE: TOP OF PROP. CURB SHALL FOLLOW 6" ABOVE GUTTER GRADE (TYP.)

NOTE: CHECK GRAPHIC SCALES BEFORE USING DRAWINGS

REVISIONS

NO.	DATE	DESCRIPTION
1	10/1/17	AS BUILT DRAFTED IN SAFE PLOT
2	10/1/17	CHECKED BY RIF
3	10/1/17	AS BUILT DRAFTED BY RIF / MDH

SUPV. JAC

DESIGN MDH/AEC

DRAWN N.D. FORTIN

CHECKED AEC

DATE 02-25-86

GRAPHIC SCALES

HORIZ. 1" = 20'

VERT. 1" = 2'

ROADWAY RECONSTRUCTION

HARTFORD, CONNECTICUT

Hayden | Wegman

Consulting Engineers

WEST HARTFORD

NEW YORK • BOSTON • BUFFALO

ATLANTA • MEMPHIS

CITY OF HARTFORD, CONNECTICUT

DEPARTMENT OF PUBLIC WORKS

BUREAU OF ENGINEERING SERVICES

DAYBOOK NO. 011013

DATE

SOUTH WHITNEY STREET

STA. 15+50 TO STA. 22+00

PLAN AND PROFILE

Contract No. E-86-10 Job No. 852534

SHEET 2

OF 3