
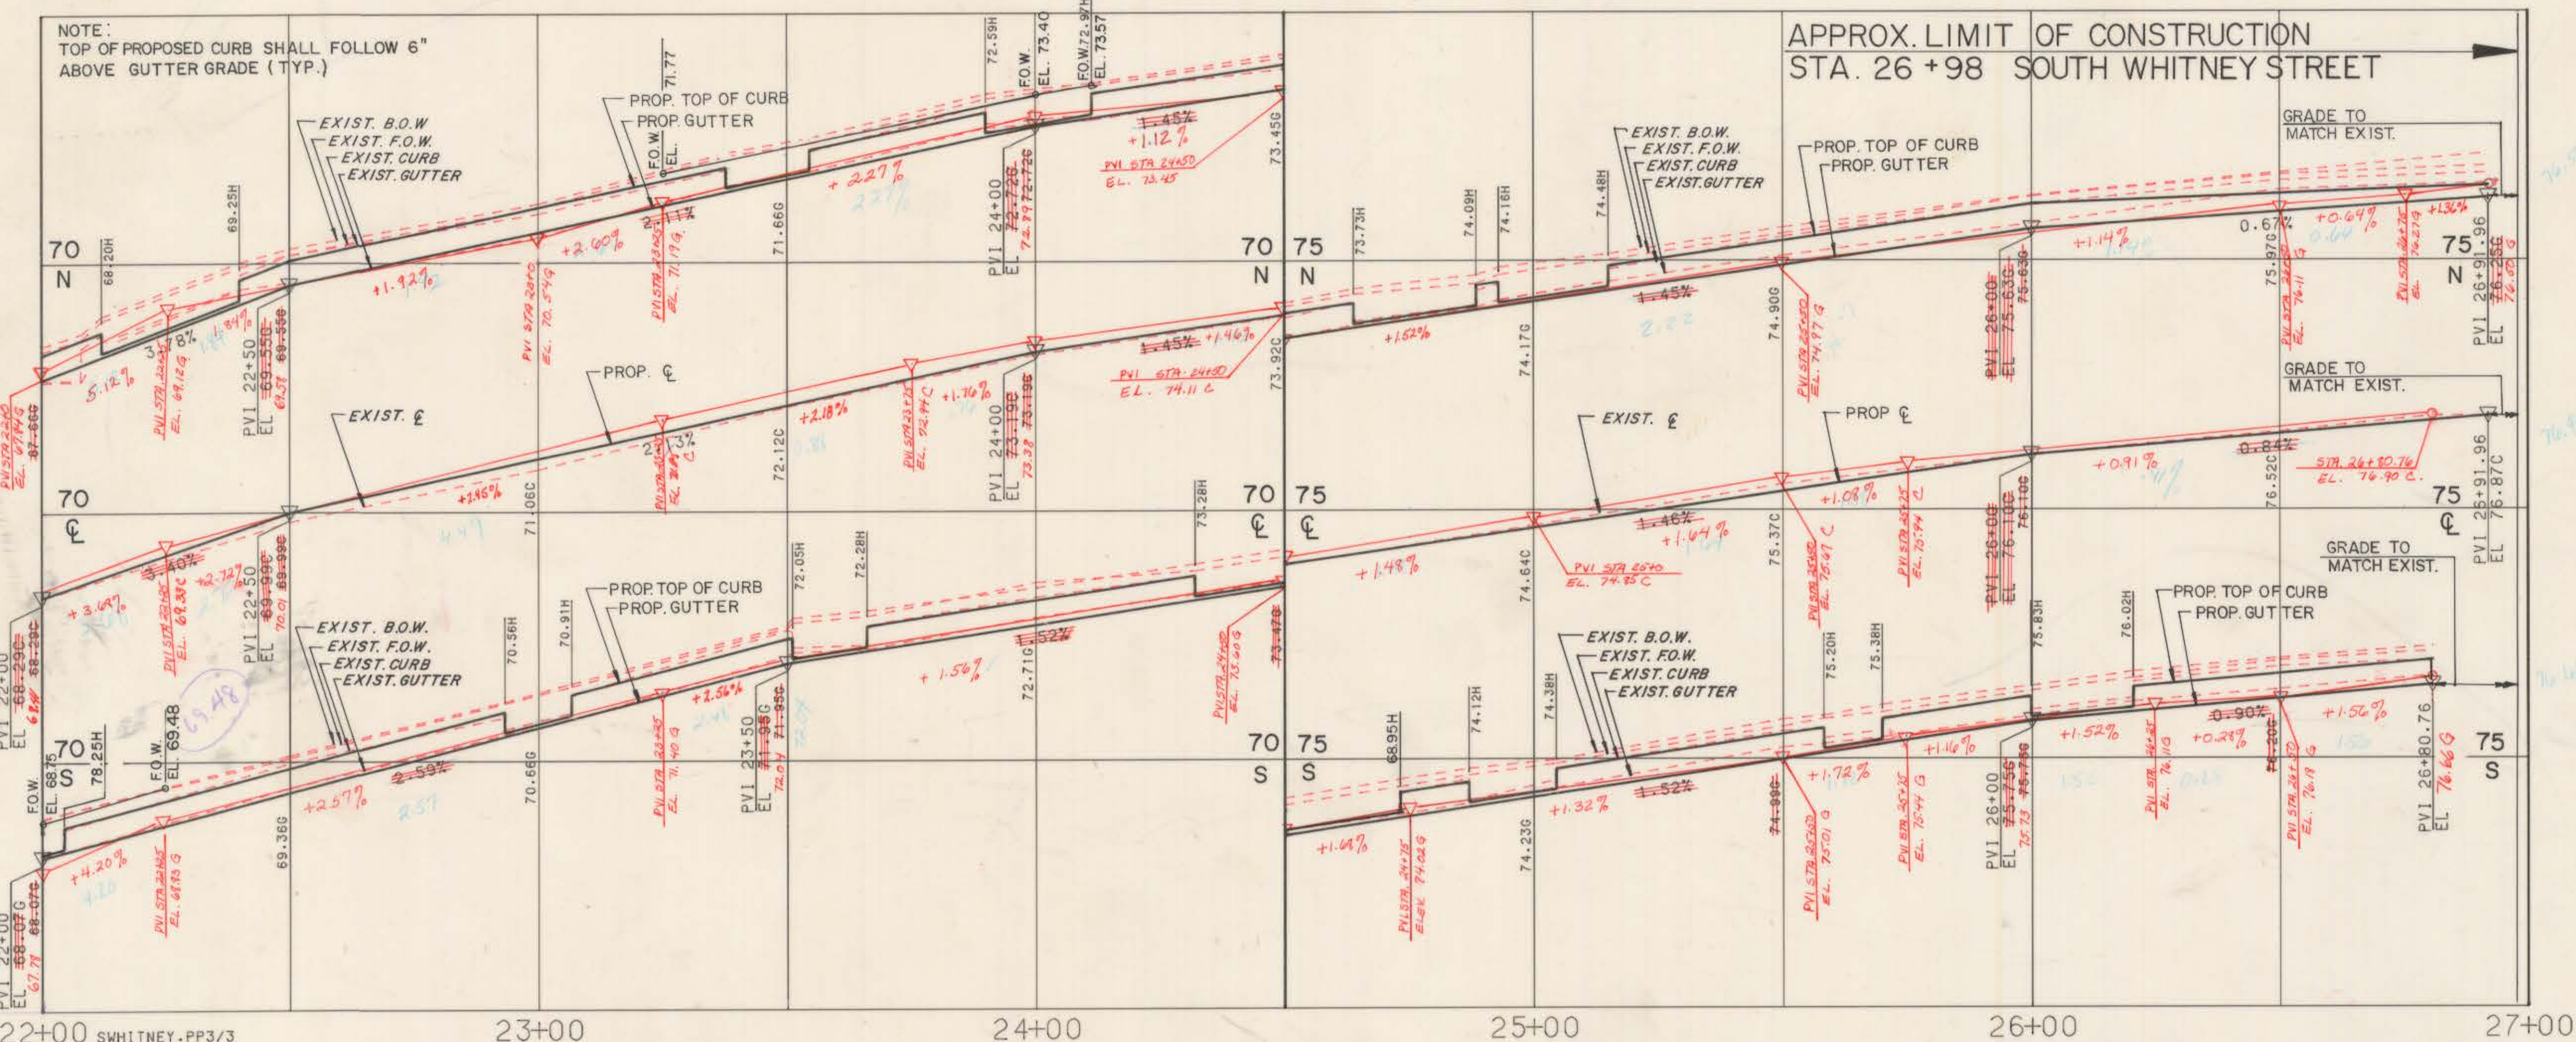


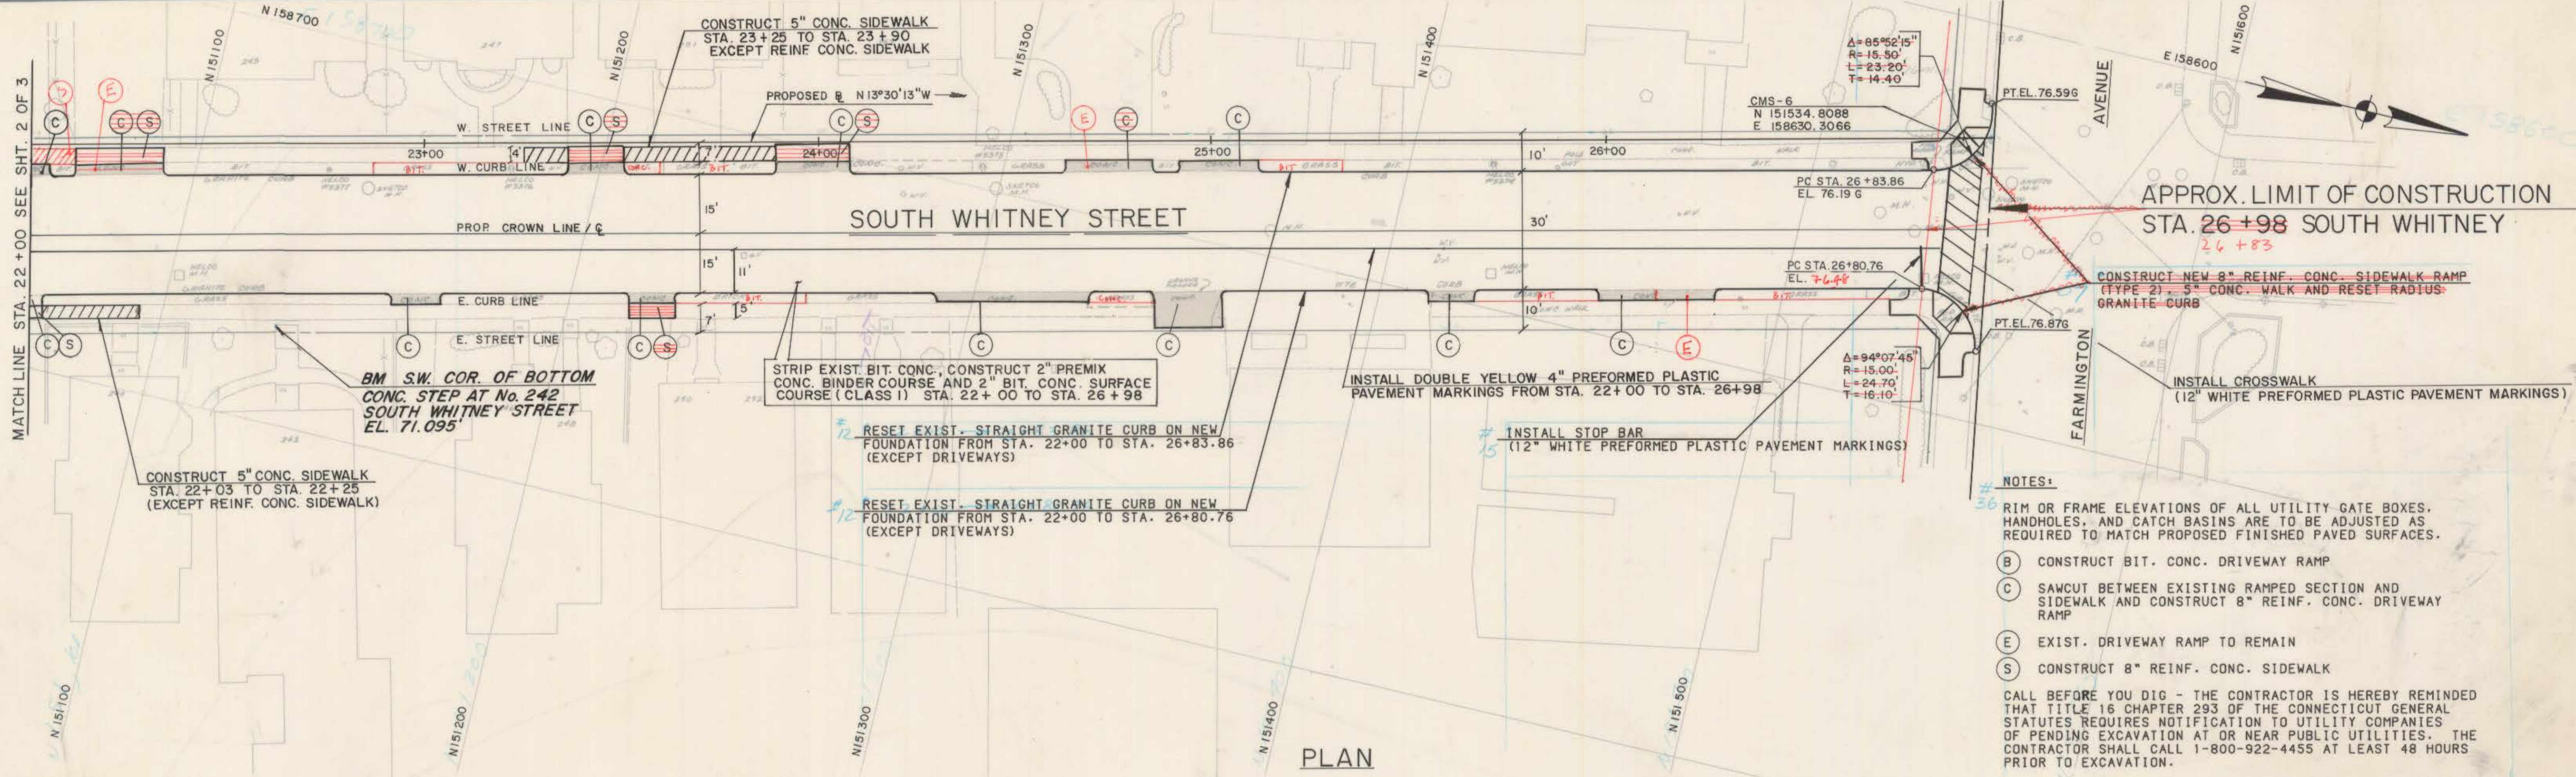

NO. DATE DESCRIPTION

REVISIONS

NOTE: AS BUILT (DATE) IN SLOPE ROAD

1/18/81 CHECKED BY JAC

1/18/81 AS-BUILT REVISION BY JAC/MDH

SUPV. JAC

DESIGN MDH/AEC

DRAWN M J N

CHECKED AEC

DATE 02-25-86

GRAPHIC SCALES

HORIZ. 1"=20'

VERT. 1"=2'

ROADWAY RECONSTRUCTION

HARTFORD, CONNECTICUT

Hayden | Wegman

Consulting Engineers

WEST HARTFORD

NEW YORK • BOSTON • BUFFALO

ATLANTA • MEMPHIS

CITY OF HARTFORD, CONNECTICUT

DEPARTMENT OF PUBLIC WORKS

BUREAU OF ENGINEERING SERVICES

DAYBOOK NO. 011013

DATE

SOUTH WHITNEY STREET

STA. 22+00 TO STA. 26+98

PLAN AND PROFILE

Contract No. E86-10 Job No. 852534

SHEET 3

OF 3