


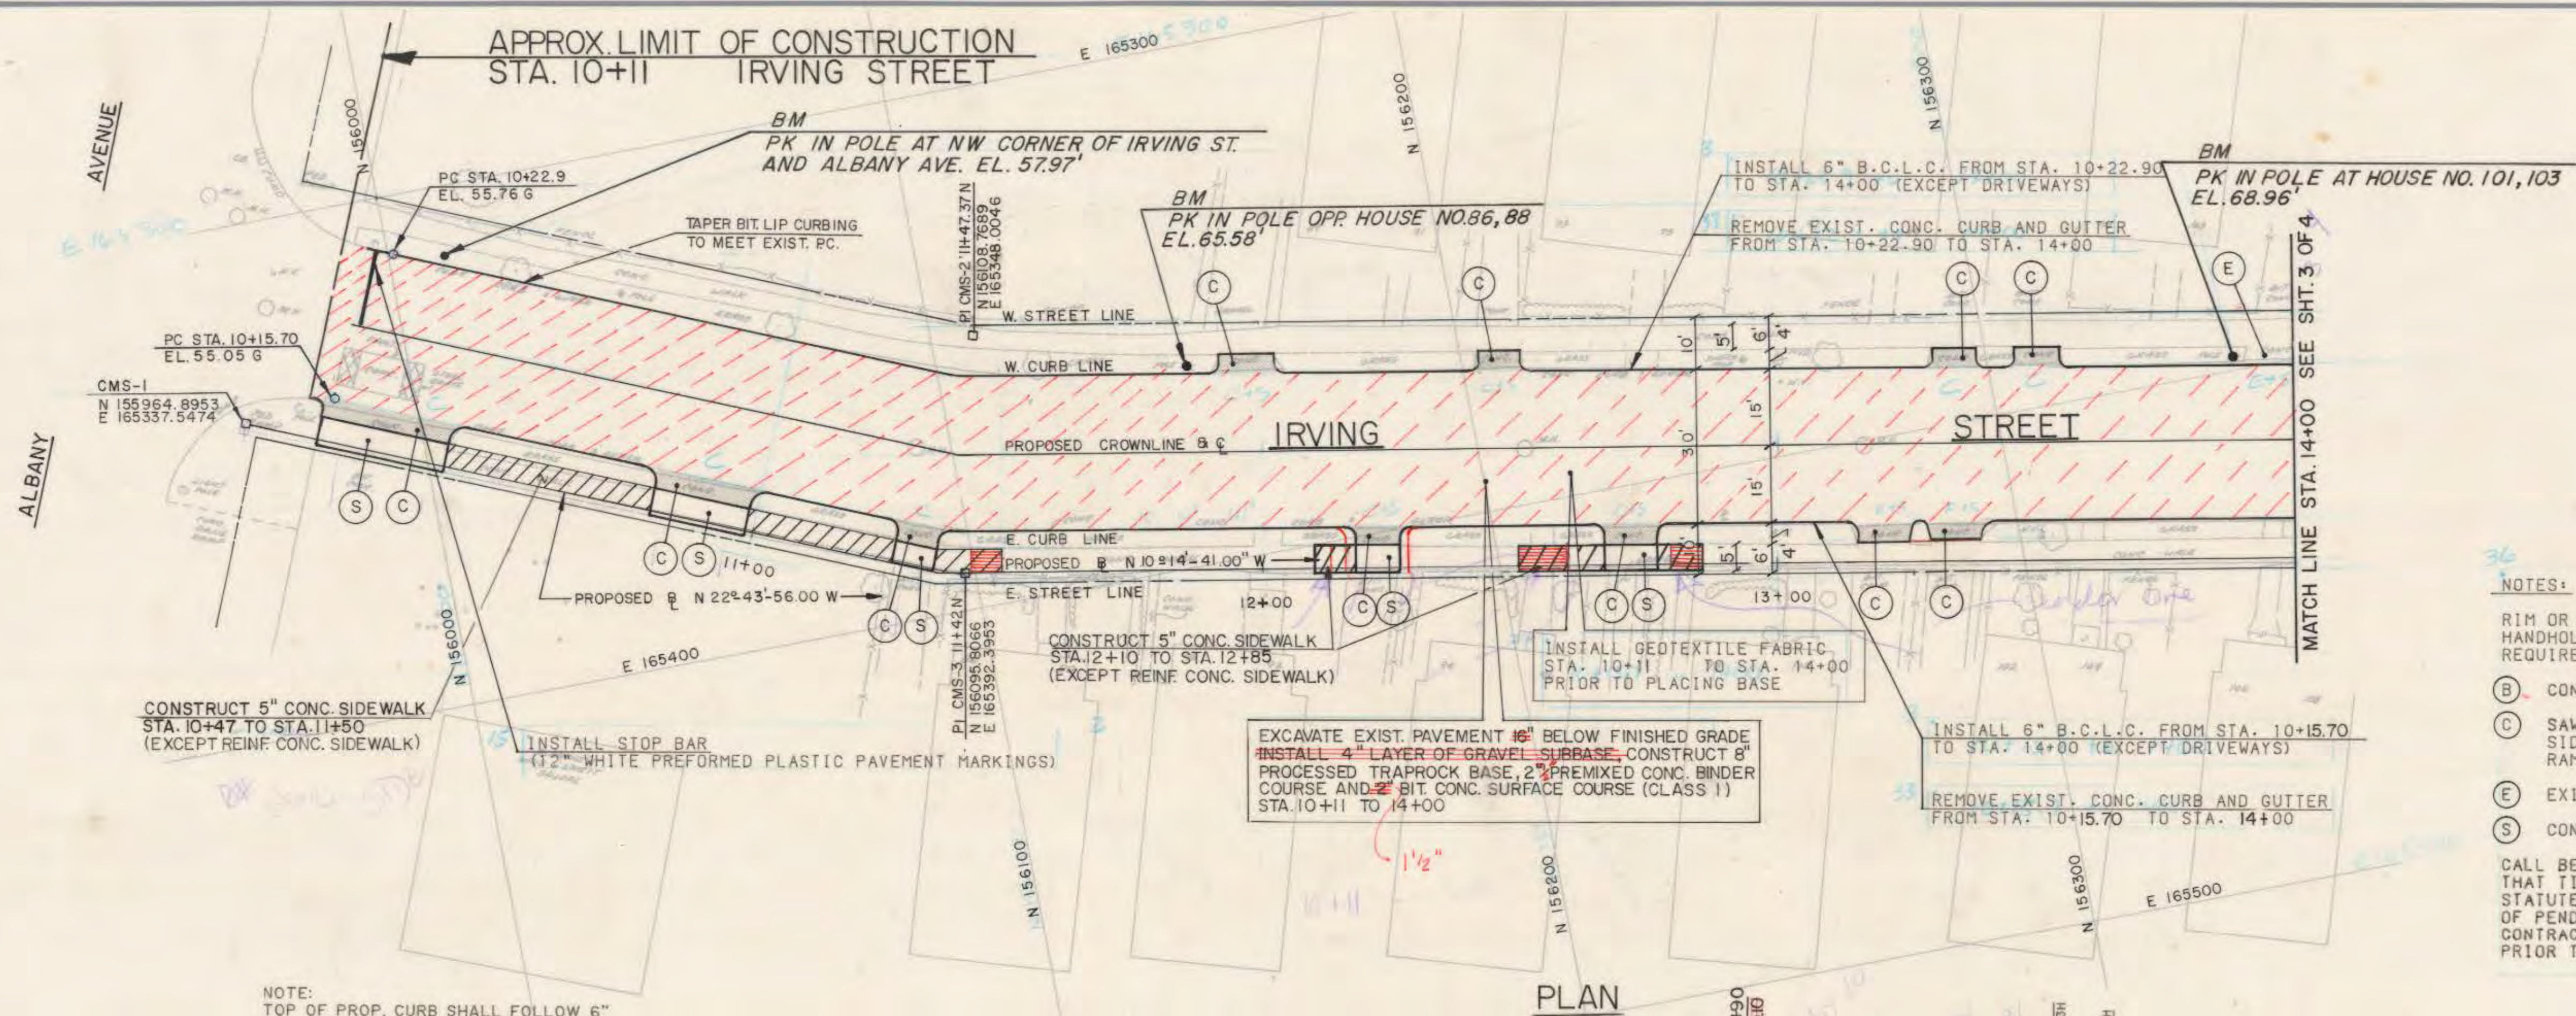


NOTES:

- (B) RIM OR FRAME ELEVATIONS OF ALL UTILITY GATE BOXES, HANDHOLES, AND CATCH BASINS ARE TO BE ADJUSTED AS REQUIRED TO MATCH PROPOSED FINISHED PAVED SURFACES.
 - (B) CONSTRUCT BIT. CONC. DRIVEWAY RAMP
 - (C) SAWCUT BETWEEN EXISTING RAMPED SECTION AND SIDEWALK AND CONSTRUCT 8" REINF. CONC. DRIVEWAY RAMP
 - (E) EXIST. DRIVEWAY RAMP TO REMAIN
 - (S) CONSTRUCT 8" REINF. CONC. SIDEWALK
- CALL BEFORE YOU DIG - THE CONTRACTOR IS HEREBY REMINDED THAT TITLE 16 CHAPTER 293 OF THE CONNECTICUT GENERAL STATUTES REQUIRES NOTIFICATION TO UTILITY COMPANIES OF PENDING EXCAVATION AT OR NEAR PUBLIC UTILITIES. THE CONTRACTOR SHALL CALL 1-800-922-4455 AT LEAST 48 HOURS PRIOR TO EXCAVATION.

NOTE:
TOP OF PROP. CURB SHALL FOLLOW 6"
ABOVE GUTTER GRADE (TYP.)

PLAN

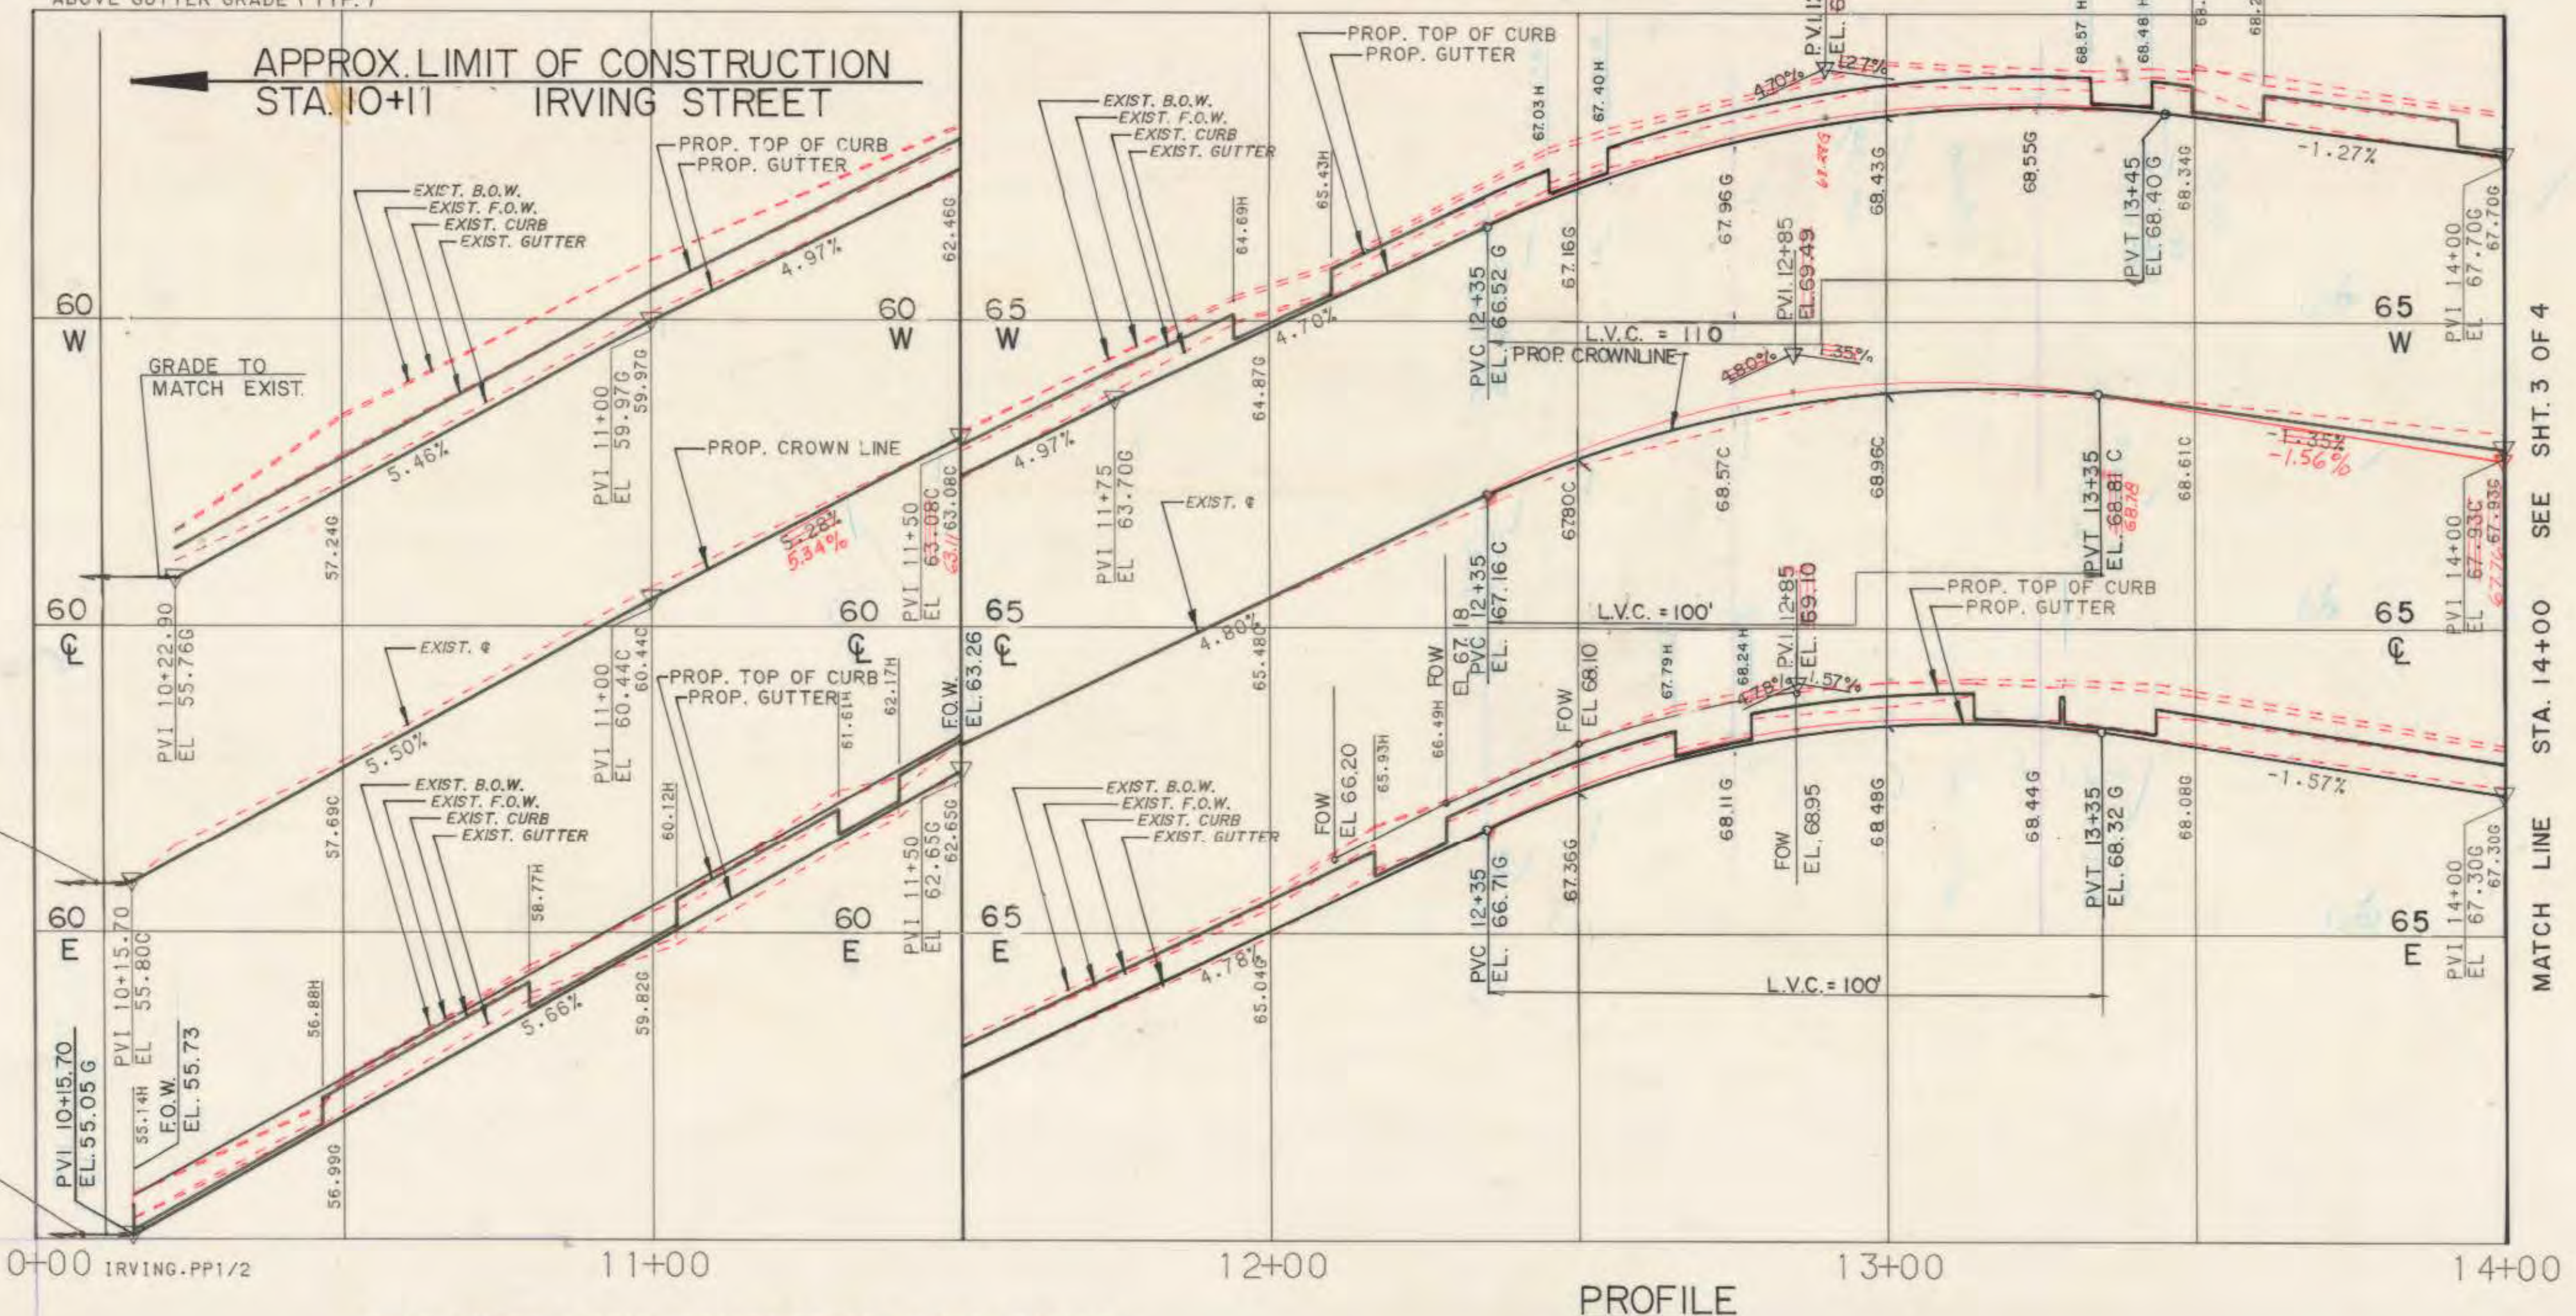

PROFILE

NOTE: CHECK GRAPHIC SCALES BEFORE USING DRAWINGS

AS BUILT - SOLID RED LINE	
HORIZONTAL AS BUILT BY: MDH	
VERTICAL AS BUILT BY: MGC	
CHECKED BY: MDH	
JAN 87	
NO.	DATE
REVISIONS	

SUPV.	JAC
DESIGN	MDH/AEC
DRAWN	N.D.FORTN
CHECKED	AEC
DATE	02-21-86

GRAPHIC SCALES	
HORIZ.	1" = 20'
VERT.	1" = 2'

ROADWAY RECONSTRUCTION
HARTFORD, CONNECTICUT



Hayden | Wegman
Consulting Engineers
WEST HARTFORD
NEW YORK • BOSTON • BUFFALO
ATLANTA • MEMPHIS

CITY OF HARTFORD, CONNECTICUT
DEPARTMENT OF PUBLIC WORKS
BUREAU OF ENGINEERING SERVICES

DAYBOOK NO. 01015
DATE

IRVING STREET
STA. 10+11 TO STA. 14+00

PLAN AND PROFILE
Contract No. E-86-12 Job No. 852534

SHEET 2
OF 4