
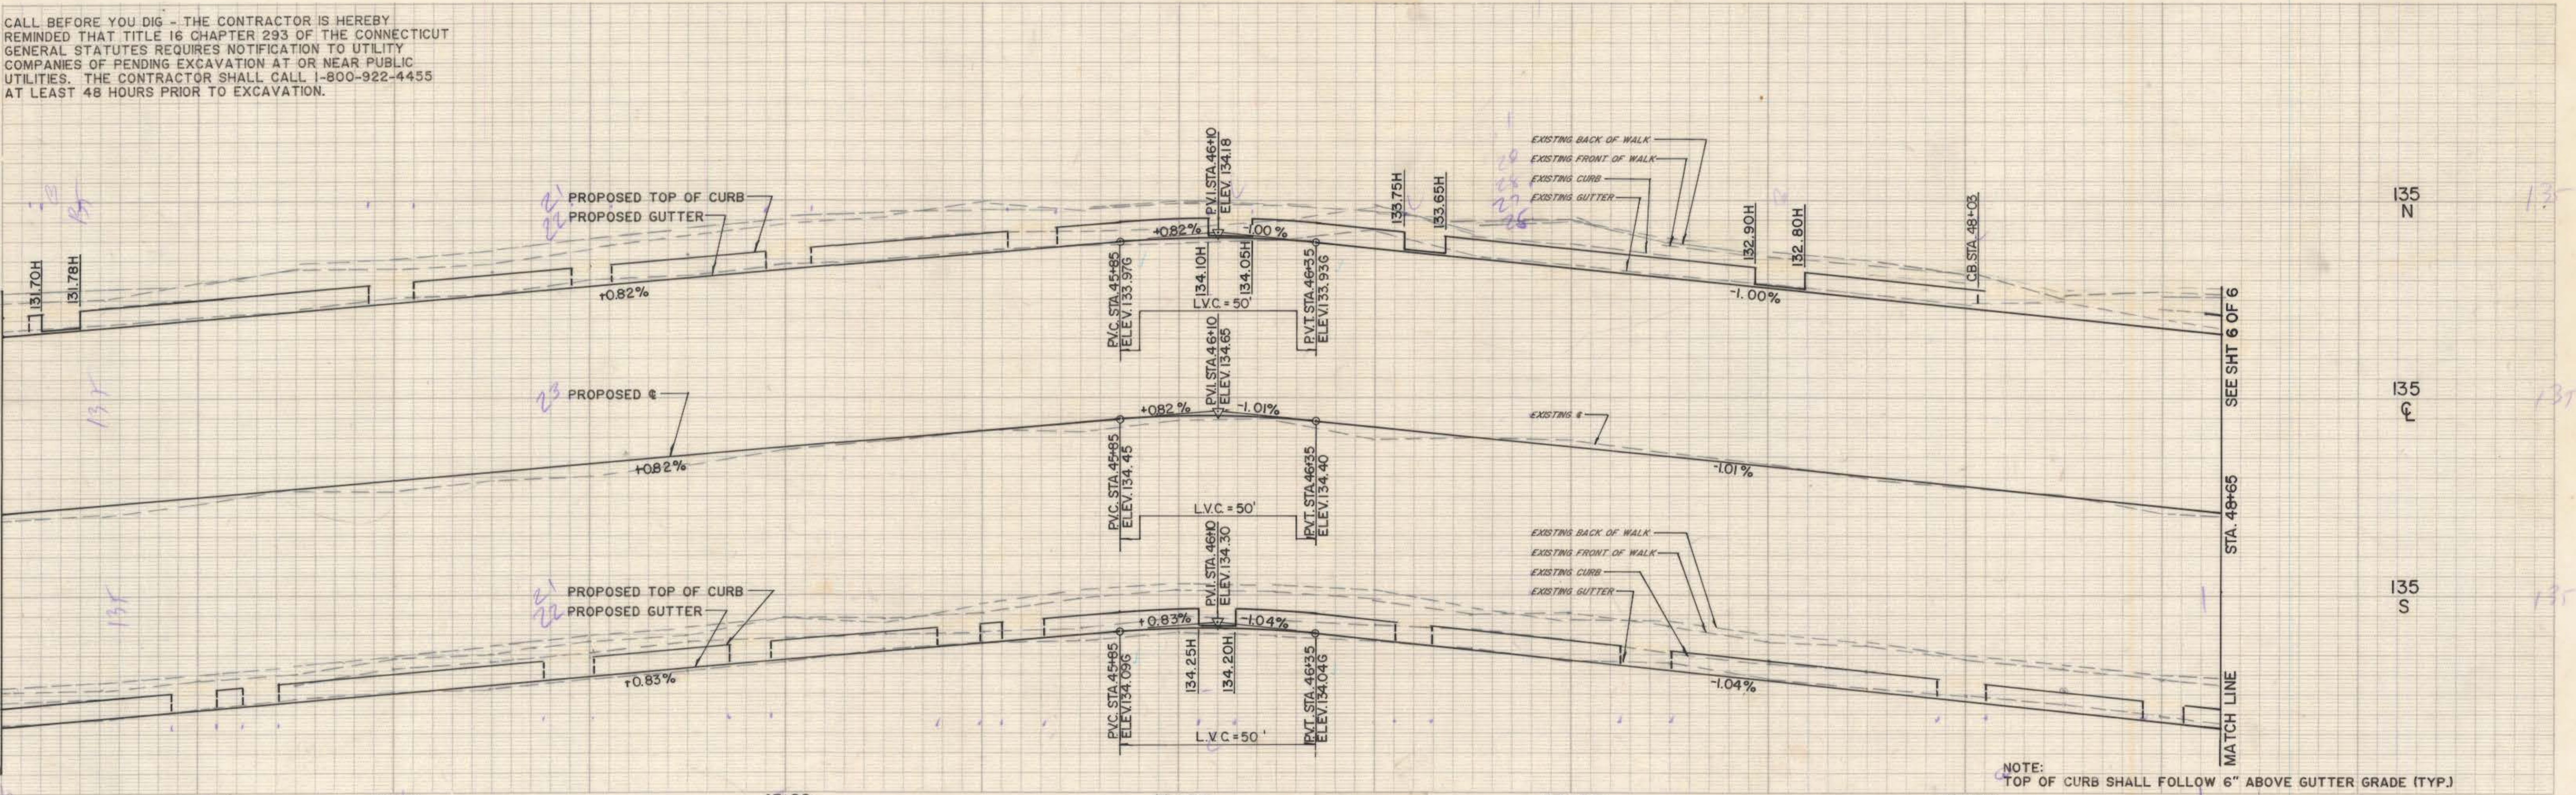


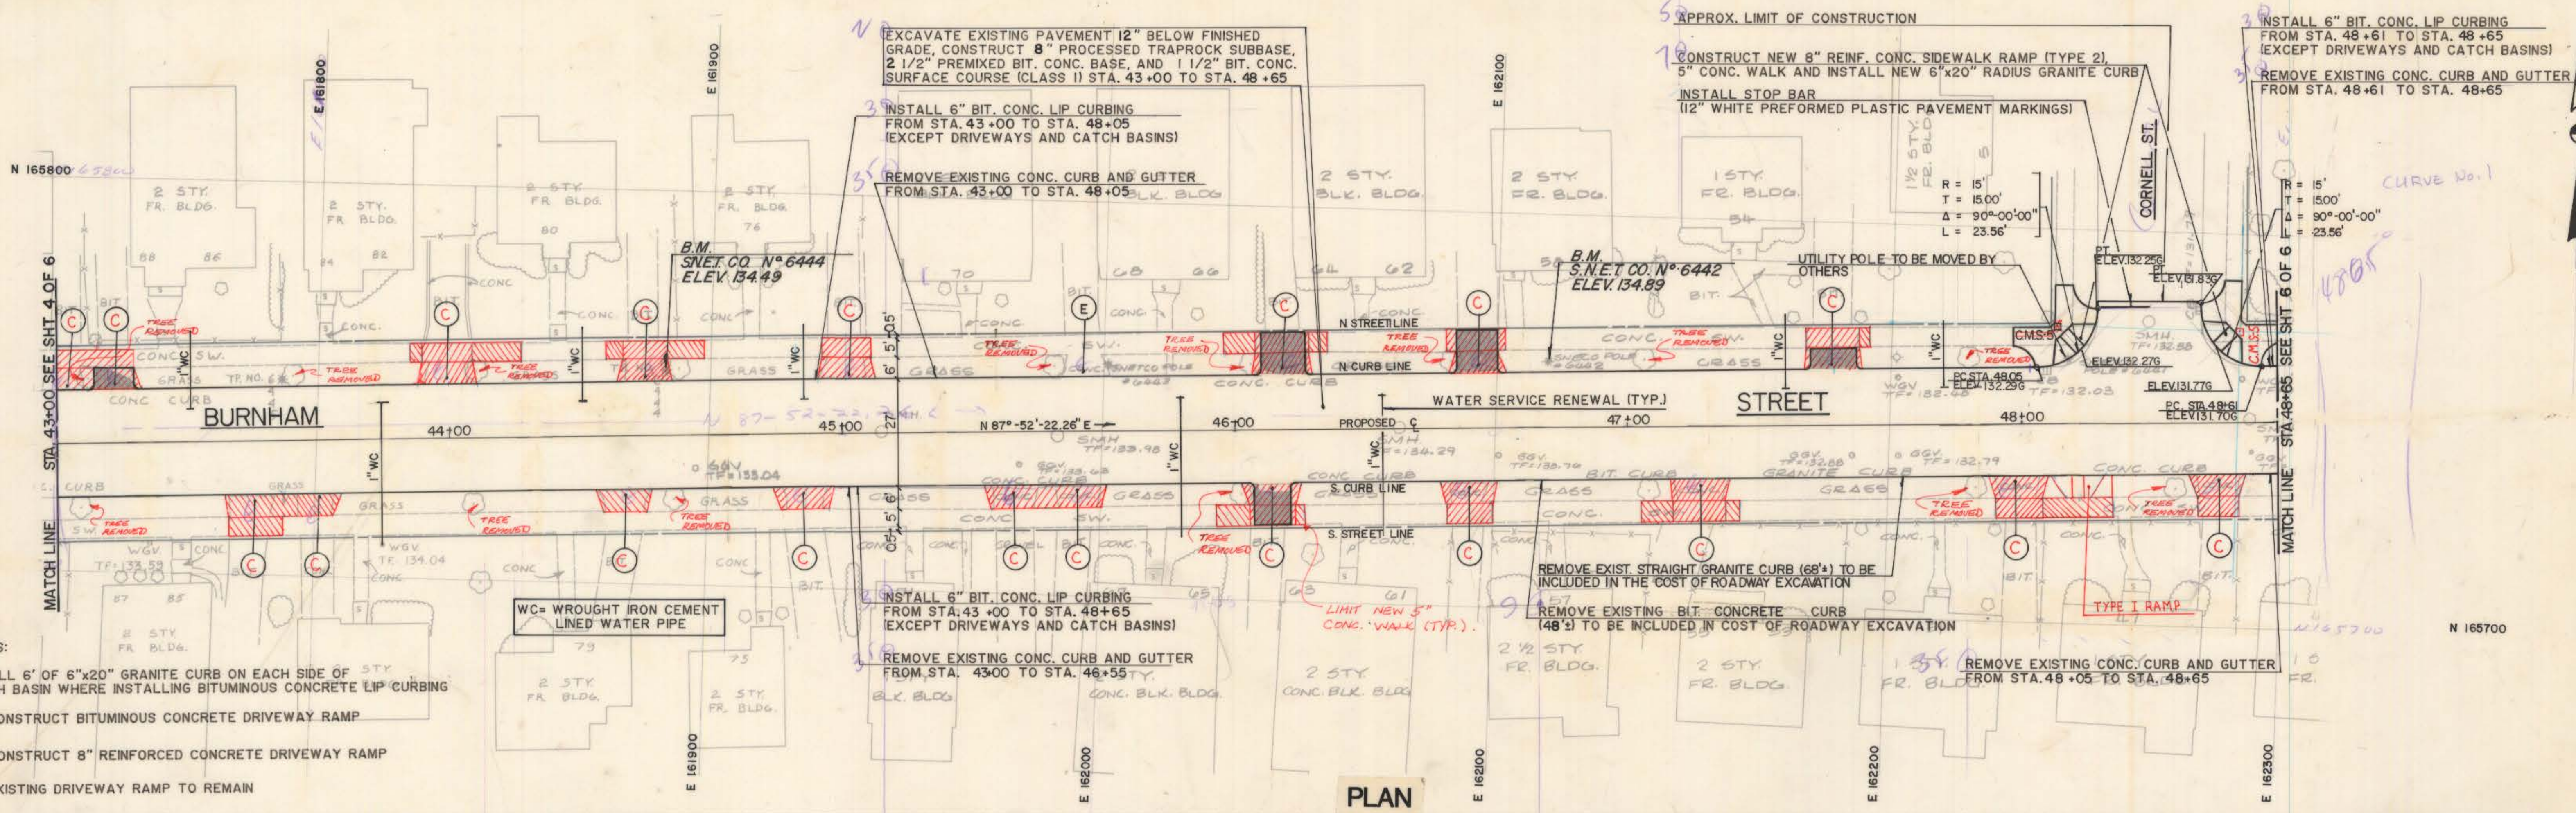

SUPV. ARW DESIGN MDH/AEC DRAWN OK CHECKED JAC DATE 6/17/85		GRAPHIC SCALES HORIZ. 1" = 20' VERT. 1" = 2'	ROADWAY RECONSTRUCTION HARTFORD, CONNECTICUT		Hayden Wegman Consulting Engineers WEST HARTFORD NEW YORK • BOSTON • BUFFALO ATLANTA • MEMPHIS	CITY OF HARTFORD, CONNECTICUT DEPARTMENT OF PUBLIC WORKS BUREAU OF ENGINEERING SERVICES	BURNHAM STREET STA. 43-00 TO STA. 48-65 PLAN AND PROFILE Contract # E85-29 Job No. - 845304									
REVISIONS <table border="1" style="width:100%; border-collapse: collapse;"> <thead> <tr> <th>NO.</th> <th>DATE</th> <th>DESCRIPTION</th> </tr> </thead> <tbody> <tr> <td>1</td> <td>DEC 78</td> <td>CHECKED BY MDH</td> </tr> <tr> <td>2</td> <td>NOT 80</td> <td>AS-BUILT BY JAC</td> </tr> </tbody> </table>		NO.	DATE	DESCRIPTION	1	DEC 78	CHECKED BY MDH	2	NOT 80	AS-BUILT BY JAC					DRAWN _____ CHECKED _____ SCALE _____ DAYBOOK NO. _____ DATE _____	SHEET 5 OF 6
NO.	DATE	DESCRIPTION														
1	DEC 78	CHECKED BY MDH														
2	NOT 80	AS-BUILT BY JAC														