



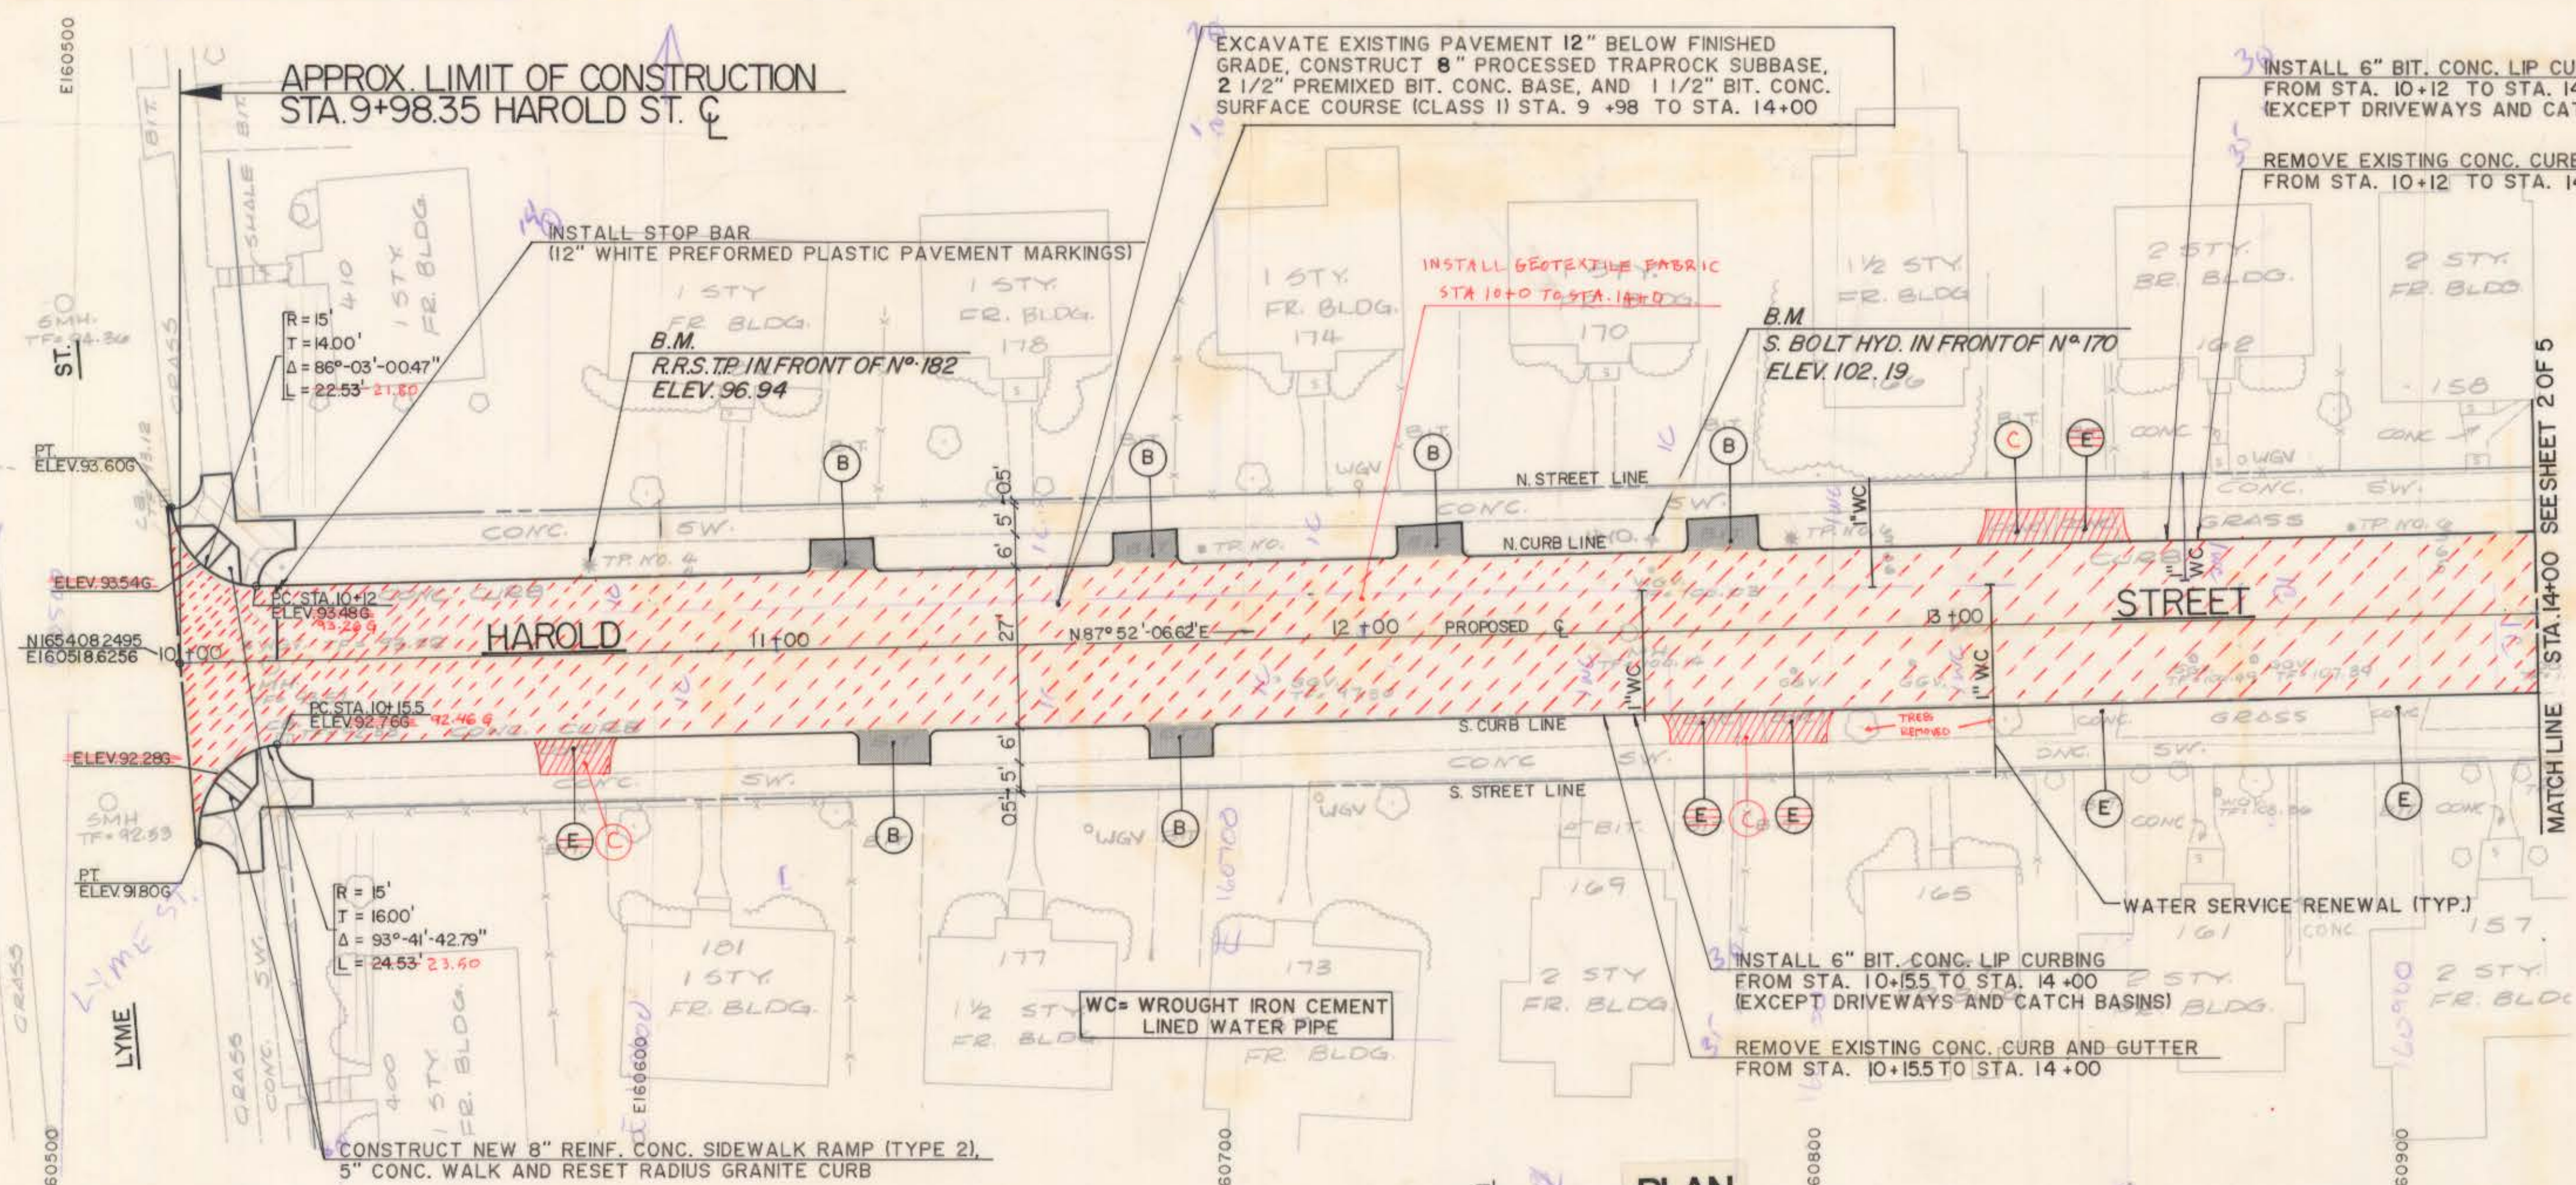

- NOTES:
- INSTALL 6" OF 6"x20" GRANITE CURB ON EACH SIDE OF CATCH BASIN WHERE INSTALLING BITUMINOUS CONCRETE LIP CURBING
 - CONSTRUCT BITUMINOUS CONCRETE DRIVEWAY RAMP
 - CONSTRUCT 8" REINFORCED CONCRETE DRIVEWAY RAMP
 - EXISTING DRIVEWAY RAMP TO REMAIN
 - CONSTRUCT 8" REINF. CONC. SIDEWALK
- CALL BEFORE YOU DIG - THE CONTRACTOR IS HEREBY REMINDED THAT TITLE 16 CHAPTER 293 OF THE CONNECTICUT GENERAL STATUTES REQUIRES NOTIFICATION TO UTILITY COMPANIES OF PENDING EXCAVATION AT OR NEAR PUBLIC UTILITIES. THE CONTRACTOR SHALL CALL 1-800-922-4455 AT LEAST 48 HOURS PRIOR TO EXCAVATION.

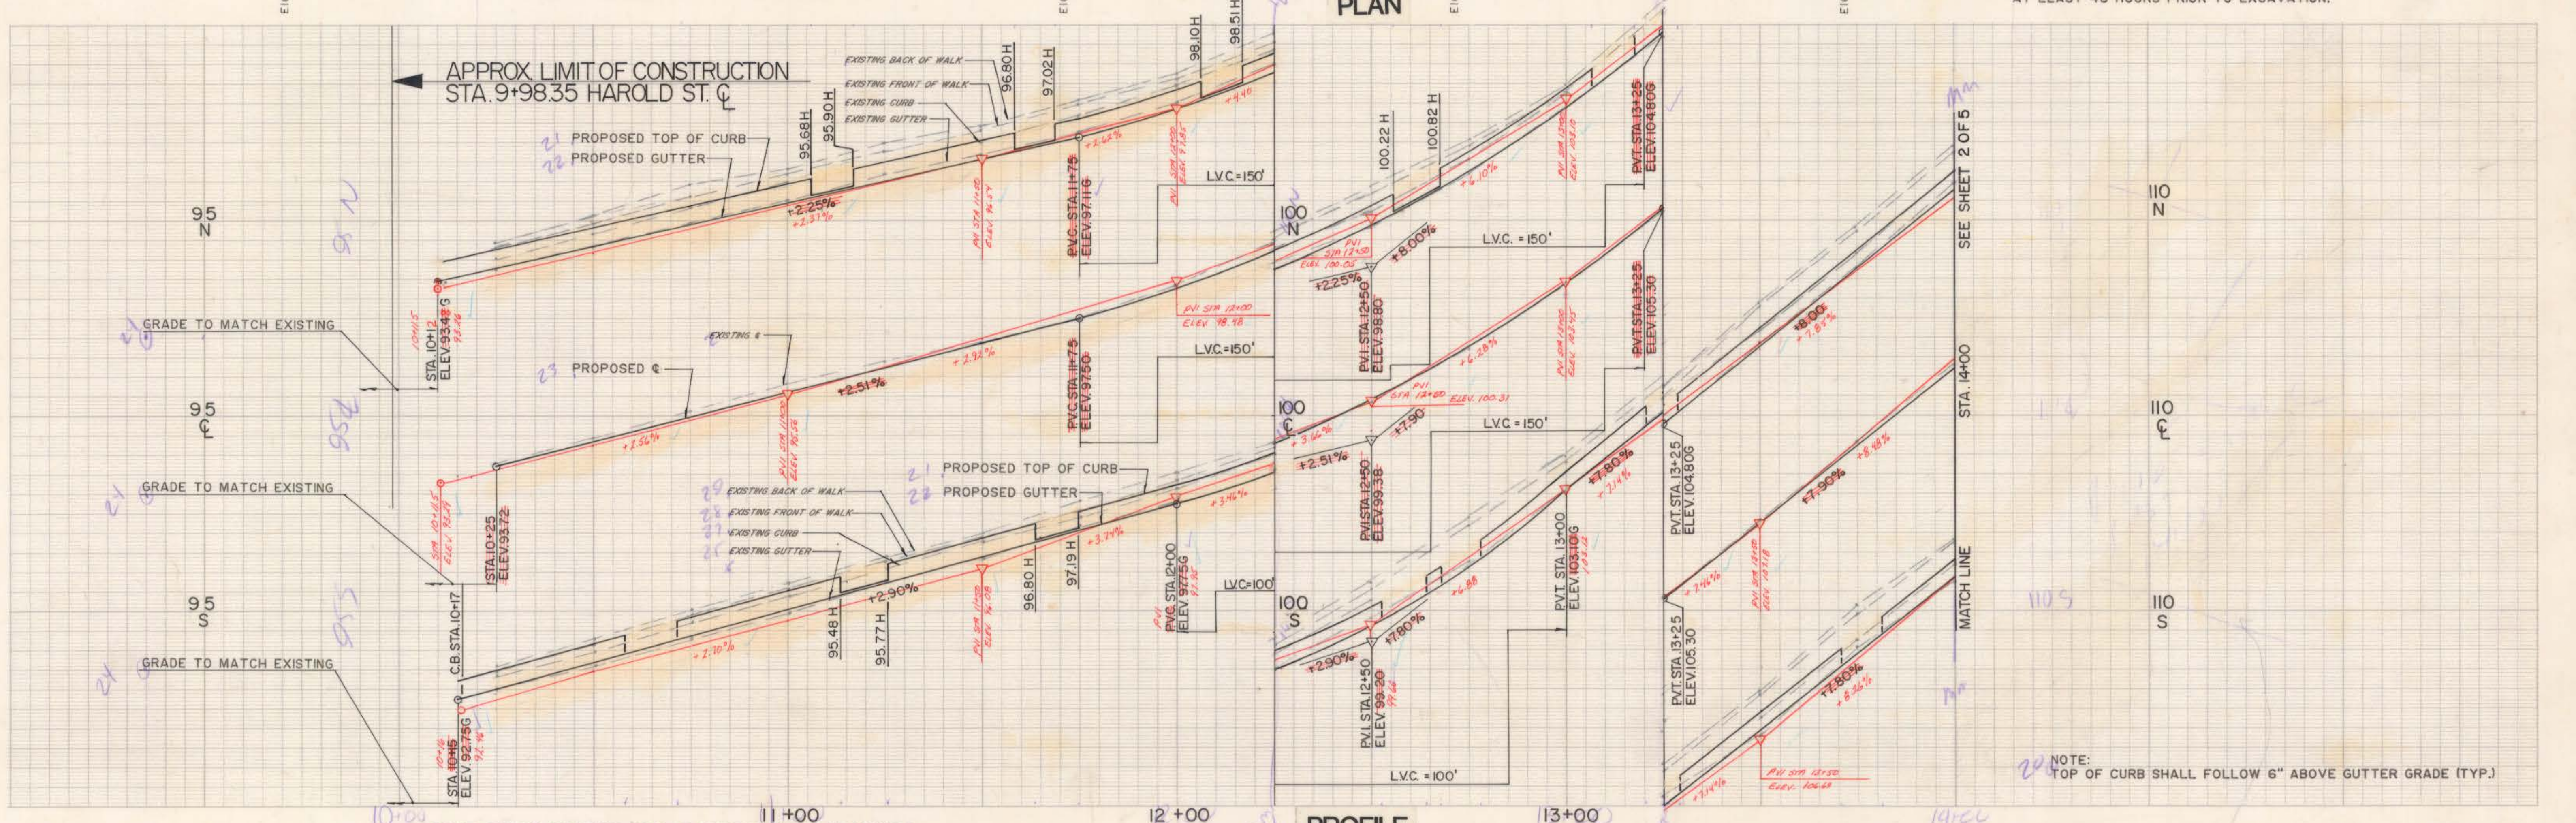

REVISIONS NO. DATE DESCRIPTION 1 10/1/87 ADD GEO-TEX-AS BUILTS - DRAFTED BY NIN 2 JAN 87 CHECKED BY NIN 3 DEC 86 ADD BUILT TO DATE		SUPV. ARW DESIGN MDH/AEC DRAWN CEI CHECKED JAC DATE 6/17/85	GRAPHIC SCALES HORIZ. 1"=20' VERT. 1"=2' ROADWAY RECONSTRUCTION HARTFORD, CONNECTICUT	 Hayden Wegman Consulting Engineers WEST HARTFORD NEW YORK • BOSTON • BUFFALO ATLANTA • MEMPHIS	CITY OF HARTFORD, CONNECTICUT DEPARTMENT OF PUBLIC WORKS BUREAU OF ENGINEERING SERVICES DRAWN _____ CHECKED _____ SCALE _____ DAYBOOK NO. 010948. DATE _____	HAROLD STREET STA. 9-98.35 TO STA. 14-00 PLAN AND PROFILE Contract E85-29 Job No. 845304 OF 5
---	--	--	---	---	--	--