
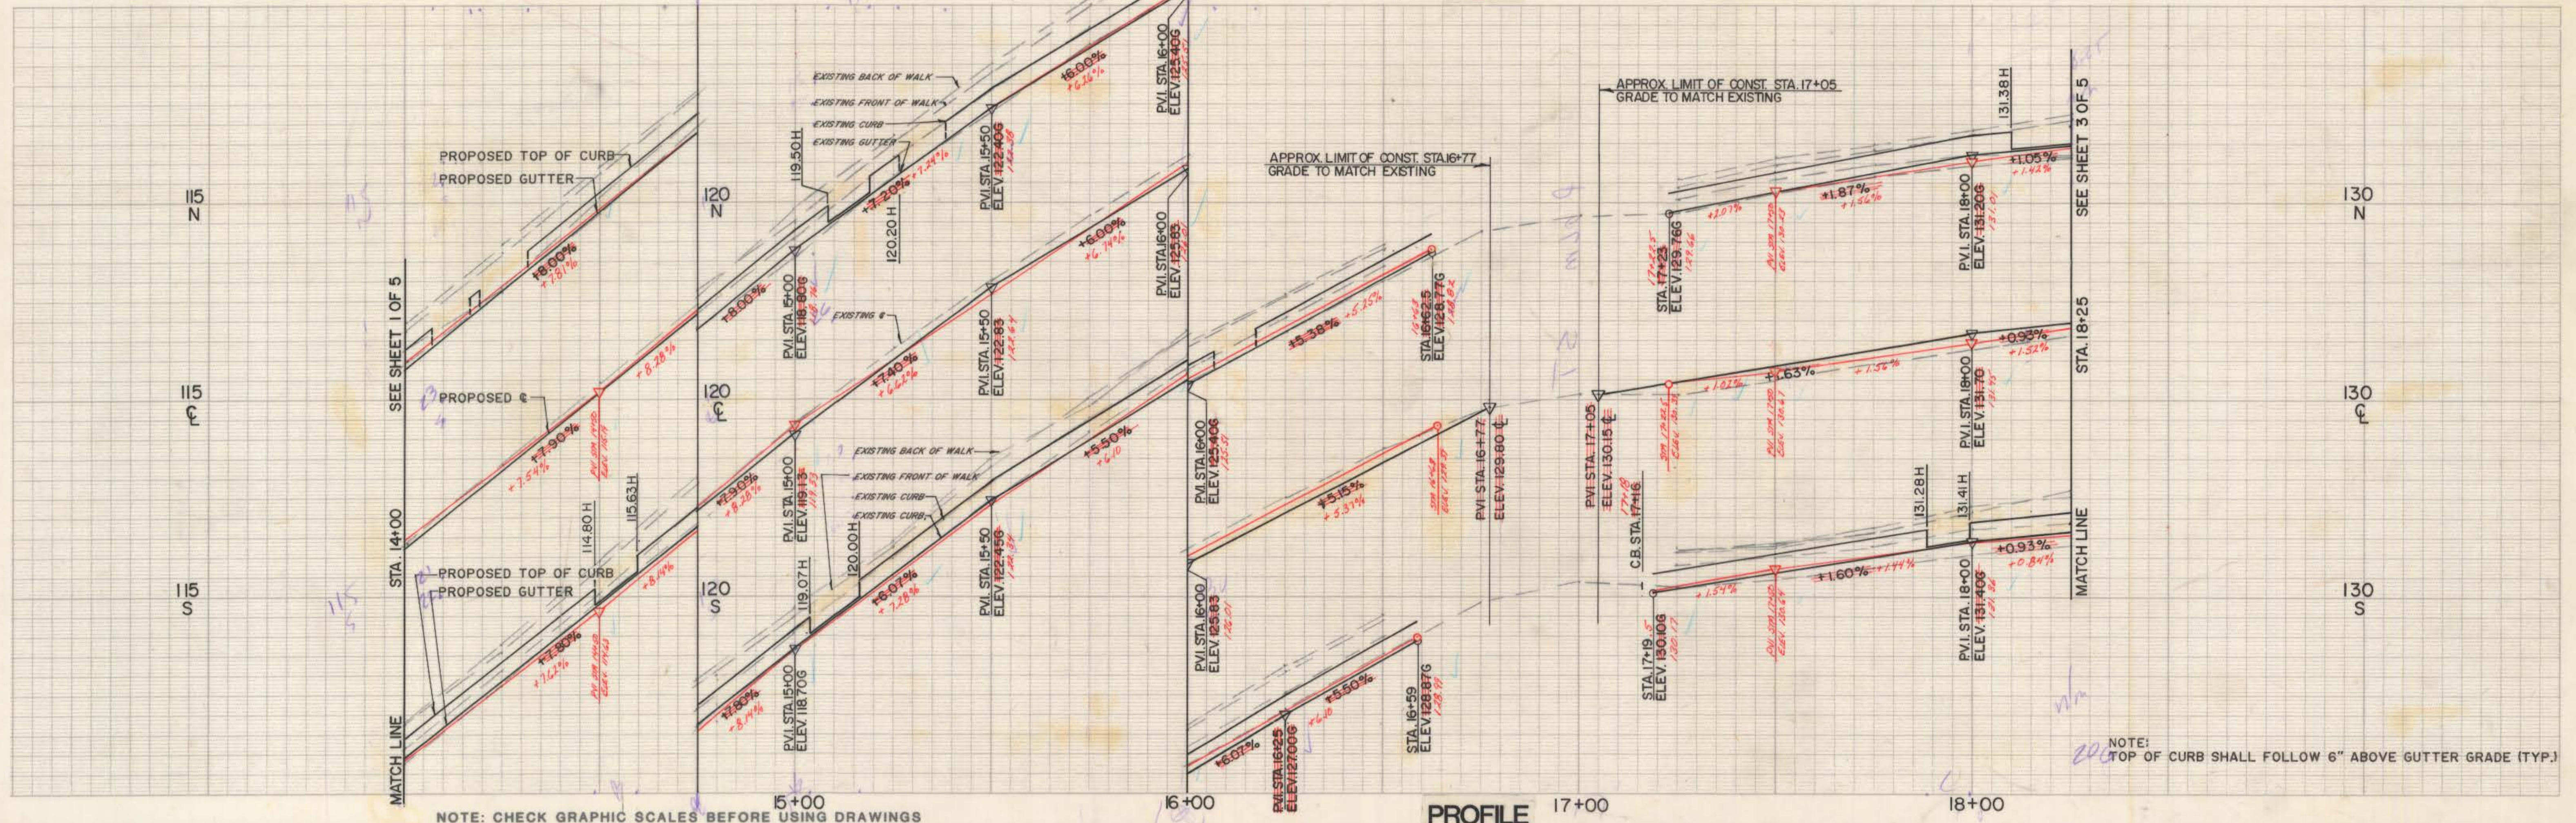


- NOTES:
- INSTALL 6" OF 6"x20" GRANITE CURB ON EACH SIDE OF CATCH BASIN WHERE INSTALLING BITUMINOUS CONCRETE LIP CURBING
- (B) CONSTRUCT BITUMINOUS CONCRETE DRIVEWAY RAMP
- (C) CONSTRUCT 8" REINFORCED CONCRETE DRIVEWAY RAMP
- (E) EXISTING DRIVEWAY RAMP TO REMAIN
- (S) **CONSTRUCT 8" REINF. CONC. SIDEWALK**
- CALL BEFORE YOU DIG - THE CONTRACTOR IS HEREBY REMINDED THAT TITLE 16 CHAPTER 293 OF THE CONNECTICUT GENERAL STATUTES REQUIRES NOTIFICATION TO UTILITY COMPANIES OF PENDING EXCAVATION AT OR NEAR PUBLIC UTILITIES. THE CONTRACTOR SHALL CALL 1-800-922-4455 AT LEAST 48 HOURS PRIOR TO EXCAVATION.

N165500

N165400

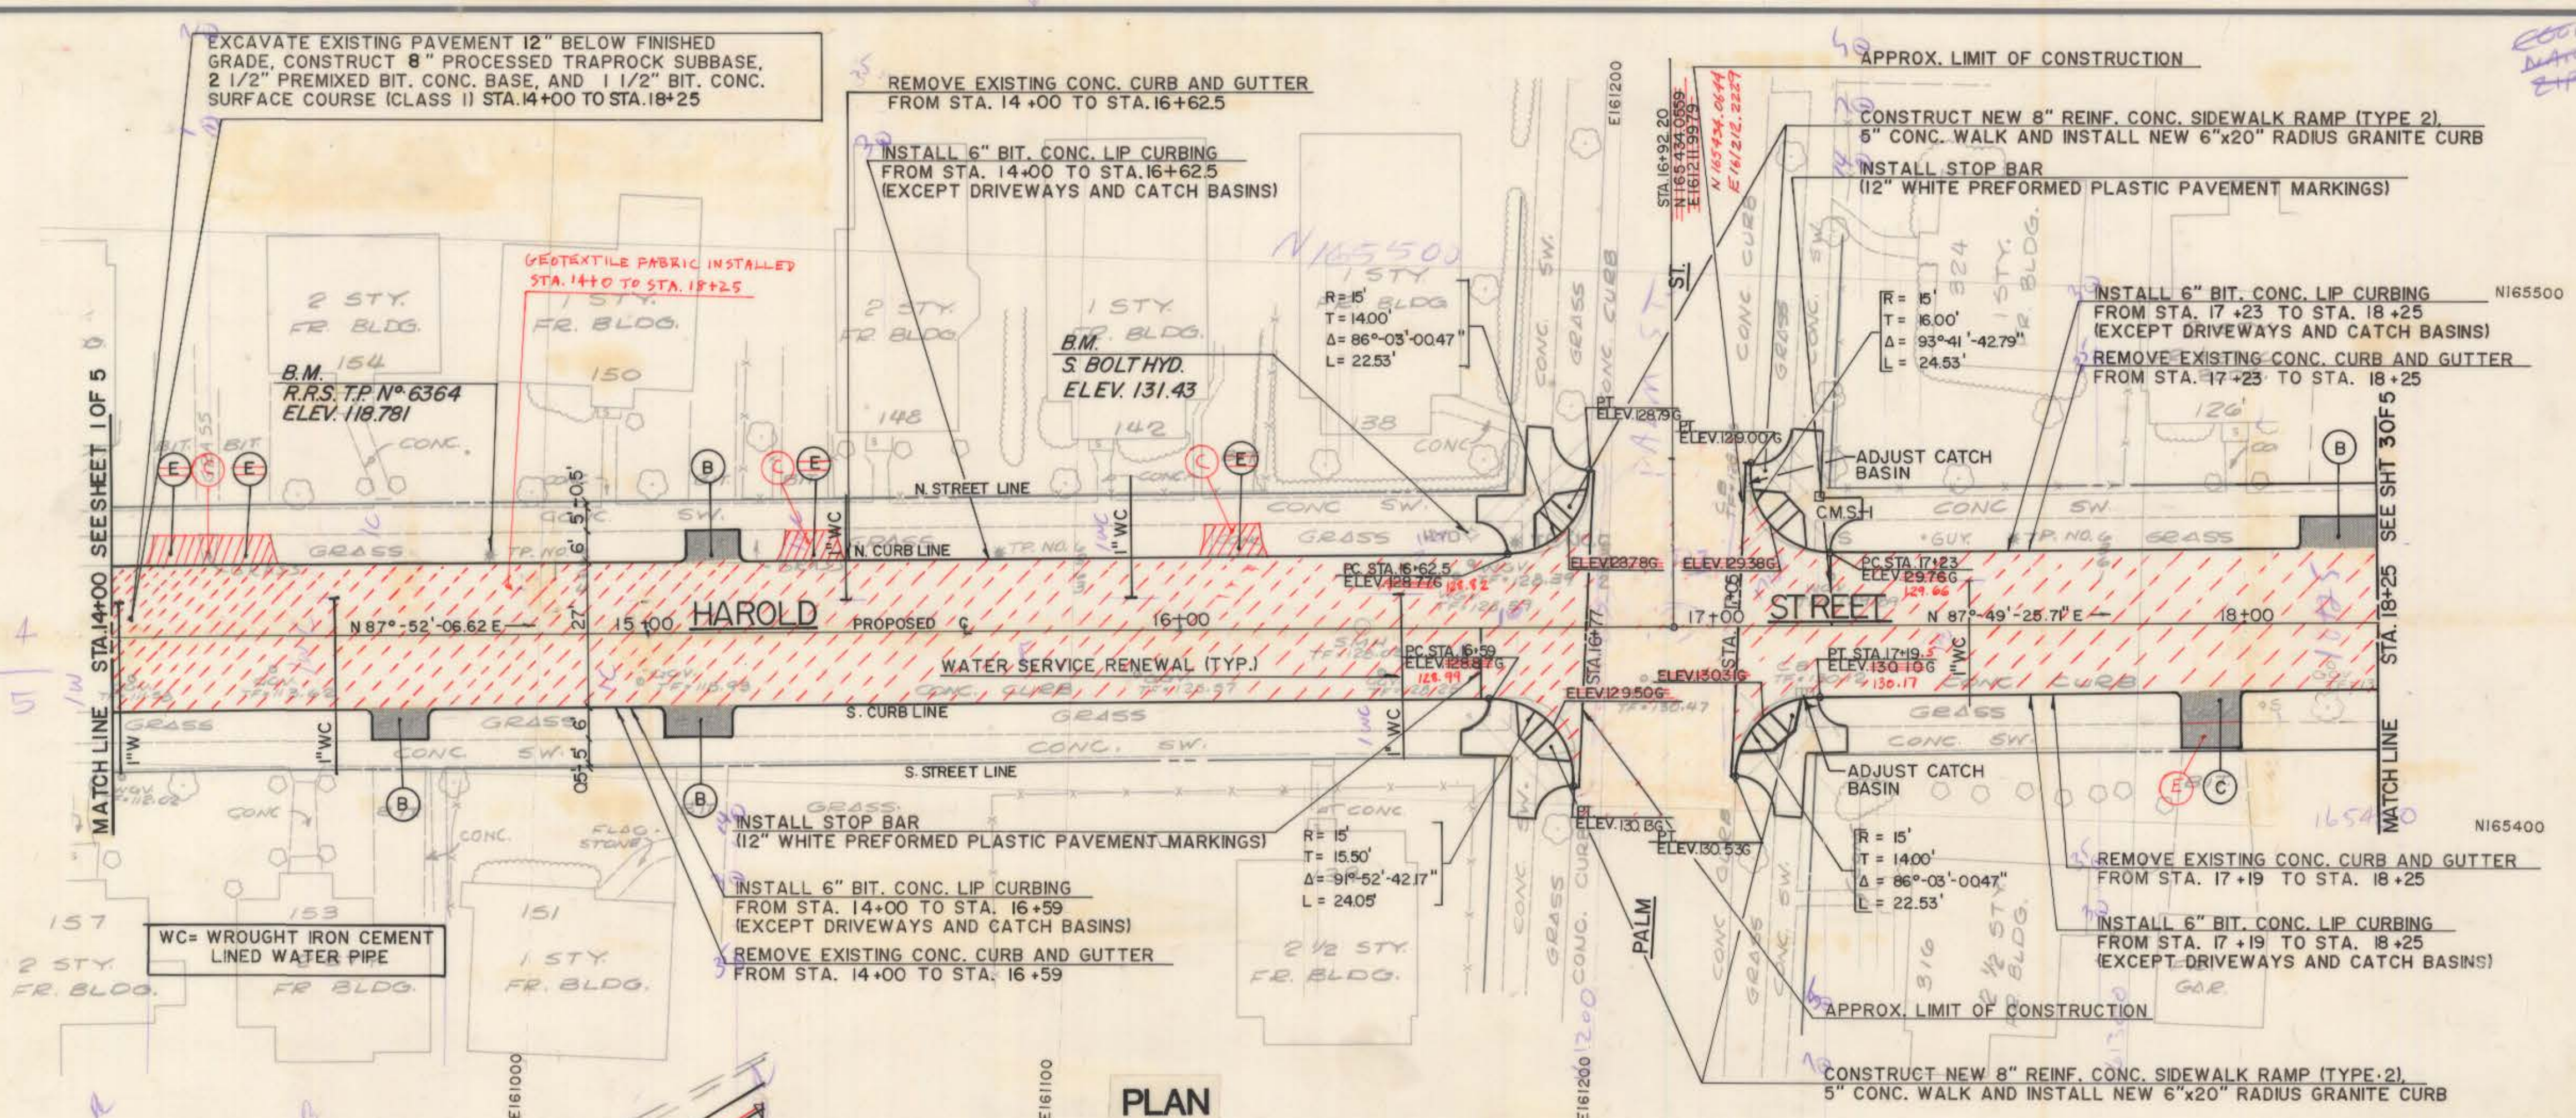

NO.	DATE	DESCRIPTION
1	1/10/84	ADD GEO-TEXT. AS BUILTS - DRAFTED BY: MTH
2	JAN 85	DESIGNED BY: MDH
3	DEC 84	AS-BUILT BY: MTH

SUPV.	ARW
DESIGN	MDH/AEC
DRAWN	MDH
CHECKED	JAC
DATE	6/17/85

GRAPHIC SCALES
HORIZ. 1" = 20'
VERT. 1" = 2'

ROADWAY RECONSTRUCTION
HARTFORD, CONNECTICUT



Hayden | Wegman
Consulting Engineers

WEST HARTFORD
NEW YORK • BOSTON • BUFFALO
ATLANTA • MEMPHIS

CITY OF HARTFORD, CONNECTICUT
DEPARTMENT OF PUBLIC WORKS
BUREAU OF ENGINEERING SERVICES

DRAWN
CHECKED
SCALE
DAYBOOK NO. 010948
DATE

HAROLD STREET

STA. 14-00 TO STA. 18-25

PLAN AND PROFILE

Contract #E85-37.29 Job No. 845304 OF 5