
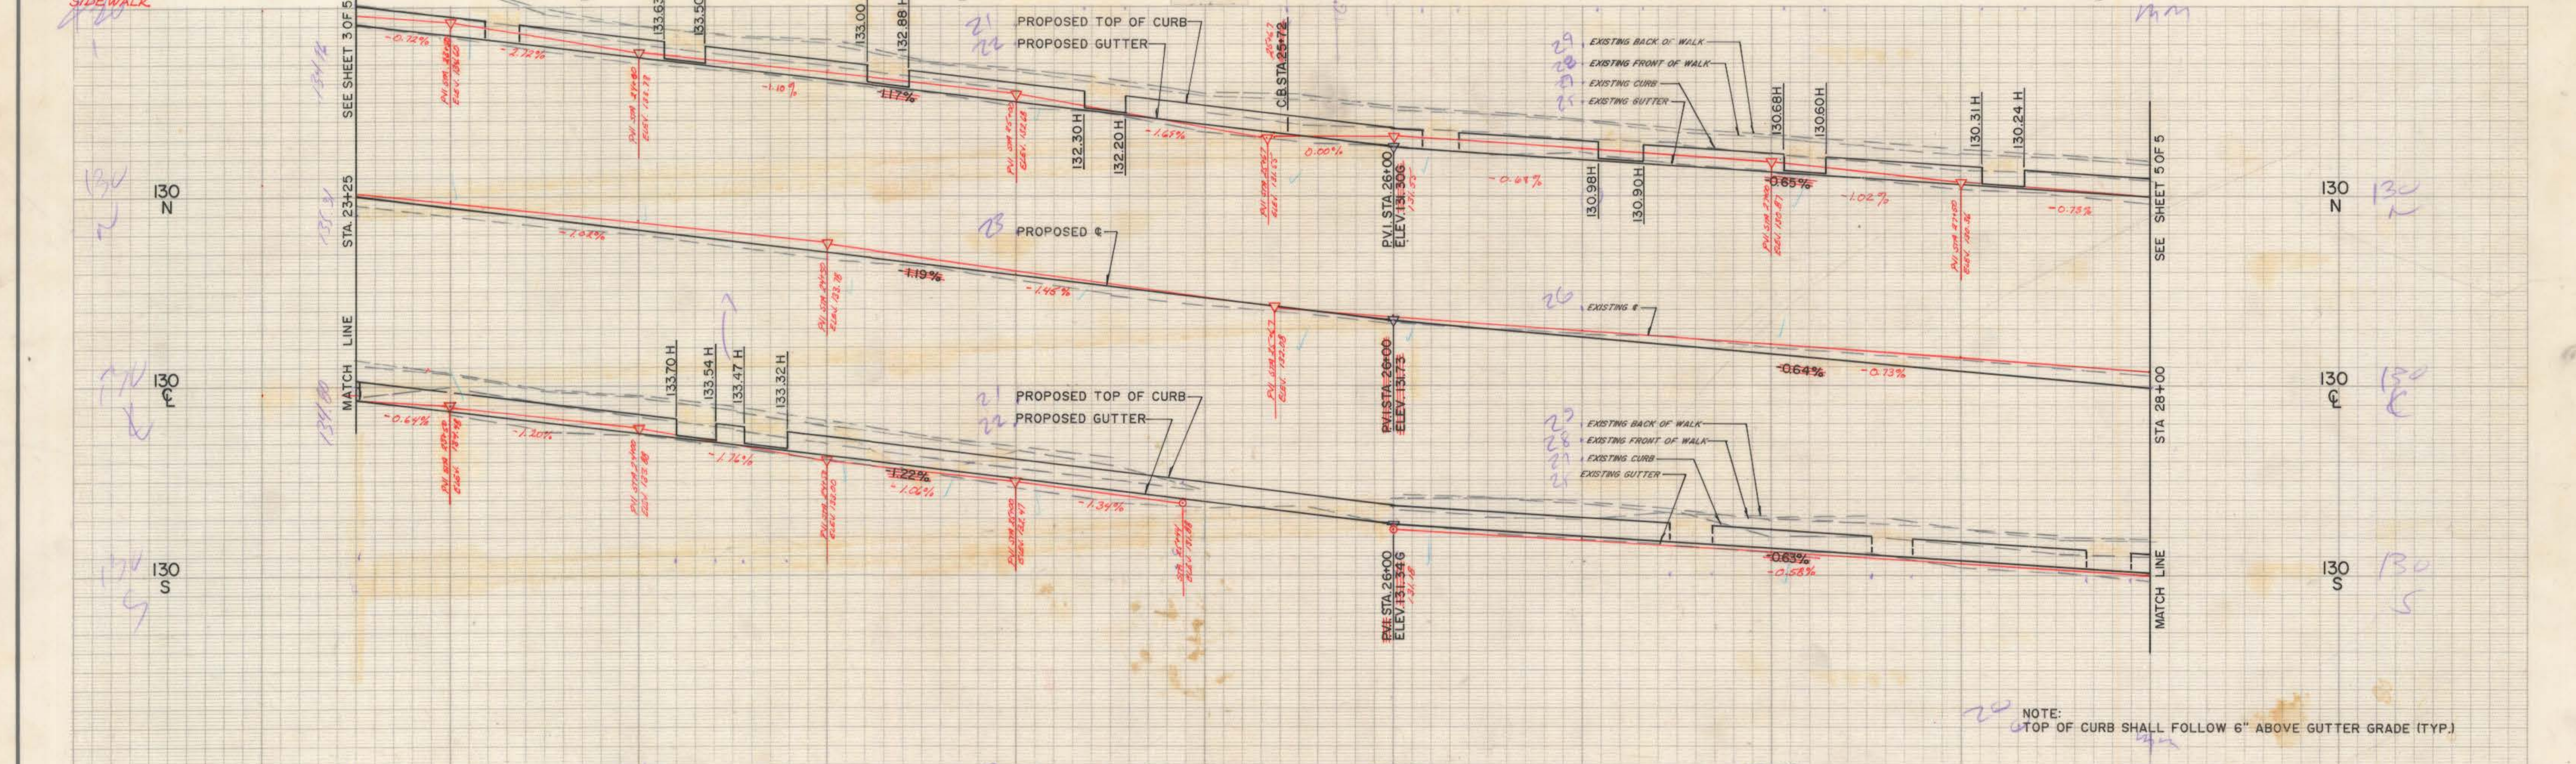


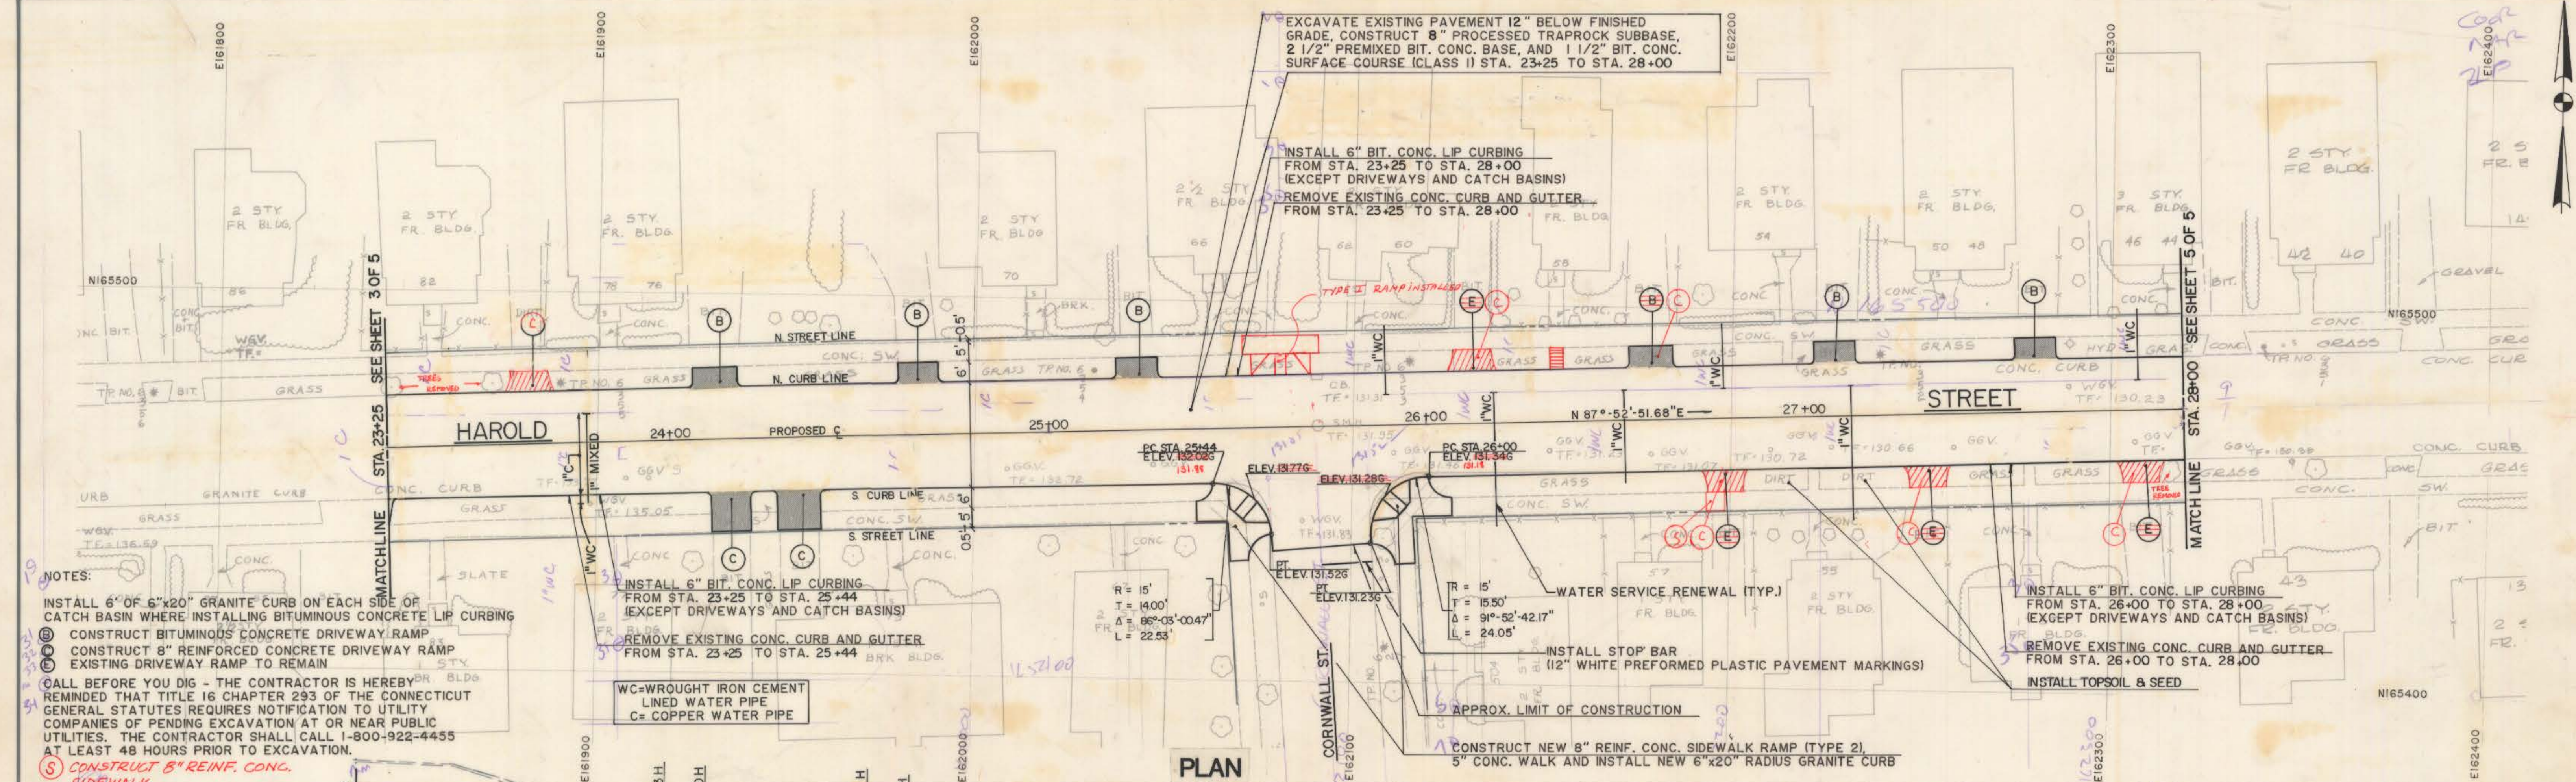

REVISIONS		NO. DATE DESCRIPTION	
3	1/17/87	ADD GUT-TEX. AS BUILTS. DRAFTED BY: MTH	
2	1/17/87	REVISION 301 MTH	
1	1/17/87	AS BUILT BY: MTH	

SUPV. ARW	DESIGN MDH/AEC	DRAWN JAC	CHECKED JAC
DATE 6/17/85			

GRAPHIC SCALES	
HORIZ. 1"=20'	VERT. 1"=2'

ROADWAY RECONSTRUCTION HARTFORD, CONNECTICUT	
---	--

Hayden Wegman Consulting Engineers	
WEST HARTFORD NEW YORK • BOSTON • BUFFALO ATLANTA • MEMPHIS	

CITY OF HARTFORD, CONNECTICUT DEPARTMENT OF PUBLIC WORKS BUREAU OF ENGINEERING SERVICES	
--	--

HAROLD STREET STA 23-25 TO STA 28-00	
PLAN AND PROFILE	
Contract E85-29	Job No.- 845304

DRAWN CHECKED	SCALE DATE	DAYBOOK NO 010948
-------------------------	----------------------	--------------------------

SHEET 4	OF 5
----------------	-------------