
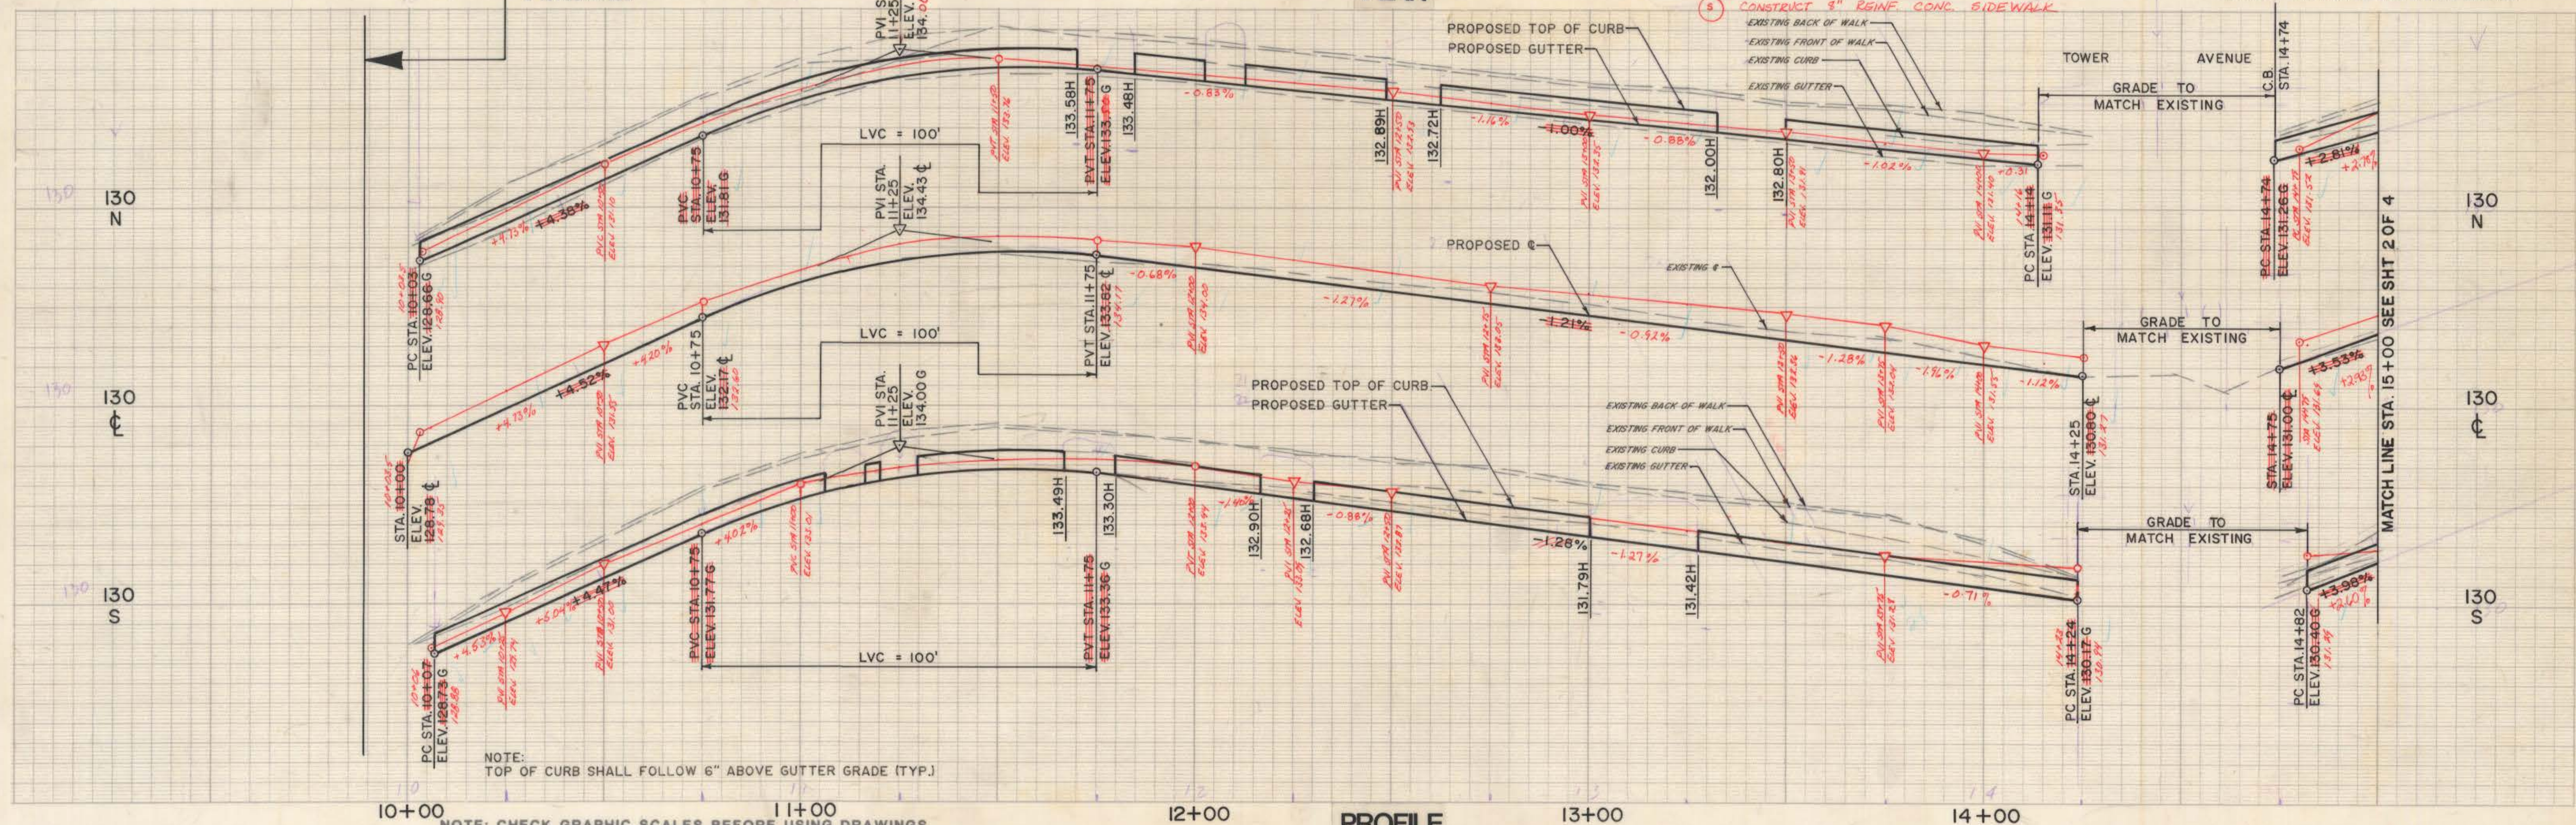


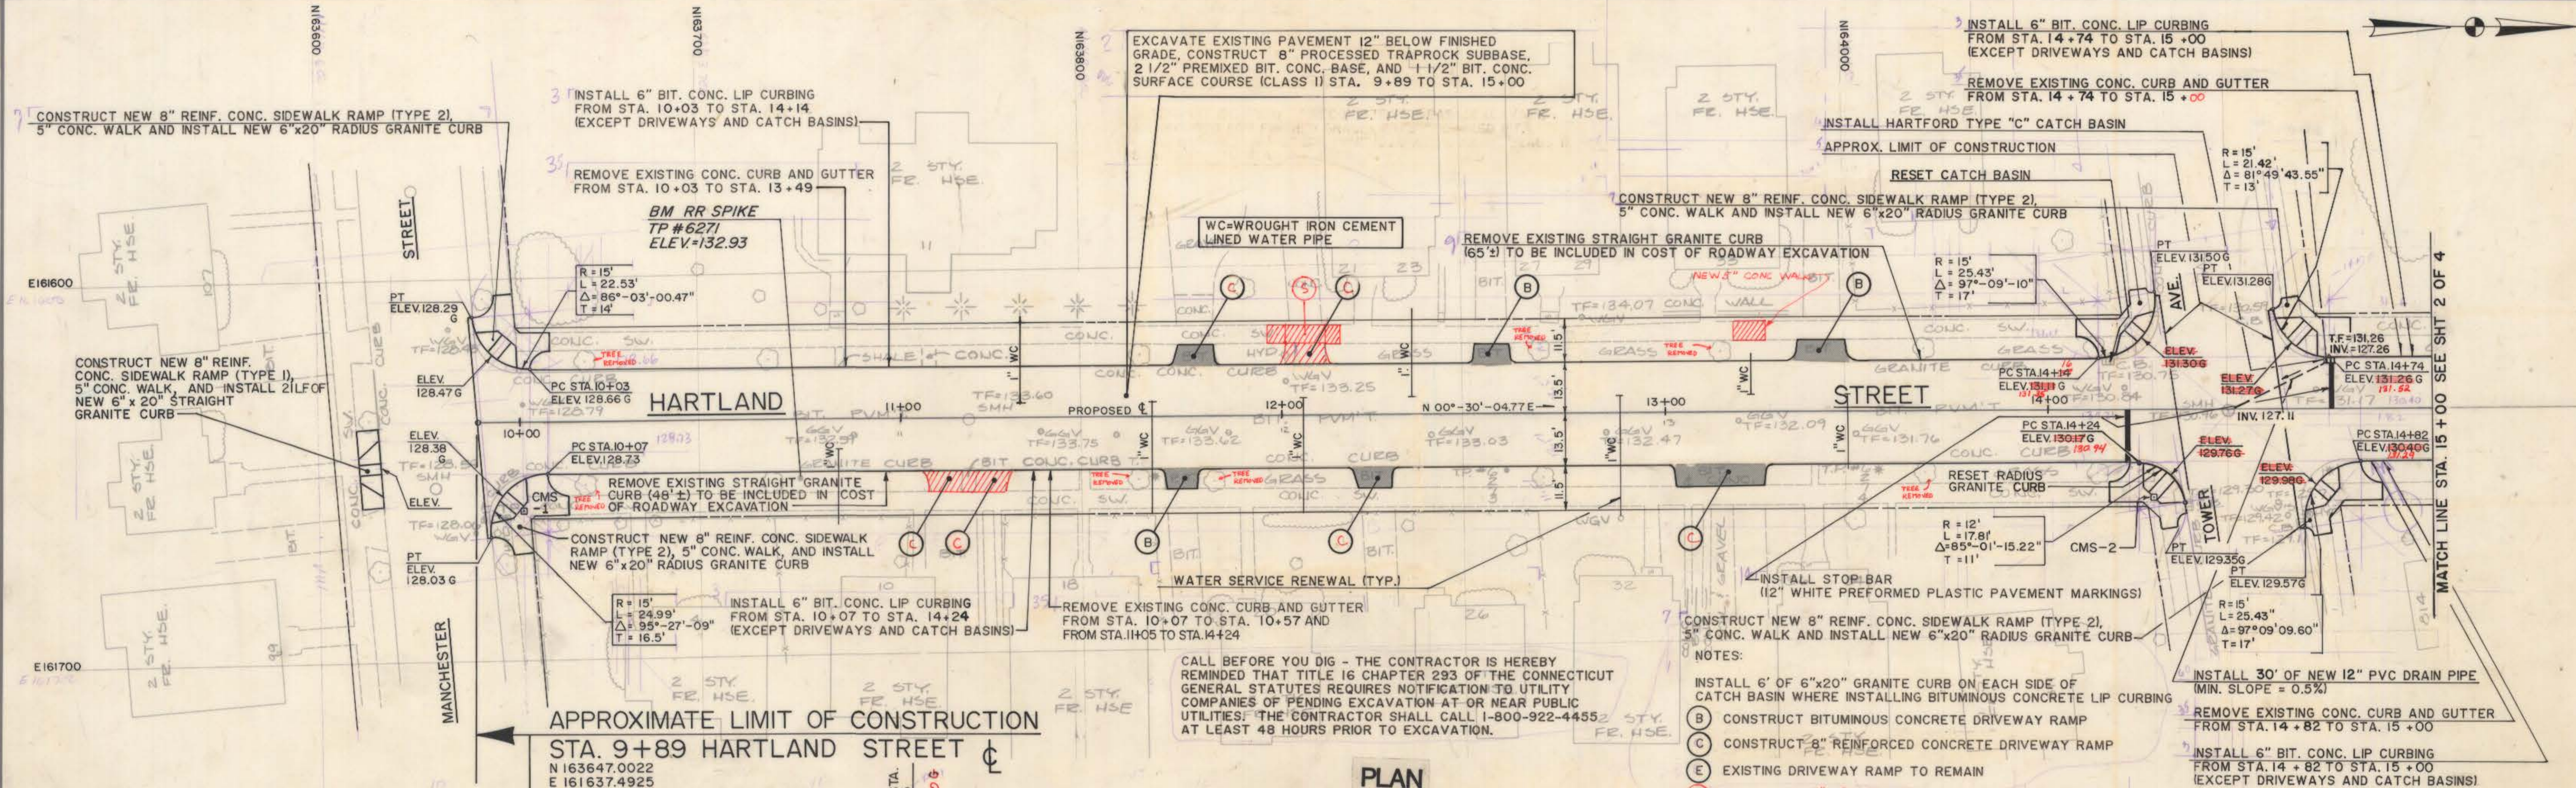

NO.	DATE	REVISIONS
1	JAN 17	CHECKED BY MDH
2	JAN 17	AS BUILT FOR DATE

SUPV. ADW
DESIGN MDH/AEC
DRAWN
CHECKED JAC
DATE 6/17/85

GRAPHIC SCALES
HORIZ. 1"=20'
VERT. 1"=2'

ROADWAY RECONSTRUCTION HARTFORD, CONNECTICUT



Hayden Wegman Consulting Engineers
WEST HARTFORD NEW YORK • BOSTON • BUFFALO ATLANTA • MEMPHIS

CITY OF HARTFORD, CONNECTICUT DEPARTMENT OF PUBLIC WORKS BUREAU OF ENGINEERING SERVICES
DRAWN CHECKED
SCALE DAYBOOK NO. 010948 DATE

HARTLAND STREET HARTLAND STA. 9-89 TO STA. 15-00
PLAN AND PROFILE
Contract # E85-29 Job No. - 845304
SHEET 1 OF 4