
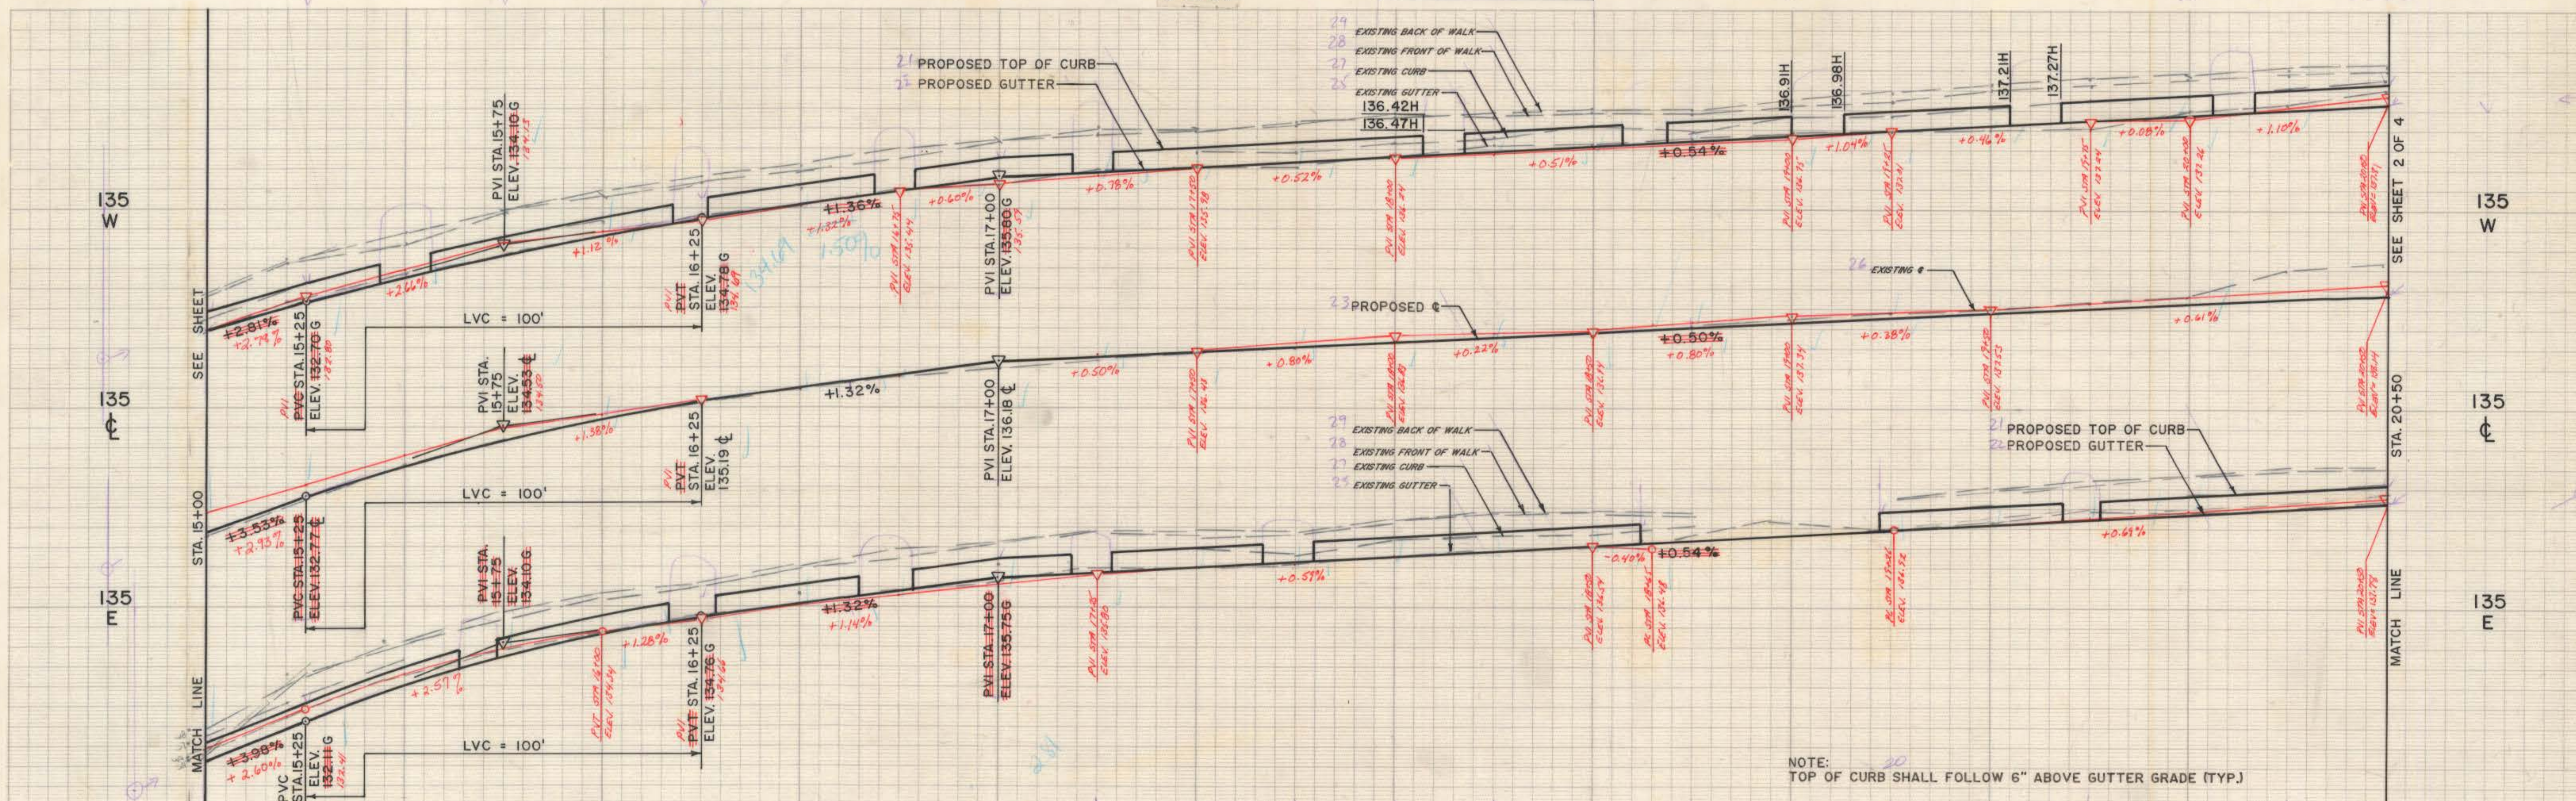


NOTES:

- INSTALL 6" OF 6"x20" GRANITE CURB ON EACH SIDE OF CATCH BASIN WHERE INSTALLING BITUMINOUS CONCRETE LIP CURBING
- CONSTRUCT BITUMINOUS CONCRETE DRIVEWAY RAMP
- CONSTRUCT 8" REINFORCED CONCRETE DRIVEWAY RAMP
- EXISTING DRIVEWAY RAMP TO REMAIN
- CONSTRUCT 8" REINF. CONC. SIDEWALK

EXCAVATE EXISTING PAVEMENT 12" BELOW FINISHED GRADE. CONSTRUCT 8" PROCESSED TRAPROCK SUBBASE, 2 1/2" PREMIXED BIT. CONC. BASE, AND 1 1/2" BIT. CONC. SURFACE COURSE (CLASS II) STA. 15+00 TO STA. 20+50

CALL BEFORE YOU DIG - THE CONTRACTOR IS HEREBY REMINDED THAT TITLE 16 CHAPTER 293 OF THE CONNECTICUT GENERAL STATUTES REQUIRES NOTIFICATION TO UTILITY COMPANIES OF PENDING EXCAVATION AT OR NEAR PUBLIC UTILITIES. THE CONTRACTOR SHALL CALL 1-800-922-4455 AT LEAST 48 HOURS PRIOR TO EXCAVATION.

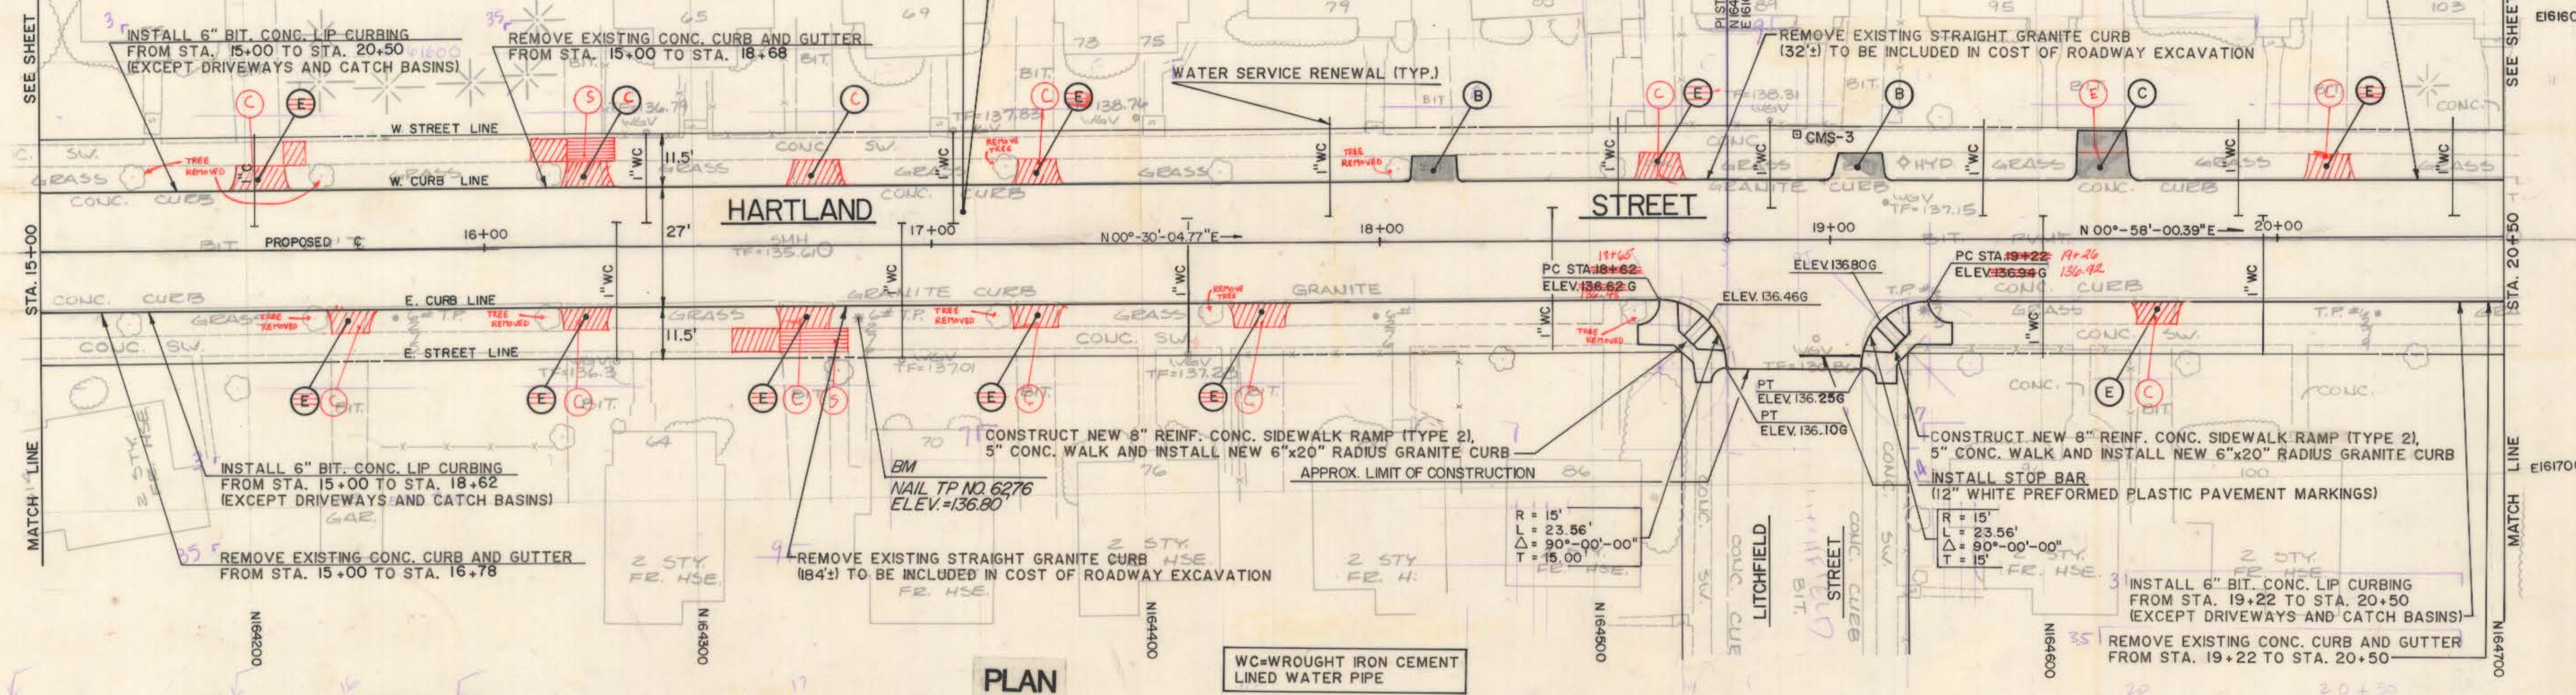

NOTE: CHECK GRAPHIC SCALES BEFORE USING DRAWINGS

PROFILE

NO.	DATE	DESCRIPTION
1	JAN 17 2017	CHECKED BY MDH
2	JAN 17 2017	AS BUILT BY EPE

SUPV. ARW	DESIGN MDH/AEC	DRAWN EPE	CHECKED JAL	DATE 6/17/85
--------------	-------------------	--------------	----------------	-----------------

GRAPHIC SCALES	HORIZ. 1" = 20'	VERT. 1" = 2'
----------------	-----------------	---------------

ROADWAY RECONSTRUCTION
HARTFORD, CONNECTICUT



Hayden | Wegman
Consulting Engineers

WEST HARTFORD
NEW YORK • BOSTON • BUFFALO
ATLANTA • MEMPHIS

CITY OF HARTFORD, CONNECTICUT
DEPARTMENT OF PUBLIC WORKS
BUREAU OF ENGINEERING SERVICES

DRAWN _____
CHECKED _____

SCALE _____
DATE _____

DAYBOOK NO 010948

HARTLAND STREET
STA. 15+00 TO STA. 20+50

PLAN AND PROFILE

Contract # E85-29 Job No. - 845304 OF 4