


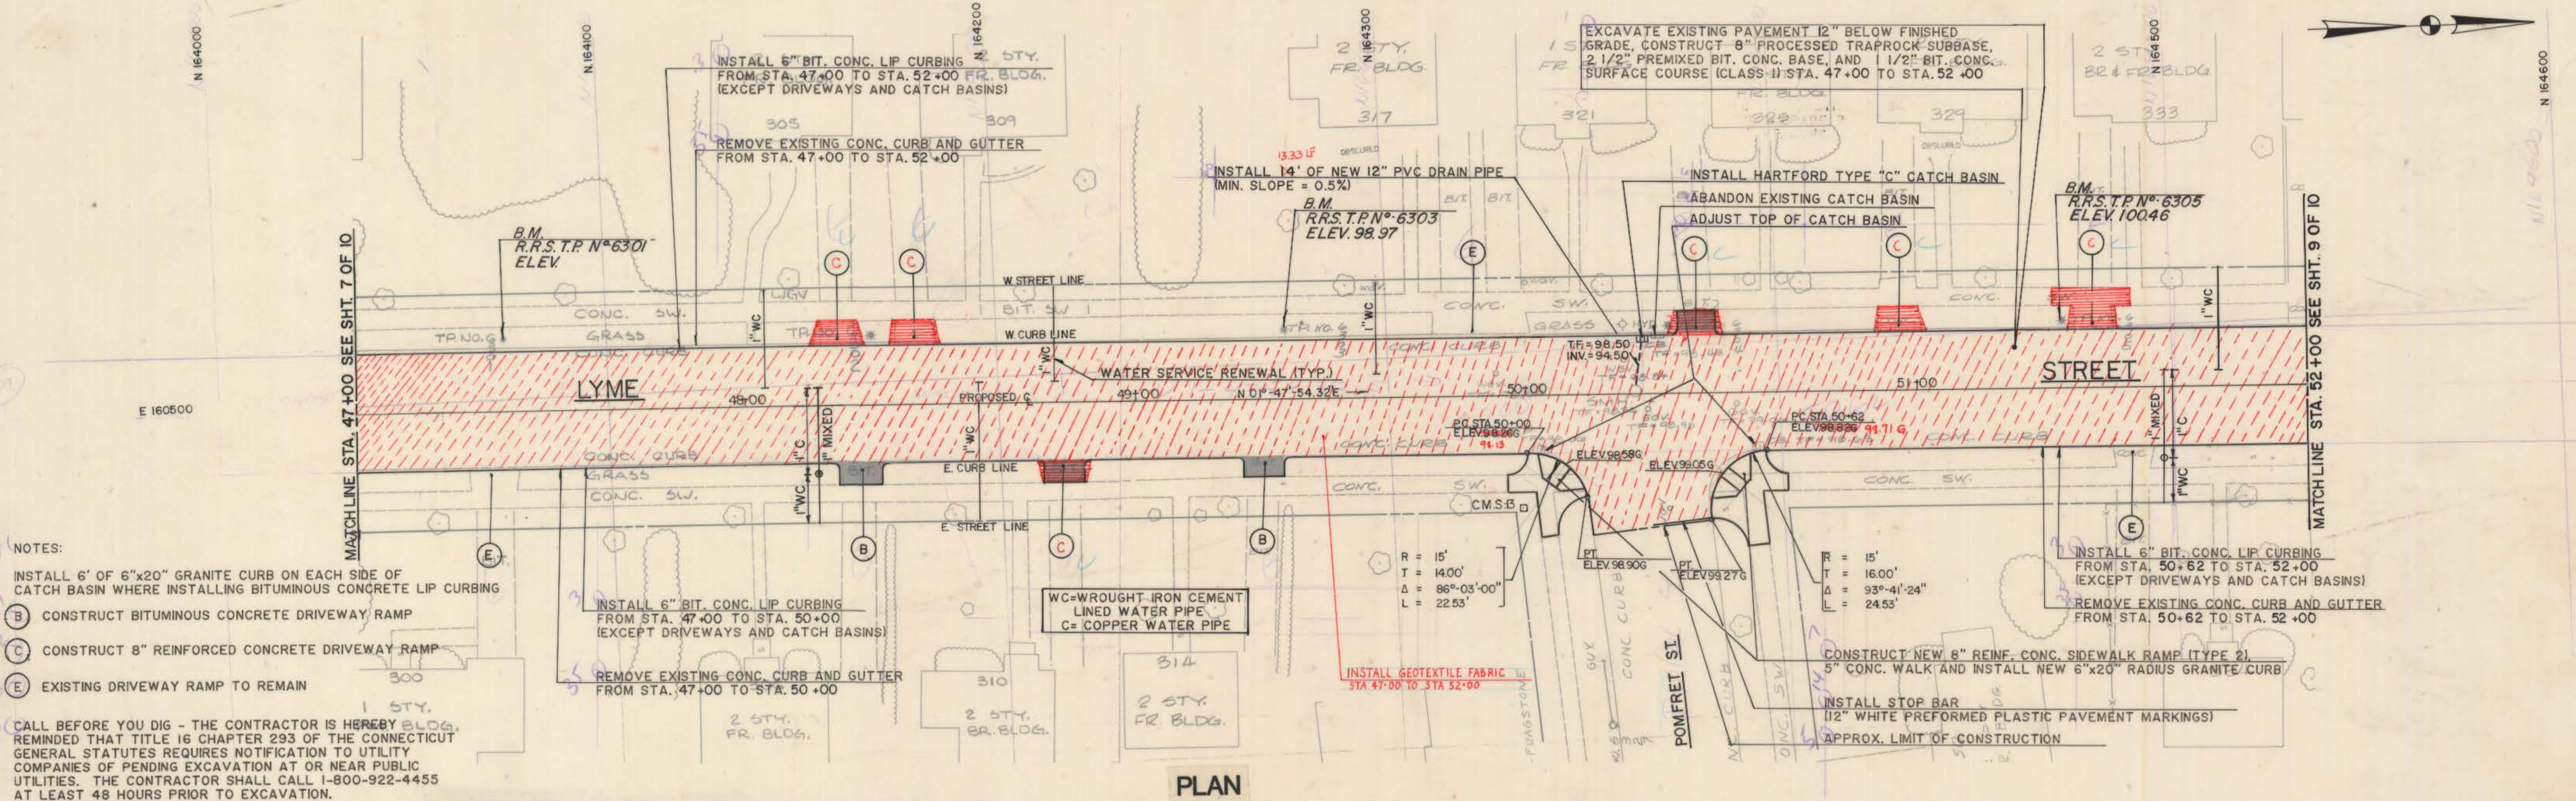

NOTES:


INSTALL 6' OF 6"x20" GRANITE CURB ON EACH SIDE OF CATCH BASIN WHERE INSTALLING BITUMINOUS CONCRETE LIP CURBING

(B) CONSTRUCT BITUMINOUS CONCRETE DRIVEWAY RAMP

(C) CONSTRUCT 8" REINFORCED CONCRETE DRIVEWAY RAMP

(E) EXISTING DRIVEWAY RAMP TO REMAIN

CALL BEFORE YOU DIG - THE CONTRACTOR IS HEREBY BLDG. REMINDED THAT TITLE 16 CHAPTER 293 OF THE CONNECTICUT GENERAL STATUTES REQUIRES NOTIFICATION TO UTILITY COMPANIES OF PENDING EXCAVATION AT OR NEAR PUBLIC UTILITIES. THE CONTRACTOR SHALL CALL 1-800-922-4455 AT LEAST 48 HOURS PRIOR TO EXCAVATION.

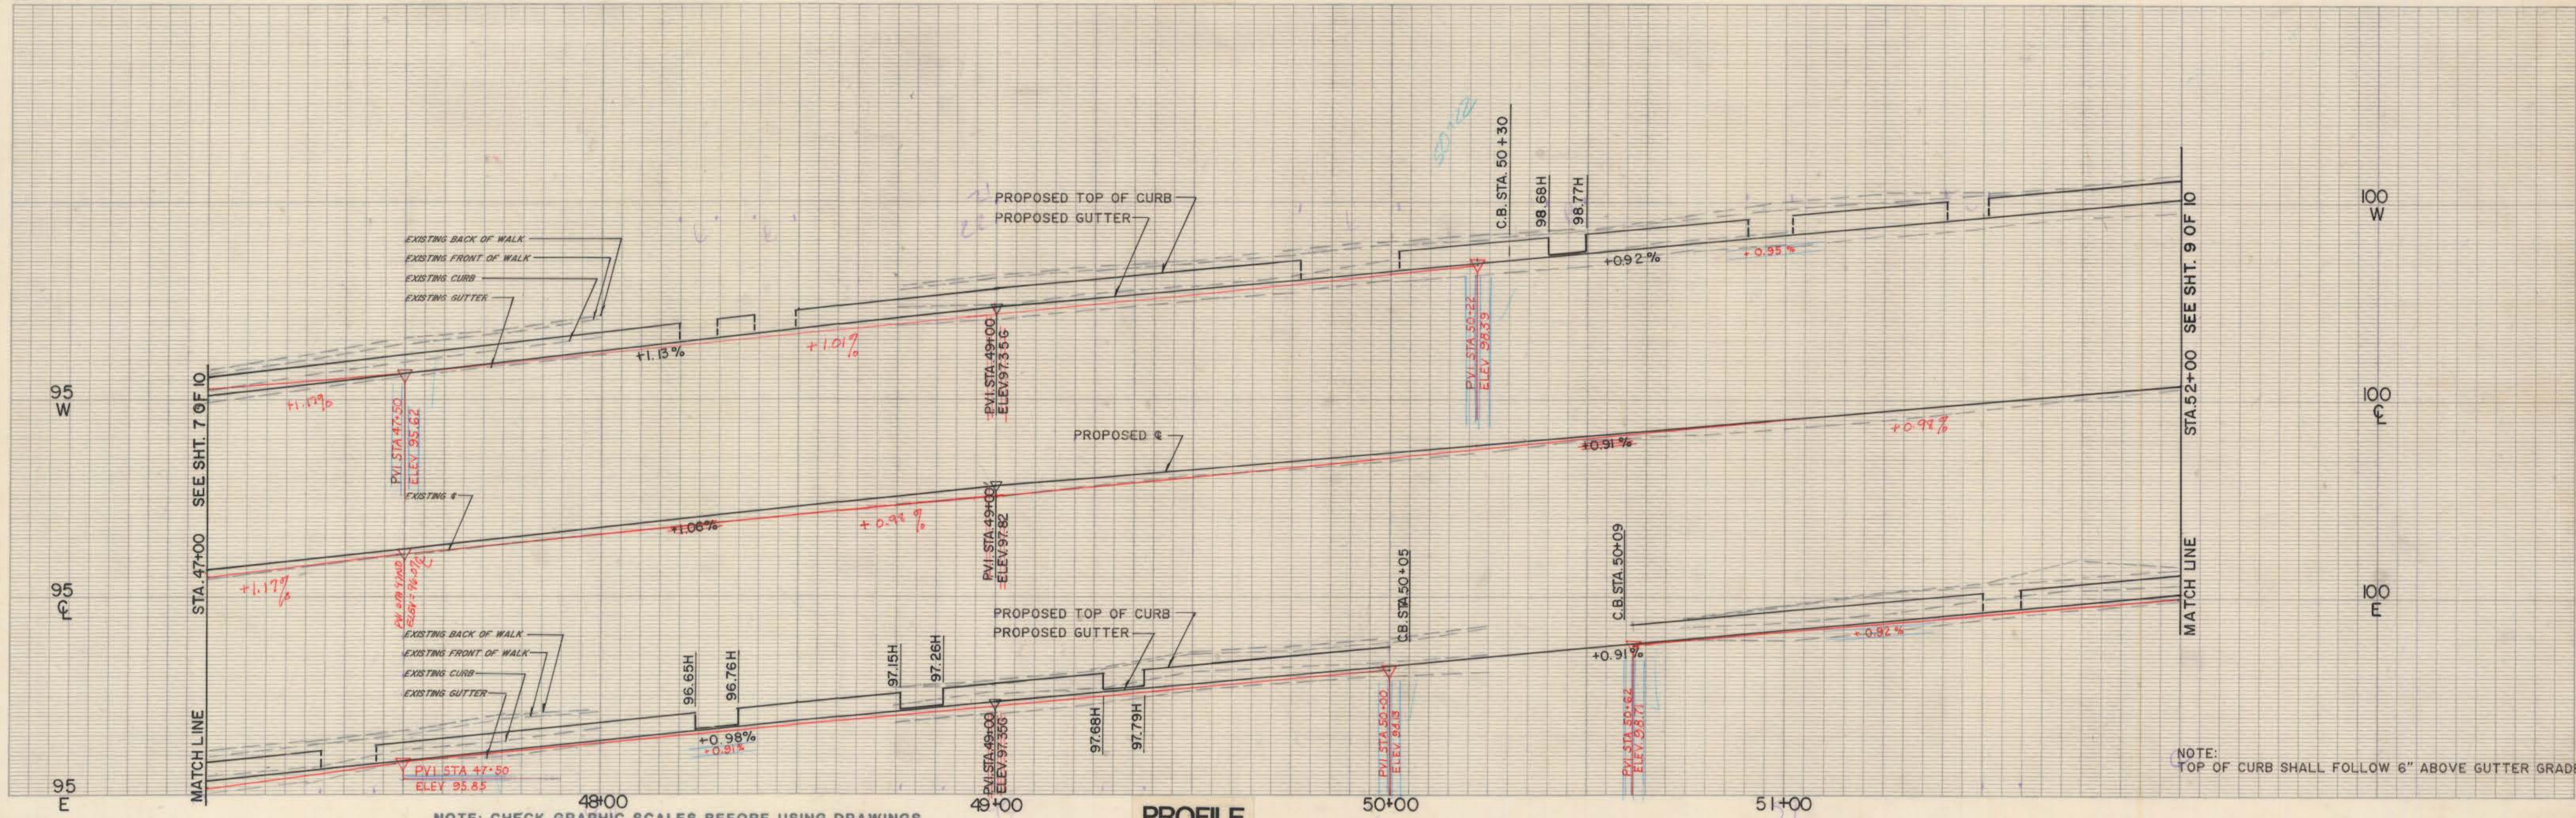

NO.	DATE	DESCRIPTION
1	1/11/87	ADD GEN. SPEC. - AS BUILT - DRAWN BY: WDH
2	1/11/87	CHECKED BY: MDH
3	1/11/87	AS BUILT BY: JAC

SUPV.	ARW
DESIGN	MDH/AEC
DRAWN	ARW
CHECKED	JAC
DATE	6/17/85

GRAPHIC SCALES	HORIZ. 1"=20'
	VERT. 1"=2'

ROADWAY RECONSTRUCTION
HARTFORD, CONNECTICUT



Hayden | Wegman
Consulting Engineers

WEST HARTFORD
NEW YORK • BOSTON • BUFFALO
ATLANTA • MEMPHIS

CITY OF HARTFORD, CONNECTICUT
DEPARTMENT OF PUBLIC WORKS
BUREAU OF ENGINEERING SERVICES

DRAWN _____
CHECKED _____

SCALE _____
DATE _____

DAYBOOK NO. 010948

LYME STREET
STA. 47+00 TO STA. 52+00

PLAN AND PROFILE

Contract E85-29 Job No. 845304 OF 10