
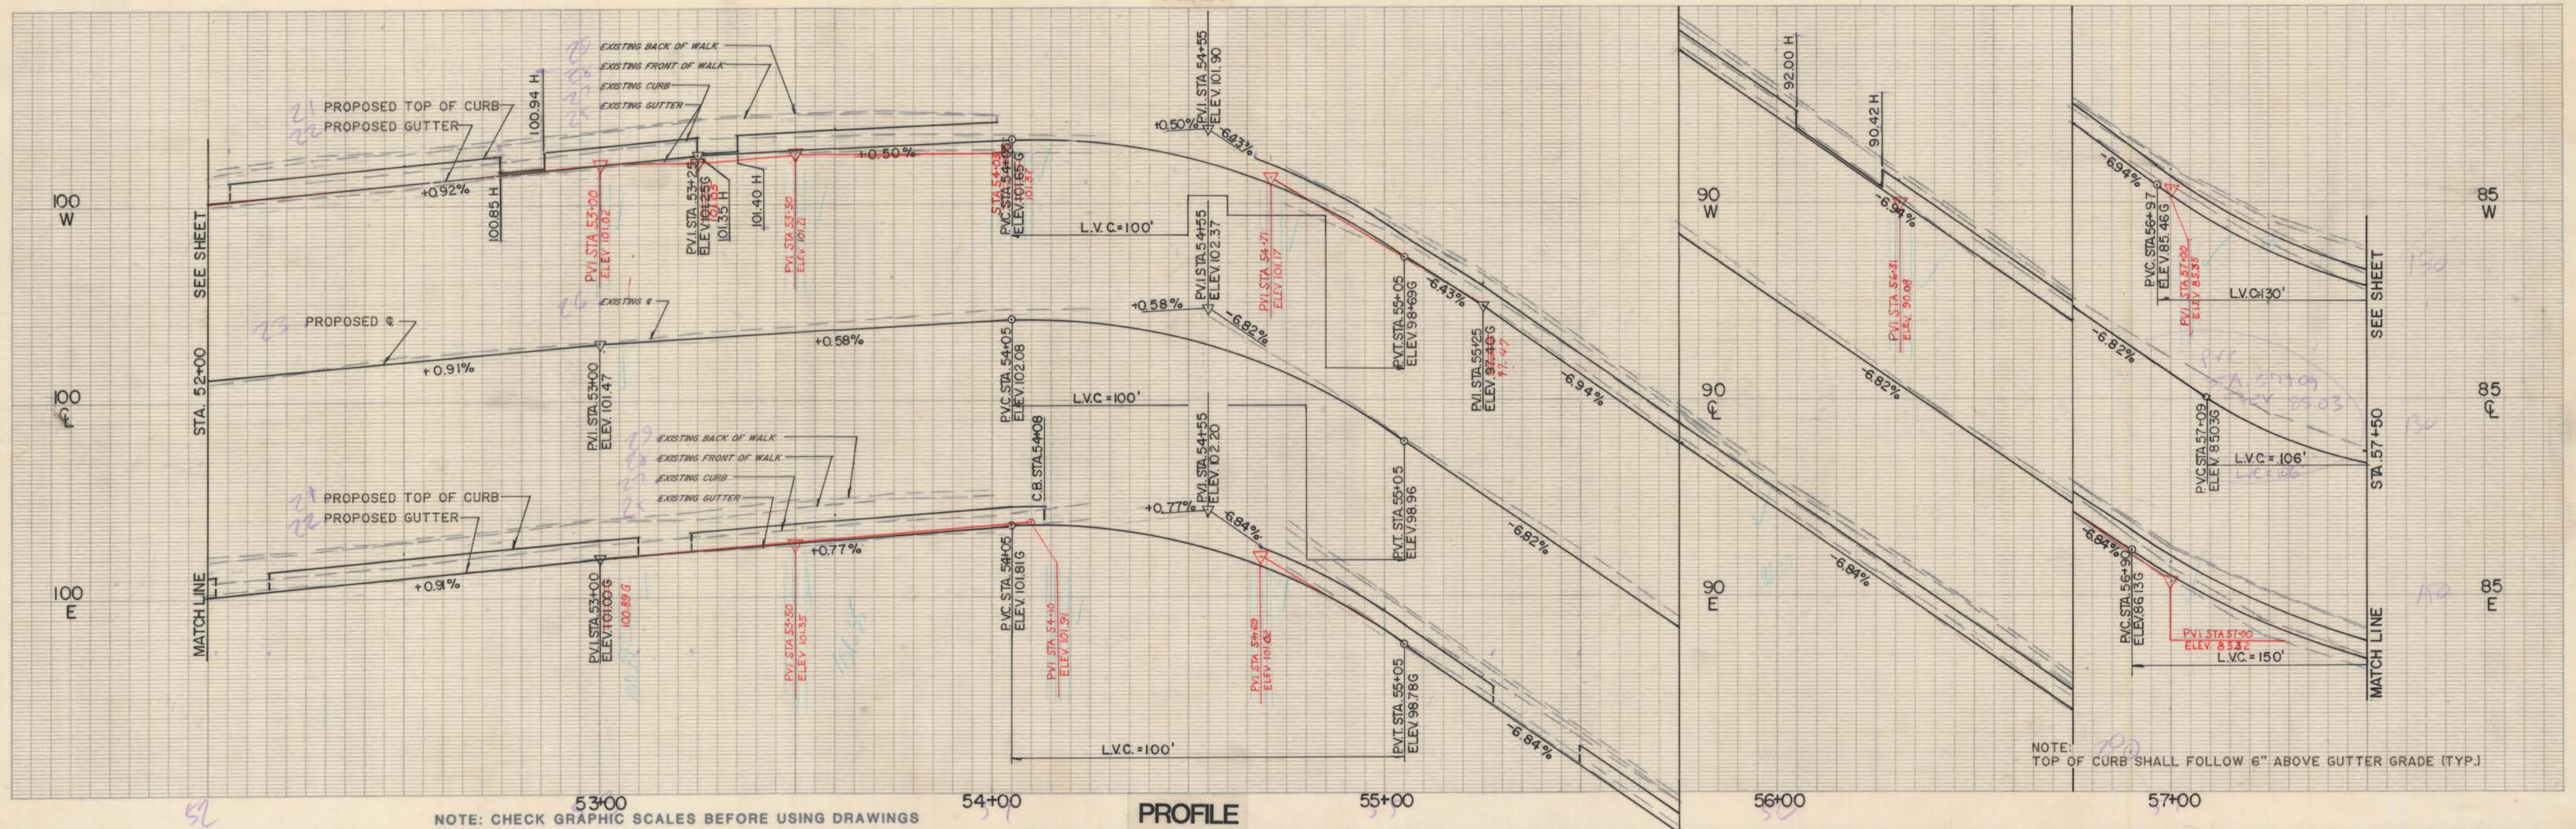


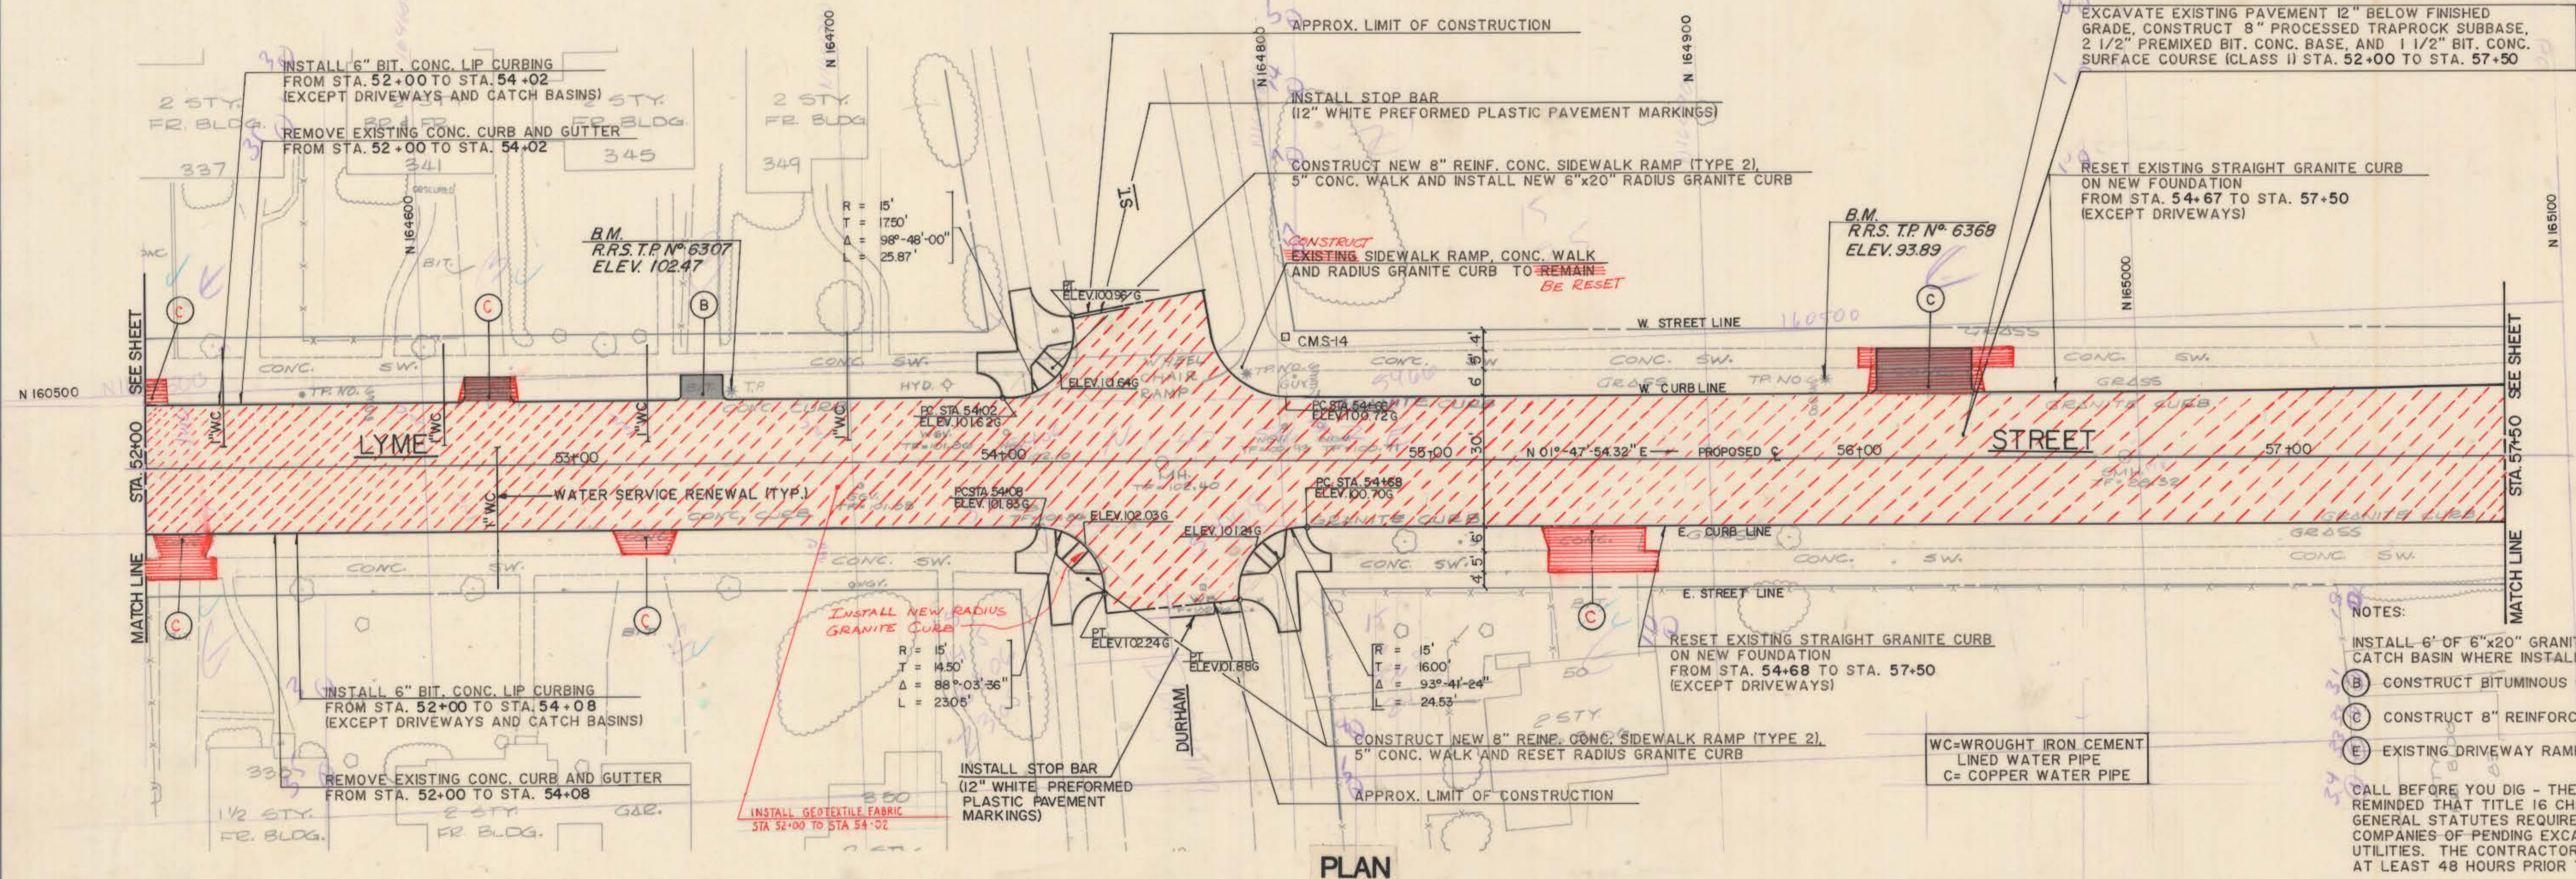

REVISIONS NO. DATE DESCRIPTION 1 1/18/87 Add Use-Tax As-Proposed Drawings by: M.N. 2 JAN '91 CHECKED BY: M.N. 3 DEC '96 AS-BUILT BY: M.N.		SUPV. <i>AW</i> DESIGN <i>MDH/AEC</i> DRAWN <i>AW</i> CHECKED <i>JAC</i> DATE 6/17/85	GRAPHIC SCALES HORIZ. 1"=20' VERT. 1"=2' ROADWAY RECONSTRUCTION HARTFORD, CONNECTICUT		Hayden Wegman Consulting Engineers WEST HARTFORD NEW YORK • BOSTON • BUFFALO ATLANTA • MEMPHIS	CITY OF HARTFORD, CONNECTICUT DEPARTMENT OF PUBLIC WORKS BUREAU OF ENGINEERING SERVICES	LYME STREET STA. 52+00 TO STA. 57+50	PLAN AND PROFILE Contract E85-29 Job No. 845304 OF 10	SHEET 9
--	--	---	---	--	---	---	--	---	---------