

INSTALL 6' OF 6"x20" GRANITE CURB ON EACH SIDE OF
CATCH BASIN WHERE INSTALLING BITUMINOUS CONCRETE LIP CURBING

- (B) CONSTRUCT BITUMINOUS CONCRETE DRIVEWAY RAMP
- (C) CONSTRUCT 8" REINFORCED CONCRETE DRIVEWAY RAMP
- (E) EXISTING DRIVEWAY RAMP TO REMAIN

CALL BEFORE YOU DIG - THE CONTRACTOR IS HEREBY
REMINDED THAT TITLE 16 CHAPTER 293 OF THE CONNECTICUT
GENERAL STATUTES REQUIRES NOTIFICATION TO UTILITY
COMPANIES OF PENDING EXCAVATION AT OR NEAR PUBLIC
UTILITIES. THE CONTRACTOR SHALL CALL 1-800-922-4455
AT LEAST 48 HOURS PRIOR TO EXCAVATION.


APPROX. LIMIT OF CONSTRUCTION
STA. 32+72 PLAINFIELD STREET

EXCAVATE EXISTING PAVEMENT 12" BELOW FINISHED GRADE, CONSTRUCT 8" PROCESSED TRAPROCK SUBBASE, 2 1/2" PREMIXED BIT. CONC. BASE, AND 1 1/2" BIT. CONC. SURFACE COURSE (CLASS 1) STA. 32 + 71.70 TO 37 + 00

2. INSTALL 6" BIT. CONC. LIP CURBING
FROM STA. 33+21 TO STA. 37+00
(EXCEPT DRIVEWAYS AND CATCH BASINS)

INSTALL GEOTEXTILE FABRIC
STA. 32+71.70 TO STA. 37+00
PRIOR TO INSTALLATION OF SUB BASE.


REMOVE EXISTING CONC. CURB AND GUTTER
FROM STA. 33+21 TO STA. 37+00

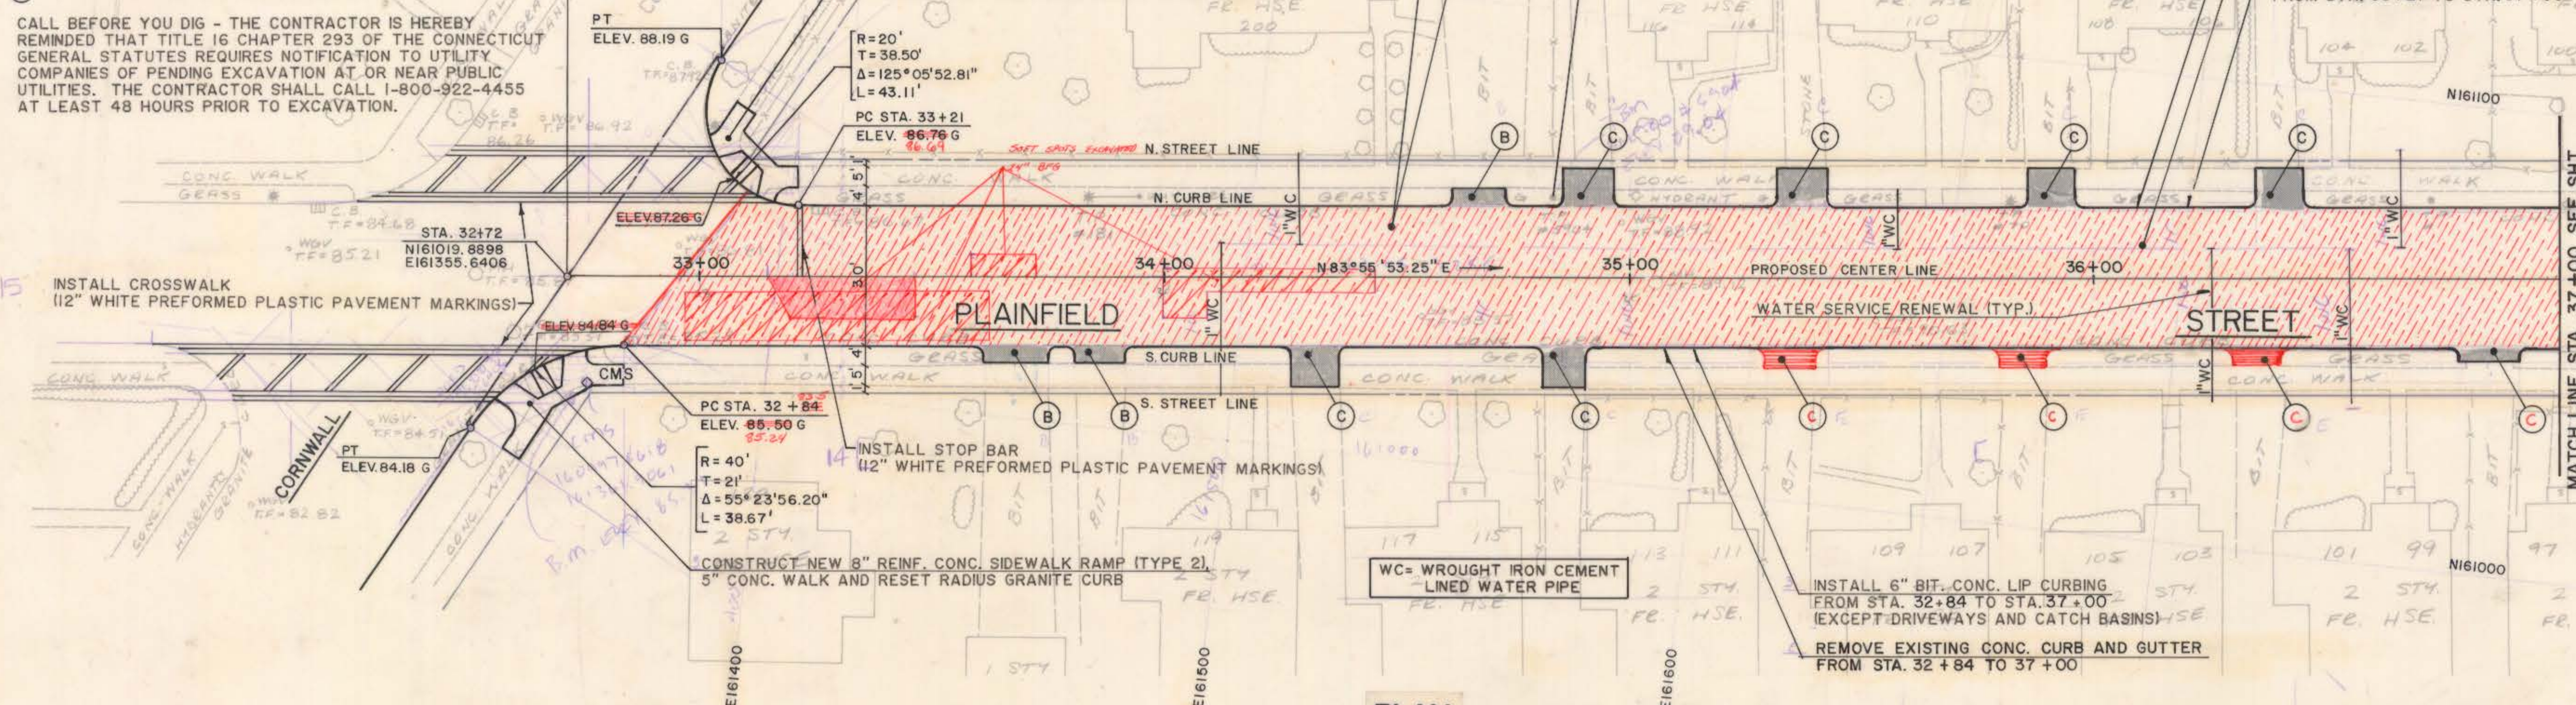

PLAN

APPOX. BEGIN OF CONSTRUCTION
STA. 32+72 PLAINFIELD STREET @

NOTE:
TOP OF CURB SHALL FOLLOW 6" ABOVE GUTTER GRADE (TYP.)

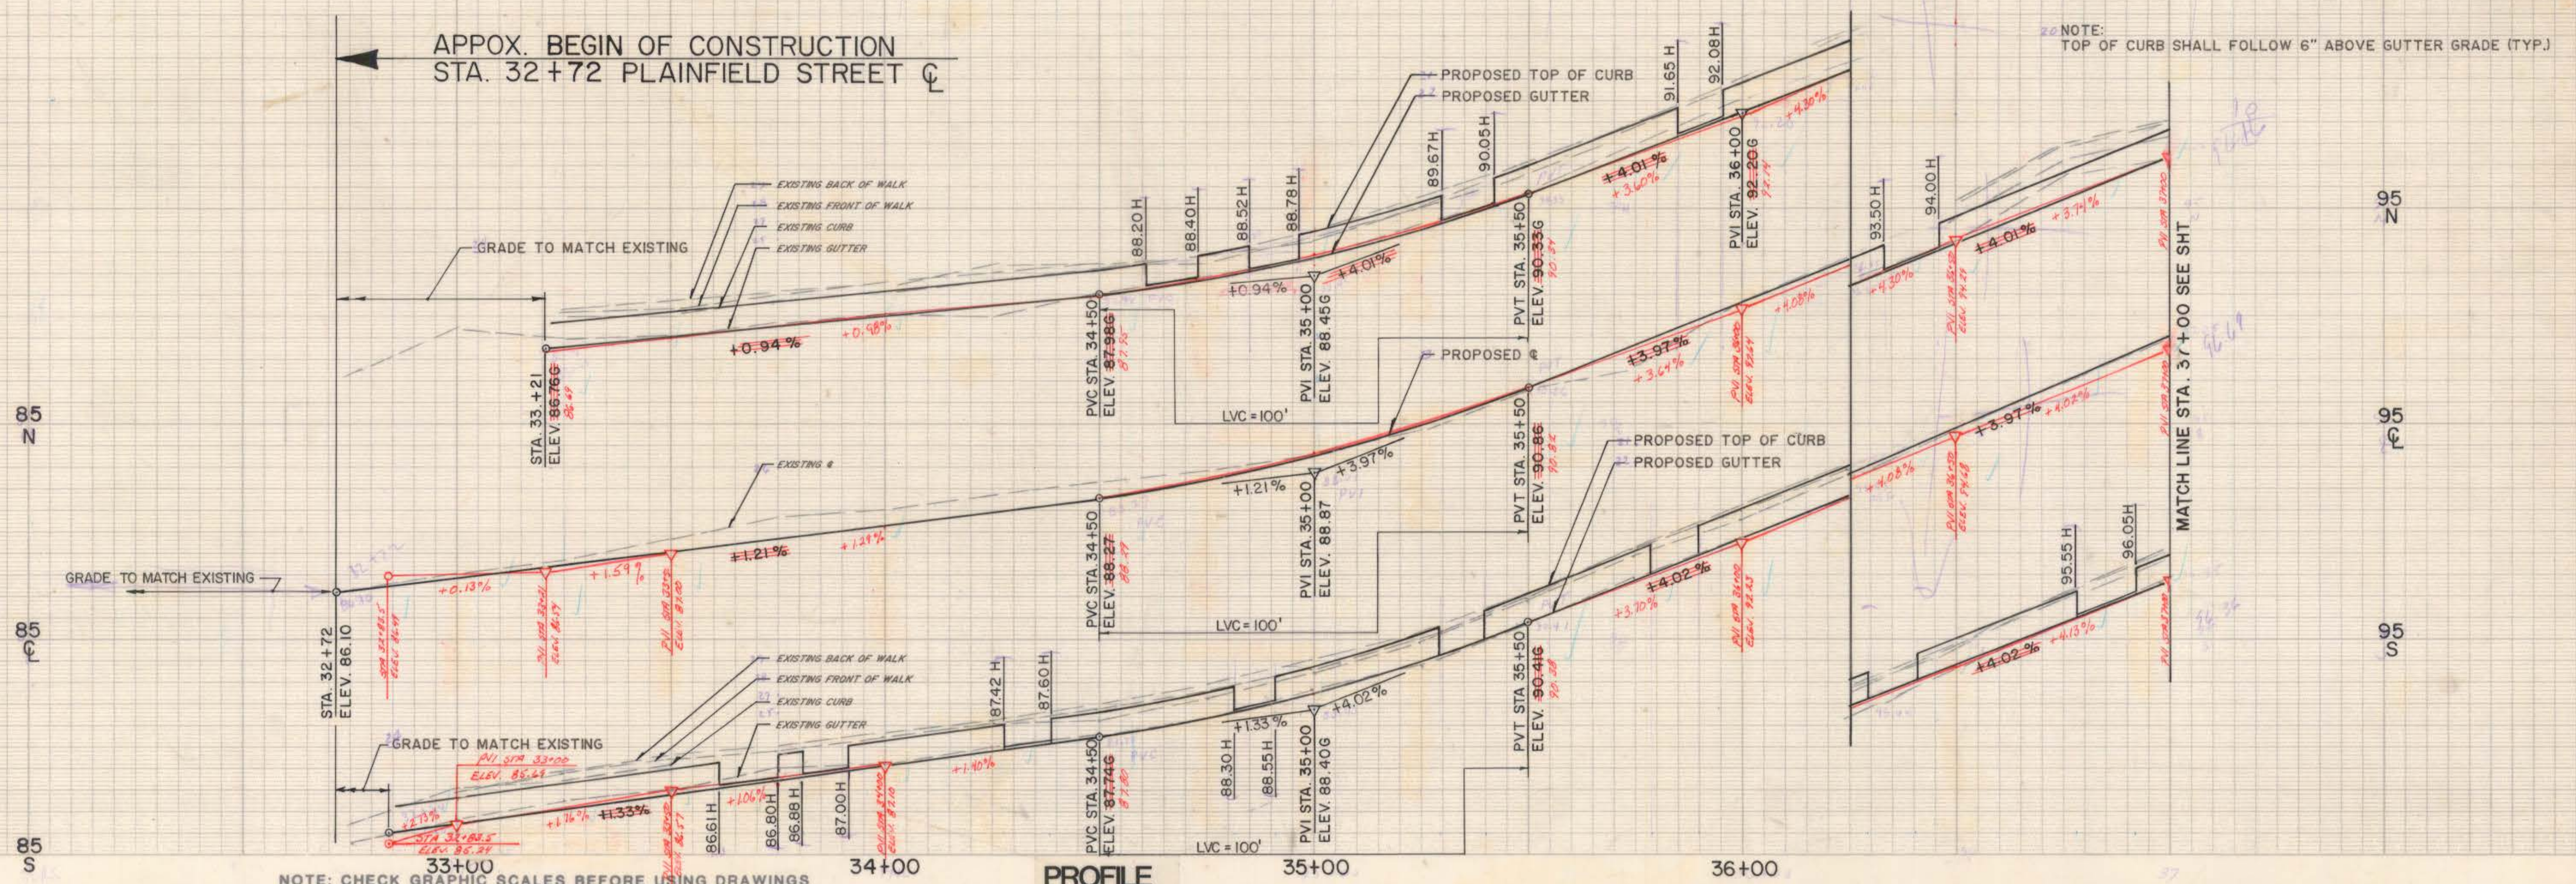

NOTE: CHECK GRAPHIC SCALES BEFORE USING DRAWINGS

PROFILE

		SUPV.	ARW
		DESIGN	
		DRAWN	MDH/AEC
		CHECKED	JAC
		DATE	6/17/85
		NO.	DATE
		DESCRIPTION	
3	1/10/87	ADD DES-TEX AS BUILT DRAWING BY IN.	
2	JAN 91	CHECKED BY RAB	
1	JAN 91	AS-BUILT BY RSE	
REVISIONS			

GRAPHIC SCALES

HORIZ. 1" = 20'

VERT. 1" = 2'

ROADWAY RECONSTRUCTION HARTFORD, CONNECTICUT



Hayden | Wegman
Consulting Engineers

WEST HARTFORD
NEW YORK • BOSTON • BUFFALO
ATLANTA • MEMPHIS

CITY OF HARTFORD, CONNECTICUT
DEPARTMENT OF PUBLIC WORKS
BUREAU OF ENGINEERING SERVICES

DRAWN _____	SCALE	DAYBOOK NO. 010948
CHECKED _____		DATE

PLAINFIELD STREET

STA. 32+72 TO STA. 37+00

PLAN AND PROFILE

Contract	E85-29	Job No.- 845304	OF	2
----------	--------	-----------------	----	---