

INSTALL 6' OF 6"x20" GRANITE CURB ON EACH SIDE OF
CATCH BASIN WHERE INSTALLING BITUMINOUS CONCRETE LIP CURBING

(B) CONSTRUCT BITUMINOUS CONCRETE DRIVEWAY RAMP
(C) CONSTRUCT 8" REINFORCED CONCRETE DRIVEWAY RAMP
(E) EXISTING DRIVEWAY RAMP TO REMAIN

EXCAVATE EXISTING PAVEMENT 12" BELOW FINISHED
GRADE, CONSTRUCT 8" PROCESSED TRAPROCK SUBBASE,
2 1/2" PREMIXED BIT. CONC. BASE, AND 1 1/2" BIT. CONC.
SURFACE COURSE (CLASS 1) STA. 37+00 TO STA. 41+58.228

INSTALL GEOTEXTILE FABRIC
STA 37+00 TO 41+58.228
PRIOR TO INSTALLATION OF SUB BASE

INSTALL 6" BIT. CONC. LIP CURBING
FROM STA. 37+00 TO STA. 41+45
(EXCEPT DRIVEWAYS AND CATCH BASINS)

REMOVE EXISTING CONC. CURB AND GUTTER
FROM STA. 37+00 TO STA. 41+45

RRS TP NO. 5
ELEV. 114.43


~~$$\begin{aligned} R &= 15' \\ T &= 14.00' \\ \Delta &= 86^\circ - 03' - 00'' \\ L &= 22.53' \end{aligned}$$~~
$$\begin{aligned} R &= 15.00' \\ T &= 13.46' \\ \Delta &= 83^\circ 49' 30'' \\ L &= 21.95' \end{aligned}$$

APPROX. END OF CONSTRUCTION
STA. 41+58.228 PLAINFIELD STREET C

CONSTRUCT NEW 8" REINF. CONC. SIDEWALK RAMP (TYPE 2),
5" CONC. WALK AND INSTALL NEW 6"x20" RADIUS GRANITE CURB

CALL BEFORE YOU DIG - THE CONTRACTOR IS HEREBY
REMINDED THAT TITLE 16 CHAPTER 293 OF THE CONNECTICUT
GENERAL STATUTES REQUIRES NOTIFICATION TO UTILITY
COMPANIES OF PENDING EXCAVATION AT OR NEAR PUBLIC
UTILITIES. THE CONTRACTOR SHALL CALL 1-800-922-4455
AT LEAST 48 HOURS PRIOR TO EXCAVATION.

PLAN

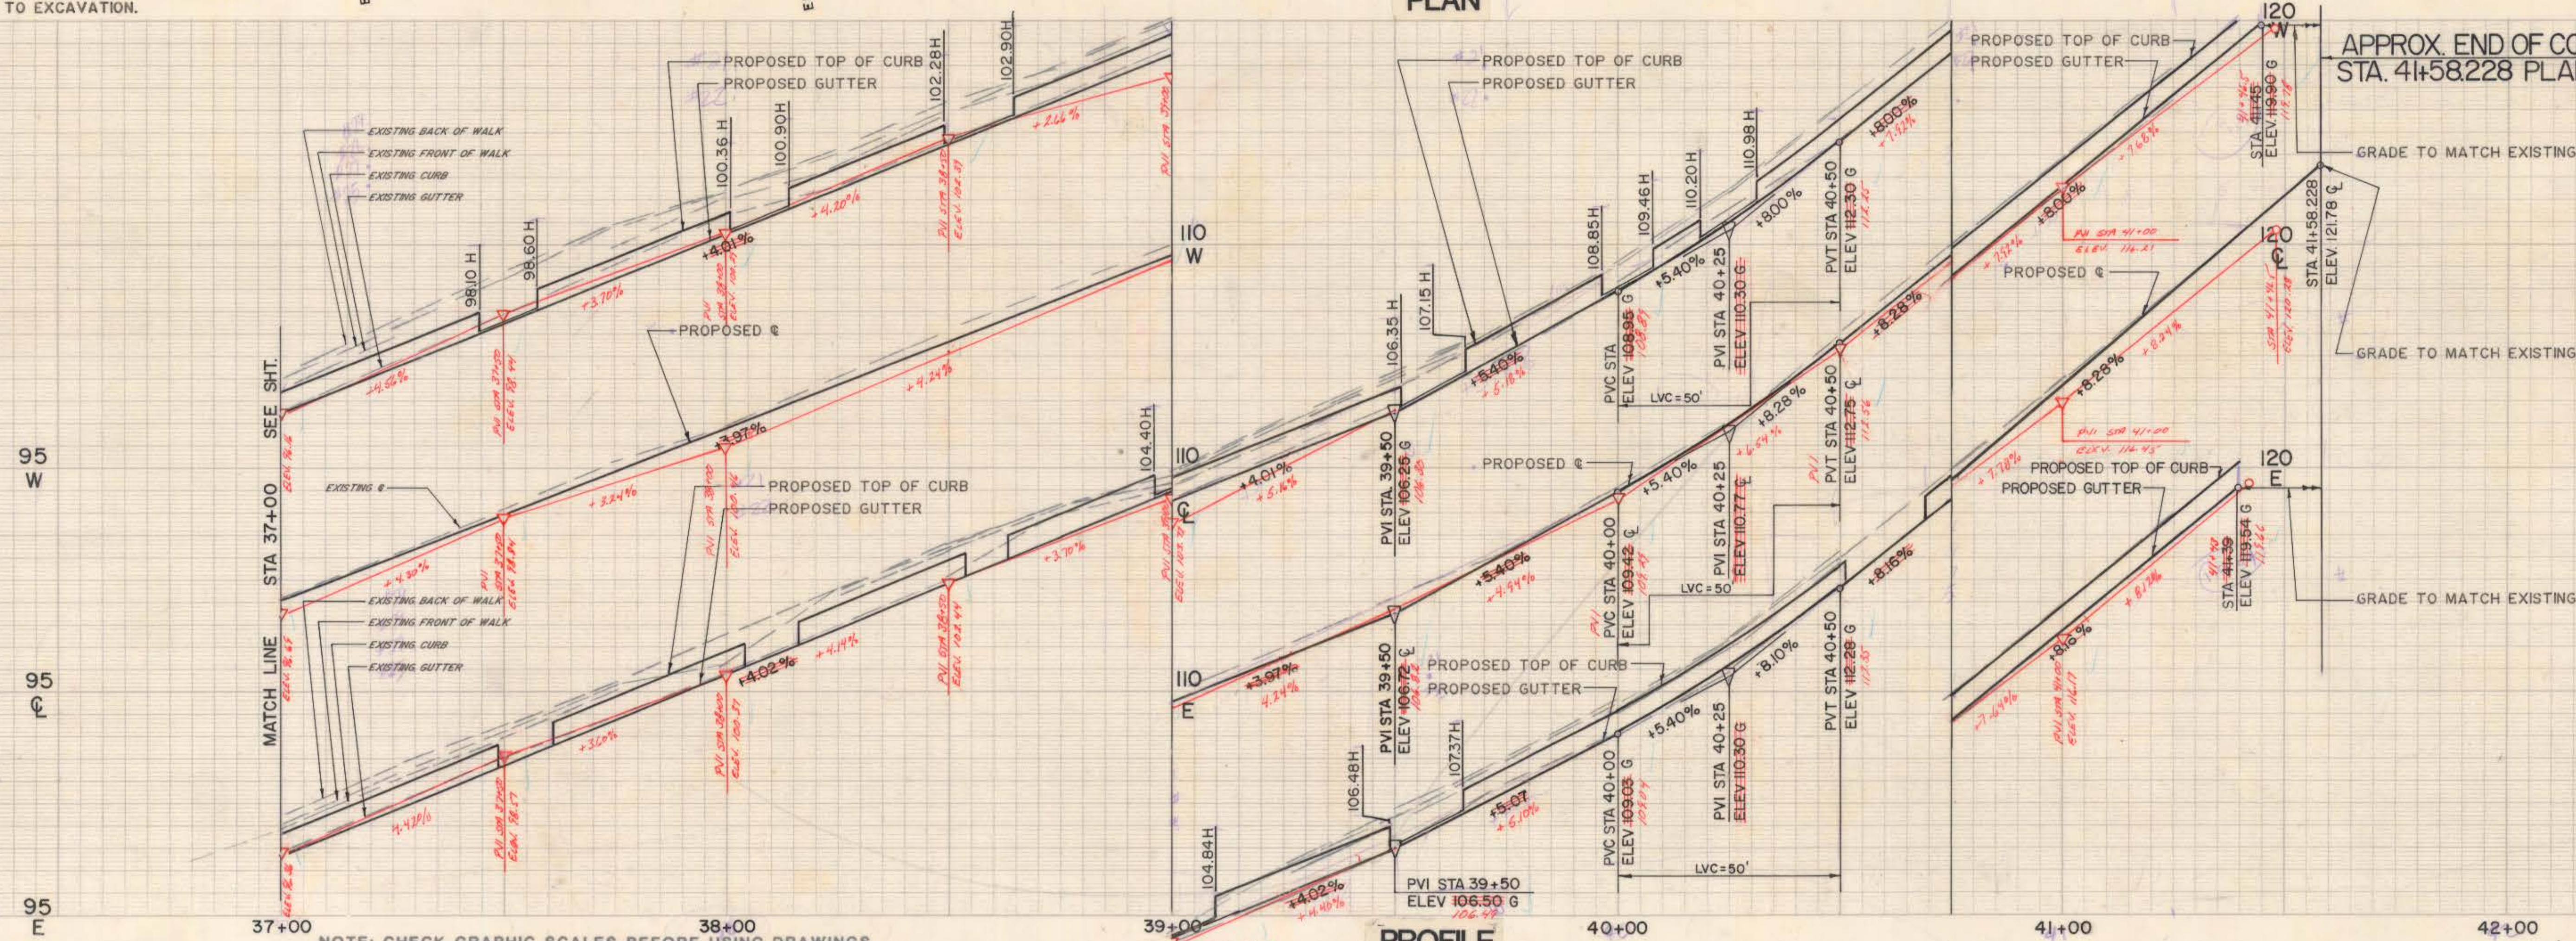

NOTE: CHECK GRAPHIC SCALES BEFORE USING DRAWINGS

4	11/13/87	ADD GEO-TEX AS BUILT - DRAWING BY C
3	MAY 97	CHECKED BY MDH
2	JAN 97	AS-BUILT BY RJE
1	830812	COORD. DATA CHNG.
NO.	DATE	DESCRIPTION
REVISONS		

SUPV.	ARW
DESIGN	MDH/AEC
DRAWN	BAC
CHECKED	JAC
DATE	6/17/85

GRAPHIC SCALES

HORIZ. 1" = 20'

VERT. 1" = 2'

ROADWAY RECONSTRUCTION HARTFORD, CONNECTICUT



Hayden | Wegman
Consulting Engineers

WEST HARTFORD
NEW YORK • BOSTON • BUFFALO
ATLANTA • MEMPHIS

CITY OF HARTFORD, CONNECTICUT
DEPARTMENT OF PUBLIC WORKS
BUREAU OF ENGINEERING SERVICES

DRAWN _____
CHECKED _____

SCALE

DAYBOOK NO. 010948

DATE _____

PLAINFIELD STREET

STA. 37-00 TO STA. 41-58.228

PLAN AND PROFILE

Contract E85-29.

Job No.- 845304

SHEET 2

4 OF 2

575/1