
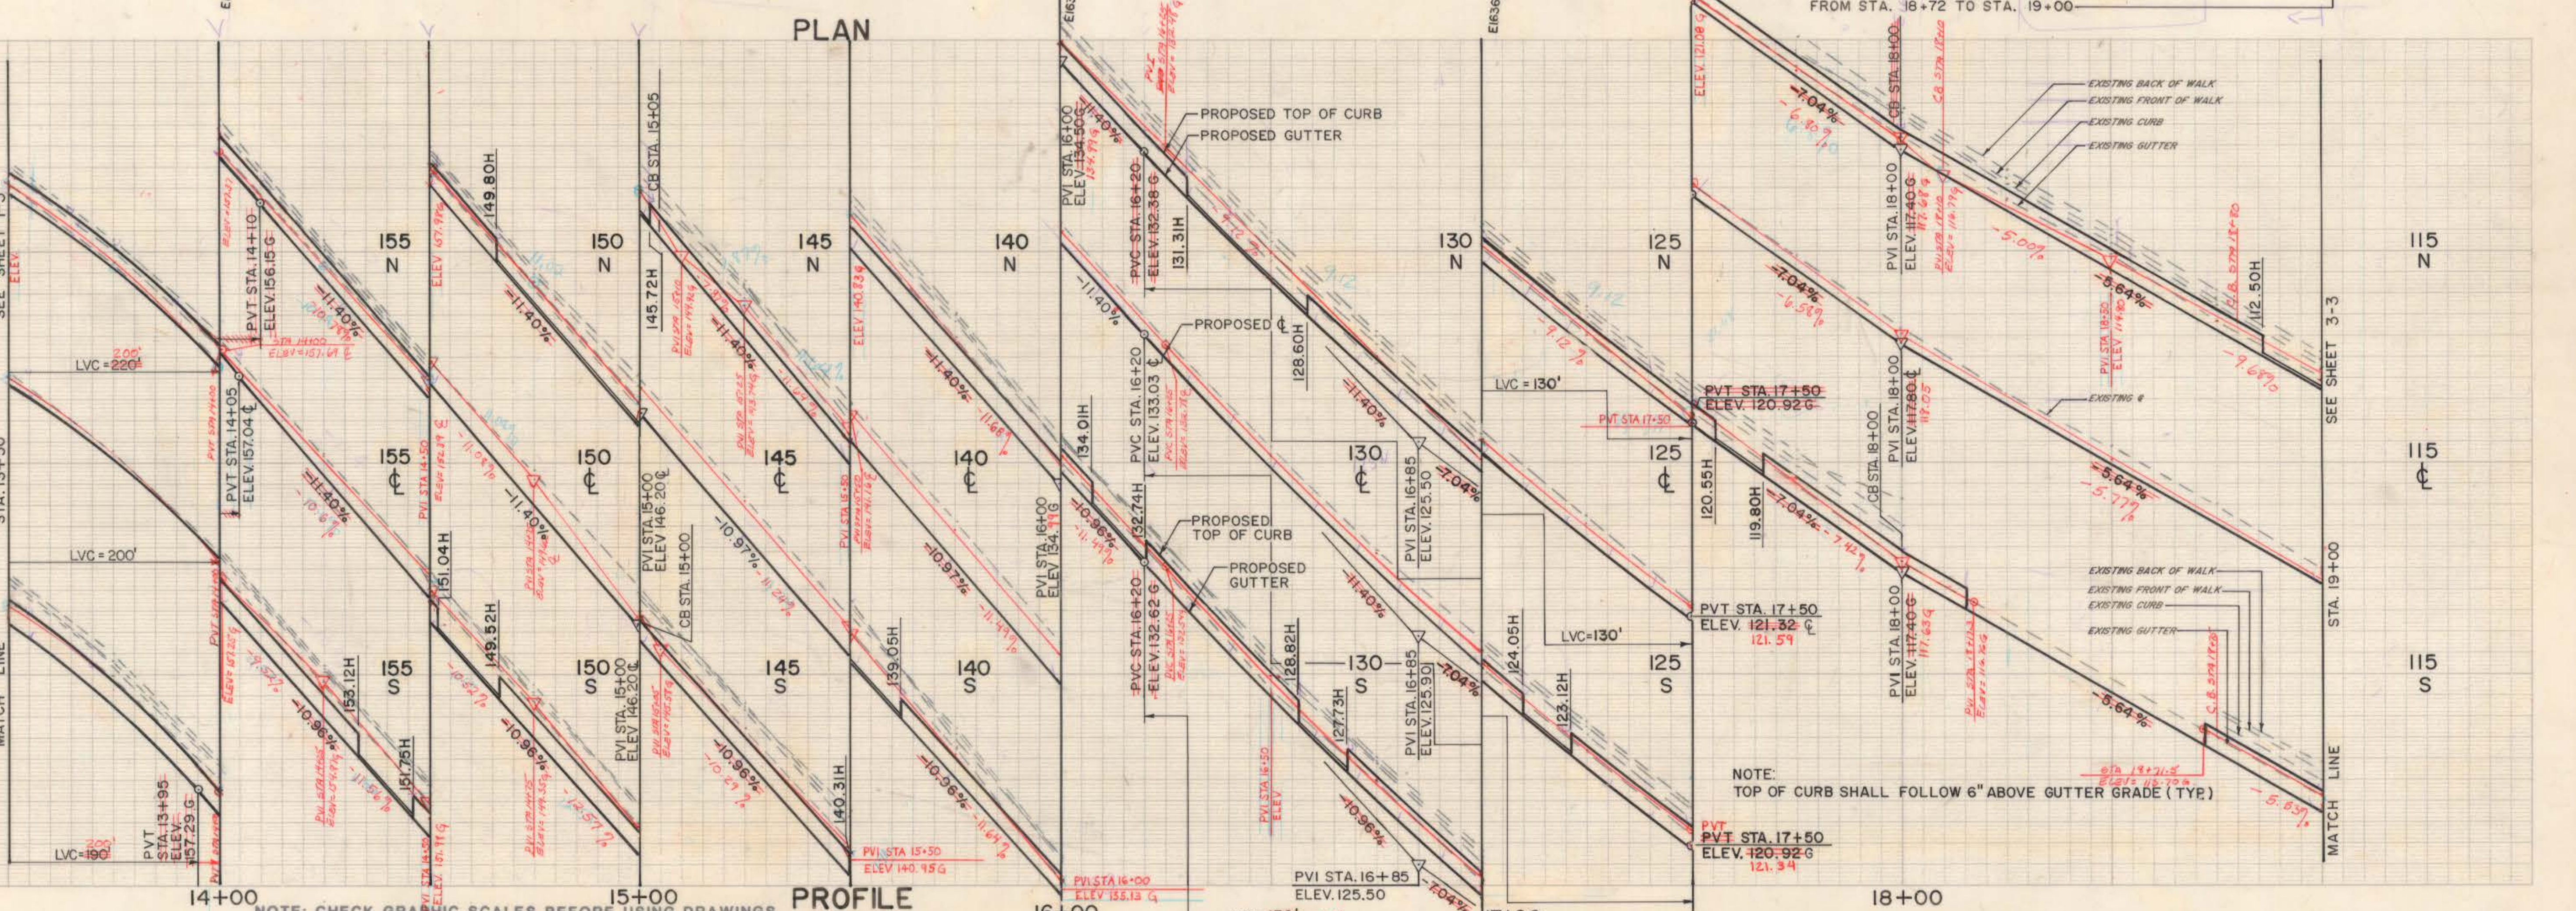


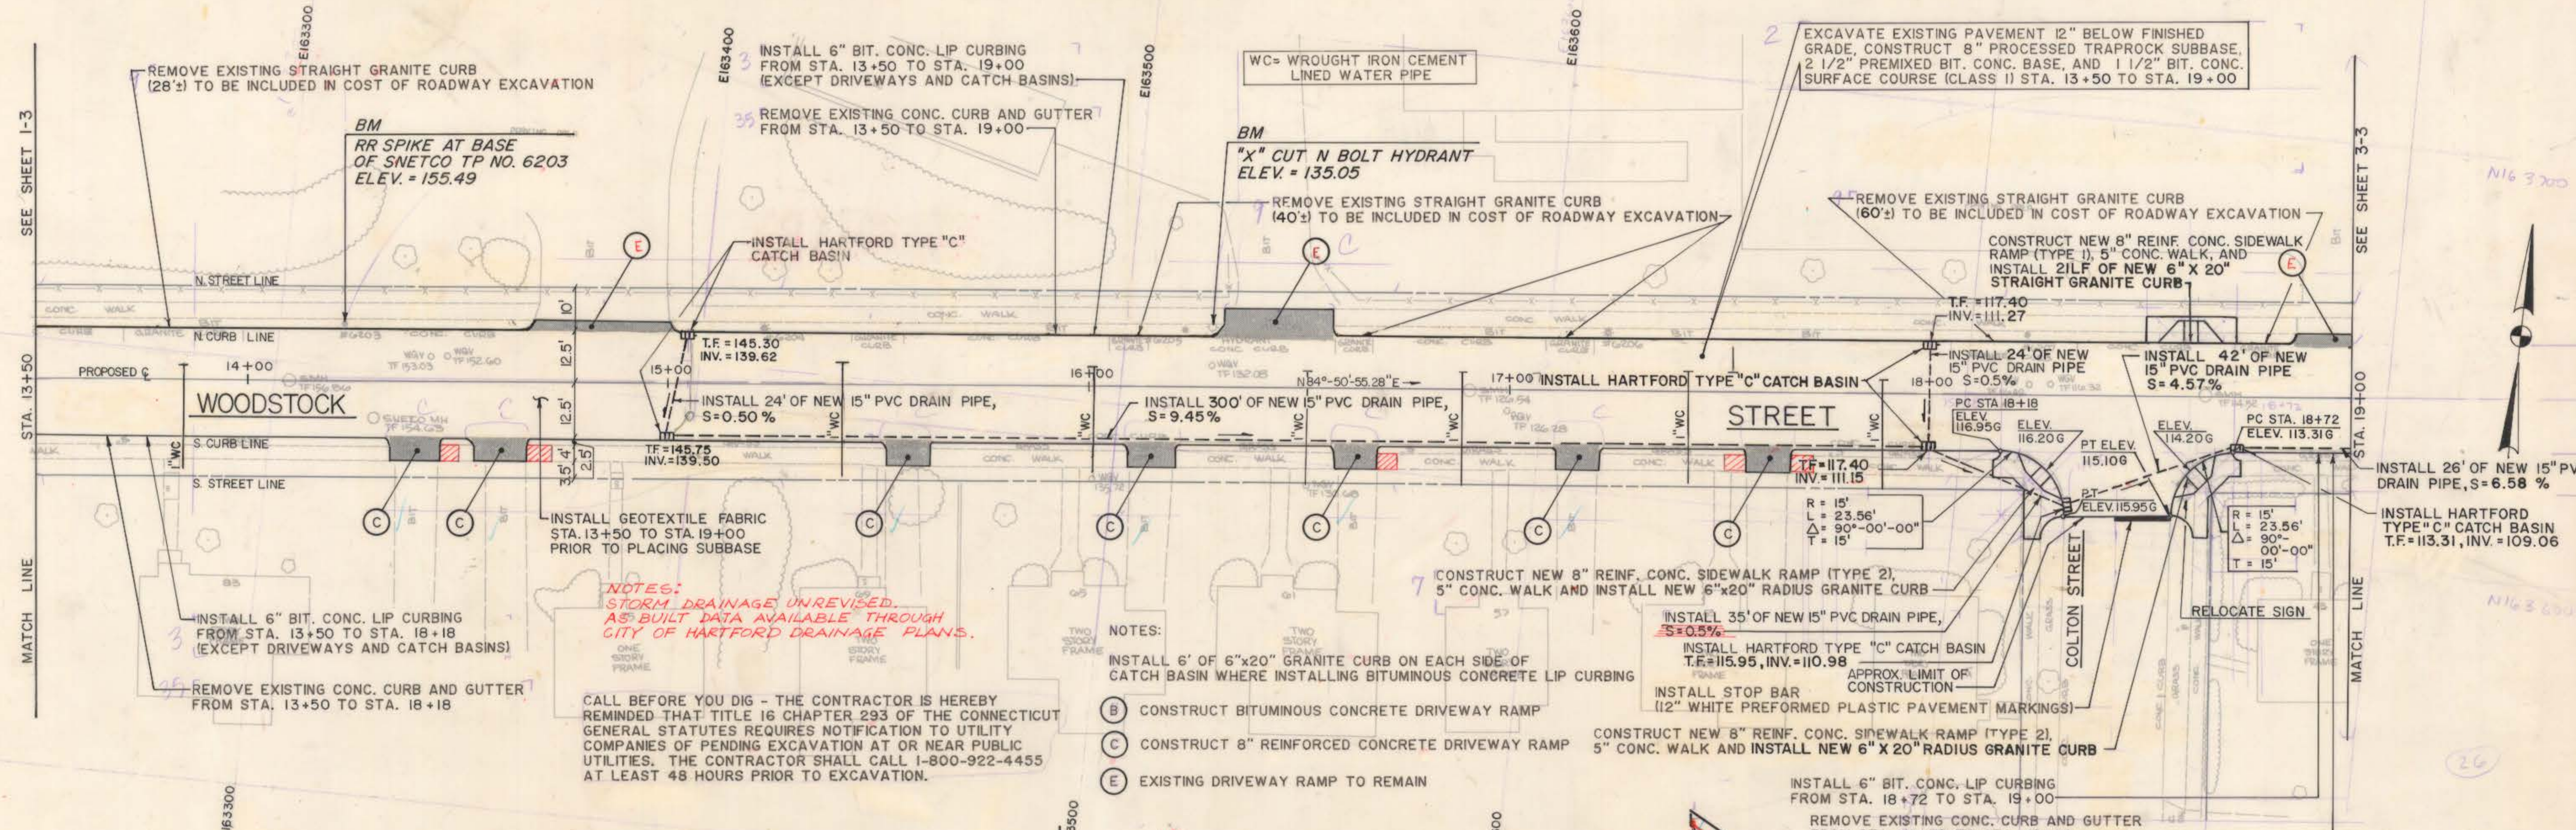

REVISIONS		SUPV. ARW		GRAPHIC SCALES		ROADWAY RECONSTRUCTION		Hayden Wegman		CITY OF HARTFORD, CONNECTICUT		WOODSTOCK STREET	
1. 1/26/87 Add Note "AS BUILT" DRAFTED BY M.J.N.		DESIGN AC/DH		HORIZ. 1"=20'		HARTFORD, CONNECTICUT		Consulting Engineers		DEPARTMENT OF PUBLIC WORKS		STA. 13+50 TO STA. 19+00	
2. 8/25/87 CHECKED BY M.D.H.		DRAWN EPF		VERT. 1"=2'				WEST HARTFORD		BUREAU OF ENGINEERING SERVICES		SHEET 2	
3. 9-6-85 ENGINEERING DATA CHANGE		CHECKED JAC						NEW YORK • BOSTON • BUFFALO				PLAN AND PROFILE	
NO. DATE DESCRIPTION		DATE 6-25-85						ATLANTA • MEMPHIS		DRAWN _____		SHEET 2	
										CHECKED _____		OF 3	
										SCALE DAYBOOK NO. 010956		Contract E85-34 Job No. 845304	
										DATE		575/2A	