



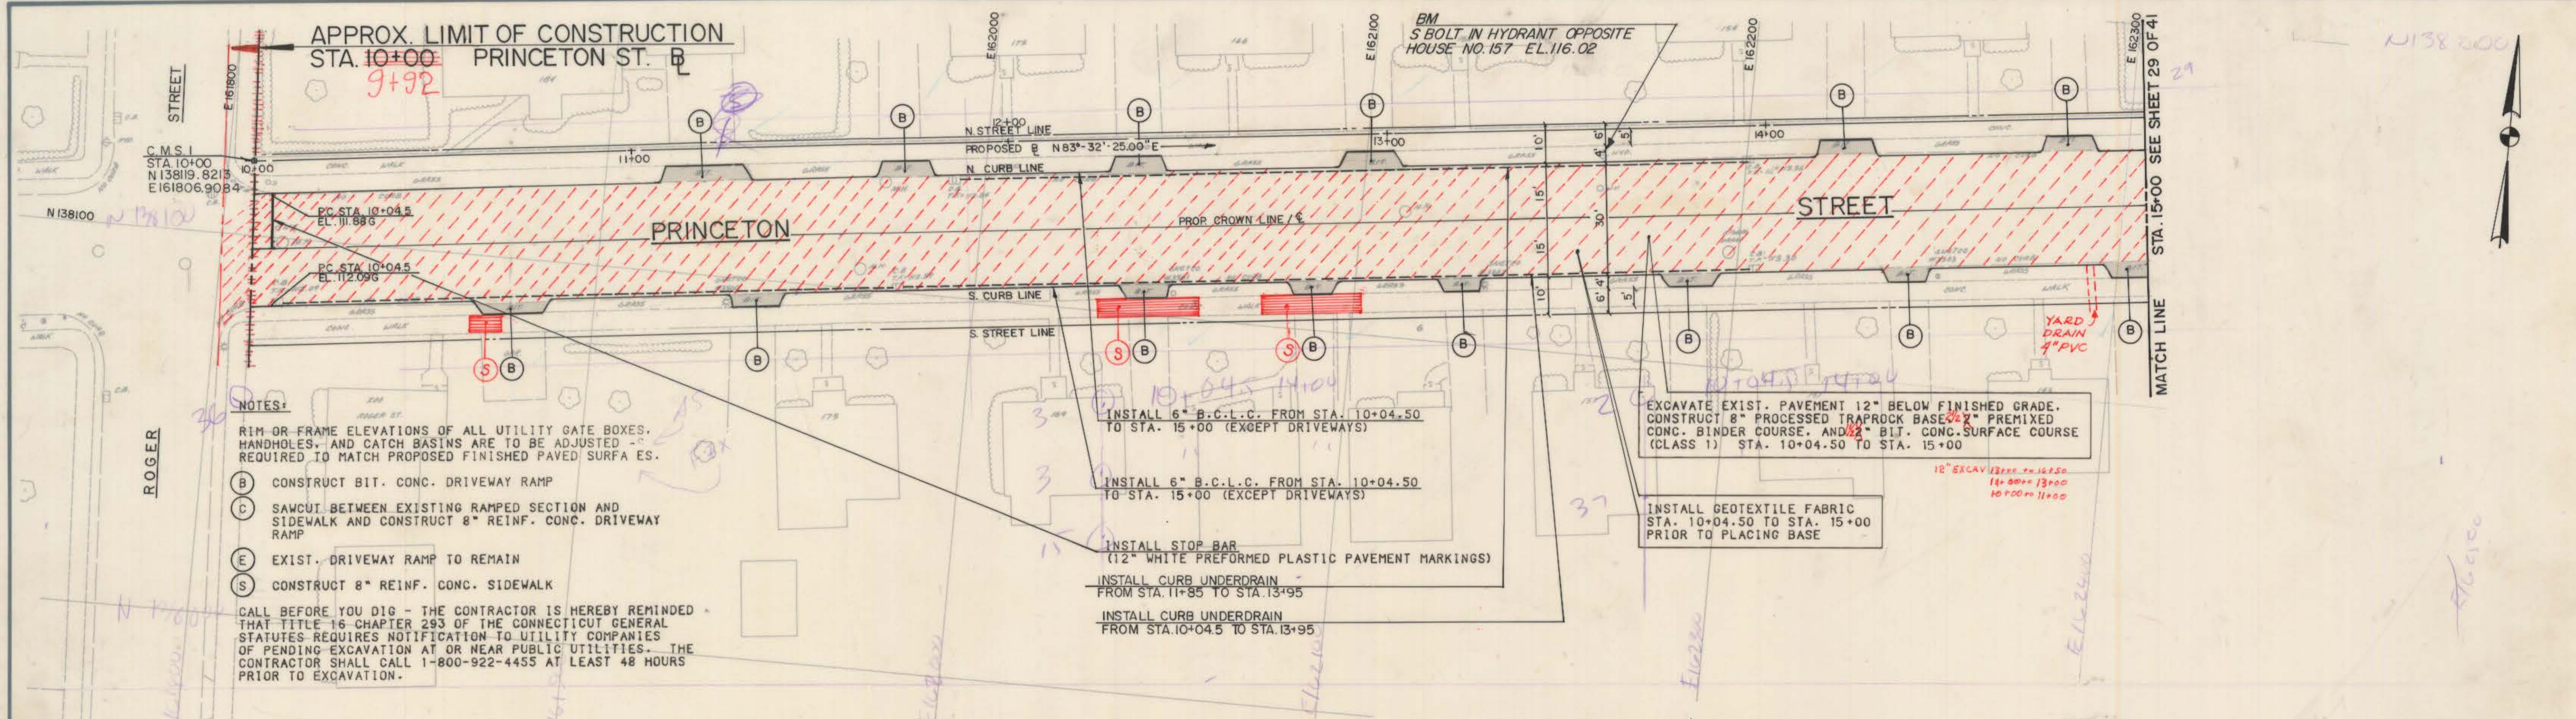

PLAN

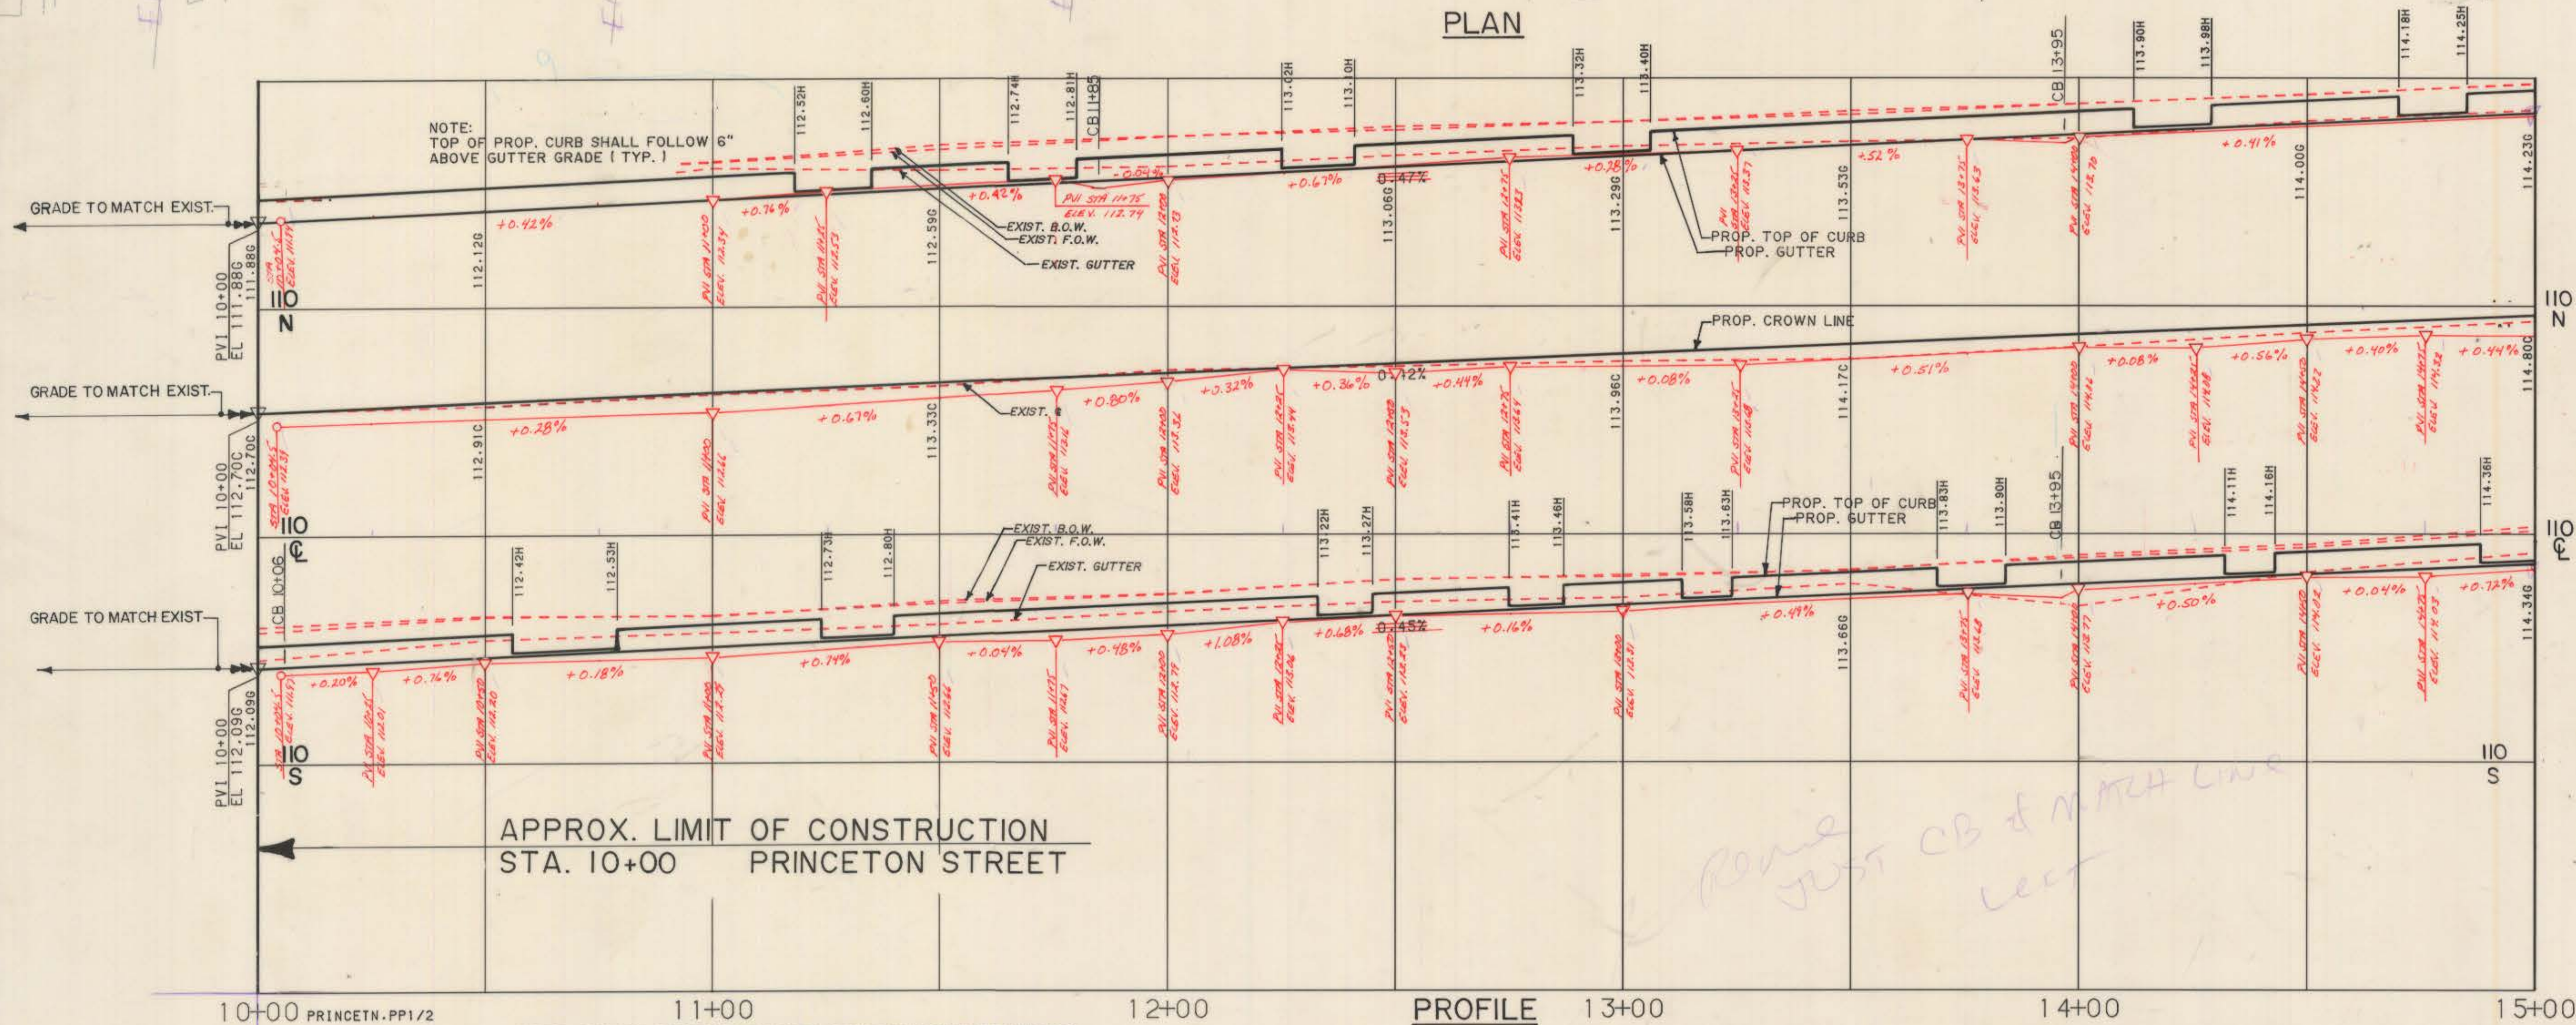

NOTE: CHECK GRAPHIC SCALES BEFORE USING DRAWINGS

2 1/20/17 App Geo-For As Buit - Drawn by JMM 7 AS BUILT - GOLD RED LINES ✓ VERTICAL AS BUILT BY RJF CHECKED BY MCC NO. DATE DESCRIPTION REVISIONS JAN 27 DATE 02-11-86		SUPV. JAC DESIGN MDH/AEC DRAWN NF CHECKED AEC DATE 02-11-86	GRAPHIC SCALES HORIZ. 1" = 20' VERT. 1" = 2' ROADWAY RECONSTRUCTION HARTFORD, CONNECTICUT		Hayden Wegman Consulting Engineers WEST HARTFORD NEW YORK • BOSTON • BUFFALO ATLANTA • MEMPHIS	CITY OF HARTFORD, CONNECTICUT DEPARTMENT OF PUBLIC WORKS BUREAU OF ENGINEERING SERVICES DAYBOOK NO. 011005 DATE	PRINCETON STREET STA. 10+00 TO STA. 15+00 PLAN AND PROFILE Job No. - 852534	SHEET 28 OF 41
---	--	---	---	--	---	---	---	-------------------