


NOTES:


RIM OR FRAME ELEVATIONS OF ALL UTILITY GATE BOXES, HANDHOLES, AND CATCH BASINS ARE TO BE ADJUSTED AS REQUIRED TO MATCH PROPOSED FINISHED PAVED SURFACES.

- (B) CONSTRUCT BIT. CONC. DRIVEWAY RAMP
- (C) SAWCUT BETWEEN EXISTING RAMPED SECTION AND SIDEWALK AND CONSTRUCT 8" REINF. CONC. DRIVEWAY RAMP
- (E) EXIST. DRIVEWAY RAMP TO REMAIN
- (S) CONSTRUCT 8" REINF. CONC. SIDEWALK

CALL BEFORE YOU DIG - THE CONTRACTOR IS HEREBY REMINDED THAT TITLE 16 CHAPTER 293 OF THE CONNECTICUT GENERAL STATUTES REQUIRES NOTIFICATION TO UTILITY COMPANIES OF PENDING EXCAVATION AT OR NEAR PUBLIC UTILITIES. THE CONTRACTOR SHALL CALL 1-800-922-4455 AT LEAST 48 HOURS PRIOR TO EXCAVATION.

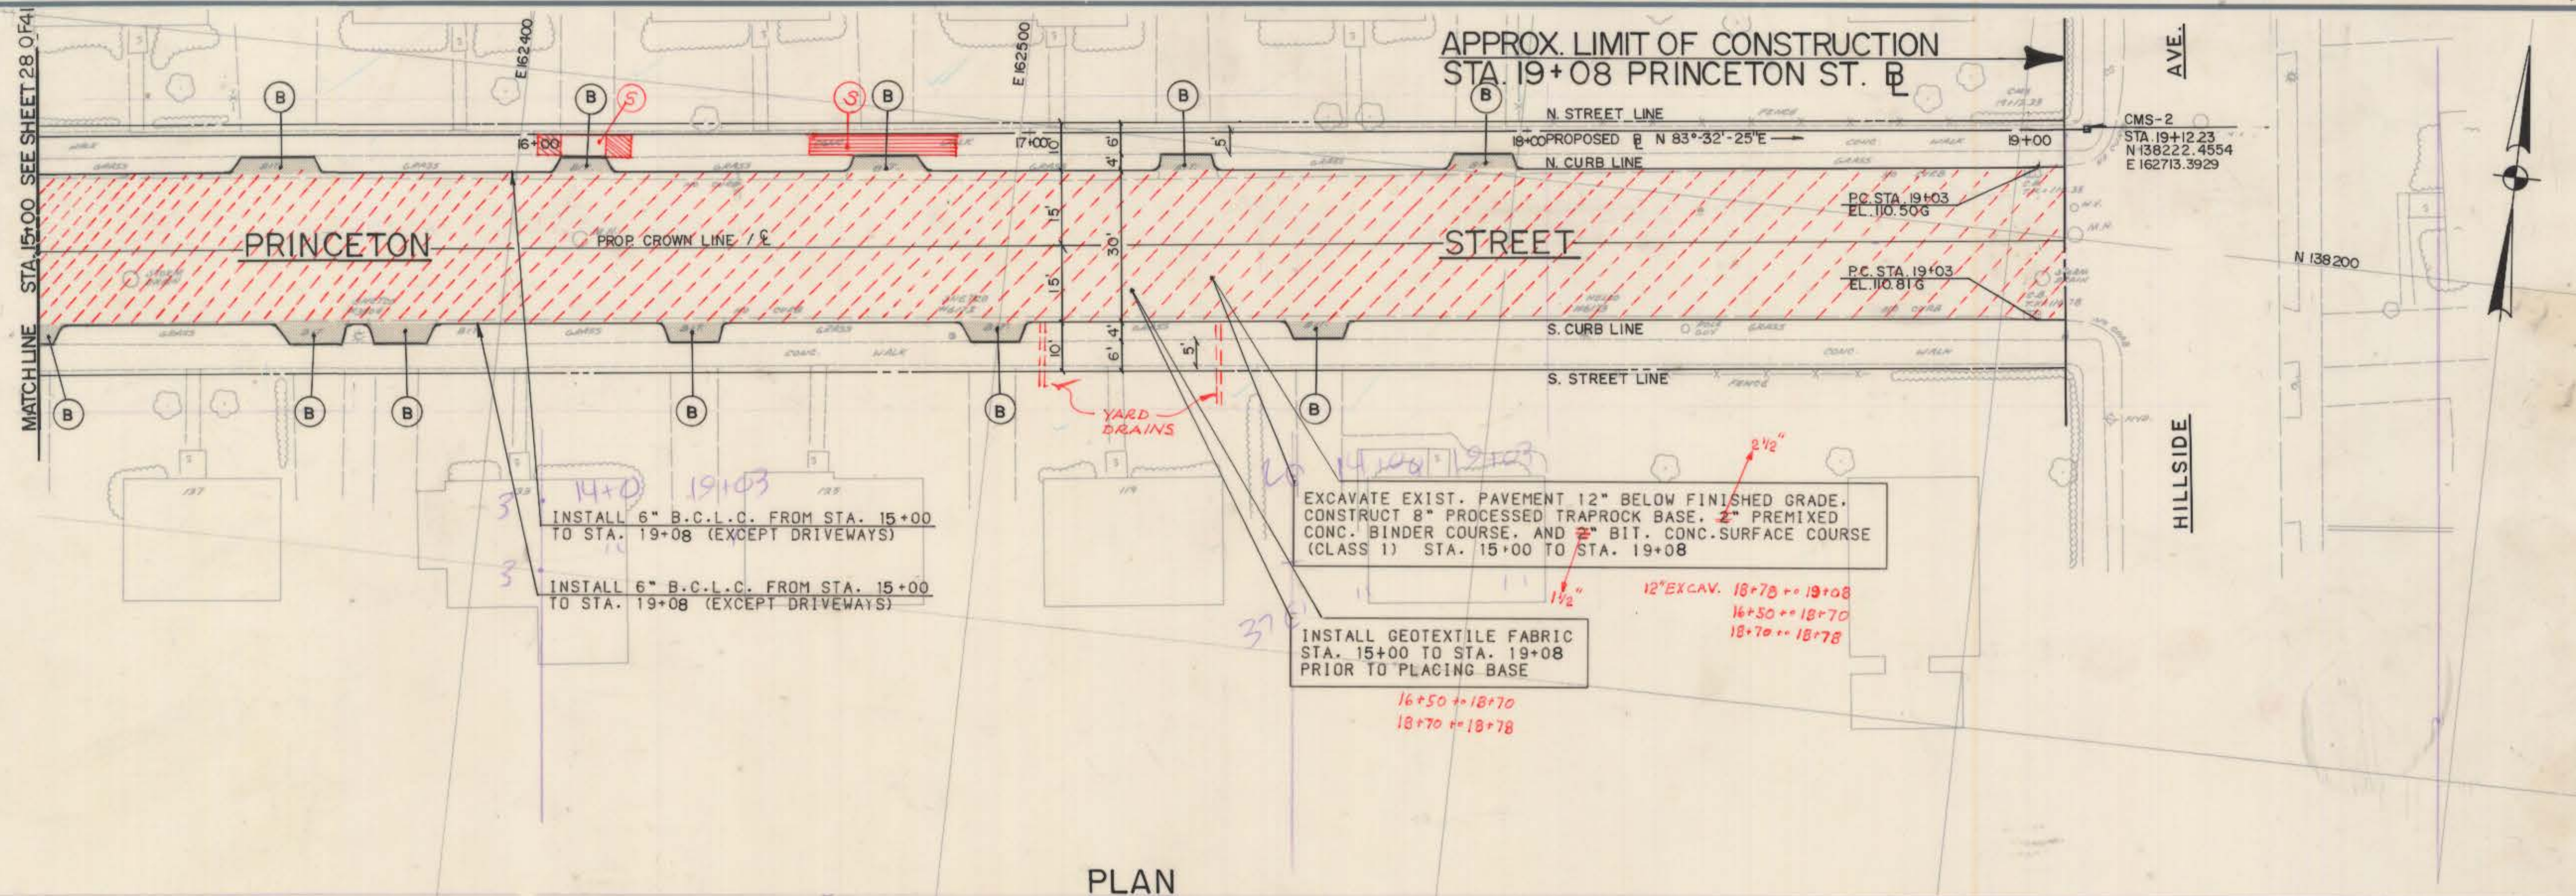

PLAN

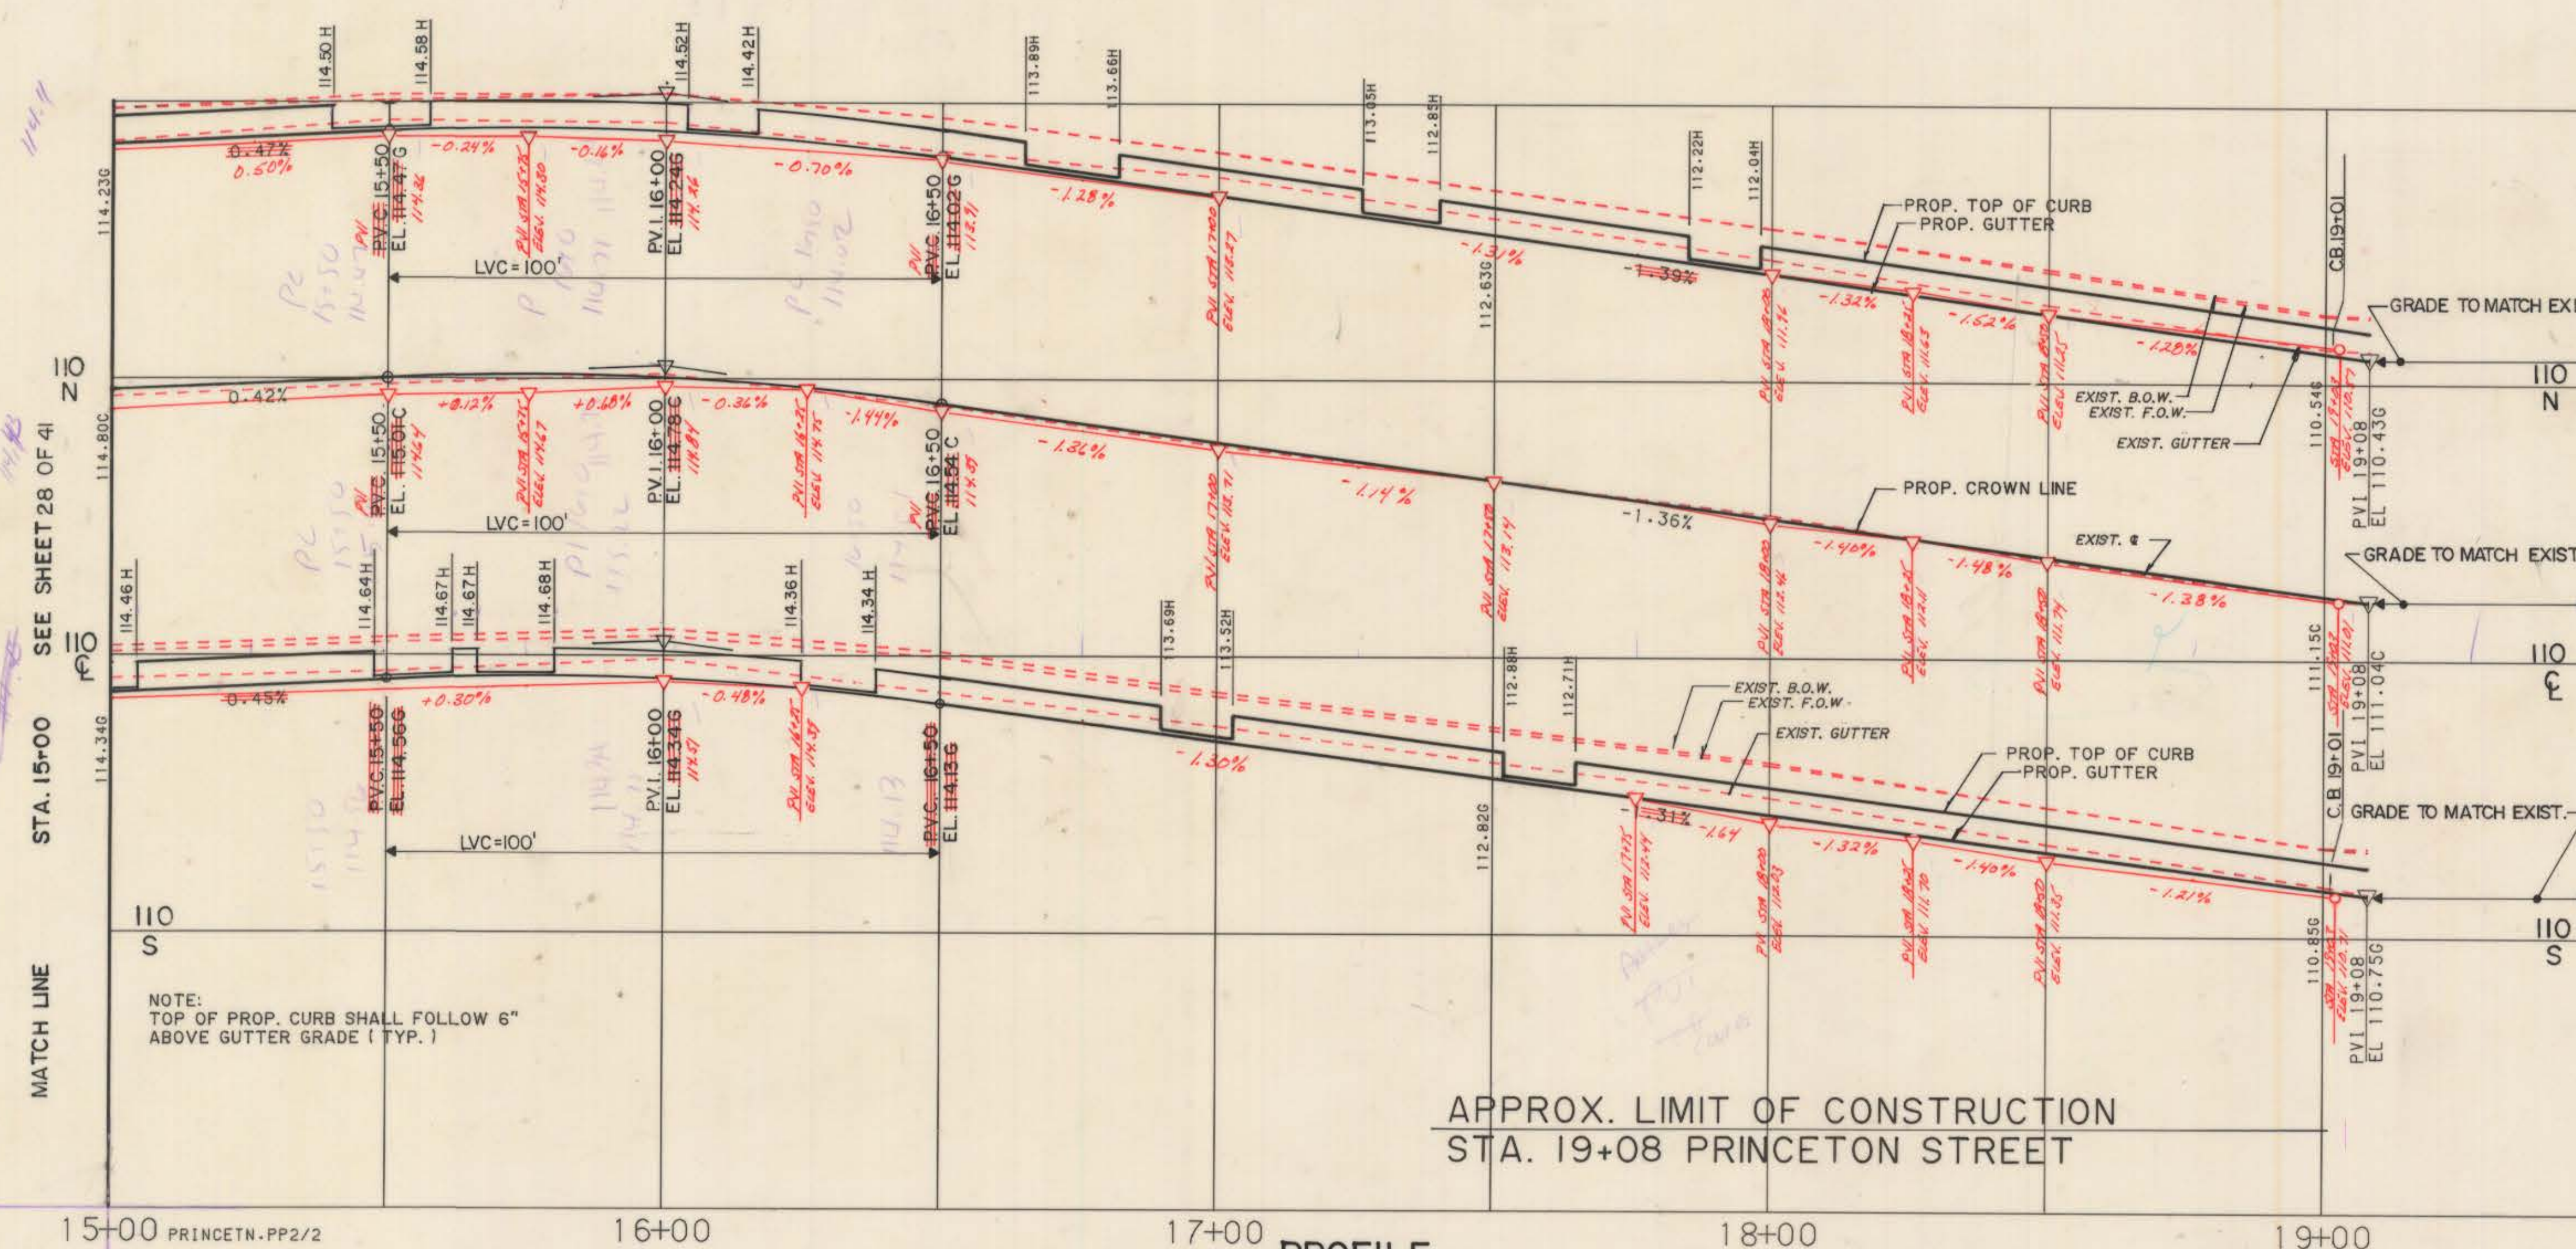

PROFILE

NOTE: CHECK GRAPHIC SCALES BEFORE USING DRAWINGS

2	1/29/87	App Geo. Tex. Ac Bmt. Checked by MTK	SUPV.	JAC
1		AS BUILT - SOLID RED LINES	DESIGN	MDH/AEC
			DRAWN	T.C.
		VERTICAL AS BUILT BY RJF	CHECKED	AEC
		CHECKED BY MCC		
		JAN 87		
NO.	DATE	DESCRIPTION	DATE	02-11-86
REVISIONS				

GRAPHIC SCALES
HORIZ. 1"=20'
VERT. 1"=2'

ROADWAY RECONSTRUCTION
HARTFORD, CONNECTICUT



Hayden | Wegman
Consulting Engineers

WEST HARTFORD
NEW YORK • BOSTON • BUFFALO
ATLANTA • MEMPHIS

CITY OF HARTFORD, CONNECTICUT
DEPARTMENT OF PUBLIC WORKS
BUREAU OF ENGINEERING SERVICES

DAYBOOK NO. 011005
DATE

PRINCETON STREET
STA. 15+00 TO STA. 19+08

PLAN AND PROFILE

Job No. - 852534

SHEET 29
OF 41