




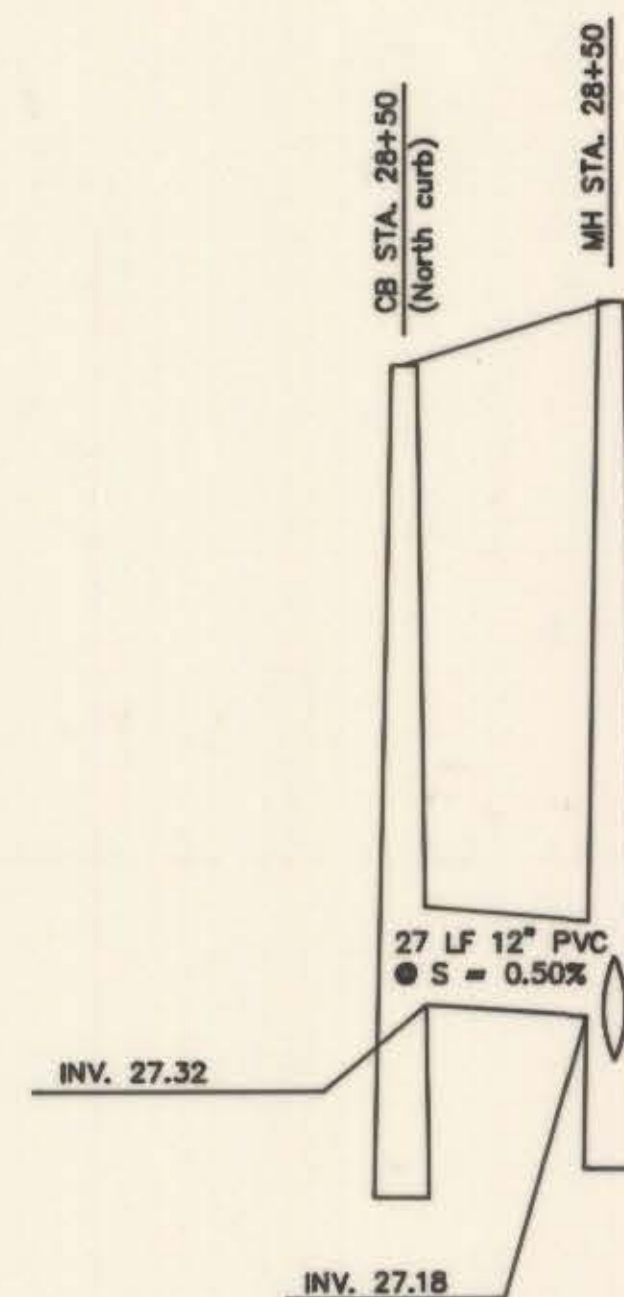

PROFILE 2

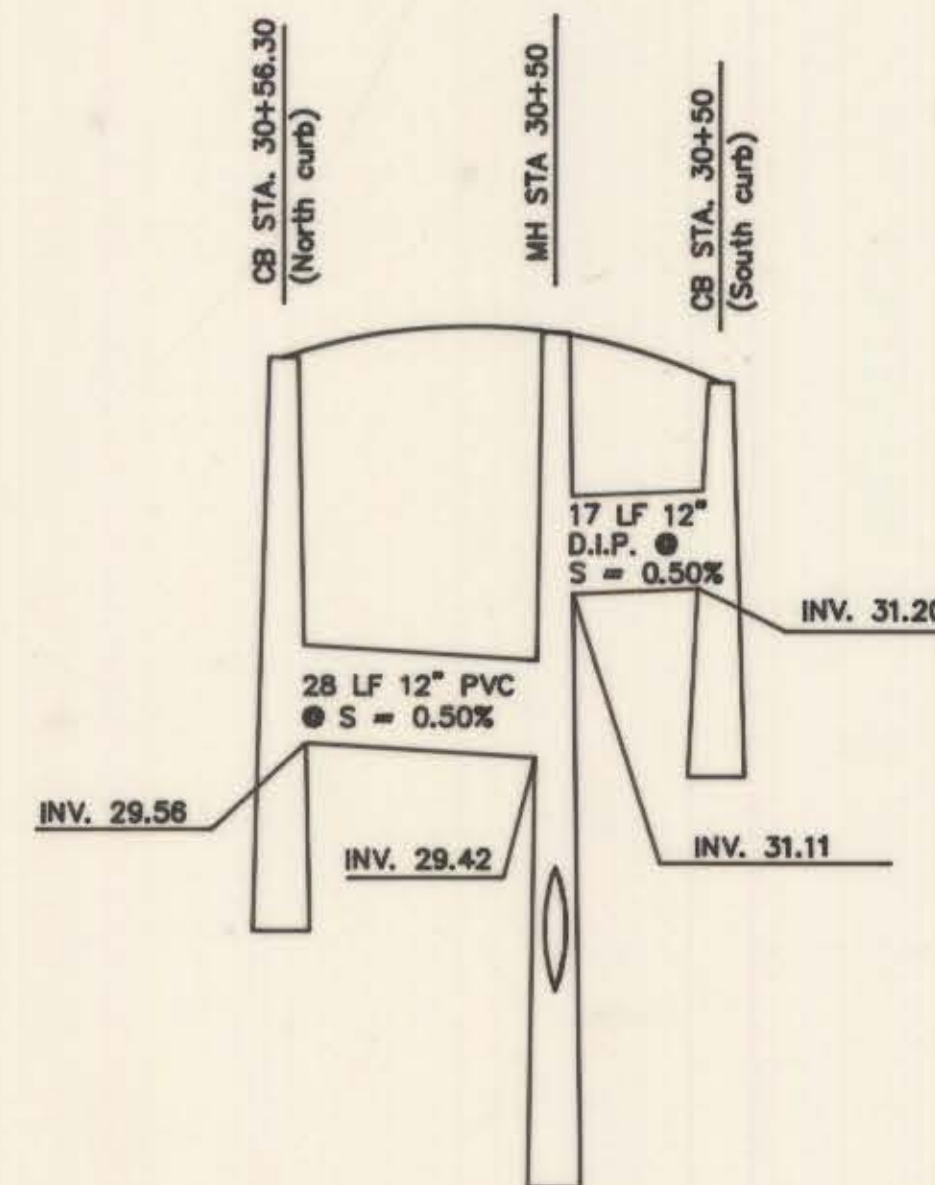

PROFILE 3 & 4

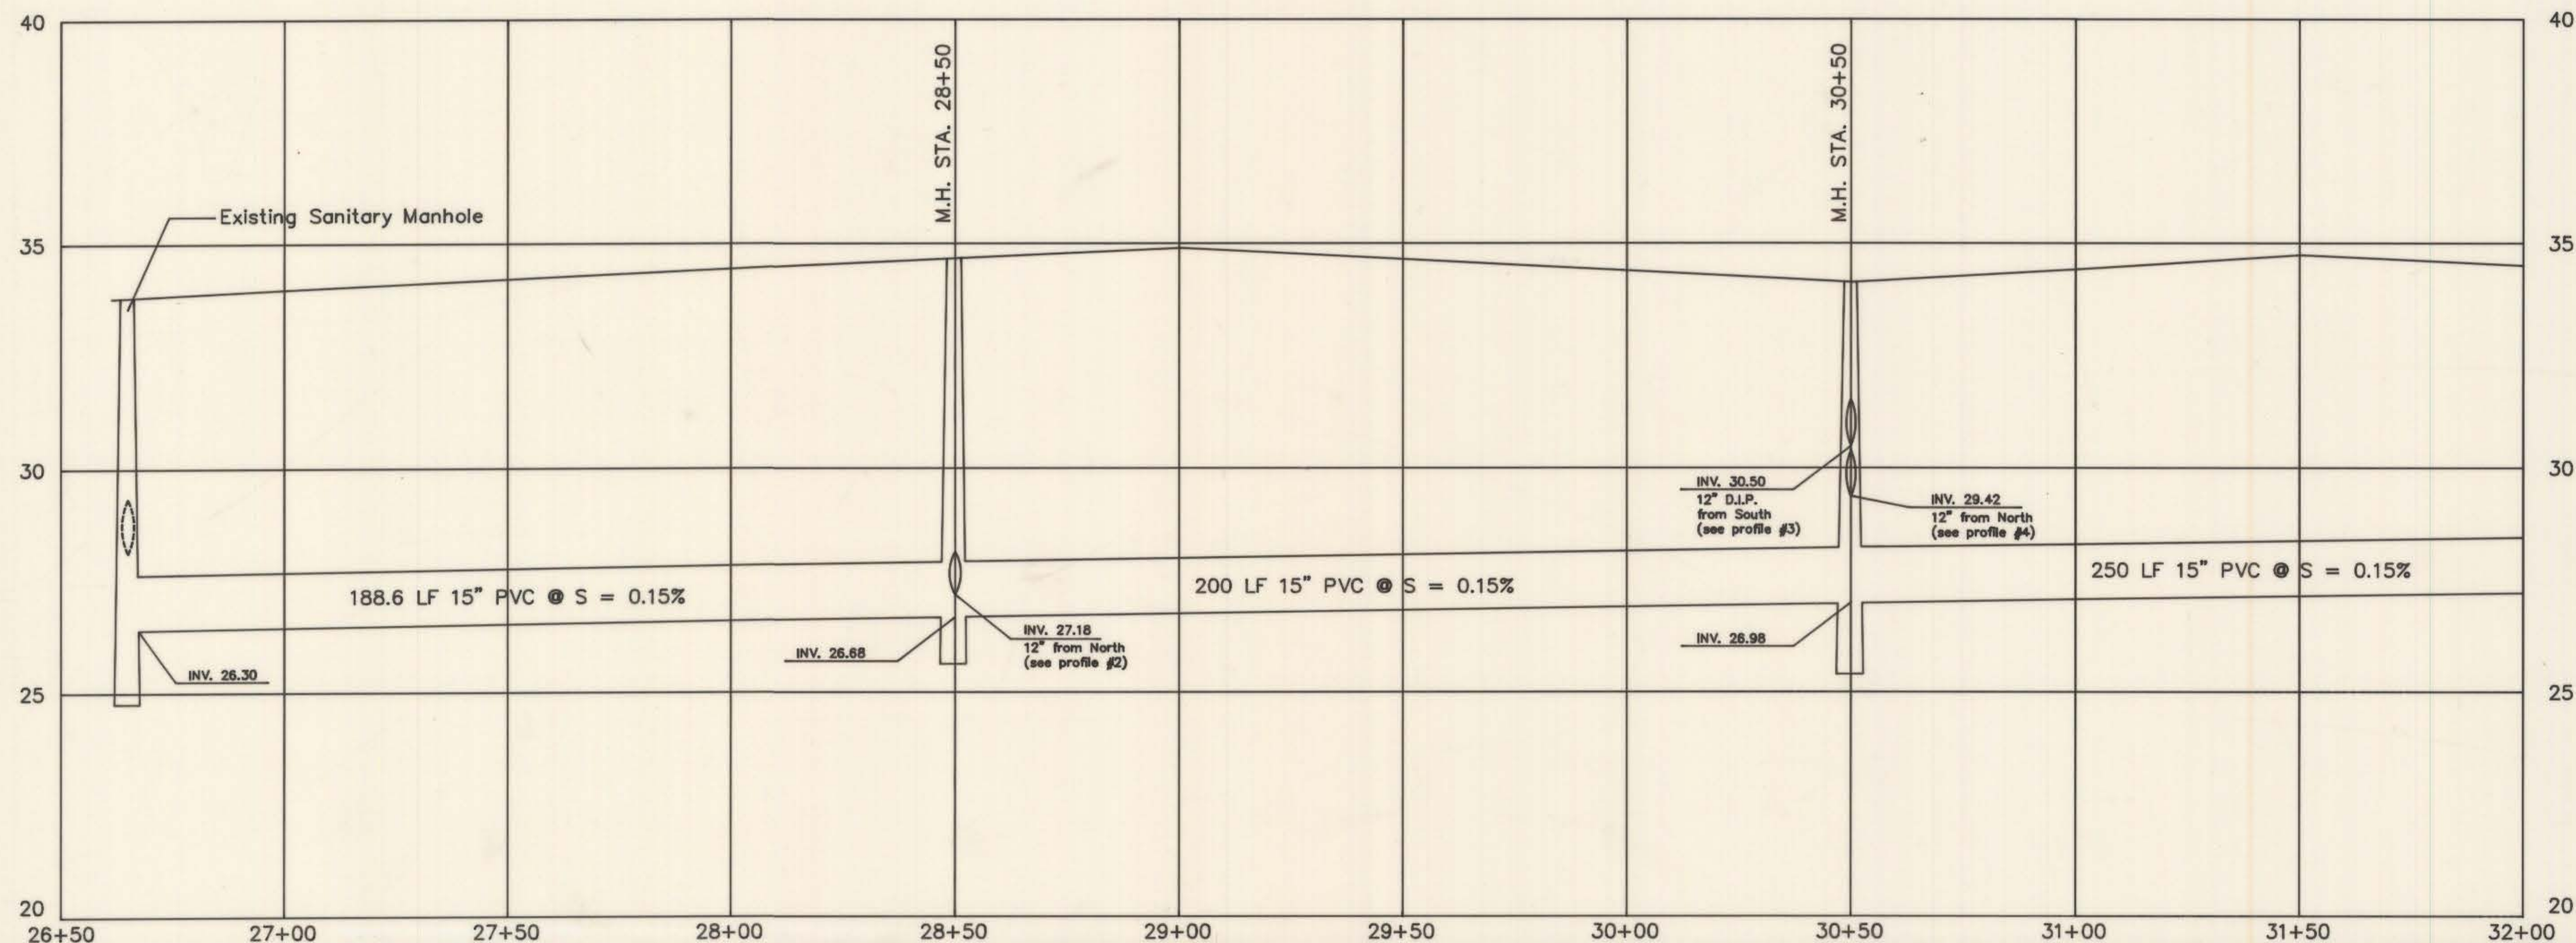

NO.	DATE	DESCRIPTION
1	1/13/87	As Built - Drawn by W.H.
REVISIONS		
SUPV.	J.A.C.	
DESIGN	A.E.C.	
DRAWN	M.J.N.	
CHECKED	A.E.C.	
DATE	6-20-86	

GRAPHIC SCALES
 HORZ. = 1" = 20'
 VERT. = 1" = 2'

ROADWAY RECONSTRUCTION
 HARTFORD, CONNECTICUT



Hayden | Wegman
 Consulting Engineers

• WEST HARTFORD •
 BOSTON • NEW YORK • ATLANTA
 NIAGARA • WEST PALM BEACH

CITY OF HARTFORD, CONNECTICUT
 DEPARTMENT OF PUBLIC WORKS
 BUREAU OF ENGINEERING SERVICES

DAYBOOK NO. 011005

DATE

WAWARME AVENUE
 STA. 26+62 TO STA. 32+00

PLAN AND PROFILE

Contract No. E-86-2 Job No. - 852534

SHEET 38 A

OF 41