




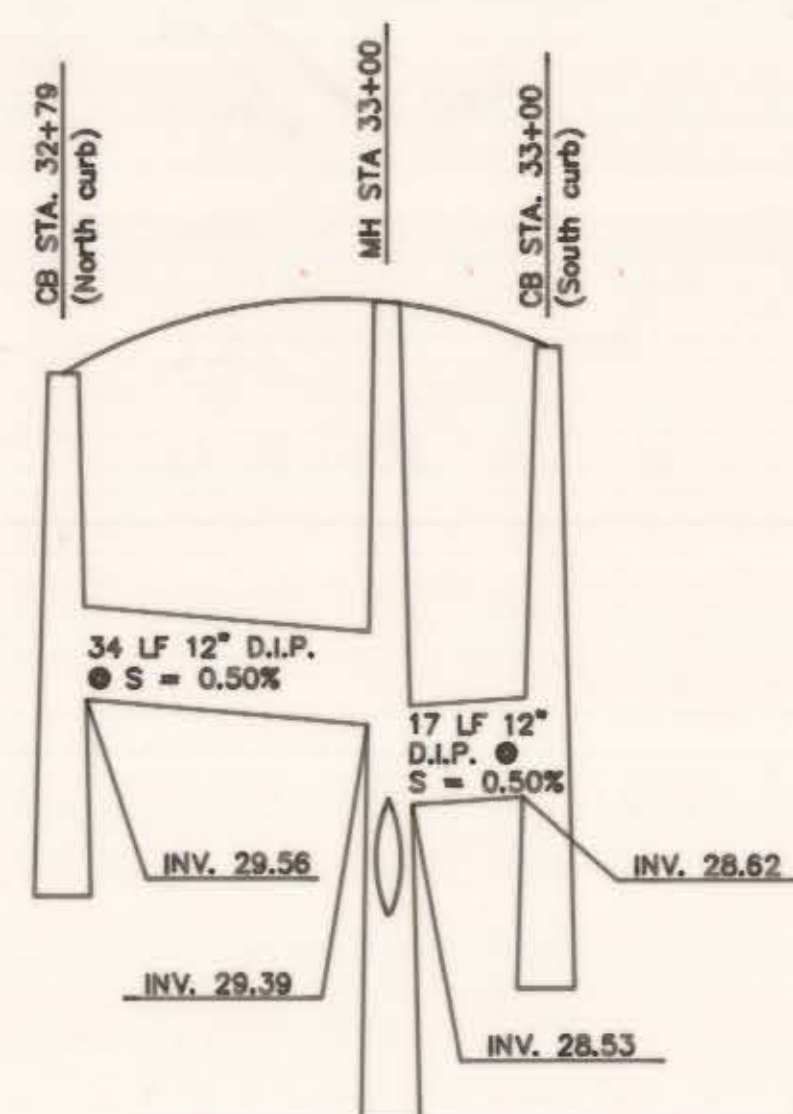

PROFILE 5 & 6

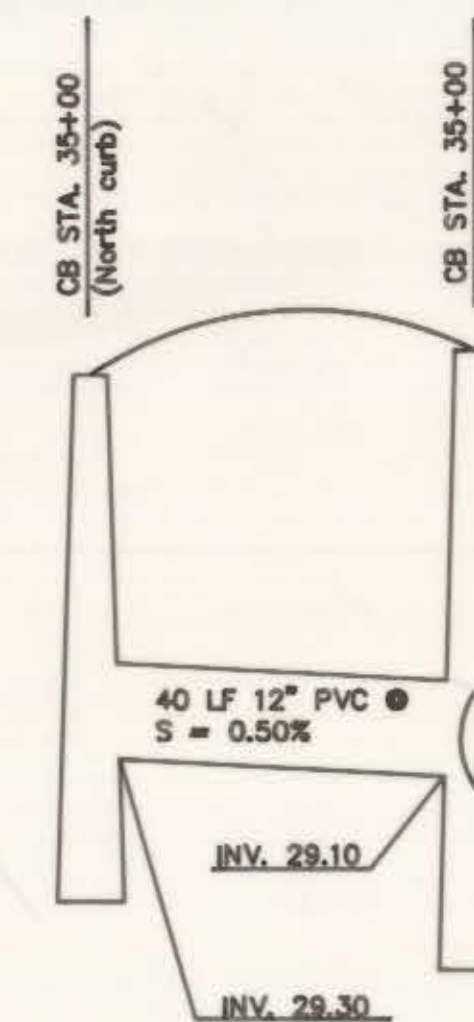

PROFILE 7

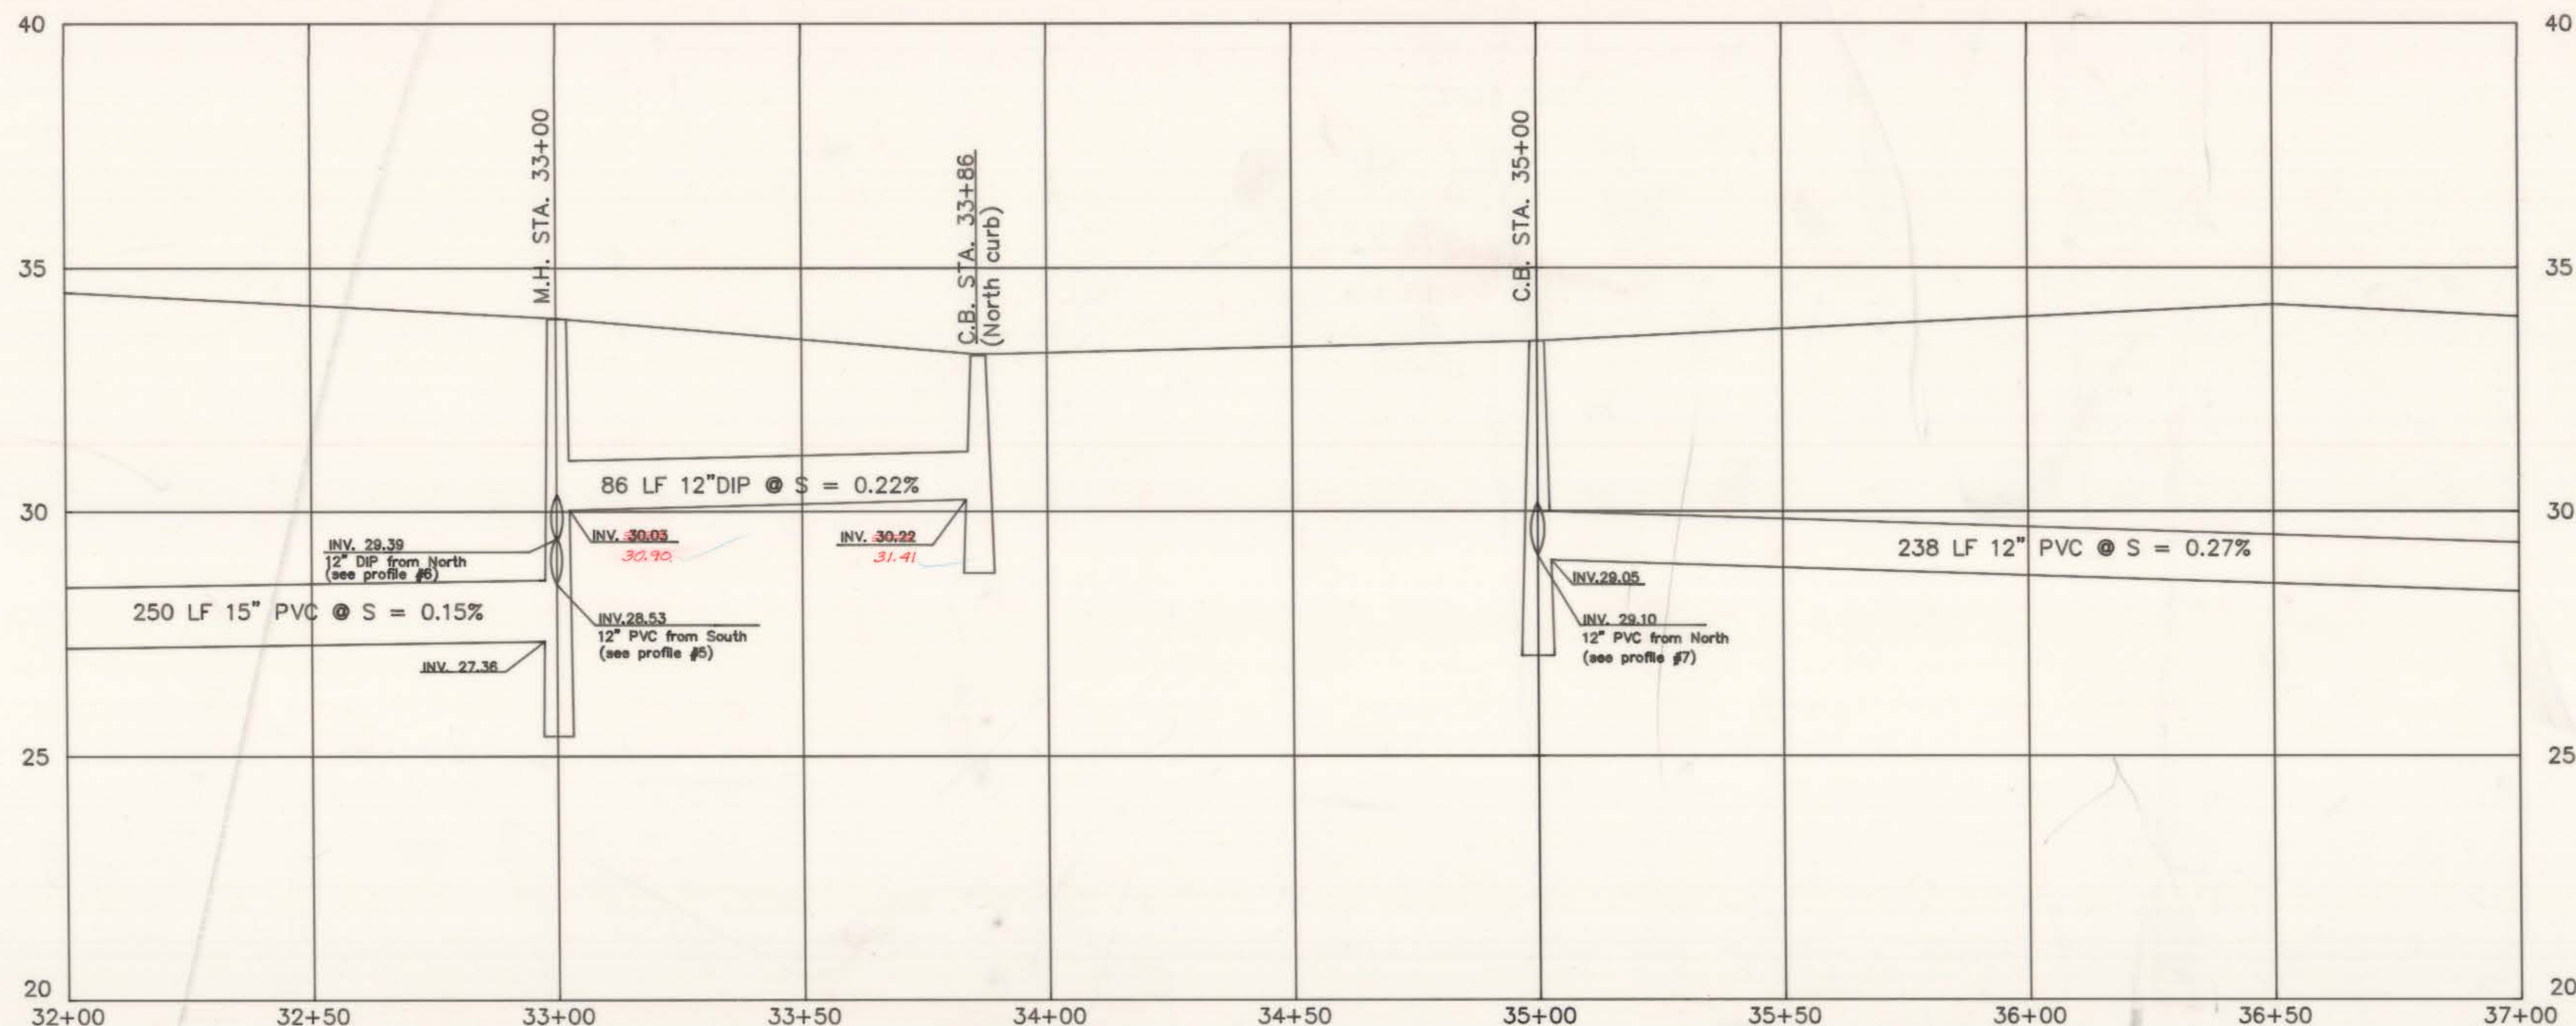

NO.	DATE	REVISIONS
1	1-26-87	CHECKED BY M.J.N.
2	1-26-87	AS BUILT - DRAFTED BY M.J.N.

SUPV.	J. A. C.
DESIGN	A. E. C.
DRAWN	M. J. N.
CHECKED	A. E. C.
DATE	6-20-86

GRAPHIC SCALES

HORZ. = 1" = 20'

VERT. = 1" = 2'

ROADWAY RECONSTRUCTION
HARTFORD, CONNECTICUT



Hayden | Wegman
Consulting Engineers

NEW YORK • BOSTON • BUFFALO
WEST HARTFORD • ATLANTA • MEMPHIS

CITY OF HARTFORD, CONNECTICUT
DEPARTMENT OF PUBLIC WORKS
BUREAU OF ENGINEERING SERVICES

DAYBOOK NO. 011005
DATE

WAWARME AVENUE
STA. 32+00 TO STA. 37+00

PLAN AND PROFILE

Contract No. E-86-2 Job No. - 852534

SHEET 39 A
OF 41